

 CONTRACTOR SHALL BE FULLY INSURED AND LICENSED IN THE STATE WHERE WORK IS TAKING PLACE. - THE CONTRACTOR SHALL NOT ORDER MATERIALS NOR SCHEDULE THE WORK UNTIL ALL PLAN DIMENSIONS, SPECIFICATIONS, NOTES, HAVE BEEN VERIFIED IN FIELD.

 DRAWINGS, SHOP DRAWINGS AND EXISTING CONDITIONS ARE VERIFIED IN THE FIELD BY THE GENERAL CONTRACTOR. THE GC SHALL INFORM THE ARCHITECT OF ANY CONFLICTS IN WRITING BEFORE CONSTRUCTION COMMENCES. ALL INFORMATION SHOWN ON THE DRAWINGS RELATIVE TO EXISTING CONDITIONS IS GIVEN AS BEST AS PRESENT KNOWLEDGE, BUT WITHOUT GUARANTEE OF ACCURACY.

- IT IS THE RESPONSIBILITY OF THE GC TO NOTIFY THE OWNER AND THE ARCHITECT OF RECORD OF ANY CONDITION FOUND IN THE FIELD TO BE DIFFERENT FROM THOSE SHOWN ON THE PLANS OR SHOP DRAWINGS AND OF NOTED CONFLICTS FOUND ON THE PLANS OR SHOW ON DRAWINGS THAT MAY AFFECT THE COMPLETION OF THE PROJECT, BEFORE SUCH WORK COMMENCES.

PLUMBING, MECHANICAL, CIVIL, AND ELECTRICAL DRAWINGS, AS PROVIDED IN PERMIT SET. CONTRACTOR SHALL VERIFY ALL DIMENSIONS IN FIELD PRIOR TO POURING CONCRETE; ANY DISCREPANCIES SHALL BE CALLED TO THE ATTENTION OF THE ARCHITECT OF RECORD BEFORE PROCEEDING WITH

 THE CONTRACTOR IS RESPONSIBLE FOR PROTECTING EXISTING AND NEW PROPERTIES OF THE OWNER OR ADJOINING PROPERTIES. THE CONTRACTOR SHALL NOT UNDERMINE FOUNDATIONS WITHOUT WRITTEN PERMISSION FROM THE ENGINEER.

- THE CONTRACTOR SHALL BE RESPONSIBLE FOR ALL MEANS, METHODS, TECHNIQUES AND SEQUENCES OF CONSTRUCTION. THE CONTRACTOR SHALL BE RESPONSIBLE FOR ALL SAFETY PROGRAMS AND PROCEDURES DURING CONSTRUCTION, INCLUDED BUT NOT LIMITED TO POLLUTION PREVENTION PLAN. - IT IS THE CONTRACTOR'S RESPONSIBILITY TO DESIGN AND IMPLEMENT SHORING SYSTEM PRIOR TO THE

SPECIFICATIONS, DETAIL NOTES AND DRAWINGS SHALL GOVERN AND WRITTEN DIMENSIONS SHALL GOVERN OVER SCALED MEASUREMENTS.

- UNLESS SHOWN OTHERWISE, DETAILS SHOWN ON TYPICAL DETAIL SHEETS SHALL BE USED WHEREVER APPLICABLE. SPECIFIC DETAILS ON THE STRUCTURAL DRAWINGS TAKE PRECEDENCE OVER TYPICAL ARCHITECTURAL DETAILS. SPECIFIC NOTES ON STRUCTURAL DRAWINGS TAKE PRECEDENCE OVER NOTES SHOWN IN GENERAL NOTES. - MANUFACTURERS' NOTES AND SPECIFICATIONS SHALL


APPLY WHEN PER CODE. DO NOT SCALE DRAWINGS.

- GC IS RESPONSIBLE FOR LOCATING AND AVOIDING UTILITIES. CALL USA NORTH AT 1-800-227-2600. - VERIFY ALL DIMENSIONS IN FIELD, IN CASE OF DISCREPANCY CONTACT ARCHITECT PRIOR TO CONTINUATION OF WORK. - THE ISSUANCE OF A BUILDING PERMIT SHALL NOT BE CONSTRUED AS A GUARANTEE THAT ALL OF CODE

ULTIMATELY RESPONSIBLE FOR INSURING THAT THE FINISHED BUILT COMPLIES WITH ALL LOCAL, STATES AND FEDERAL REGULATIONS, LAWS AND CODE REQUIREMENTS. - WHEN MANUFACTURED ROOF TRUSSES ARE INSTALLED, GC TO PROVIDE TRUSSES CALCS SIGNED BY LICENCE PROFESSIONAL FOR APPROVAL BY CITY OR COUNTY. CALC TO BE REVIEWED AND APPROVED BY ENGINEER OF RECORD PRIOR TO BE SUBMITTED TO THE BUILDING OFFICIAL.

- THE CITY/COUNTY BUILDING OFFICIAL AND/OR FIRE MARSHALL WILL REVIEW THE SCOPE OF WORK AND DETERMINE IF THE EXISTING BUILDING WILL NEED TO BE REQUIRED TO BE RETROFITTED WITH FIRE SUPPRESSION SPRINKLERS. GC TO CONTACT FIRE DEPARTMENT FOR VERIFICATION, AND UPGRADE WATER METER, LINES AS NECESSARY. IF REQUIRED, FIRE SPRINKER SYSTEM TO BE ON DEFERED PERMIT AND SUBMITED BY THE GC. - GC TO READ, BE FAMILIAR AND FOLLOW ALL STANDARD PROVISIONS, CONSTRUCTION GUIDE LINES AND REQUIREMENTS OF LISTED, CURRENTLY APPLICABLE CODES AND ORDINANCE.



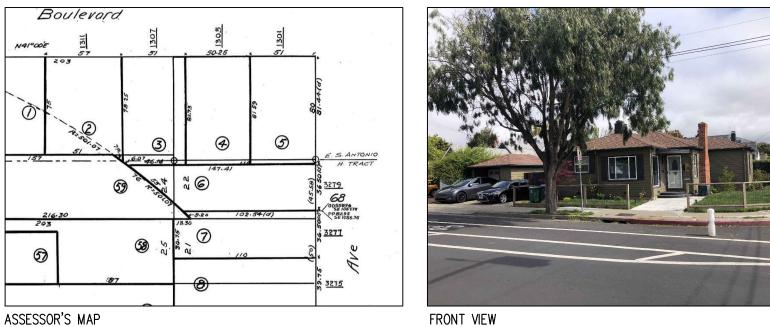

SHALL REQUIRE INSTALLATION OF APPROVED SMOKE AND CARBON MONOXIDE DETECTORS WITHIN THE DWELLING. - ALL PERMITS EXCEEDING \$10,000.00 IN VALUATION SHALL REQUIRE THE INSTALLATION OF

AN APPROVED AUTOMATIC GAS SHUT-OFF DEVICE ON THE CUSTOMER OWNED PIPING AT THE UTILITY METER.

REQUIRED. - BUILDING ADDRESS NUMBERS MUST BE A MINIMUM OF 4 INCHES IN HEIGHT OR 3 INCHES IN HEIGHT AND SELF-ILLUMINATED. - CARBON MONOXIDE ALARM AND DETECTOR SHALL BE INSTALLED IN ACCORDANCE W/ THE MANUFACTURER'S INSTRUCTIONS, NFPA 720 INSTALLATION STANDARDS AND CRC. ALL SMOKE ALARMS SHALL BE 110V CONNECTED

anura design

**REVISIONS** 

06/27/2025

07/25/2025

08/25/2025 09/30/2025



ROMAIN CURTIS ARCHITECT #C35019

367 CIVIC DR #3, phone: 510.612.0345 roman@anuradesign.com

PLEASANT HILL, CA94523

0

DRAWN BY CA008

CHECKED BY

CA007

ISSUE DATE

04/12/2024

1/8"=1'-0"

69-76-5 R-1

R-3 / U

4,157 SF 1,093 SF 236 SF 1,329 SF (E) TOTAL CONDITIONED SPACE: 1,093 SF

ALL DIMENSIONS

REMOVED WALL

(E) WALL

(N) WALL

SHEAR WALL

31.97% 26.29%

280 SF (N) TOTAL CONDITIONED SPACE: 1,373 SF 18 SF (N) TOTAL FOOT PRINT: 1,627 SF (N) LOT COVERAGE: 39.16% 33.20%

SCOPE OF WORK 280 SF ADDITION AND INTERIOR REMODEL. CREATING A MUDROOM AND STORAGE ROOM, MAIN BEDROOM WITH A NEW BATHROOM. REMOVAL OF WATER TANK AND INSTALLING AN

2 UNSTANT WATER HEATER. NO CHANGE TO LANDSCAPING NO CHANGE TO PARKING NO CHANGE TO IMPERVIOUS AREA NO CHANGE TO DRAINAGE

ATO SITE PLAN - PROJECT DATA A1b EROSION CONTROL A2a EXISTING/ DEMOLITION PLANS

A2b EXISTING ELEVATIONS A3 PROPOSED & ELECTRICAL PLAN A4 PROPOSED ELEVATIONS, SECTION & ROOF PLAN A5 GASE LINE DIAGRAM & WATER SIZING CALCS.

GN1 GENERAL NOTES GN2 MANDATORY MEASURES GN3 MANDATORY MEASURES

GN4 CALGREEN FORMS GN5 POLLUTION PREVENTION PLAN EN1 TITLE 24

EN2 TITLE 24 S-1 STRUCTURAL NOTES S-1.1 STRUCTURAL NOTES

S-2 FOUNDATION PLAN S-3 CEILING FRAMING PLAN S-4 ROOF FRAMING PLAN SD1 TYPICAL DETAILS

SD1.1 TYPICAL DETAILS SD2 STRUCTURAL DETAILS SD3 STRUCTURAL DETAILS

SD4 STRUCTURAL DETAILS SDS STRUCTURAL DETAILS 1

SD6 STRUCTURAL DETAILS SUR SURVEY


ALL PERMITS EXCEEDING \$1,000.00 IN VALUATION

- VIF & INSTALL A MOTION SENSITIVE AUTOMATIC GAS SHUTOFF VALVE ON GAS METER WHEN


INCLUDING LOW BATTERY WARNING FEATURE)

ALL SMOKE ALARMS TO BE INTERCONNECTED.

ANURA JOB NO CA2504-0002 SHEET TO THE BUILDING WIRING (W/ BATTERY BACKUP

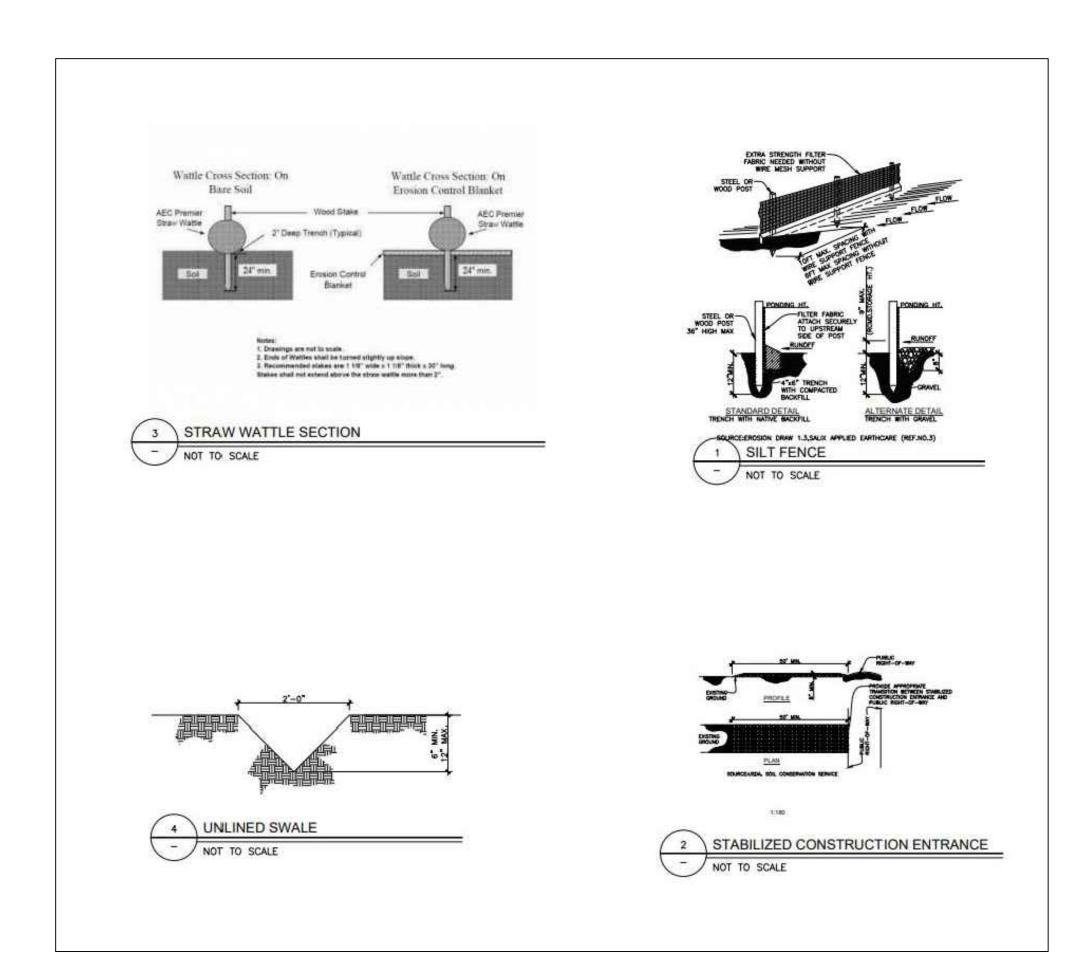

- 1. PERFORM CLEANING & EARTH MOVING ACTIVITIES ONLY DURING DRY WEATHER. MEASURES TO ENSURE ADEQUATE EROSION & SEDIMENT CONTROL SHALL BE INSTALLED PRIOR TO EARTH MOVING ACTIVITIES & CONSTRUCTION.
- 2. MEASURES TO ENSURE ADEQUATE EROSION & SEDIMENT CONTROL ARE REQUIRED YEAR ROUND. STABILIZE ALL DENUDED AREAS & MAINTAIN EROSION CONTROL MEASURES CONTINUOUSLY BETWEEN OCTOBER 1 & APRIL 30.
- 3. TORE, HANDLE & DISPOSE OF CONSTRUCTION MATERIALS & WASTES PROPERLY SO AS TO PREVENT THEIR CONTACT WITH STORM WATER.
- 4. CONTROL & PREVENT THE DISCHARGE OF ALL POTENTIAL POLLUTANTS, INCLUDING PAVEMENT CUTTING WASTES, PAINTS, CONCRETE, PETROLEUM PRODUCTS, CHEMICALS, WASH WATER OR SEDIMENTS, AND NON-STORM WATER DISCHARGES TO STORM DRAINS & WATERCOURSES.
- 5. AVOID CLEANING, FUELING OR MAINTAINING VEHICLES ON SITE EXCEPT IN A DESIGNATED AREA WHERE WASH WATER IS CONTAINED & TREATED.
- 6. LIMIT & TIME APPLICATION OF PESTICIDES & FERTILIZERS TO PREVENT POLLUTED RUNOFF.
- 7. LIMIT CONSTRUCTION ACCESS ROUTES TO STABILIZED DESIGNATED ACCESS POINTS.
- 8. AVOID BACKING DIRT OR OTHER MATERIALS OFF-SITE; CLEAN OFF-SITE PAVED AREAS & SIDEWALKS USING DRY SWEEPING METHODS.
- 9. TRAIN & PROVIDE INSTRUCTION OF ALL EMPLOYEES & SUBCONTRACTORS REGARDING THE WATERSHED PROTECTION MAINTENANCE STANDARDS & CONSTRUCTION BEST MANAGEMENT PRACTICES.
- 10. PLACEMENT OF EROSION MATERIALS AT THESE LOCATIONS ARE REQUIRED ON WEEKENDS & DURING RAIN EVENTS AROUND PROPERTY LINE & DEBRIS COLLECTION AREAS.
- 11. THE AREAS DELINEATED ON THE PLANS FOR PARKING, GRUBBING, STORAGE, ETC., SHALL NOT BE ENLARGED OR "RUN OVER".
- 12. CONSTRUCTION SITES ARE REQUIRED TO HAVE EROSION CONTROL MATERIALS ON SITE DURING THE "OFF-SEASON".
- 13. DUST CONTROL IS REQUIRED YEAR ROUND.
- 14. USE OF PLASTIC SHEETING BETWEEN OCTOBER 1 & APRIL 10 IS NOT ACCEPTABLE, UNLESS FOR USE ON STOCKPILES WHERE THE STOCKPILE IS ALSO PROTECTED WITH FIBER ROLS CONTAINING THE BASE OF THE STOCKPILE
- 15. TREE PROTECTION SHALL BE IN PLACE BEFORE ANY DEMOLITION, GRADING, EXCAVATING OR GRUBBING IS STARTED.

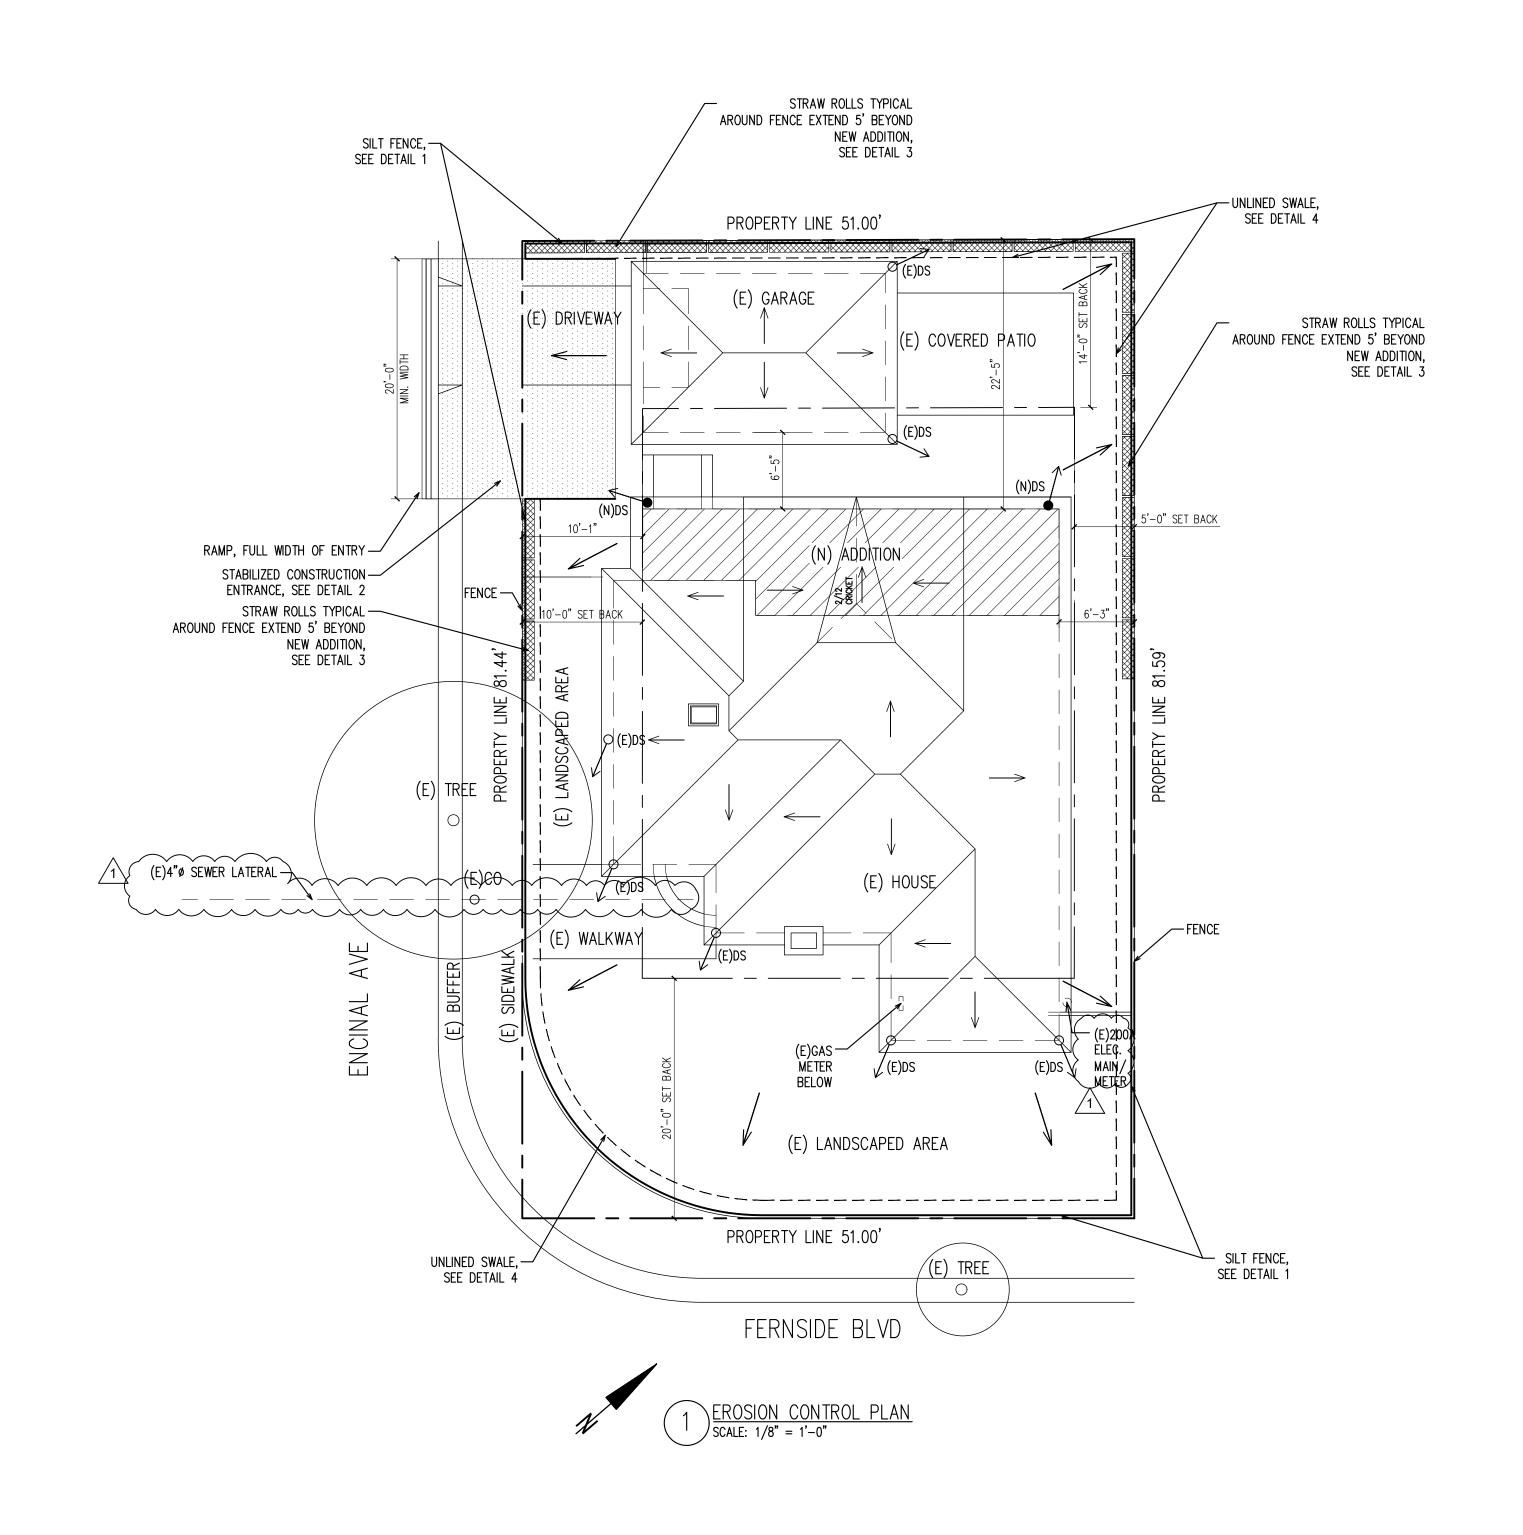

anura

REVISIONS

*1* 06/27/2025

<sup>2</sup> 07/25/2025 <u>/</u>3 08/25/2025

4 09/30/2025



ROMAIN CURTIS ARCHITECT #C35019 367 CIVIC DR #3, PLEASANT HILL, CA94523 phone: 510.612.0345

roman@anuradesign.com


REMODE ADE 130' AL

CA008 CHECKED BY CA007

ISSUE DATE 04/12/2024

1/4"=1'-0" ANURA JOB NO

CA2504-0002

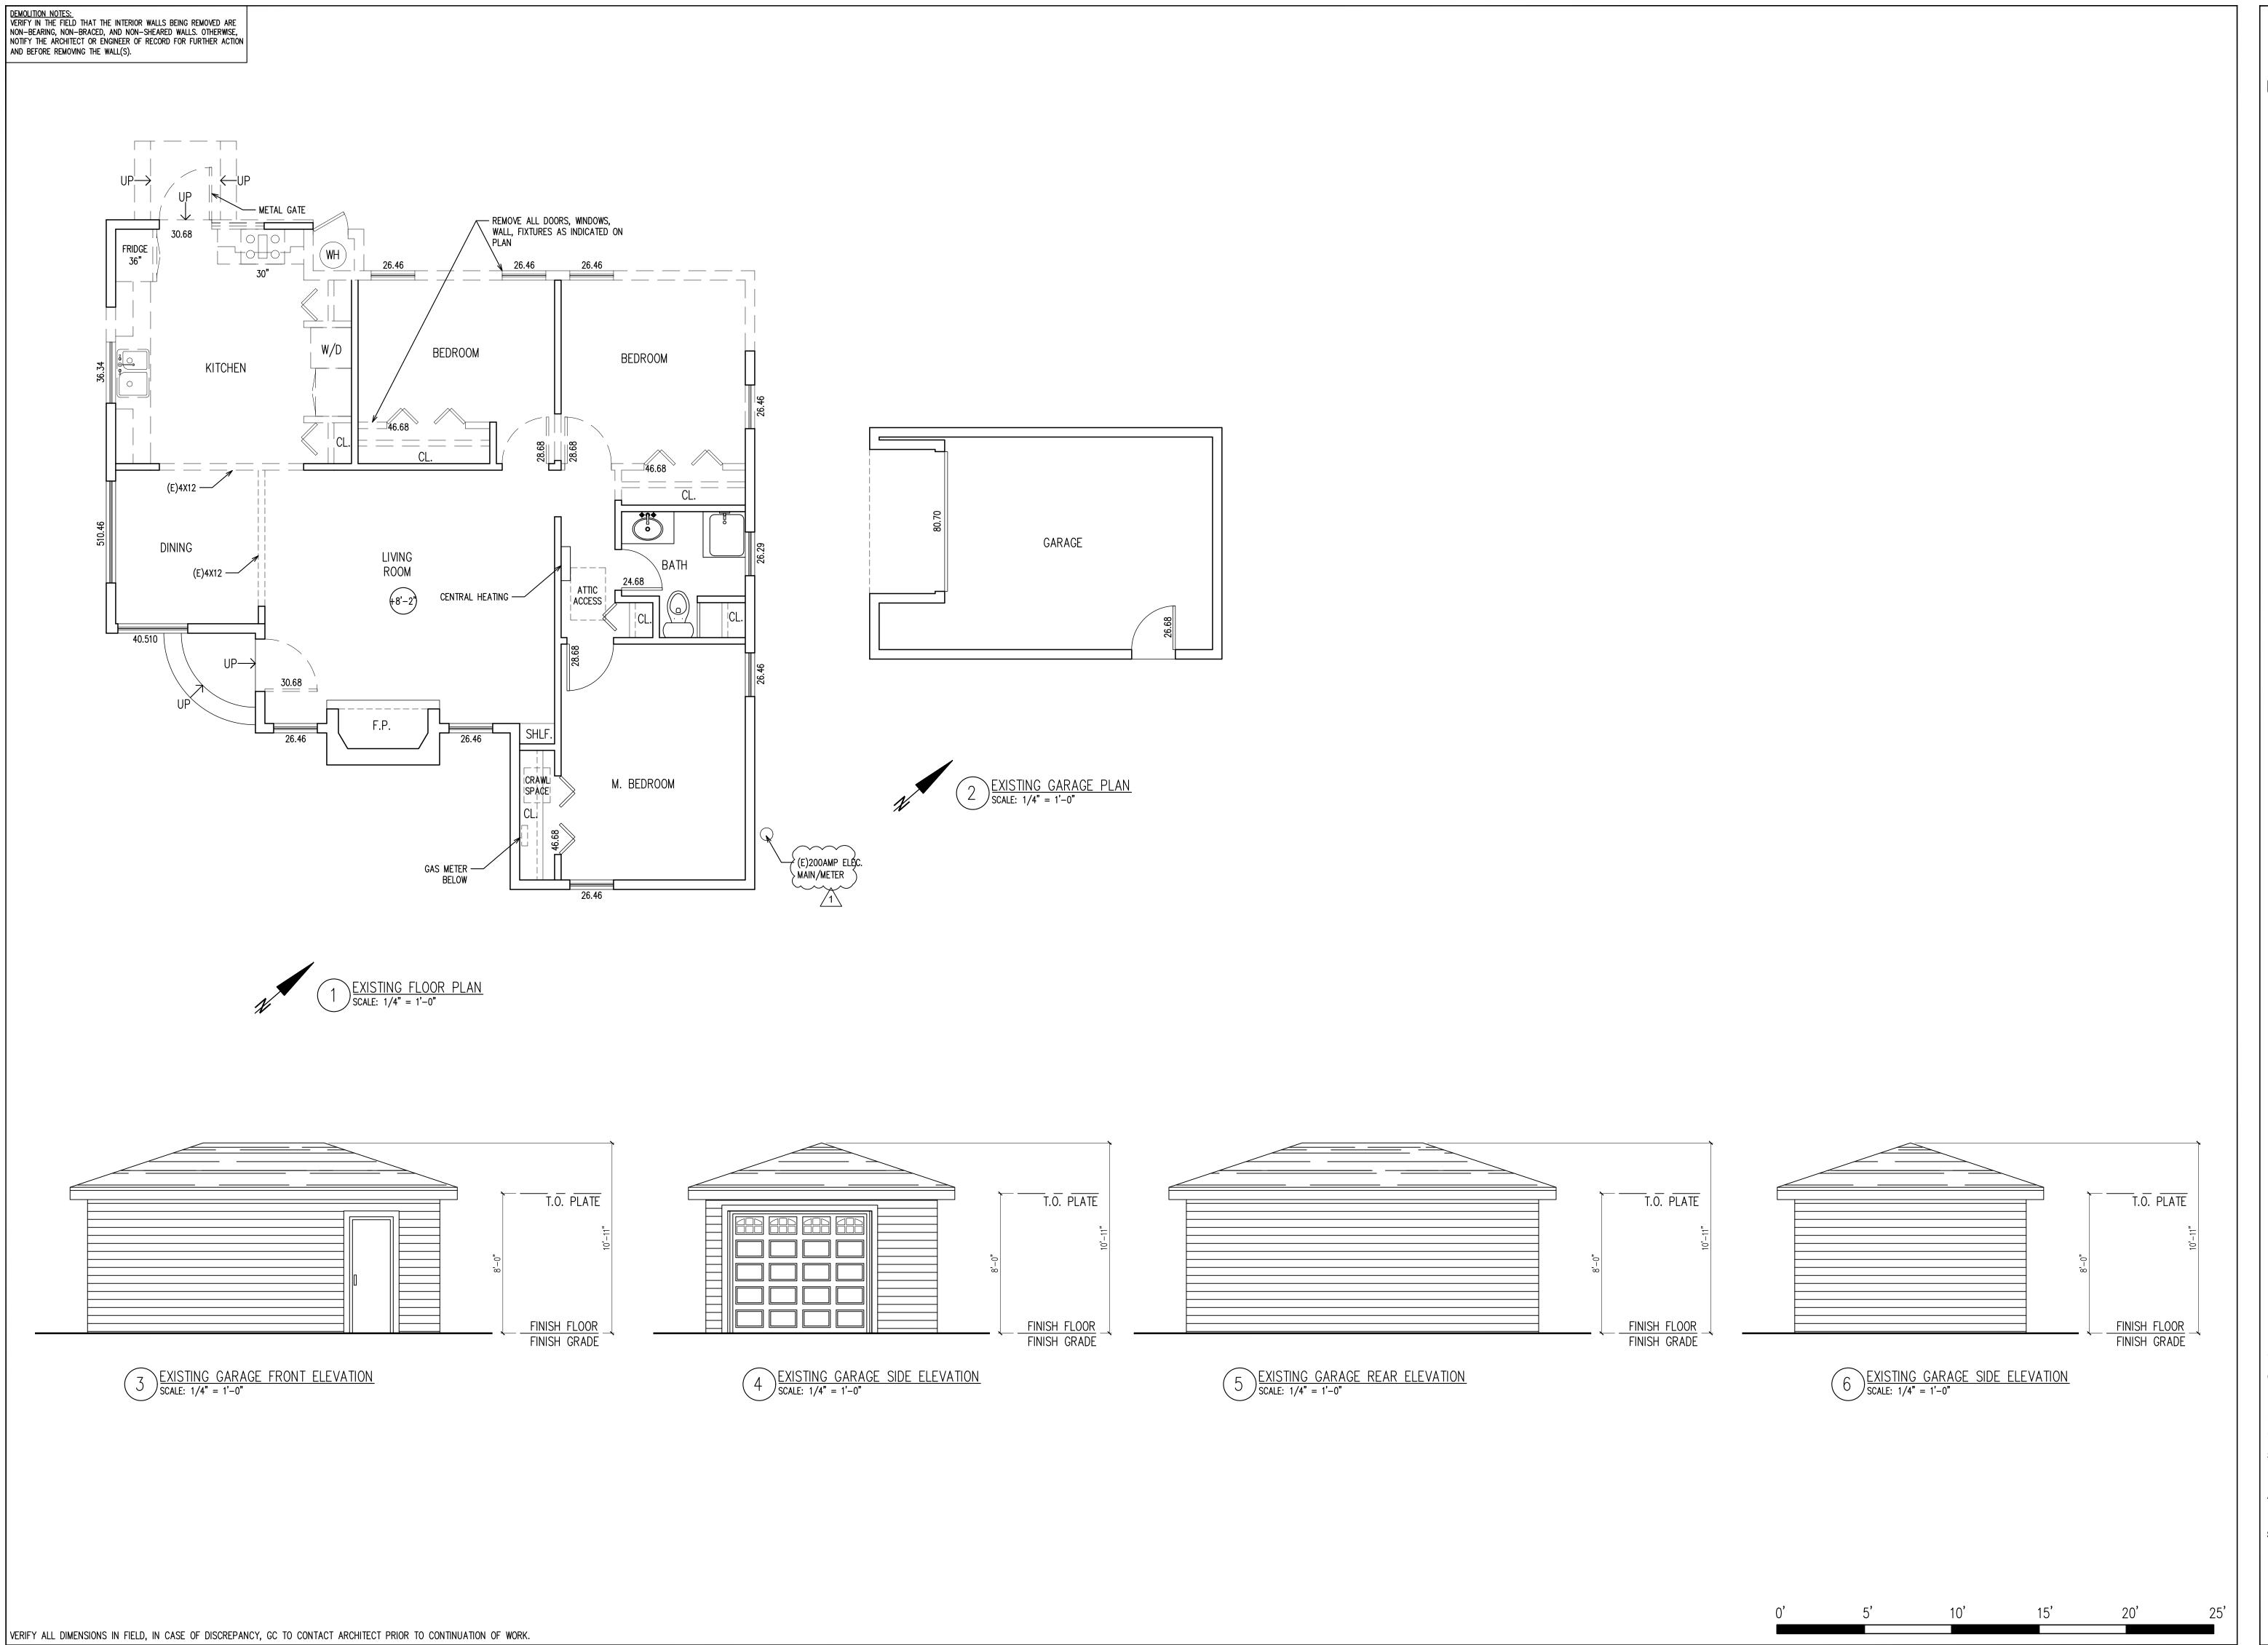

anura design

REVISIONS

*∕*1 06/27/2025

<u>2</u> 07/25/2025

3 08/25/2025 4 09/30/2025



ROMAIN CURTIS ARCHITECT #C35019 367 CIVIC DR #3, PLEASANT HILL, CA94523 phone: 510.612.0345

roman@anuradesign.com


ADDI 1301 I ALAI

**∞** EXISTING/
DEMOLITION PLANS &
ELEVATIONS


CA008 CHECKED BY CA007

ISSUE DATE 04/12/2024

SCALE 1/4"=1'-0"

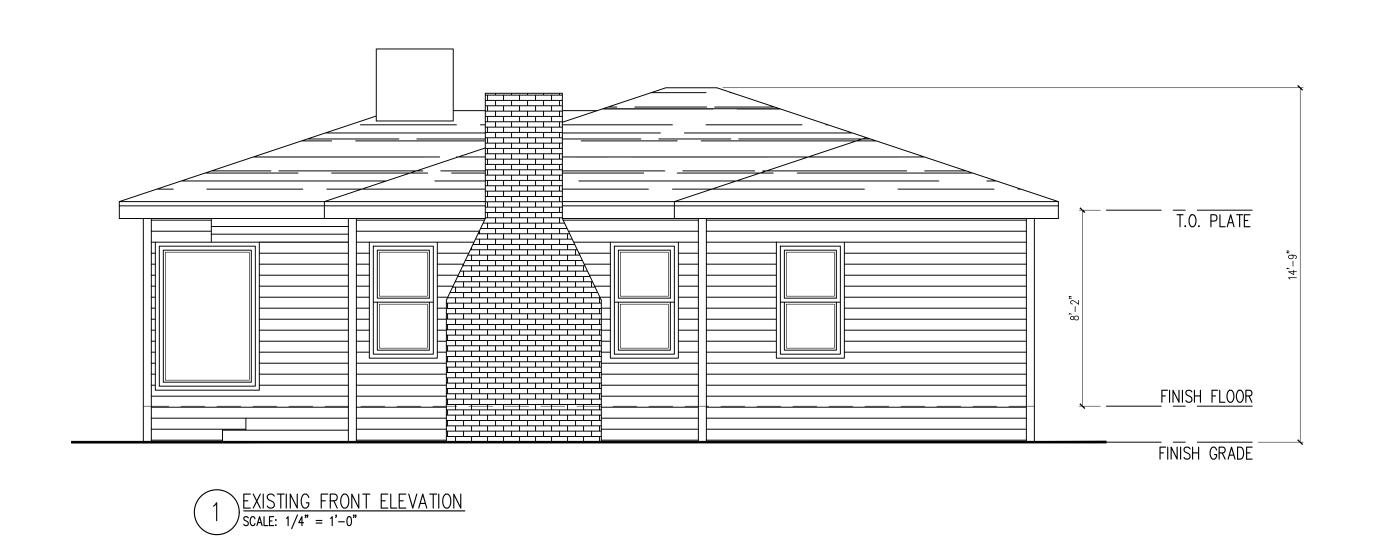



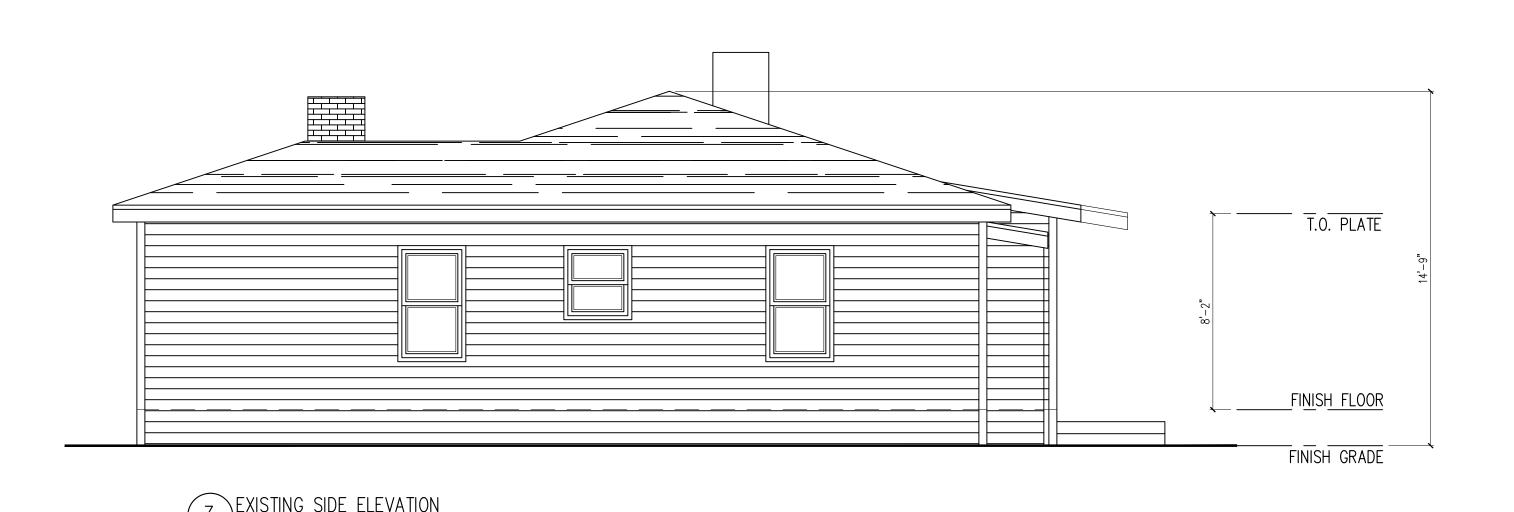



anura d e s i g n

REVISIONS

<u></u> 06/27/2025

<u>2</u> 07/25/2025 <u>3</u> 08/25/2025

<u>4</u> 09/30/2025



ROMAIN CURTIS
ARCHITECT #C35019
367 CIVIC DR #3,
PLEASANT HILL, CA94523
phone: 510.612.0345
roman@anuradesign.com

REMODEL 9450 ADDITION 1301 FERN ALAMEDA

EXISTING ELEVATIONS

CA008 CHECKED BY CA007

ISSUE DATE 04/12/2024

SCALE 1/4"=1'-0" ANURA JOB NO CA2504-0002

WINDOW SCHEDULE | QTY | WIDTH | HEIGHT | GLAZING ID I ROOM FRAME I KITCHEN SINGLE HUNG | FIBERGLASS | 1 | 4-6 | 3-6 | CLR I MUD ROOM GLASS DOOR FIBERGLASS | 3-4 | 6-8 | CLR STORAGE **TEMPERED** | 2-6 | 3-6 | CLR SINGLE HUNG FIBERGLASS 4 BEDROOM |DOUBLE HUNG | FIBERGLASS | 2 | 3-0 | 4-0 | CLR 1 | 2-0 | 3-0 | FROSTED TEMPERED I RATH SINGLE HUNG FIBERGLASS 6 BEDROOM IDOUBLE HUNG I FIBERGLASS | 1 | 4-6 | 4-0 | CLR SKYLIGHT FIXED | FIBERGLASS | 1 | 1-10 | 2-6 | CLR 7 | KITCHEN 

2x4 STUDS -

FLR-1 - R19 ROOF-1 - R30

# - (N) CONCRETE STAIRS LANDING TOTO WASHLET -LED MIRROR -(N)34.68 TFMP. GLASS **STORAGE** — 6'-0" HIGH WALL SCONCE M. BEDROOM ∖ M. BATH (₅) (1)(4)(13)(N)26.68 ROOM 5'-0" HIGH TV MOUNT OUTLET FRIDGE WARMER TOWEL RACK -DEDICATED LINE 20A BEDROOM KITCHFN (N)22x30 SKLT ) INSTANT $\odot$ GAS WATER $^{\prime}$ $\otimes$ $\odot$ L \_ \_ \_ \_ \_ \_ \_ \_ \_ \_ \_ \_ \_ \_ \_ FRIDGE (N)28.68(7) 220V <sub>-</sub> A DEDICATED LINE 20A W/D∉ ELECTRIC DRYER 30A — LIVING ROOM CENTRAL HEATING -ACCESS (N)30.68M. BEDROOM -(E)200AMP ELEC (E)GAS METER -MAIN/METER PROPOSED ELECTRICAL PLAN $\int SCALE: 1/4" = 1'-0"$

# VERIFY ALL DIMENSIONS IN FIELD, IN CASE OF DISCREPANCY, GC TO CONTACT ARCHITECT PRIOR TO CONTINUATION OF WORK.

WITH 16D NAILS AT 12" O.C., STAGGERED

ALL SHEAR WALLS SHALL BE 1/2" OSB. UON.

LAPPED AND NAILED OVER TOP PLATES, U.O.N.

OF 8" ABOVE ADJACENT FINISHED GRADE.

PRIOR TO PLACING CONCRETE.

ALL UNTREATED WOOD FRAMING SHALL BE A MINIMUM

ALL TIMBER LESS THAN 8" FROM FINISHED GRADE SHALL

BE PRESSURE TREATED. ALL SILL PLATE TO BE PT

EARTH ON WHICH CONCRETE FOUNDATIONS ARE TO BE

FRAMING (E.G., JOISTS, BEAMS, POSTS, DECKING) SHALL

BE OF APPROVED NATURALLY DURABLE OR PRESSURE

INCHES OR WIDER. NO POINT ALONG THE WALL LINE IS

MEASURED HORIZONTALLY FROM A RECEPTACLE OUTLET

POURED MUST WETTED NOT LESS THAN 24 HOURS

D00R-1

 $\int SCALE: 1/4" = 1'-0"$ 

(N)30.68

TIMBER FRAMING:
ALL FRAMING LUMBER SHALL BE DOUGLAS FIR GRADE STAMPED ACCORDING TO THE CURRENT GRADING RULES BEAMS AND STRINGERS — #1 OR STRUCTURAL AS CEILING JOISTS AND RAFTERS - #2 OR #1 AS FLOOR FRAMING SHALL BE #2 @ 16" O.C. U.O.N. DOOR AND WINDOW HEADERS - #2

PLATES AND BLOCKING - #2 .LL LUMBER SHALL BE MINIMUM DOUGLAS FIR #2 WWPA ALL SUB-FLOORS SHALL BE 34" TONGUE AND GROOVE EDGE GOLD OSB, STAGGERED JOINTS. GLUE WITH OSI CONSTRUCTION ADHESIVE. NAIL WITH 10D NAILS AT 6"

O.C. AT EDGES AND 12" O.C. THROUGHOUT.

ELECTRICAL NOTES:

- AFCI PROTECTION IS REQUIRED FOR ALL RECEPTACLES EXCEPT FOR THOSE LOCATED OUTSIDE, IN BATHROOMS, GARAGES, ATTICS AND BASEMENTS. TAMPER RESISTANT RECEPTACLES ARE REQUIRED IN ALL LOCATIONS EXCEPT AT OUTLETS LOCATED MORE THAN 5 1/2 FEET ABOVE THE FLOOR, OUTLETS THAT ARE A PART OF A LUMINAIRE, OUTLETS DEDICATED TO

BASEMENTS, CRAWL SPACES, KITCHEN AND WET BAR

COUNTER TOP SURFACES, GARAGES, ACCESSORY

BUILDINGS NOT INTENDED AS HABITABLE ROOMS.

- RECEPTACLES LOCATED IN DAMP OR WET LOCATIONS SHALL HAVE AN ENCLOSURE THAT IS WEATHERPROOF AND SHALL BE LISTED WEATHER RESISTANT TYPE. - CLARIFY RECEPTACLE OUTLET LOCATIONS: A) RECEPTACLES SHALL BE INSTALLED SO THAT NO POINT MEASURED HORIZONTALLY ALONG THE FLOOR IN ANY WALL SPACE IS OVER 6 FEET FROM THE RECEPTACLE (ALLOWING 12 FEET MAX. BETWEEN RECEPTACLES ON THE SAME WALL). APPLIANCES THAT CANNOT BE EASILY MOVED AND AT B) RECEPTACLES SHALL BE LOCATED ALONG ANY WALL OUTLETS LOCATED IN ATTICS. THAT IS 2 FEET OR MORE IN LENGTH. GECL PROTECTION REQUIRED FOR RECEPTACLES C) RECEPTACLE OUTLETS SHALL BE INSTALLED AT EACH LOCATED OUTDOORS, IN BATHROOMS, UNFINISHED WALL COUNTER SPACE THAT IS 12

MORE THAN 24 INCHES

DOUBLE FLOOR JOISTS BELOW PARALLEL PARTITIONS TREATED WOOD. FAVOR PLYWOOD INSTEAD OF OSB FOR SHEATHING, AS OSB CAN LOOSE ITS STRUCTURAL STRENGTH ONCE IF PROVIDE HARDWARE MANUFACTURED BY SIMPSON AS REQUIRED, INSTALL PER MANUFACTURER'S INSTRUCTIONS. STRUCTURAL DETAIL: FLOOR JOISTS AND CEILING JOISTS SHALL BE SIDE FOR STRUCTURAL, AND/OR SEISMIC RETROFIT, SHEAR

MINIMUM 12"

IN THAT SPACE.

CEILINGS: AND

THE REQUIREMENTS FOR:

WATER SHUTOFF LEAK DETECTOR -

SYSTEM ON THE MAIN WATER

WHOLE HOUSE FILTER -SYSTEM ON THE MAIN

(E)GAS METER

L CONCRETE SHALL BE MINIMUM 2,500 PSI STRENGTH WITHIN 28 DAYS. - UON SSD REINFORCING STEEL LARGER THAN # 5 SHALL BE GRADE 60 DEFORMED BARS CONFORMING TO ASTM A415, 30,000 PSI. SPLICES = 40 BAR DIAMETERS, BENDS

INSULATION CONTACT (IC) LABELING: SEALED WITH A

GASKET OR CAULKED BETWEEN HOUSING AND CEILING,

AND SHALL BE CERTIFIED TO COMPLY WITH SECTION

110.9 AND ALLOW BALLAST MAINTENANCE AND

WALL DETAILS AND LOCATION, AND FOUNDATION DESIGN,

SEE STRUCTURAL DESIGN WHEN PROVIDED.

REPLACEMENT TO BE READILY ACCESSIBLE TO BUILDING - ALL INSTALLED LUMINAIRES SHALL BE HIGH EFFICACY AND SHALL BE LISTED BY SOURCE TYPE - SCREW BASED LUMINAIRES SHALL MEET ALL THE A) SHALL NOT BE RECESSED DOWN LIGHT LUMINAIRES IN B) SHALL CONTAIN LAMPS THAT COMPLY WITH CEC RÉFERENCE JOINT APPENDIX JA8; AND C) THE INSTALLED LAMPS SHALL BE MARKED WITH JA8-2022 OR JA8-2022-E. LUMINAIRES RECESSED INTO CEILINGS MUST MEET ALL

INSPECTION.

6'-4"

HEATED FLOOR UNDER TILE

CURBLESS SHOWER -

BEDROOM

SHELF

W/D

M. BEDROOM

10'-6"

REINFORCEMENT OF CONCRETE SLAB AND SLAB

MIN. 4" THICK WITH # 4 BARS AT 18" O.C. E/W

EARTH ON WHICH CONCRETE FOUNDATIONS ARE TO BE

POURED MUST BE WETTED NOT LESS THAN 24 HOURS

STAKES OR OFFSET STAKES MUST BE ESTABLISHED BY

CALIFORNIA AND VERIFIED BY THE FIELD INSPECTOR TO

LOCATED IN ACCORDANCE WITH THE APPROVED PLANS,

AT THE TIME OF FOUNDATION INSPECTION CORNER

A LAND SURVEYOR REGISTERED IN THE STATE OF

ENSURE THAT NEW STRUCTURE CONSTRUCTION IS

AND DOES NOT ENCROACH IN THE SETBACK.

THICKNESS TO BE AS NOTED ON DRAWINGS,

PROVIDE GROOVED JOINTS AT 10'-0" O.C.

PRIOR TO PLACING CONCRETE.

REMOVE CROWN MOLDING —

ACCESS

I⊤CRÁŴLi

I ISPACEIL18

SHOWER HEADHAND HOLDER DIVERTER —

4'-3"

|| WIN-|6 |

GAS WATER

· (E)200AMP ELEC.

MAIN/METER

HEATER

(N)20 30  $\frac{WIN-5}{1}$ 

OCCUPANTS FROM BELOW, BE RATED FOR FLEVATED TEMPERATURE, MUST BE INSTALLED BY FINAL -AT LEAST ONE LIGHT IN BATHROOMS, GARAGES, LAUNDRY AND UTILITY ROOMS SHALL BE CONTROLLED BY A VACANCY SENSOR CERTIFIED TO COMPLY WITH SECTION 119(D) THAT DOES NOT TURN ON AUTOMATICALLÝ OR HAVE AN ALWAYS ON OPTION.

DIMMÉRS OR VACANCY SENSORS SHALL CONTROL ALL LUMINAIRES REQUIRED TO HAVE LIGHT SOURCES COMPLIANT WITH REFERENCE JOINT APPENDIX JA8 (INCLUDING CEILING RECESSED DOWNLIGHT LUMINAIRES AND GU-24 SOCKETS CONTAINING LED LIGHT SOURCES) AND THEY SHALL COMPLY WITH SECTION 119(D) AND NOT TURN ON AUTOMATICALLY OR HAVE AN

FLASHING:
FLASHING TO BE INSTALLED TO ADEQUATELY PREVENT

WINDOWS:
ALL NEW WINDOWS AND DOORS W/ GLASS WINDOW TO MOISTURE FROM ENTERING THE WALL AT PENETRATIONS OF THE BUILDING ENVELOPE INCLUDING BUT NOT LIMITED NFRC RATED - TYP. TO THE LOCATIONS AND FLASHING INSTALLATION REQUIREMENTS.

IN BED ROOMS, AT LEASE ONE WINDOW OR DOOR TO EXTERIOR TO COMPLY WITH EGRESS REQUIREMENTS. ONE WINDOW IN EACH BEDROOM MUST COMPLY W/ THE MIN CLEAR OPENING HEIGHT OF 24" MIN CLEAR OPENING WIDTH OF 20" MIN CLEAR OPENABLE AREA NOT LESS THAN 5.7 SF. BOTTOM OF CLEAR OPENING NOT GREATER THAN 44" ABOVE THE FLOOR - GC TO VIF

ALWAYS ON OPTION. EXCEPTIONS: LUMINAIRES IN CLOSETS LESS THAN 70 SQUARE FEET; LUMINAIRES IN -RECESSED LIGHT FIXTURES SHOULD BE BOXED IN. -DOOR BELL AND CHIME SHALL BE PROVIDED AS A STANDARD ITEM. PROVIDE ALL ELECTRICAL FIXTURES AND APPLIANCES AS SELECTED BY OWNERS — GC TO VERIFY ALL FIXTURE MEET CODE. -FOR REMODELED AREAS: SPECIFY RECEPTACLE OUTLETS IN THE FOLLOWING LOCATIONS, AS SHOWN ON AND MOTION SENSOR OR BY PHOTOCONTROL AND PLANS, 12' O.C. MAX, AND WITHIN 6' FROM THE ENDS OF WALLS. ANY WALL SPACE 2 OR MORE FEET WIDE. AT LEAST ONE WALL SWITCH—CONTROLLED LIGHTING OUTLET SHALL BE INSTALLED AT OUTDOOR ENTRANCES.

HAVE U FACTOR AS NOTED ON ENERGY REPORT & BE FLOORS W/ R-19 ALL GLASS IN (N) INTERIOR OR EXTERIOR DOORS TO BE

EXTERIOR 7/8-INCH TEXTURED STUCCO SHALL BE APPLIED ACCORDING TO THE TSIB RECOMMENDATIONS, TECHNICAL SERVICES INFORMATION BUREAU — CHAPTER 6 - THREE-COAT PLASTER-STUCCO DETAILS ALL EXTERIOR WALLS/CEILINGS/FLOORS (OR WALLS

ADJACENT TO UNCONDITIONED SPACE) THAT ARE OPENED OUTSIDE. UP DURING CONSTRUCTION WILL BE INSULATED. - MANUAL ON AND OFF SWITCHES MUST NOT OVERRIDE SHALL BE ZERO CLEARANCE IC LISTED AND CERTIFIED ANY CONTROL THAT OVERRIDES THE AUTOMATIC CONTROLS TO ON MUST AUTOMATICALLY REACTIVATE THOSE CONTROLS WITHIN SIX HOURS - RESIDENTIAL OUTDOOR LIGHTING PERMANENTLY

PATHS BETWEEN CONDITIONED AND UNCONDITIONED SPACES. SHALL NOT CONTAIN SCREW BASE SOCKETS ALL LIGHTING SHALL BE HIGH EFFICACY AND MEET MOUNTED TO THE DWELLING OR TO OTHER BUILDINGS ON THE REQUIREMENTS OF SECTION 150.0 (K) AND JOINT THE SAME LOT SHALL BE CONTROLLED BY A MANUAL ON APPENDIX JAB. MANUFACTURERS MUST TEST THEIR AND OFF SWITCH AND CONTROLLED BY A PHOTOCELL SUBMIT TEST RESULTS TO THE CALIFORNIA AUTOMATIC TIME SWITCH CONTROL OR BY ASTRONOMICAL TIME CLOCK CONTROL THAT OF COMPLIANT PRODUCTS CAN BE FOUND AT AUTOMATICALLY TURNS THE OUTDOOR LIGHTING OFF HTTPS: //CACERTAPPLIANCES.ENEGY.CA.GOV. DURING DAYLIGHT HOURS OR BY ENERGY MANAGEMENT - ALL ELECTRICAL INSTALLATION SHALL MEET THE CONTROL SYSTEM MINIMUM OR MAXIMUM ALLOWED IN THE 2022 - LUMINARIES RECESSED IN INSULATED CEILINGS SHALL MANDATORY MEASURES - NO EXCEPTION. COMPLY WITH THE FOLLOWING: - GAS LINE SIZING CALCULATIONS TO BE A DEFERRED

2X4 FRAMED WALLS WITH A MINIMUM OF R-15, AT LEAST 1.5 SQ.FT. PROVIDE MECHANICAL VENTILATION WITH 2X6 FRAMED WALLS WITH R-21. AN EXHAUST CAPACITY OF AT LEAST 50 CFM. EXHAUST FAN SHALL BE SWITCHED SEPARATELY FROM CEILINGS WITH R-30 (ZONE 3) R-38 (ZONE 12) OR AS OTHERWISE NOTED ON PLAN OR ENERGY REPORT. EACH BATHROOM CONTAINING A BATHTUB, SHOWER OR FOR ALL NEW WALLS, FLOORS, ROOF, SEE ENERGY TUB SHOWER COMBINATION SHALL BE MECHANICALLY REPORT FOR INSULATION REQUIREMENTS. VENTILATED FOR PURPOSES OF HUMIDITY CONTROL WINDOW OPERATION IS NOT A PERMISSIBLE METHOD OF

MECHANICAL VENTILATION SYSTEM PROVIDED IN THE BATHROOM/WATER CLOSET SPACES SHALL BE A MINIMUM 50-CU. FT. PER MINUTE (FOR INTERMITTENT VENTILATION), OR 25-CU. FT. PER MINUTE FOR CONTINUOUS VENTILATION. THE VENTILATION AIR FROM THIS SPACE SHALL BE EXHAUSTED DIRECTLY TO THE WHEN THE BATHROOM OR TOILET ROOM IS NOT EQUIPPED

SUBMITTAL ITEM AND PROVIDED BY GC. THE AUTOMATIC CONTROL FUNCTIONS LISTED ABOVE AND AIR TIGHT. BE SEALED WITH GASKET OR CAULK BETWEEN DUCT SIZING AND DUCT LAYOUT TO BE A DEFERRED LUMINAIRE HOUSING AND CFILING AND AT ALL AIR LEFK SUBMITTAL ITEM AND PROVIDED BY GC. - IC RATED, ELECTRONIC BALLAST AND AIR-TIGHT (AT) FIXTURES FOR RECESSED LUMINARIES - ALL ADDED/REPLACED BRANCH CIRCUITS THAT SUPPLY 120 VOLT, SINGLE PHASE, 15 AND 20 AMPERE OUTLETS INSTALLED IN DWELLING UNIT FAMILY ROOMS, DINING ROOMS, LIVING ROOMS, PARLORS, LIBRARIES, DENS, BEDROOMS, SUNROOMS, PRODUCTS AT AN ACCREDITED TEST LABORATORY AND RECREATION ROOMS, CLOSETS, HALLWAY, OR SIMILAR ROOMS OR AREA SHALL BE ARC-FAULT CIRCUIT INTERRUPTER (AFCI) ENERGY COMMISSION TO GAIN JA8 CERTIFICATION. A LIST ALL ADDED/REPLACED 125-VOLT; 15- AND 20-AMPERE RECEPTACLÉS SHALL BE LISTED TAMPER-RESISTANT RECEPTACLES.

EXHAUST SYSTEM.

(N) BATHROOM AND POWDER ROOM ADJACENT TO

GÁRAGE AND FAMILY ROOM THAT DO NOT HAVE A

WINDOW TO HAVE ARTIFICIAL LIGHT AND A LOCAL

THE MINIMUM LOCAL EXHAUST RATES SHALL BE 50

CUBIC FEET PER MINUTE FOR INTERMITTENT VENTILATION

WITH A WINDOW THAT PROVIDES A VENTILATION OPENING OF OR 20 CUBIC FEET PER MINUTE FOR CONTINUOUS VENTILATION. EXHAUST AIR FROM THE SPACE SHALL BE EXHAUSTED DIRECTLY TO THE OUTDOORS. DOMESTIC DRYER MOISTURE EXHAUST DUCTS SHALL NOT EXCEED A TOTAL COMBINED HORIZONTAL AND VERTICAL SHALL BE A MINIMUM OF 3 FEET FROM PROPERTY LINES LENGTH OF 14 FEET (4267 MM). INCLUDING TWO 90 DEGREE (1.57 RAD) ELBOWS. A LENGTH OF 2 FEET (610 UTILITY FANS, ETC., MUST BE 3 FEET AWAY FROM MM) SHALL BE DEDUCTED FOR EACH 90 DEGREE (1.57 RAD) ELBOW IN EXCESS OF TWO. NOT LESS THAN A 4 PROVIDING BATHROOM EXHAUST FOR HUMIDITY CONTROL. EXHAUST RATE OF RESTROOM FANS AT (F) BATHROOM. APPROVED MATERIAL SHALL BE INSTALLED IN ACCORDANCE WITH THE CODE.

> VENTILATION TO MEET INDOOR AIR QUALITY (IAQ) REQUIREMENTS. THE FAN SHOULD BE ON AT ALL TIMES WHEN THE BUILDING IS OCCUPIED.

FLUORESCENT LIGHT

**ELECTRICAL SYMBOLS:** CEILING FAN DIMMER SWITCH RECEPTACLE 220 RECEPTACLE (LOW VOLTAGE) GROUND FAULT INTERRUPTER  $\Phi_{\scriptscriptstyle \rm F}$ SMOKE ALARM RECESSED LIGHTING CHANDELIER FAN CLG MOUNT WALL MOUNT HANGING LIGHT

PROVIDE WHOLE HOUSE FAN (WHF) WHEN INDICATED ON

OR ANY OPENINGS INTO THE BUILDING (I.E., BATH AND DOORS, WINDOWS, OPENING SKYLIGHTS OR ATTIC VENTS). FLUE / VENT FOR DRYER 14'-0" LONG MAX. END MUST INCH DIAMETER (102 MM) MOISTURE EXHAUST DUCT OF BE 3'-0" MIN FROM ANY OPENING. IF LONGER THAN 14'-0" ADD MECHANICAL FAN TO BE AUTOMATICALLY ON WHEN W/D ARE IN USE (N) METAL FLUE TO BE INSULATED AND 4" CLR MIN ALL TIMBER - INSTALL PER GC TO PROVIDE AN EXHAUST FAN FOR WHOLE-BUILDING MANUFACTURER SPECIFICATIONS INSULATE ALL FLUE & VENT TO PREVENT CONDENSATION.

TERMINATION OF ALL ENVIRONMENTAL AIR DUCT EXHAUST

VANITY LIGHTING CEILING FAN W/LIGHT UNDER CABINET LIGHTING CARBON MONOXIDE ALARM WATER PROOF EXT. LIGHT EVCS EV CHARGING STATION \_ • FLOOR PLAN KEY NOTES:

**ELECTRICAL PLAN KEY NOTES:** 

ALARMS IN THE INDIVIDUAL UNIT.

FROM THE STREET

APPLIANCE.

(N) BATHROOM

ALL BATHROOMS.

BACKDRAFT DAMPER.

EXTENDED PERIOD OF TIME.

150.0(K) 2 (B)).

SEE ATTACHED MANDATORY MEASURES TO BE FOLLOWED

OR/AND DONE DURING CONSTRUCTION PER 2022 CBC

CONTRAST W/ BACKGROUND COLOR, MIN 4" HIGH, MIN

3) NEW CARBON MONOXIDE ALARMS AND SMOKE DETECTOR

THEY SHALL BE INTERCONNECTED IN A MANNER THAT

SMOKE ALARMS SHALL BE INSTALLED A MINIMUM

ACTIVATION OF ONE ALARM SHALL ACTIVATE ALL OF THE

OF 20 FEET FROM A PERMANENTLY INSTALLED COOKING

APPLIANCE. IONIZATION SMOKE ALARMS AND PHOTOELECTRIC

SMOKE ALARMS ARE PERMITTED TO BE INSTALLED 10 FEET

OR GREATER FROM A PERMANENTLY INSTALLED COOKING

PROVIDE AT LEAST ONE 20-AMP CIRCUIT AT BATHROOM;

LUMINAIRES INSTALLED IN WET OR DAMP LOCATIONS MUST BE

MECHANICAL VENTILATION (EXHAUSTED FAN) IS REQUIRED IN

BATHROOM EXHAUST FANS WHICH EXHAUST DIRECTLY FROM

BATHROOMS SHALL COMPLY WITH CGBS 4.506.1 AND SHALL

INCLUDE THE FOLLOWING: HAVE AN EXHAUST RATE OF MIN

UNLESS FUNCTIONING AS A COMPONENT OF A WHOLE HOUSE

HUMIDISTAT CONTROLS SHALL BE CAPABLE OF ADJUSTMENT BETWEEN A RELATIVE HUMIDITY OF 50% TO 80%. THE

CONTROL MAY BE A SEPARATE COMPONENT OR INTEGRAL TO

THE EXHAUST FAN. BATHROOM EXHAUST FAN CONTROLS

EXHAUST FANS. FOR AN EXHAUST FAN WITH AN INTEGRAL

LIGHTING SYSTEM, IT SHALL BE POSSIBLE FOR THE LIGHTING

ALL LIGHTING SHALL BE SWITCHED SEPARATELY FROM

SYSTEM TO BE MANUALLY TURNED ON AND OFF WHILE

IF FAN IS PART OF INTERMITTENT WHOLE HOUSE FAN

EXHAUST FAN SHOWING IN THE BATHROOMS SHALL BE

SWITCHED SEPARATELY FROM LIGHTING SYSTEM. (CENC

TWO SMALL APPLIANCE OUTLET CIRCUITS, 20-AMP EACH,

ARE REQUIRED IN KITCHEN; CIRCUITS SHALL BE BALANCED

AND HAVE NO OTHER OUTLETS. PROVIDE INDIVIDUAL

DEDICATED CIRCUITS, MINIMUM 15 AMPS EACH, FOR ALL MAJOR APPLIANCES AND AS FOLLOW: DISHWASHER, GARBAGE

KITCHEN RECEPTACLE OUTLETS SERVING COUNTERTOPS

INCHES. SHALL BE INSTALLED IN EACH WALL SPACE

WIDER SO NO POINT ALONG THE WALL IS MORE THAN 24

SEPARATED BY RANGE TOPS, REFRIGERATORS OR SINKS.

SHALL BE INSTALLED NOT MORE THAN 20 INCHES ABOVE

PENINSULA COUNTER SPACE WITH A LONG DIMENSION OF 24

INCHES MINIMUM AND A SHORT DIMENSION OF 12 INCHES OR

THE KITCHEN EXHAUST SYSTEM SHALL BE DUCTED WITH A

A MINIMUM EXHAUST RATE OF 100 CFM AND BE PROVIDED

EXHAUST FANS AND UNDER CABINET LIGHTING SHALL BE SWITCHED SEPARATELY FROM LIGHTING SOURCE. KITCHEN SHALL HAVE AN EXHAUST FAN DUCTED TO THE

OUTSIDE WITH A MINIMUM VENTILATION RATE OF 100 CEM

STANDARD 62.2 TABLE 7.1. [\$150(0) AND \$150(G) CENC]

KITCHEN HOOD SHALL HAVE A MINIMUM 110 CFM EXHAUS'

RATE FOR ELEC RANG, AND 250 CFM FOR GAS RANGE, AND

HOOD TO HAVE BACKDRAFT DAMPER. IF HOOD IS PART OF

INTERMITTENT WHOLE HOUSE FAN VENTILATION SYSTEM PER

PROVIDE AT LEAST ONE 30-AMP CIRCUIT AT LAUNDRY ROOM;

LUMINAIRES INSTALLED IN WET OR DAMP LOCATIONS MUST BE

HIGH EFFICACY AND CONTROLLED BY VACANCY SENSORS.

OUTDOOR LIGHTING SHALL BE CONTROLLED BY MANUAL

MOTION SENSOR OR PHOTOCONTROL TIME SWITCH

(N) GAS TANKLESS WATER HEATERS SHALL HAVE A DEDICATED GAS LINE DUE TO LARGE GAS DEMAND. REFER TO

THE MANUFACTURER'S INSTALLATION MANUAL FOR MINIMUM

HOT WATER PIPE INSULATION SHALL HAVE A MINIMUM WALL

THICKNESS OF NOT LESS THAN THE DIAMETER OF THE PIPE

HOT WATER PIPING WITH A NOMINAL DIAMETER EQUAL TO OR GREATER THAN 3/4" AND LESS THAN 1" SHALL HAVE A MIN, INSULATION THICKNESS OF 1" OR A MIN INSULATION

ON/OFF SWITCH AND CONTROLLED BY PHOTOCELL AND

CONTROL/ASTRONOMICAL TIME CLOCK/ENERGY MANAGEMENT

OUTSIDE WITH A MINIMUM VENTILATION RATE OF 50 CFM. THE

DUCTING SHALL BE SIZED ACCORDING TO ASHRAE STANDARD

ASHRAE 62.2, MAXIMUM SOUND RATING OF 3-SONES IS

CIRCUIT SHALL HAVE NO OTHER OUTLETS.

PROVIDE 1 EXHAUST FAN DUCTED TO THE

62.2 -TABLE 7.1. [\$150(0) CENC]

0) WEATHERPROOF EXTERIOR GRADED OUTLET

FOR PIP UP TO 2" IN DIAMETER

MARKED - SUITABLE FOR WET/DAMP LOCATIONS. LIGHTS AT LAUNDRY ROOMS, AND UTILITY ROOMS SHALL BE

THE DUCTING SHALL BE SIZED ACCORDING TO ASHRAE

THE COUNTERTOP, AT LEAST ONE RECEPTACLE OUTLET SHALL RE INSTALLED AT FACH ISLAND AND EACH

GREATER; PENINSULA COUNTER TOPS ARE MEASURED

RATING OF 3-SONES IS ALLOWED AT 100 CFM.

CONTROLLED BY VACANCY SENSORS.

DISPOSAL, HOOD, REFRIGERATOR, ETC.

FROM THE CONNECTING EDGE.

WITH A BACK-DRAFT DAMPER.

ALLOWED AT 100 CFM.

(N) LAUNDRY AREA

8) VACANCY SENSOR

CONTROLS SYSTEM.

11) (N) 100 AMP SUB-PANEL

R-VALUE OF 7.7

WIRING

VENTILATION SYSTEM PER ASHRAE 62.2, MAXIMUM SOUND

LIGHTS AT BATHROOM ROOMS SHALL BE HIGH EFFICACY AND

ALLOWING THE FAN TO CONTINUE TO OPERATE FOR AN

MUST COMPLY WITH ONE OF THE FOLLOWING:

50 CFM AND BE ENERGY STAR COMPLIANT AND HAVE A

VENTILATION SYSTEM FANS MUST BE CONTROLLED BY A HUMIDISTAT WHICH SHALL BE READILY ACCESSIBLE.

4) ARC FAULT CIRCUIT INTERRUPTERS IN ALL ROOMS — UON

CIRCUIT SHALL HAVE NO OTHER OUTLETS.

MARKED - SUITABLE FOR WET/DAMP LOCATIONS.

STROKE OF 1/2" AND BE ILLUMINATED, AND CLEARLY VISIBLE

SHALL RECEIVE THEIR PRIMARY POWER FROM THE BUILDING

WIRING AND SHALL BE EQUIPPED WITH A BATTERY BACK-UP.

2) APPROVED ADDRESS NUMBER FOR EACH UNIT TO BE

SEE ATTACHED MANDATORY MEASURES TO BE FOLLOWED OR/AND DONE DURING CONSTRUCTION PER 2022 CBC

) VIF & INSTALL INSTANT GAS SHUT OFF

CEMENT BACKER BOARD 30" DIAM. - CLR

SHOWER COMPARTMENTS, CRC R702.3.7

MIN IN FRONT

TEMP. GLASS

APPROVED ADDRESS NUMBER FOR EACH UNIT TO BE

CONTRAST W/ BACKGROUND COLOR, MIN 4" HIGH, MIN

-SHOWER COMPARTMENT TO HAVE A MIN. FINISHED INTERIOR

OF 1,024 SQ INCHES. ALL WALLS ADJACENT TO SHOWER TO

ALL WALLS ADJACENT TO TUB TO A HEIGHT OF 72" ABOVE

GYPSUM BOARD USED AS BACKER SHALL NOT BE INSTALLED

TOILET TO HAVE 15" CLR MIN. OC. EACH SIDE AND 24" CLR

PUT FOAM INSULATION AT ALL WALL AROUND LAUNDRY

100 SQUARE INCHES IN DOOR PER CMC 504.3.2. FOR

AT LAUNDRY ROOM PROVIDE A MINIMUM SIZED OPENING OF

(N) FLUE / VENT FOR DRYER 14'-0" LONG MAX. END MUST

BE 3'-0" MIN FROM ANY OPENING. IF LONGER THAN 14'-0"

ADD MECHANICAL FAN TO BE AUTOMATICALLY ON WHEN W/D

1/2 PLY WOOD SHEATHING - R-21 INSULATION UON IN T24

SIDING AND TRIM OR STUCCO TO MATCH (E) - UON

SOIL TO SLOPE AWAY FROM FOUNDATION 10' MIN AT 5%

(N) METAL FLUE TO BE INSULATED AND 4" CLR MIN ALL

TIMBER - INSTALL PER MANUFACTURER SPECIFICATIONS

A HEIGHT OF 72" ABOVE DRAIN TO BE TILED ON FIBER

DRAIN TO BE TILED ON FIBER CEMENT BACKER BOARD

OVER A CLASS I OR II VAPOR RETARDER AT TUB OR

DRYWALL MUST CONTINUE BEHIND TUB/SHOWERS.

STROKE OF 1/2" AND BE ILLUMINATED. AND CLEARLY VISIBLE

06/27/2025 07/25/2025

anura

design

REVISIONS

08/25/2025

09/30/2025



**ROMAIN CURTIS** ARCHITECT #C35019 367 CIVIC DR #3. PLEASANT HILL, CA94523

ALL SILL PLATE TO BE PT WOOD - NO EXCEPTION (N) FRENCH DRAIN

) (N) EXTERIOR WALL 2X6 DF #2 MIN

2 LAYER GRAD "D" BLDG. PAPER

(N) CONCRETE FOUNDATION

(N) CONCRETE STAIRS AND LANDING

1) AT DOOR, 36" MIN DEPTH LANDING TO BE NO MORE THAN 1-1/2" BELOW 1/2" THRESHOLD - LANDING TO SLOPE AWAY 1/4" PER FOOT MIN

2) DRY ROT - REPAIR AND REPLACE AS NECESSARY

) MAINTAIN AT LEAST 8" BETWEEN WEEP SCREED AND DIRT. MAINTAIN AT LEAST 6" BETWEEN THE WEEP SCREED AND ANY PAVED AREA

SLOPE AWAY 1/4" PER FOOT MIN

CONCRETE LANDINGS AT EXTERIOR DOORS AND EXTERIOR SHALL: BE INSTALLED IN EACH COUNTER WALL 12 INCHES OR STAIRS EQUAL TO THE WIDTH OF THE DOOR/STAIRS MIN AND A LENGTH IN THE DIRECTION OF TRAVEL EQUAL TO 36" AND SLOPE OF EXTERIOR LANDINGS SHALL NOT EXCEED 1/4" PER FOOT (2% SLOPE). [\$R311.3 CRC]

ALL EXISTING NONCOMPLIANT PLUMBING FIXTURES SHALL BE REPLACED WITH WATER-CONSERVING PLUMBING FIXTURES WHEN REQUIRED IN THE 2022 MANDATORY MEASURE. ALL NEW FIXTURES TO COMPLY WITH THE 2022 MANDATORY MEASURE, SEE GN2 FOR LOW FLOW WATER FIXTURE REQUIREMENTS. SHOWERS AND TUB-SHOWER COMBINATIONS SMOOTH METAL INTERIOR DUCT, VENTED TO OUTDOORS, HAVE SHALL BE PROVIDED WITH INDIVIDUAL CONTROL VALVES OF THE PRESSURE BALANCE, THERMOSTATIC, OR COMBINATION PRESSURE BALANCE/THERMOSTATIC MIXING VALVE TYPE.

> ANKLESS WATER HEATER SHALL INCLUDE THE FOLLOWING COMPONENTS: A 120V ELECTRICAL RECEPTACLE THAT IS WITHIN 3 FEET FROM THE WATER HEATER AND ACCESSIBLE TO THE WATER HEATER WITH NO OBSTRUCTIONS: AND A CATEGORY III OR IV VENT, OR A TYPE B VENT WITH STRAIGHT PIPE BETWEEN THE OUTSIDE TERMINATION AND THE SPACE WHERE THE WATER HEATER IS INSTALLED: AND A CONDENSATE DRAIN THAT IS NO MORE THAN 2 INCHES HIGHER THAN THE BASE OF THE INSTALLED WATER HEATER. AND ALLOWS NATURAL DRAINING WITHOUT PUMP ASSISTANCE AND A GAS SUPPLY LINE WITH A CAPACITY OF AT LEAST

8) CRAWL SPACE ACCESS 18"X24 MIN PROVIDE AND MAINTAIN UNDER-FLOOR VENTILATION AT THE RATE OF 1SF FOR EACH 150 SF.

ATTIC ACCESS 24"X36" MIN PROVIDE AND MAINTAIN ATTIC VENTILATION AT THE RATE OF 1 SF FOR EACH 150 SF. ALL UNDER-FLOOR VENTILATION OPENINGS SHALL BE COVERED WITH A WIRE MESH OPENING NOT MORE THAN 1/4-INCH.

) ALL UNIT SKYLIGHTS INSTALLED IN A ROOF WITH A PITCH FLATTER THAN THREE UNITS VERTICAL IN 12 UNITS HORIZONTAL (25-PERCENT SLOPE) SHALL BE MOUNTED ON A CURB EXTENDING AT LEAST 4 INCHES ABOVE THE PLANE OF THE ROOF UNLESS OTHERWISE SPECIFIED IN THE MANUFACTURER'S INSTALLATION INSTRUCTIONS. CRC SECTION R308.6.8. LAMINATED. FULLY TEMPERED. HEAT STRENGTHENED, WIRED, OR APPROVED RIGID PLASTIC GLAZING AT THE SKYLIGHTS ABOVE THE LIVING ROOM. CRC SECTION

phone: 510.612.0345 roman@anuradesign.com


0

DRAWN BY CA008 CHECKED BY CA007

**ISSUE DATE** 04/12/2024

SCALE 1/4"=1'-0"

ANURA JOB NO CA2504-0002 SHEET

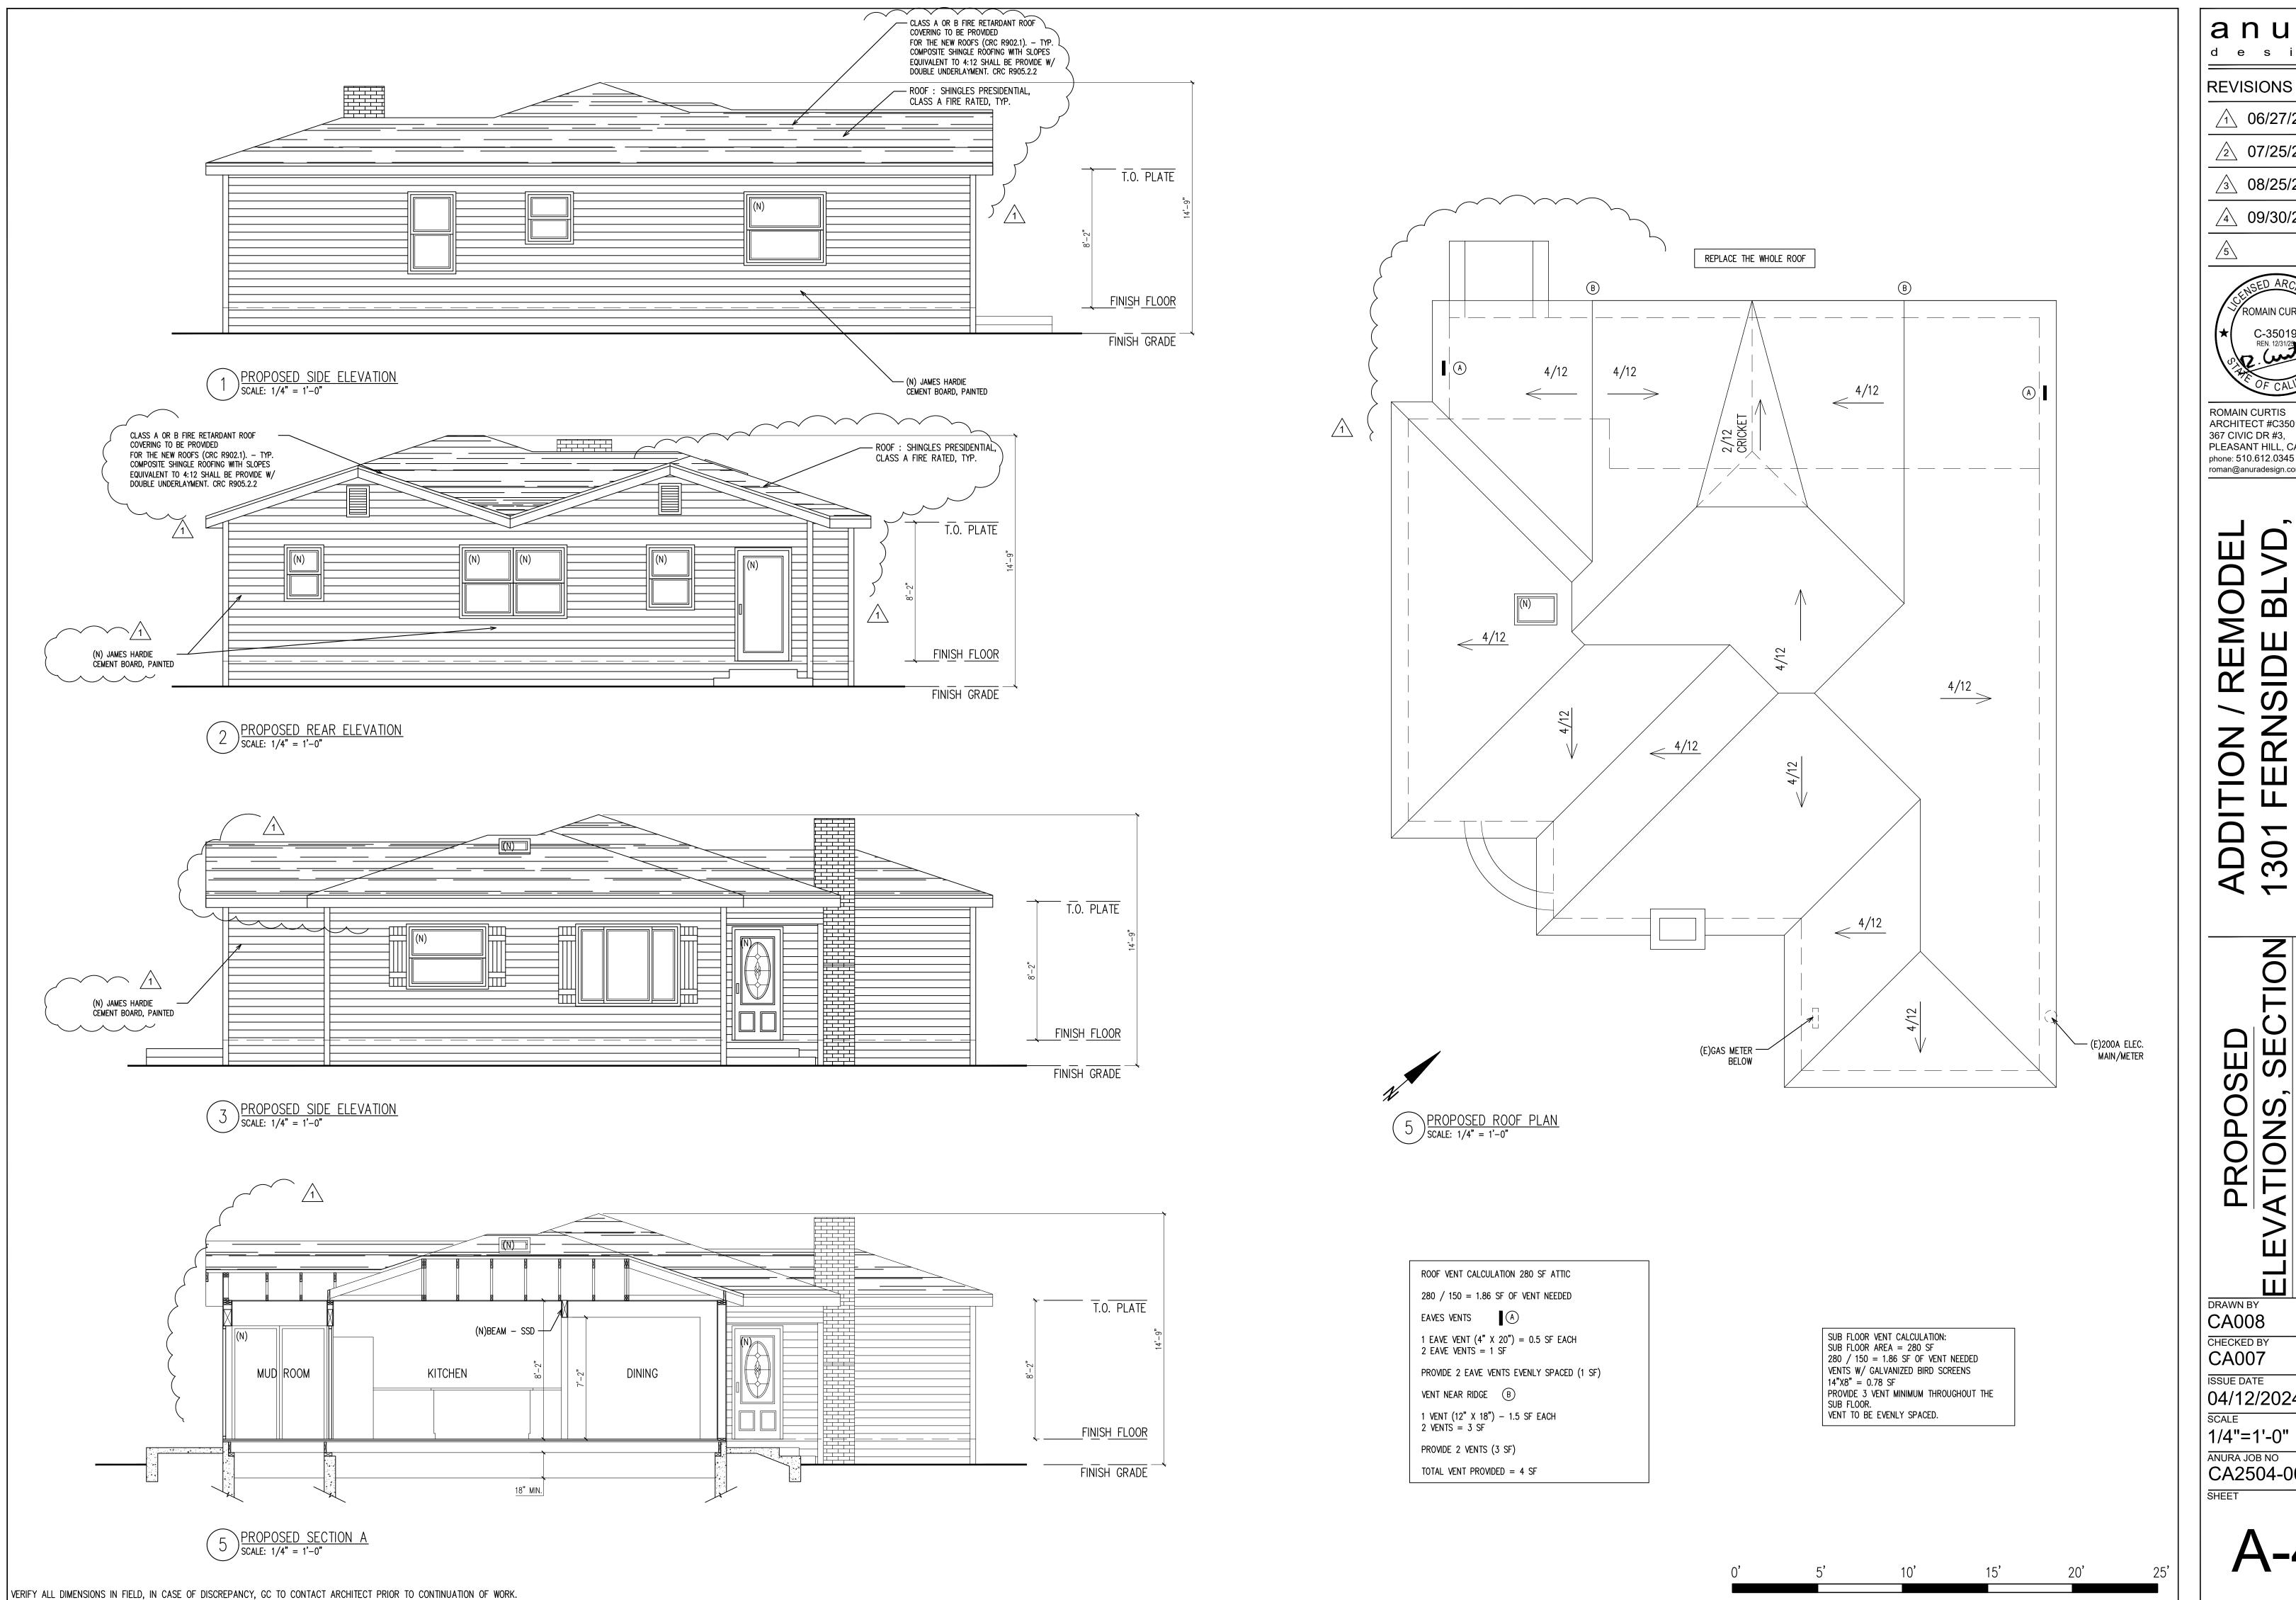

anura design


REVISIONS

1 06/27/2025

<u>2</u> 07/25/2025

3 08/25/2025

4 09/30/2025

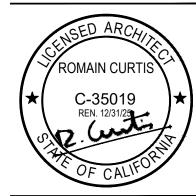

ROMAIN CURTIS ARCHITECT #C35019 367 CIVIC DR #3, PLEASANT HILL, CA94523 phone: 510.612.0345

roman@anuradesign.com


DRAWN BY CA008 CHECKED BY CA007 ISSUE DATE

04/12/2024 1/4"=1'-0" ANURA JOB NO

CA2504-0002


| PIPE | LENGTH | MAX LENGTH | MAX CFH | DIAMETER |
|------|--------|------------|---------|----------|
| Α    | 20'    | 100'       | 411     | 1-1/2    |
| В    | 7'     | 10'        | 108     | 1/2      |
| С    | 9'     | 80'        | 443     | 1-1/2    |
| D    | 13'    | 20'        | 75      | 1/2      |
| E    | 7'     | 50'        | 364     | 1-1/4    |
| F    | 18'    | 20'        | 280     | 1        |
| G    | 24'    | 30'        | 129     | 3/4      |

LICENCE PLUMBER TO INCREASE GAS LINE IF REQUIRED VERIFIED FIELD CONDITIONS, BENDS, LENGTH... IN FIELD

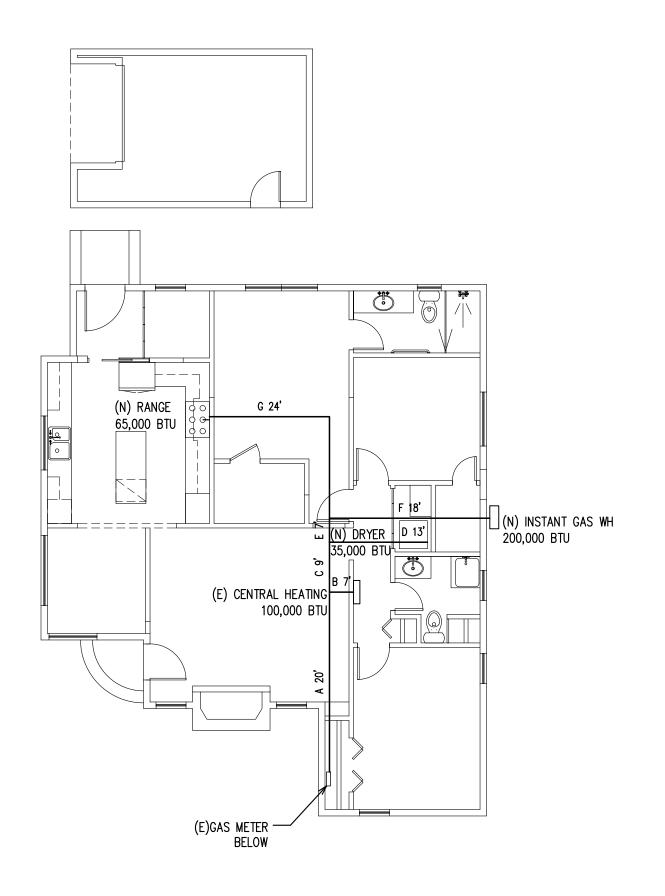



| # OF<br>FIXTURES | INDIVIDUAL FIXT     | URES          | MINIMUM<br>PIPE SIZE | PRIVATE<br>HOME (WSFU) | SUB TOTAL<br>(WSFU) |
|------------------|---------------------|---------------|----------------------|------------------------|---------------------|
| 2                | LAVATORY (BATHROOM  | SINK)         | 1/2"                 | 1.0                    | 2.0                 |
| 2                | TOILET GRAVITY TANK | (1.6 GAL/MIN) | 1/2"                 | 2.5                    | 5.0                 |
| 2                | BATHTUB OR BATH/SH  | IOWER         | 1/2"                 | 4.0                    | 8.0                 |
| 1                | DISHWASHER          |               | 1/2"                 | 1.5                    | 1.5                 |
| 1                | KITCHEN SINK        |               | 1/2"                 | 1.5                    | 1.5                 |
| 1                | CLOTHES WASHER      |               | 1/2"                 | 4.0                    | 4.0                 |
| 1                | HOSE BIB            |               | 1/2"                 | 2.5                    | 2.5                 |
| 2                | HOSE BIB (EACH ADDI | TIONAL)       | 1/2"                 | 1.0                    | 2.0                 |
| 12               | TOTAL FIXTURES      | PRIVA         | TE HOME TOTAL        | MAX. WATER V           | VSFU 26.5           |

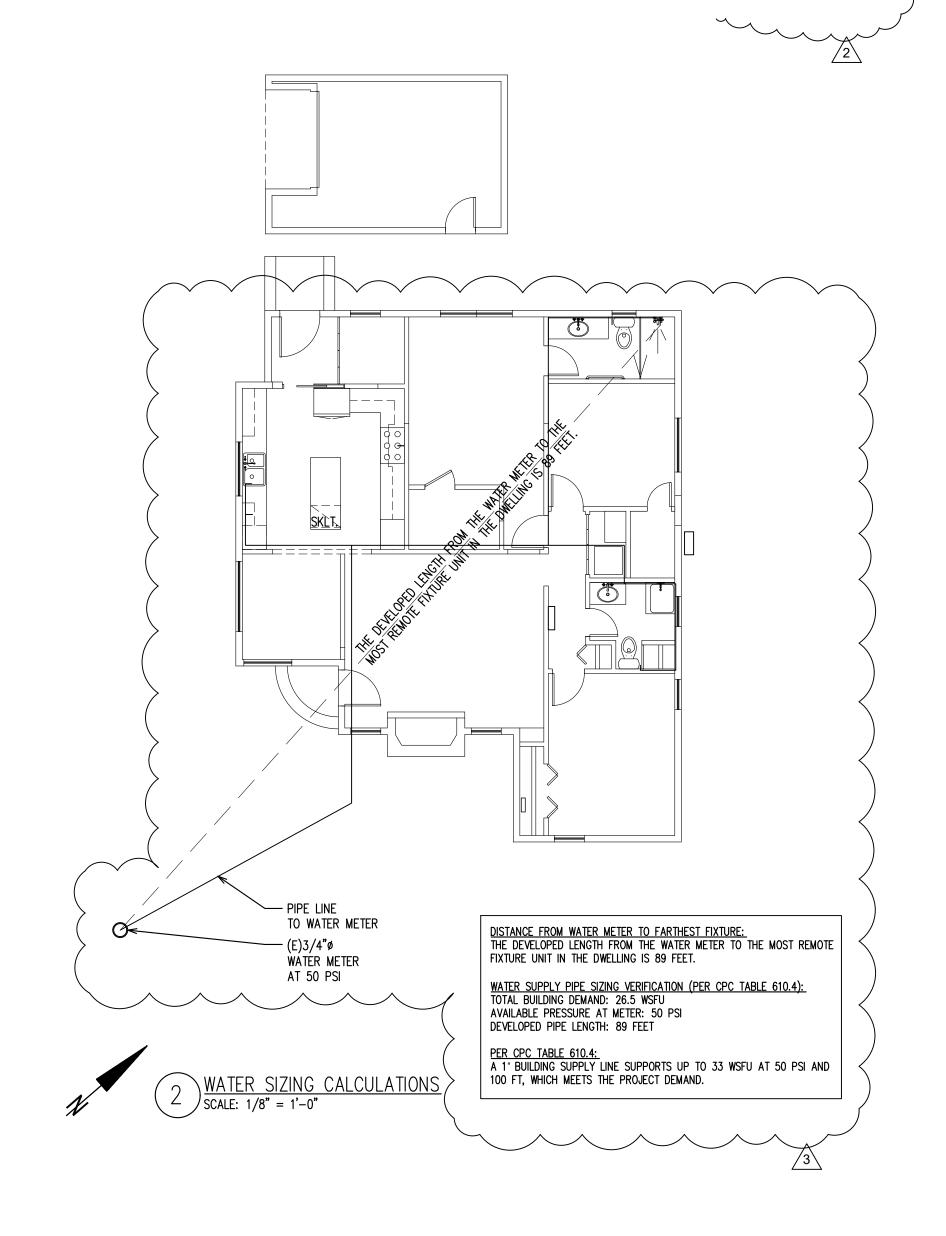

ROMAIN CURTIS ARCHITECT #C35019 367 CIVIC DR #3, PLEASANT HILL, CA94523 phone: 510.612.0345 roman@anuradesign.com

anura

<u>1</u> 06/27/2025

<u>2</u> 07/25/2025

3 08/25/2025

<u>4</u> 09/30/2025

ROMAIN CURT

REVISIONS

GAS LINE DIAGRAM
& WATER SIZING
CALCULATIONS

ADDI 1301

CA008

CHECKED BY

CA007

ISSUE DATE

04/12/2024

SCALE 1/4"=1'-0"

ANURA JOB NO CA2504-0002

A-5

# 1. NOTES AND SPECIFICATIONS

#### 2. Light, Ventilation, Room Dimensions

2.1 Required window area for light shall be not less than 8 percent of the floor area of the room served; the minimum openable area to the outdoors shall be 4 percent of the floor area being ventilated. The glazed area need not be openable for ventilation when a whole-house ventilation system is installed. (R303.1)

minimum net clear opening width dimension shall be 20". The bottom of the clear opening shall be no more than

- openable for ventilation when a whole-house ventilation system is installed. (R303.1)

  2.2 Every sleeping room and any basement must have at least one openable window or door approved for shall have a minimum net area of 5.0 square feet. The minimum net vertical opening dimension shall be 24". The emergency rescue with a minimum net clear opening of 5.7 square feet, except the windows at the grade floor
- 2.3 Bathrooms, water closet compartments and similar rooms shall have window at least 3 sq. feet in area, half of which must be openable, or mechanical ventilation must be provided. (R303.3)
- 2.4 Each bathroom containing a bathing facility shall be mechanically ventilated for the purposes of humidity control. (R303.3.1)
- 2.5 Provide ventilation for products of combustion to outside air. (CMC 802.0)
- 2.6 Attic ventilation: 1/150 of attic area. If 40% 50% of the vents are no more than 3 feet below the ridge or highest point of the roof area; then the ratio may be reduced to 1/300. (R806.2) Unvented attics may be allowed if meeting the requirements of R806.5.
- 2.7 Enclosed rafter spaces shall have a minimum 1" space between the insulation and roof sheathing and at the location of all eave and cornice vents. (R806.3)
- 2.8 Underfloor space shall have a ventilation opening area of 1/150 square feet of underfloor area. If a Class I vapor retarder is used the ratio may be reduced to 1/1500. One opening shall be placed within 3 feet of each building corner. Openings shall be covered with a covering having openings no greater than 1/4". (R408.2)
- 2.9 Heating system is required to maintain 68 degrees at 3 feet above floor level and 2 feet from exterior walls in all habitable room. (R303.9)
- 2.10 Air infiltration, insulation, space heating, space cooling, water heating, etc shall meet CA Energy Commission Standards.
- 2.11 All habitable rooms except kitchens shall be at least 70 square feet in area and shall have a width of at least 7 feet. In addition there shall be at least one room with a minimum of 120 square feet in each dwelling. Minimum ceiling height shall be 7 feet. See CRC for exceptions. (R304/R305)

## 3. DOORS, STAIRWAYS AND LANDINGS (INCLUDING DECKS)

- 3.1. Required egress door shall be side hinged and have a minimum net clear width of 32" and a minimum height of 78". (R311.2)
- 3.2. There shall be a landing at each side of all doors not more than 1 1/2" lower than the threshold at the required egress door, and not more than 7 3/4" for other exterior doors. The landing shall be at least as wide as the door served and 36" minimum length measured in the direction of travel. A landing is not required at doors other than the required egress door where a stairway of two or fewer risers is located on the exterior of the door, and the door does not swing over the stairway. (R311.3)
- 3.3. Stairway rise shall be 4" min and 7.75" max. Run shall be 10" min. Headroom shall be 80" minimum. Width shall be 36" minimum. Handrails shall provide graspability and be 34"–38" above tread nosing with openings less than 4 3/8" clear, except openings formed by the riser, tread, and bottom rail of the guard may be 6" maximum diameter. (R 311.7 & R312.1.3 ex. 1 & 2)
- 3.4. Enclosed useable space under interior stairs shall be finished with 1/2" min. type X gypsum board (R302.7)
- 3.5. Fireblocking is required in concealed spaces between stair stringers at the top and bottom of the run. (R302.11)
- 3.6. There shall be a floor or landing at the top and bottom of each stairway. Width and length of landings shall be not less than the width of the stairway served. A floor or landing is not required at the top of an interior flight of stairs, including stairs in an enclosed garage, provided a door does not swing over the stairs. (R311.7.6)
- 3.7. Guards shall be located along open sided walking surfaces, including stairs, ramps, landings, and decks, that are more than 30" above the floor or grade, measured at any point within 36" horizontally. Required guards shall be not less than 42" above the adjacent walking surface. Except that handrails may be considered as guards at stairways. Openings in guards shall not exceed 4". (R312)
- 3.8. Exterior deck support posts shall be cross braced in two directions for lateral stability.
- 3.9. For posts over 30" in height provide mechanical connection at post base.
- 3.10. Provide detail at junction of exterior decking, wall and interior floor framing. Show elevations, flashing, and anchorage. Deck framing shall be positively attached to building framing at a minimum of 2 locations within 24" of each end of the deck with hold-down tension devices having an allowable design capacity of not less than 1500 pounds each, or at a minimum of 4 locations with hold-down tension devices of not less than 750 pounds allowable design capacity. (R507.2.4)
- 3.11. Deck framing and support posts to be of preservative treated or naturally durable lumber. (R317.1) Hardware and fasteners shall be hot-dipped galvanized, stainless steel, silicon bronze, or copper. (R317.3.1)

# 4. WEATHER AND CORROSION DAMAGE PREVENTION MEASURES

- 4.1. Naturally durable wood or preservative treated wood, per AWPA U1, shall be required in the following locations
  - A. Wood joists and girders closer than 18" or 12", respectively, to the exposed ground.
- B. Wood framing members that rest on concrete or masonry and are less than 8" from the exposed ground.
- C. Sills and sleepers on a concrete or masonry slab that is in direct contact with the ground unless separated by an impervious moisture barrier.
- D. Wood siding, sheathing and wall framing on the exterior of the building having a clearance of less than 6" from the ground or less than 2" from a horizontal concrete surface.
- E. All wood in contact with the ground.
- F. All wood embedded in concrete that is in direct contact with the ground or exposed to weather and that supports structures intended for human occupancy.
- 4.2. Exposed glu-lams shall be preservative treated, applied by the manufacturer, or made from naturally durable
- wood.
  4.3. Weatherproofing of exterior surfaces above and below grade is required. (R406 & R703)
- 4.4. Concrete slabs shall be separated from earth by a minimum 6-mil vapor retarder, with edges lapped a minimum
- 4.4. Concrete slabs shall be separated from earth by a minimum 6-mil vapor retarder, with edges lapped a minimum of 6". This may be omitted if the space above is not heated and is not likely to become heated in the future. (R506.2.3)

4.5. A capillary break shall be installed when concrete slab-on-ground floors are required to have a vapor retarder.

- This capillary break shall be a 4" thick base of 1/2" or larger clean aggregate with a vapor retarder in direct contact with concrete. The concrete mix design shall address bleeding, shrinkage, and curling, in accordance with ACI 302.2R-06. As an alternative the slab design may be prepared by a licensed design professional. (CalGreen 4.505.2.1)
- 4.6. The ground adjacent to the foundation shall be sloped so that the grade shall fall a minimum of 6" within the first 10'. Impervious surfaces may be sloped at 2% minimum. (R401.3)
- 4.7. All fasteners used for attachment of siding shall be corrosion-resistant. (R703.3.2)
- 4.8. Corrosion resistant flashing shall be provided at openings and intersections/attachments. (R703.4)
- 4.9. All roof areas of buildings shall be provided with gutters or roof drains. Provide adequate roof slope for drainage (1/4" per foot, min.) or submit deflection and ponding calculations. Primary roof drains shall be designed based on a 60 minute storm with a 100 year return period, per Table D of the CPC. Secondary roof drains shall be provided not less than 2" above the roof surface. (CPC 1101.12)

# 5. GARAGE & CARPORT

- 5.1. Common wall between garage and dwelling shall have 1/2" gypsum board applied on the garage side. Garage ceiling with habitable space above shall have 5/8" type X gyp board applied to the ceiling. Carports with no enclosed uses above do not need protection. (R302.6)
- 5.2. No openings may be provided between a garage and a sleeping room. Other openings shall be equipped with solid wood or steel doors 1 3/8" in thickness and shall be self-closing and self-latching. (R302.5.1)
- 5.3. Garage and carport floor surfaces shall be of approved noncombustible material. Asphaltic surfaces shall be permitted at ground level in carport. (R309.1 & R309.2)
- 5.4. Appliances and receptacles installed in garages and carports generating a glow, spark, or flame shall be located 18" min. above the floor unless listed as flammable vapor ignition resistant. Provide protective bollard or other impact barrier or located out of the normal path for vehicles. (CMC 305.1)

#### 6. ELECTRICAL

- 6.1. Do not install electrical panels larger than 16 square inches in rated fire walls. Garage to dwelling unit separation is not a rated fire wall. (R302.4.2) Never install electrical panels in closet. Maintain a clearance of 36" in front of the panels. (CEC 110.26)
- 6.2. Provide a minimum of one 20 Amp receptacle in areas designated for laundry equipment. (CEC 210.52F)
- 6.3. Kitchens and dining areas must have a minimum of two 20 Amp circuits. Kitchen counter outlets must be installed in every counter space 12" or wider, not greater than 4' o.c. and within 24" of the end of any counter space. (CEC 210.52)
- 6.4. GFCI outlets are required for all kitchen receptacles that are designed to serve countertop surfaces, in bathrooms, in underfloor spaces at or below grade level, in exterior outlets, in laundry areas, and in all garage outlets not dedicated to a single device or appliance. (CEC 210.8) All dwellings must have at least one exterior outlet at the front and the back of the dwelling. (CEC 210.52E)
- 6.5. Receptacles must be installed at 12' o.c. maximum in walls. Walls longer than 2 feet and halls longer than 10' must have a receptacle. A receptacle must be provided within 3' of bathroom sinks. (CEC 210.52)
- 6.6. Bond all metal gas and water pipes to ground. All ground clamps must be accessible and of an approved type. (CEC 250.104)
- 6.7. Furnaces installed in attics and crawl spaces must have an access platform (catwalk in attics), light, light switch, and receptacle in the space. (CMC 904.10)
- 6.8. New dwellings must have a 120V powered smoke alarm in every sleeping room, outside each sleeping room, on every story of the dwelling, including basements and habitable attics, but not including crawl spaces or uninhabitable attics. (R314.3)
- 6.9. When more than one smoke alarm or carbon monoxide alarm is required the alarm devices shall be interconnected. If the proposed scope of work does not result in the removal of wall and ceiling finishes exposing areas requiring installation, in buildings built prior to January 1, 2011, devices may be battery operated. (R314.4 & R315.7)
- 6.10. When alterations, repairs, or additions require a permit or sleeping rooms are added or created, smoke alarms shall be installed where required in new dwellings. (R314.2.2)
- 6.11. For new construction and work in an existing dwelling, where an addition is made to an existing dwelling or a fuel-burning appliance is added, carbon monoxide alarms shall be installed in sleeping rooms within which fuel-burning appliances are installed, outside of each sleeping area, and on each occupiable level. Carbon monoxide alarms are not required in dwellings where there is no fuel-fired appliance or attached garage. (R315.1; R315.2)
- 6.12. All 120-volt 15 and 20 amp branch circuits in dwelling units except those in bathrooms, unfinished basements, garages and outdoors shall have AFCI protection. (CEC 210.12)
- 6.13. Receptacles on 120-volt 15 and 20 amp circuits shall be tamper resistant. Except when located more than 5.5' above the floor or when part of a luminaire or appliance. (CEC 406.12)

#### 7. MISCELLANEOUS LIFE-SAFETY

- 7.1. Provide pressure relief valve with drain to outside for water heater. (CPC 608.3) Provide seismic strapping or anchorage resisting overturning of water heater. (CPC 507.2, CRC R301.2.2.3.7)
- 7.2. Liquefied petroleum gas (LPG) appliances shall not be installed in a pit, basement or similar location. LPG appliances shall not be installed in an above grade underfloor space or basement unless such location is provide with an approved means for removal of unburned gas (CMC 303.7.1)
- 7.3. Provide combustion air for all gas fired appliances. (CMC Chapter 7)
- 7.4. Fuel burning water heater is not allowed in bedroom or bathroom unless direct vent type or complying with CPC 504 1
- 7.5. Vent clothes dryer to outside of building (not to underfloor area). Vent length shall be 14' maximum and the vent diameter shall not be less than 4". (CMC 504.4.2)
- 7.6. Water closet shall be located in a space not less than 30" in width with 24" minimum clearance in front. (CPC 402.5)
- 7.7. Showers and tubs with showers require a non-absorbent surface up to 72" above the floor. (R307.2). Provide curtain rod or approved enclosure material.
- 7.8. Provide backflow preventers on all hose bibs. (CPC 603.5.7)
- 7.9. Safety glazing shall be required within 24" of a door edge or within 36" of a stairway, landing or ramp when the bottom edge of the glazing is less than 60" from the floor or walking surface. (R308.4.2 & R308.4.3)
- 7.10. Safety glazing is required in all fixed and operable panels of swinging, sliding and bi-fold doors. (R308.4.1)
- 7.11. Safety glazing is required in enclosures and walls facing hot tubs, saunas, steam rooms, showers and tubs where the bottom edge of the glazing is less than 60" from any standing or walking surface. (R308.4.5)
- 7.12. Wood burning appliances shall be EPA phase II certified in the Northern Sonoma County Air Pollution Control District. In the Bay Area Air Quality Management District wood burning appliances are not allowed. (Sonoma County Ordinance)
- 7.13. Provide 18" x 24" foundation access within 5' of all plumbing cleanouts. (R408.4; CPC 707.9)
- 7.14. Fireblocking shall be provided in concealed spaces of stud walls and partitions, including furred spaces, and parallel rows of studs or staggered studs; vertically at floor and ceiling levels, horizontally at intervals not to exceed 10'. (R302.11)
- 7.15. Show minimum 22" x 30" access opening to attic. (CMC 304.4; R807.1) In attics in which an appliance is installed, an opening and passageway at least as large as the largest component of the appliance shall be required. (CMC 903.2.3)
- 7.16. Roof construction and covering shall comply with R905 and local ordinance. All roofing shall be of Class A fire resistive material, supported by solid sheathing (Chapter 7 Sonoma County Code).
- 7.17. Storage use or placement of a fuel burning appliance in an underfloor area may trigger the requirement for a 1/2 inch gypsum wallboard or 5/8 inch wood panel membrane on the underside of the floor framing member. See Section R302.13 of the CRC for exceptions.

# 8. FOUNDATIONS AND CONCRETE

- 8.1. Concrete shall be 2500 psi minimum for foundation and retaining walls (including stem walls), garage floor slabs, and porches or steps exposed to weather and 2500 psi minimum for all other concrete. (R402.2; Table R402.2; R608.5.1.5) unless otherwise note on structural drawings and calculations.
- 8.2. Conventional Residential Foundation Requirements (R404.1.4.2; Table R403.1(1))

  Foundations for Stud Bearing Walls Min. Requirements

| No. of stories | Thickness of stem wall concrete * | Width of footing | Thickness of footing | Depth below undisturbed ground surface |
|----------------|-----------------------------------|------------------|----------------------|--|
| 1              | 6.0"                              | 12"              | 6"                   | 12"                                    |
| 2              | 6.0"                              | 15"              | 6"                   | 12"                                    |

- \* Foundation walls exceeding 4'6" shall be minimum 7.5" thick.
- 8.3. Horizontal reinforcing at footing and stem wall: one number 4 rebar within top 12" of stem wall and one number 4 rebar 3–4 inches from bottom of footing (R403.1.3.1)
- 8.4. When the stem wall and footing are not poured monolithically a number 4 rebar shall be installed vertically at not more than 4' o.c. The vertical bar shall extend to 3" clear from the bottom of the footing, have a standard hook, and extend a minimum of 14 inches into the stem wall. (R403.1.3.1)

- 8.5.Stepped footings shall be used when slope of footing bottom is greater than 10:1 (H:V). Step footing detail shall be shown on building elevations and foundation plan. (R403.1.5)
- 8.6. Concrete slabs shall be 3.5" thick minimum. (R506.1)
- 8.7. Provide adequate setbacks from slopes greater than 33% gradient equal to half the height of the slope (need not exceed 15 feet) for an adjacent ascending slope surface, and one third the height of the slope (need not exceed 40 feet) for an adjacent descending slope surface. If these setbacks cannot be met a geotechnical report justifying soil characteristics and suitability of the proposed building site shall be provided. (R403.1.7)
- 8.8. Anchor bolts shall be minimum 1/2" x 10" placed at 6' o.c. maximum. Embed bolts 7" min. Locate end bolts neither less than 3.5" nor more than 12" from ends of sill members. (R 403.1.6) Provide 3" x 3" x 0.229" plate washers on each bolt. (R602.11.1)

#### 9. FLOORS

- 9.1. Floor joist size, spacing and grade shall conform to Table R502.3.1; or shall be designed by a licensed professional.
- 9.2. Joists under and parallel to bearing partitions shall be doubled. (R502.4)
- 9.3. Bearing partitions perpendicular to joists shall not be offset from supporting girders, walls or partitions more than the joist depth. (R502.4)
- 9.4. Girders for single-story construction or supporting one floor shall be 4" x 6" for spans 6' or less, with girders spaced at 8' o.c. For other sizes and spans see Table R602.7 (1, 2, & 3).
- 9.5. Nail spacing for floor plywood sheathing: 6" o.c. at edges, 12" o.c. in field (unless closer nailing is specified). Table R602.3(1)
- 9.6. Provide detail of connection of floor girder at foundation wall.
- 9.7. Solid block all joists at ends and intermediate supports with full-depth solid blocking not less than 2" nominal thickness. (R502.7)
- 9.8. At floor openings where header joist span exceeds 4' show double trimmer joists and headers. Approved hangers shall be used for the header joist to trimmer joist connections when the header joist span exceeds 6'. (R502.10)

#### 10 Walle

- 10.1. Show stud size, height, grade and spacing. (Table R602.3(5)) Exterior and interior studs shall be continuous floor to roof unless braced at ceiling.
- 10.2. Balloon frame gable end walls or provide softwall bracing detail.
- 10.3. Minimum header sizes shall be according to Table R602.7(1,2,&3).
- 10.4. Double top plates shall have a minimum lap of 24". Nail with eight 16d common nails on each side of the joint, unless additional nailing is specified. Plates at intersections with bearing walls and corners shall also be overlapped. (Table R602.3)
- 10.5. Sole plate to joist or blocking shall be 16d common nails at 16" o.c. and 2-16d common nails at 16" at braced wall panels. (Table R602.3 item 14)
- 10.6. Foundation cripple walls shall be framed of studs not less in size than the studs of the wall above. Cripple walls exceeding 4' in height shall be framed of studs as required for an additional story. Cripple walls shall be sheathed per R602.10.9 & R602.10.9.1. Cripple walls less than 14" in height shall be continuously sheathed or constructed of solid blocking. (R602.9)
- 10.7. Minimum wood structural panel sheathing nailing: 6" o.c. at edges and 12" o.c. in field. (Table R602.3) Nailing shall be inspected prior to covering.
- 10.8. Provide one layer of No. 15 asphalt felt or other approved material under exterior siding. Material shall have upper layer lapped 2" min over lower layer with 6" min laps at joints. (R703.2) Provide 2 layers of Grade D paper, or equivalent, between wood sheathing and stucco lath. (R703.7.3)
- 10.9. Braced wall lines shall be sized and configured in accordance with section R602.10 in its entirety. Provide and label a layout of all braced wall lines complete with required values for wind and seismic for the specified wall
- 10.10. Spacing of braced wall lines shall not exceed 25' (interior & exterior) unless length of required bracing, per Table R602.10.3(3) is adjusted in accordance with Table R602.10.3(4). (R602.10.1.3)

# . <u>ROOF</u>

- 11.1. Show roof rafters and ceiling joists. Spans shall be per Tables R802.4(1) & (2) for ceiling joists and Tables R802.5.1(1) & (2) for rafters. Include the size, spacing and grade of all members.
- 11.2. Nail rafters to adjacent parallel ceiling joists. Where not parallel, use rafter ties at 4' o.c. max. (R802.3.1)

  Connect ties per Table R802.5.1(9). Rafter ties shall use adjustment factor in footnote h., for the height above supporting wall and the location of the connection must be in lower third of attic space.
- 11.3. Where ceiling joists or rafter ties are not provided trusses shall be used or engineering shall be provided. (R802.3.1 & R802.10)
- 11.4. Solid block all rafters and trusses at exterior walls. (R802.8) Nail blocking to top plate with (3) 8d toe nails per block or provide clips.
- 11.5. For roofs shallower than 3:12 ridges, hips and valleys shall require engineering. (R802.2)
- 11.6. Wood structural panel sheathing when designed to be permanently exposed in outdoor applications, shall be of an exterior exposure durability. Wood structural panel roof sheathing exposed to the underside may be identified as Exposure 1. (R803.2) Minimum nailing per Table R602.3(1) is 6" at edges and 12" in the field, 8d common, box or casing. Nail panels to blocking between rafters.

# 12. GREEN BUILDING AND ENERGY

- 12.1. New construction and additions/alterations increasing a building's conditioned floor area shall comply with applicable provisions of CalGreen. (CalGreen 301.1) Mandatory provisions shall apply only to the specific area of the addition or alteration. (CalGreen 301.1.1)
- 12.2. The Residential California Green Building Checklist shall be filled out and all mandatory and elective features selected shall be identified with adequate notations and details on the proposed project plans. An approved 3rd party CALGreen special inspector shall review the proposed checklist and project plans and provide verification that all applicable mandatory and elective elements identified in the checklist have been adequately incorporated into the proposed project plans and details. The field verification of the required CALGreen elements shall also be achieved by the 3rd party CALGreen special inspector during the construction and inspection process.
- 12.3. Residential buildings undergoing permitted alterations, additions or improvements shall replace noncompliant plumbing fixtures with water-conserving plumbing fixtures. (CalGreen 301.1.1)
- 12.4. Energy code documentation shall be provided for any additions and alterations to the conditioned envelope, space-conditioning systems, or lighting systems. Energy code documentation shall be registered with the California Energy Commission prior to permit issuance. (California Energy Code Section 100(b))

# 13. FIRE RESISTANT CONSTRUCTION

- 13.1. New structures and remodels and additions to existing structures shall meet the requirements of the PRMD Planning Division, based on parcel specific zoning, use, and setback requirements.
- 13.2. Exterior walls within 5' (or 3' when the structure is equipped with an automatic fire sprinkler system) of an adjacent property line (or an assumed property line between structures) shall be 1 hour rated.
- 13.3. The exposed underside of projections from exterior walls from 2' to less than 5' from an adjacent property line, or from 2' to less than 3' when the structure is equipped with an automatic fire sprinkler system, shall be 1 hour rated. Exterior wall projections less than 2' from an adjacent property line are not allowed.
- 13.4. When a parcel is located in a State Responsibility Area (SRA) all new construction shall comply with the applicable fire resistant construction requirements of CRC Section R337. Accessory Group U occupancy structures located at least 50' from an applicable building and additions and remodels to structures originally constructed prior to July 1, 2008 are exempt from these requirements.
- 13.5. Structures which are subject to Fire Safe Standards and located in the SRA on parcels 1 acre and larger shall have a minimum 1 hour rating at exterior walls and the underside of exterior projections within 10 feet from an adjacent property line.
- 13.6. Dwelling units in two-family dwellings shall be separated from each other by wall and floor assemblies having not less than a 1-hour fire-resistance rating. Fire-resistance rated floor/ceiling assemblies shall extend to the exterior walls, and the supporting construction shall have an equal or greater fire-resistance rating. Wall assemblies shall extend from the foundation to the underside of the roof sheathing, although wall assemblies need not extend through attic spaces where the ceiling is protected by not less than 5/8" Type X gypsum board, an attic draft stop is provided above and along the wall assembly separating the dwellings, and the structural framing supporting the ceiling is protected by not less than ½" gypsum board or equivalent. (R302.3)

### TURN OVER REQUIREMENTS:

- 1. THE G.C. SHALL COMPLETE ALL REQUIRED INSPECTIONS BY CONSTRUCTION COMPLETION DATE AND WILL FURNISH THE OWNER WITH THE CERTIFICATE OF OCCUPANCY OR/AND A NOTICE OF COMPLETE FINAL INSPECTION. IN ADDITION, THE G.C. SHALL PROVIDE A LIST OF THE NAMES, ADDRESSES AND TELEPHONE NUMBERS OF ALL SUBCONTRACTORS, AND PROOF THAT ALL PAYMENT TO SUB CONTRACTORS HAVE BEEN MADE.
- THE G.C. SHALL TURN OVER ALL KEYS TO THE OWNER.
   UPON COMPLETION OF THE WORK, THE G.C. SHALL PROVIDE FOR A FINAL CLEANING TO BE PERFORMED BY A
  PROFESSIONAL CLEANING SERVICE. THE ENTIRE STRUCTURE SHALL BE THOROUGHLY CLEANED BEFORE TURNING
  THE PROPERTY OVER TO OWNER.
- SUPERINTENDENT MUST REMAIN ON JOB SITE THROUGH COMPLETION OF THE PUNCH LIST.
   UPON COMPLETION OF WORK, THE G.C. WILL DEMONSTRATE THE OPERATION OF ALL SYSTEMS TO THE OWNER.
  THIS INCLUDES ELECTRICAL, MECHANICAL, PLUMBING, SOUND, SECURITY, AND THE OPERATION OF DOORS AND
- WINDOWS.

  6. THE GC SHALL COORDINATE A WALK THROUGH WITH THE OWNER'S REPRESENTATIVE AND OBTAIN A SIGNATURE
- INDICATING COMPLETION AND ACCEPTANCE. SIGNED DOCUMENT SHALL BE SUBMITTED AS PART OF THE THE PROJECT CLOSEOUT PACKAGE.
  7. THE G.C. SHALL REVIEW ALL DOCUMENTS, FIELD VERIFY ALL DRAWING DIMENSIONS, INSPECT EXISTING FIELD
- 8. ANY DISCREPANCIES BETWEEN THE EXISTING CONDITIONS DRAWINGS, THE CONTRACT DOCUMENT DRAWINGS AND THE FIELD CONDITIONS SHALL BE BROUGHT TO THE ATTENTION OF THE ARCHITECT OF RECORD FOR CLARIFICATION BEFORE PROCEEDING WITH WORK.
- 9. THE G.C. SHALL, IN THE WORK OF ALL TRADES, PERFORM ALL CUTTING, PATCHING RESTORING, REPAIRING AND THE LIKE, NECESSARY TO COMPLETE THE WORK AND RESTORE ANY DAMAGED SURFACES RESULTING FROM THE WORK TO THEIR ORIGINAL CONDITION. ALL ROOF PATCHING SHALL RETURN AFFECTED AREA TO A "LIKE NEW" CONDITION. PRIOR TO PATCHING THE G.C. SHALL VERIFY ANY ROOF WARRANTIES WITH THE LANDLORD.

CONDITIONS AND CONFIRM THAT THE WORK CAN BE BUILT AS SHOWN IN THE CONSTRUCTION DRAWINGS.

- 10. THE GENERAL CONTRACTOR SHALL BE RESPONSIBLE FOR REMOVAL AND DISPOSAL OF ALL TRASH
  11. PERMITS FOR FIRE SPRINKLER SYSTEM, FIRE ALARM, SIGNAGE OR ANY OTHER PERMITS REQUIRED BY LOCAL
  AUTHORITIES ARE TO BE SUBMITTED UNDER SEPARATE APPLICATIONS.
- 12.DURING THE CONSTRUCTION PHASE, THE GENERAL CONTRACTOR SHALL PROVIDE A PORTABLE FIRE EXTINGUISHER, WITH A UL LABEL AND RATING OF NOT LESS THAN 2-A, TO BE LOCATED WITHIN A 75 FT. TRAVEL DISTANCE OF ALL PORTIONS OF THE PREMISES.

13.A 44 IN. CLEAR EXIT AISLE THROUGH ROOMS TO EXIT DOORS SHALL BE MAINTAINED AT ALL TIMES DURING THE

- CONSTRUCTION PERIOD.

  8. FIRE DAMPERS SHALL BE PROVIDED BY THE MECHANICAL SUBCONTRACTOR WHERE DUCTS PENETRATE FIRE-RATED WALLS, FLOORS OR CEILING ASSEMBLIES.
- 9. THE CONTRACTOR SHALL COMPLY WITH ALL REQUIREMENTS OF THE SOILS REPORT PREPARED FOR THIS PROJECT AND APPROVED BY THE BUILDING DEPARTMENT ENGINEER.
- 10. TEMPORARY EROSION CONTROL MEASURES SHALL BE PROVIDED BY THE CONTRACTOR DURING CONSTRUCTION AS IDENTIFIED ON THE EROSION CONTROL PLAN. MAINTENANCE OF ONSITE DRAINAGE AND EROSION CONTROL FACILITIES DURING CONSTRUCTION SHALL BE THE RESPONSIBILITY OF THE CONTRACTOR.
- 11.PRIOR TO COMMENCEMENT OF ANY CONSTRUCTION, THE CONTRACTOR SHALL CONTACT ALL UTILITIES TO COORDINATE SCHEDULES.
  12.THE CONTRACTOR SHALL RESTORE ANY DISTURBED AREAS TO EQUAL OR BETTER CONDITION THAN EXISTED BEFORE CONSTRUCTION. DRAINAGE DITCHES OR WATERCOURSES THAT ARE DISTURBED BY CONSTRUCTION
- SHALL BE RESTORED TO THE GRADES AND CROSS-SECTIONS THAT EXISTED BEFORE CONSTRUCTION, UNLESS OTHERWISE SHOWN ON THE CONSTRUCTION DOCUMENTS.

  13.THE CONTRACTOR SHALL CAREFULLY PRESERVE BENCHMARKS, PROPERTY CORNERS, REFERENCE POINTS, STAKES AND OTHER SURVEY REFERENCE MONUMENTS OR MARKERS. IN CASE OF WILLFUL OR CARELESS DESTRUCTION. THE CONTRACTOR SHALL BE RESPONSIBLE FOR DESTRUCTION.
- DESTRUCTION, THE CONTRACTOR SHALL BE RESPONSIBLE FOR RESTORATIONS. RESETTING OF MARKERS SHALL BE PERFORMED UNDER THE DIRECTION OF A CALIFORNIA LICENSED PROFESSIONAL LAND SURVEYOR.

  14. THE CONTRACTOR SHALL IMMEDIATELY REMOVE ANY CONSTRUCTION DEBRIS AND MUD TRACKED ONTO EXISTING ROADWAYS. THE CONTRACTOR SHALL REPAIR ANY EXCAVATION OR PAVEMENT FAILURES CAUSED BY THE
- 15.ALL DAMAGED EXISTING CURB, GUTTER, AND SIDEWALK SHALL BE REPAIRED PRIOR TO ACCEPTANCE OF COMPLETED IMPROVEMENTS.

  16.THE TYPE, SIZE, LOCATION AND NUMBER OF ALL KNOWN UNDERGROUND UTILITIES ARE APPROXIMATE WHEN
- SHOWN ON THESE CONSTRUCTION DRAWINGS. IT SHALL BE THE RESPONSIBILITY OF THE CONTRACTOR TO VERIFY THE EXISTENCE AND LOCATION OF ALL UNDERGROUND UTILITIES ALONG THE ROUTE OF THE WORK PRIOR TO COMMENCING ANY NEW CONSTRUCTION. THE CONTRACTOR SHALL BE RESPONSIBLE OF ANY UNKNOWN UNDERGROUND UTILITIES.

  17. THE CONTRACTOR SHALL MAINTAIN ONE (1) SET OF "REDLINED" PRINTS OF THE CONSTRUCTION PLANS. THE

"REDLINED" PRINTS SHALL BE KEPT CURRENT TO ACCURATELY REPRESENT THE DIMENSIONS AND LOCATIONS OF

- ALL WORK PERFORMED BY THE CONTRACTOR.

  18. THE OWNER/DEVELOPER SHALL BE RESPONSIBLE FOR PROVIDING ALL REQUIRED LOT STAKING AND CONSTRUCTION STAKING. THE CONTRACTOR SHALL COORDINATE THROUGH THE OWNER'S DESIGNATED REPRESENTATIVE TO ASSURE THAT THE SURVEYOR IS GIVEN ADEQUATE NOTICE AND INSTRUCTION IN ORDER TO COMPLETE THE SURVEY REQUIREMENTS FOR THE VARIOUS PHASES OF WORK. THE CONTRACTOR SHALL BE RESPONSIBLE FOR THE COST OF RE-SURVEYING REQUIRED DUE TO THE CONTRACTOR'S, OR SUBCONTRACTOR'S, ACTIVITIES. THE CONTRACTOR SHALL BE RESPONSIBLE FOR THE COSTS ASSOCIATED WITH RESCHEDULING THE SURVEYOR TO ACCOMMODATE THE CONTRACTOR'S REQUESTS FOR UNSCHEDULED STAKING.
- 19. THE CONTRACTOR SHALL PROVIDE AND IMPLEMENT A "TRAFFIC CONTROL PLAN" RELATED TO ALL CONSTRUCTION ACTIVITIES FOR THIS PROJECT.
- 20.THE CONTRACTOR SHALL PERFORM ALL WORK ACCORDING TO ALL BUILDING DEPARTMENT, COUNTY, STATE AND FEDERAL SAFETY AND HEALTH REGULATIONS
  21.ALL CONSTRUCTION ACTIVITIES MUST COMPLY WITH THE STATE'S AND COUNTY PERMITTING PROCESS FOR "STORMWATER DISCHARGES ASSOCIATED WITH CONSTRUCTION ACTIVITY."
- 22.THE CONTRACTOR SHALL TAKE ALL NECESSARY AND PROPER PRECAUTIONS TO PROTECT ADJACENT PROPERTIES FROM ANY AND ALL DAMAGE THAT MAY OCCUR FROM STORM WATER RUNOFF AND /OR DEPOSITION OF DEBRIS RESULTING FROM ANY AND ALL WORK.

# NOTE TO OWNER:

CONSTRUCTION.

PER CALIFORNIA HEALTH & SAFETY CODE SECTION 19825, BEFORE ISSUANCE OF A BUILDING PERMIT, THE PROPERTY OWNER MUST COMPLETE AND SUBMIT THIS FORM; AN AGENT OF THE OWNER MAY NOT EXECUTE THIS FORM. PLEASE READ AND INITIAL EACH STATEMENT BELOW TO SIGNIFY

THAT YOU UNDERSTAND AND VERIFY THIS INFORMATION:

1. I UNDERSTAND A FREQUENT PRACTICE OF UNLICENSED PERSONS IS TO HAVE THE PROPERTY OWNER OBTAIN AN "OWNER-BUILDER" BUILDING PERMIT THAT ERRONEOUSLY IMPLIES THAT THE PROPERTY OWNER IS PROVIDING HIS OR HER OWN LABOR AND MATERIAL PERSONALLY. I, AS AN OWNERBUILDER, MAY BE HELD LIABLE AND SUBJECT TO SERIOUS FINANCIAL RISK FOR ANY INJURIES SUSTAINED BY AN UNLICENSED PERSON AND HIS OR HER EMPLOYEES WHILE WORKING ON MY PROPERTY. MY HOMEOWNER'S INSURANCE MAY NOT PROVIDE COVERAGE FOR THOSE INJURIES. I AM WILLFULLY ACTING AS AN OWNER-BUILDER AND AM AWARE OF THE LIMITS OF MY INSURANCE

COVERAGE FOR INJURIES TO WORKERS ON MY PROPERTY.

2. I UNDERSTAND BUILDING PERMITS ARE NOT REQUIRED TO BE SIGNED BY PROPERTY OWNERS UNLESS THEY ARE RESPONSIBLE FOR THE
CONSTRUCTION AND ARE NOT HIRING A LICENSED CONTRACTOR TO ASSUME THIS RESPONSIBILITY.

3. I UNDERSTAND AS AN "OWNER-BUILDER" I AM THE RESPONSIBLE PARTY OF RECORD ON THE PERMIT. I UNDERSTAND THAT I MAY PROTECT MYSELF FROM POTENTIAL FINANCIAL RISK BY HIRING A LICENSED CONTRACTOR AND HAVING THE PERMIT FILED IN HIS OR HER NAME INSTEAD OF MY OWN.

4. I UNDERSTAND CONTRACTORS ARE REQUIRED BY LAW TO BE LICENSED AND BONDED IN CALIFORNIA AND TO LIST

5. I UNDERSTAND IF I EMPLOY OR OTHERWISE ENGAGE ANY PERSONS, OTHER THAN CALIFORNIA LICENSED CONTRACTORS, AND THE TOTAL VALUE OF MY CONSTRUCTION IS AT LEAST \$500.00, INCLUDING LABOR AND MATERIALS, I MAY BE CONSIDERED AN "EMPLOYER" UNDER STATE AND FEDERAL LAW.

THEIR LICENSE NUMBERS ON PERMITS AND CONTRACTS.

STATE AND FEDERAL
GOVERNMENT, WITHHOLD PAYROLL TAXES, PROVIDE WORKERS' COMPENSATION DISABILITY INSURANCE, AND
CONTRIBUTE TO UNEMPLOYMENT COMPENSATION FOR EACH "EMPLOYEE." I ALSO UNDERSTAND MY FAILURE TO ABIDE
BY THESE LAWS MAY SUBJECT ME TO SERIOUS FINANCIAL RISK.
7. I UNDERSTAND UNDER CALIFORNIA CONTRACTORS' STATE LICENSE LAW, AN OWNER-BUILDER WHO BUILDS

6. I UNDERSTAND IF I AM CONSIDERED AN "EMPLOYER" UNDER STATE AND FEDERAL LAW, I MUST REGISTER WITH THE

SINGLE-FAMILY RESIDENTIAL STRUCTURES CANNOT LEGALLY BUILD THEM WITH THE INTENT TO OFFER THEM FOR SALE, UNLESS ALL WORK IS PERFORMED BY LICENSED SUBCONTRACTORS AND THE NUMBER OF STRUCTURES DOES NOT EXCEED FOUR WITHIN ANY CALENDAR YEAR, OR ALL OF THE WORK IS PERFORMED UNDER CONTRACT WITH A LICENSED GENERAL BUILDING CONTRACTOR.

8. I UNDERSTAND AS AN OWNER-BUILDER IF I SELL THE PROPERTY FOR WHICH THIS PERMIT IS ISSUED. I MAY BE HELD

LIABLE FOR ANY FINANCIAL OR PERSONAL INJURIES SUSTAINED BY ANY SUBSEQUENT OWNER(S) THAT RESULT FROM ANY LATENT CONSTRUCTION DEFECTS IN THE WORKMANSHIP OR MATERIALS.

9. I UNDERSTAND I MAY OBTAIN MORE INFORMATION REGARDING MY OBLIGATIONS AS AN "EMPLOYER" FROM THE INTERNAL REVENUE

SERVICE, THE UNITED STATES SMALL BUSINESS ADMINISTRATION, THE CALIFORNIA DEPARTMENT OF BENEFIT

PAYMENTS, AND THE CALIFORNIA DIVISION OF INDUSTRIAL ACCIDENTS. I ALSO UNDERSTAND I MAY CONTACT THE CALIFORNIA CONTRACTORS' STATE LICENSE BOARD (CSLB) AT 1-800-321-CSLB (2752) OR WWW.CSLB.CA.GOV FOR MORE INFORMATION ABOUT LICENSED CONTRACTORS.

10. I AM AWARE OF AND CONSENT TO AN OWNER-BUILDER BUILDING PERMIT APPLIED FOR IN MY NAME, AND UNDERSTAND THAT I AM THE PARTY LEGALLY AND FINANCIALLY RESPONSIBLE FOR PROPOSED CONSTRUCTION

ACTIVITY AT THE FOLLOWING ADDRESS:
SIGNATURE OF PROPERTY OWNER: DATE:
11. I AGREE THAT, AS THE PARTY LEGALLY AND FINANCIALLY RESPONSIBLE FOR THIS PROPOSED CONSTRUCTION ACTIVITY, I WILL ABIDE BY ALL APPLICABLE LAWS AND REQUIREMENTS THAT GOVERN OWNER-BUILDERS AS WELL AS EMPLOYERS.

OF THE INFORMATION
I HAVE PROVIDED ON THIS FORM. LICENSED CONTRACTORS ARE REGULATED BY LAWS DESIGNED TO PROTECT THE PUBLIC. IF YOU CONTRACT WITH SOMEONE WHO DOES NOT HAVE A LICENSE, THE CONTRACTORS' STATE LICENSE BOARD MAY BE UNABLE TO ASSIST YOU WITH ANY FINANCIAL LOSS YOU MAY SUSTAIN AS A RESULT OF A COMPLAINT. YOUR ONLY REMEDY AGAINST UNLICENSED CONTRACTORS MAY BE IN CIVIL COURT. IT IS ALSO IMPORTANT FOR YOU TO UNDERSTAND THAT IF AN UNLICENSED CONTRACTOR OR EMPLOYEE OF THAT INDIVIDUAL OR FIRM IS INJURED WHILE WORKING ON YOUR PROPERTY, YOU MAY BE HELD LIABLE FOR DAMAGES. IF YOU OBTAIN A PERMIT AS OWNER-BUILDER AND WISH TO HIRE CONTRACTORS, YOU WILL BE RESPONSIBLE FOR VERIFYING WHETHER OR NOT THOSE CONTRACTORS ARE PROPERLY LICENSED AND THE STATUS OF THEIR WORKERS' COMPENSATION INSURANCE COVERAGE.

12. I AGREE TO NOTIFY THE ISSUER OF THIS FORM IMMEDIATELY OF ANY ADDITIONS, DELETIONS, OR CHANGES TO ANY


anura design


REVISIONS

<u>√</u>1 06/27/2025

<u>/2</u>\ 07/25/2025

3

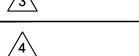

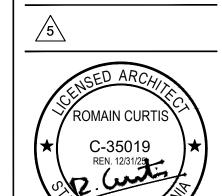

ROMAIN CURTIS ARCHITECT #C35019 367 CIVIC DR #3, PLEASANT HILL, CA94523 phone: 510.612.0345

367 CIVIC DR #3,
PLEASANT HILL, CA9452
phone: 510.612.0345
roman@anuradesign.com

10DEL BLVD, 34501

ADDITION / REMO 1301 FERNSIDE BL ALAMFDA CA 94

GENERAL NOTE

CA008

CHECKED BY

CA007

SCALE

05/07/2025

N/A
ANURA JOB NO
CA2504-0002

GN<sub>-</sub>1

Manufacturer's product specification

REVISIONS

/2\ 07/25/2025



ROMAIN CURTIS ARCHITECT #C35019 367 CIVIC DR #3, PLEASANT HILL, CA94523 phone: 510.612.0345

roman@anuradesign.com

4.505.3 MOISTURE CONTENT OF BUILDING MATERIALS. Building materials with visible signs of water damage

shall not be installed. Wall and floor framing shall not be enclosed when the framing members exceed 19 percent moisture content. Moisture content shall be verified in compliance with the following 1. Moisture content shall be determined with either a probe-type or contact-type moisture meter. Equivalent moisture verification methods may be approved by the enforcing agency and shall satisfy requirements 2. Moisture readings shall be taken at a point 2 feet (610 mm) to 4 feet (1219 mm) from the grade stamped end

3. At least three random moisture readings shall be performed on wall and floor framing with documentation acceptable to the enforcing agency provided at the time of approval to enclose the wall and floor framing.

Insulation products which are visibly wet or have a high moisture content shall be replaced or allowed to dry prior to enclosure in wall or floor cavities. Wet-applied insulation products shall follow the manufacturers' drying

4.506.1 Bathroom exhaust fans. Each bathroom shall be mechanically ventilated and shall comply with the

a. Humidity controls shall be capable of adjustment between a relative humidity range less than or equal to 50% to a maximum of 80%. A humidity control may utilize manual or automatic means of

b. A humidity control may be a separate component to the exhaust fan and is not required to be

1. For the purposes of this section, a bathroom is a room which contains a bathtub, shower or 2. Lighting integral to bathroom exhaust fans shall comply with the California Energy Code.

4.507.2 HEATING AND AIR-CONDITIONING SYSTEM DESIGN. Heating and air conditioning systems shall be

1. The heat loss and heat gain is established according to ANSI/ACCA 2 Manual J - 2011 (Residential Load Calculation), ASHRAE handbooks or other equivalent design software or methods.

2. Duct systems are sized according to ANSI/ACCA 1 Manual D - 2014 (Residential Duct Systems), ASHRAE handbooks or other equivalent design software or methods 3. Select heating and cooling equipment according to ANSI/ACCA 3 Manual S - 2014 (Residential Equipment Selection), or other equivalent design software or methods.

**Exception:** Use of alternate design temperatures necessary to ensure the system functions are

702.1 INSTALLER TRAINING. HVAC system installers shall be trained and certified in the proper installation of HVAC systems including ducts and equipment by a nationally or regionally recognized training or certification program Uncertified persons may perform HVAC installations when under the direct supervision and responsibility of a person trained and certified to install HVAC systems or contractor licensed to install HVAC systems. Examples of acceptable HVAC training and certification programs include but are not limited to the following:

3. Training programs sponsored by trade, labor or statewide energy consulting or verification organizations.

702.2 SPECIAL INSPECTION [HCD]. When required by the enforcing agency, the owner or the responsible

certifications or qualifications acceptable to the enforcing agency, the following certifications or education may be considered by the enforcing agency when evaluating the qualifications of a special inspector: 1. Certification by a national or regional green building program or standard publisher.

Certification by a statewide energy consulting or verification organization, such as HERS raters, building performance contractors, and home energy auditors. Successful completion of a third party apprentice training program in the appropriate trade.

1. Special inspectors shall be independent entities with no financial interest in the materials or the project they are inspecting for compliance with this code.

2. HERS raters are special inspectors certified by the California Energy Commission (CEC) to rate

homes in California according to the Home Energy Rating System (HERS). [BSC] When required by the enforcing agency, the owner or the responsible entity acting as the owner's agent shall this code. Special inspectors shall demonstrate competence to the satisfaction of the enforcing agency for the particular type of inspection or task to be performed. In addition, the special inspector shall have a certification from a recognized state, national or international association, as determined by the local agency. The area of certification

Note: Special inspectors shall be independent entities with no financial interest in the materials or the

703.1 DOCUMENTATION. Documentation used to show compliance with this code shall include but is not limited

to, construction documents, plans, specifications, builder or installer certification, inspection reports, or other methods acceptable to the enforcing agency which demonstrate substantial conformance. When specific documentation or special inspection is necessary to verify compliance, that method of compliance will be specified in the appropriate

NOT APPLICABLE RESPONSIBLE PARTY (ie: ARCHITECT, ENGINEER,

# 2022 SINGLE-FAMILY RESIDENTIAL MANDATORY REQUIREMENTS SUMMARY

NOTE: Single—family residential buildings subject to the Energy Codes must comply with all applicable mandatory measures, regardless of the compliance approach used. Review the respective section for more information.

### BUILDING ENVELOPE:

§110.6(A)1: AIR LEAKAGE. MANUFACTURED FENESTRATION, EXTERIOR DOORS, AND EXTERIOR PET DOORS MUST LIMIT AIR LEAKAGE TO 0.3 CFM PER SQUARE FOOT OR LESS WHEN TESTED PER NFRC-400, ASTM E283, OR AAMA/WDMA/CSA 101/LS.2/A440-2011. \*

§110.6(A)5: LABELING. FENESTRATION PRODUCTS AND EXTERIOR DOORS MUST HAVE A LABEL MEETING THE REQUIREMENTS OF §10-111(A).

§110.6(B): FIELD FABRICATED EXTERIOR DOORS AND FENESTRATION PRODUCTS MUST USE U-FACTORS AND SOLAR HEAT GAIN COEFFICIENT (SHGC) VALUES FROM TABLES 110.6-A, 110.6-B, OR JA4.5 FOR EXTERIOR DOORS. THEY MUST BE CAULKED AND/OR WEATHER-STRIPPED. \*

§110.7: AIR LEAKAGE. ALL JOINTS, PENETRATIONS, AND OTHER OPENINGS IN THE BUILDING ENVELOPE THAT ARE POTENTIAL SOURCES OF AIR LEAKAGE MUST BE CAULKED, GASKETED, OR WEATHER STRIPPED.

§110.8(A): INSULATION CERTIFICATION BY MANUFACTURERS. INSULATION MUST BE CERTIFIED BY THE DEPARTMENT OF CONSUMER AFFAIRS, BUREAU OF HOUSEHOLD GOODS AND SERVICES (BHGS).

§110.8(G): INSULATION REQUIREMENTS FOR HEATED SLAB FLOORS. HEATED SLAB FLOORS MUST BE INSULATED PER THE REQUIREMENTS OF § 110.8(G).

§110.8(I): ROOFING PRODUCTS SOLAR REFLECTANCE AND THERMAL EMITTANCE. THE THERMAL EMITTANCE AND AGED SOLAR REFLECTANCE VALUES OF THE ROOFING MATERIAL MUST MEET THE REQUIREMENTS OF § 110.8(I) AND BE LABELED PER §10–113 WHEN THE INSTALLATION OF A COOL ROOF IS SPECIFIED ON THE CF1R.

§110.8(J): RADIANT BARRIER. WHEN REQUIRED, RADIANT BARRIERS MUST HAVE AN EMITTANCE OF 0.05 OR LESS AND BE CERTIFIED TO THE DEPARTMENT OF CONSUMER AFFAIRS.

§150.0(A): ROOF DECK, CEILING AND RAFTER ROOF INSULATION. ROOF DECKS IN NEWLY CONSTRUCTED ATTICS IN CLIMATE ZONES 4 AND 8-16 AREA-WEIGHTED AVERAGE U-FACTOR NOT EXCEEDING U-0.184. CEILING AND RAFTER ROOFS MINIMUM R-22 INSULATION IN WOOD-FRAME CEILING; OR AREA-WEIGHTED AVERAGE U-FACTOR MUST NOT EXCEED 0.043. RAFTER ROOF ALTERATIONS MINIMUM R-19 OR AREA-WEIGHTED AVERAGE U-FACTOR OF 0.054 OR LESS. ATTIC ACCESS DOORS MUST HAVE PERMANENTLY ATTACHED INSULATION USING ADHESIVE OR MECHANICAL FASTENERS. THE ATTIC ACCESS MUST BE GASKETED TO PREVENT AIR LEAKAGE. INSULATION MUST BE INSTALLED IN DIRECT CONTACT WITH A ROOF OR CEILING WHICH IS SEALED TO LIMIT INFILTRATION AND EXFILTRATION AS SPECIFIED IN § 110.7, INCLUDING BUT NOT LIMITED TO PLACING INSULATION EITHER ABOVE OR BELOW THE ROOF DECK OR ON TOP OF A DRYWALL CEILING. \*

§150.0(B): LOOSE-FILL INSULATION. LOOSE FILL INSULATION MUST MEET THE MANUFACTURER'S REQUIRED DENSITY FOR THE LABELED R-VALUE.

§150.0(C): WALL INSULATION. MINIMUM R-13 INSULATION IN 2X4 INCH WOOD FRAMING WALL OR HAVE A U-FACTOR OF 0.102 OR LESS, OR R-20 IN 2X6 INCH WOOD FRAMING OR HAVE A U-FACTOR OF 0.071 OR LESS. OPAQUE NON-FRAMED ASSEMBLIES MUST HAVE AN OVERALL ASSEMBLY U-FACTOR NOT EXCEEDING 0.102. MASONRY WALLS MUST MEET TABLES 150.1-A OR B. \*

\$150.0(D): RAISED-FLOOR INSULATION. MINIMUM R-19 INSULATION IN RAISED WOOD FRAMED FLOOR OR 0.037 MAXIMUM U-FACTOR. \*

\$150.0(F): SLAB EDGE INSULATION. SLAB EDGE INSULATION MUST MEET ALL OF THE FOLLOWING: HAVE A WATER ABSORPTION RATE, FOR THE INSULATION MATERIAL ALONE WITHOUT FACINGS, NO GREATER THAN 0.3 PERCENT; HAVE A WATER VAPOR PERMEANCE NO GREATER THAN 2.0 PERM PER INCH; BE PROTECTED FROM PHYSICAL DAMAGE AND UV LIGHT DETERIORATION; AND, WHEN INSTALLED AS PART OF A HEATED SLAB FLOOR, MEET THE REQUIREMENTS OF \$ 110.8(G).

§150.0(G)1: VAPOR RETARDER. IN CLIMATE ZONES 1 THROUGH 16, THE EARTH FLOOR OF UNVENTED CRAWL SPACE MUST BE COVERED WITH A CLASS I OR CLASS II VAPOR RETARDER. THIS REQUIREMENT ALSO APPLIES TO CONTROLLED VENTILATION CRAWL SPACE FOR BUILDINGS COMPLYING WITH THE EXCEPTION TO §150.0(D).

\$150.0(G)2: VAPOR RETARDER. IN CLIMATE ZONES 14 AND 16, A CLASS I OR CLASS II VAPOR RETARDER MUST BE INSTALLED ON THE CONDITIONED SPACE SIDE OF ALL INSULATION IN ALL EXTERIOR WALLS, VENTED ATTICS, AND UNVENTED ATTICS WITH AIR—PERMEABLE INSULATION.

§150.0(Q): FENESTRATION PRODUCTS. FENESTRATION, INCLUDING SKYLIGHTS, SEPARATING CONDITIONED SPACE FROM UNCONDITIONED SPACE OR OUTDOORS MUST HAVE A MAXIMUM U-FACTOR OF 0.45; OR AREA-WEIGHTED AVERAGE U-FACTOR OF ALL FENESTRATION MUST NOT EXCEED 0.45.\*

# FIREPLACES, DECORATIVE GAS APPLIANCES, AND GAS LOG:

§110.5(E): PILOT LIGHT. CONTINUOUSLY BURNING PILOT LIGHTS ARE NOT ALLOWED FOR INDOOR AND OUTDOOR FIREPLACES.

§150.0(E)1: CLOSABLE DOORS. MASONRY OR FACTORY—BUILT FIREPLACES MUST HAVE A CLOSABLE METAL OR GLASS DOOR COVERING THE ENTIRE OPENING OF THE FIREBOX.

\$150.0(E)2: COMBUSTION INTAKE. MASONRY OR FACTORY-BUILT FIREPLACES MUST HAVE A COMBUSTION OUTSIDE AIR INTAKE, WHICH IS AT LEAST SIX SQUARE INCHES IN AREA AND IS EQUIPPED WITH A READILY ACCESSIBLE, OPERABLE, AND TIGHT-FITTING DAMPER OR COMBUSTION—AIR CONTROL DEVICE. \*

\$150.0(E)3: FLUE DAMPER. MASONRY OR FACTORY—BUILT FIREPLACES MUST HAVE A FLUE DAMPER WITH A READILY ACCESSIBLE CONTROL. \*

# SPACE CONDITIONING, WATER HEATING, AND PLUMBING SYSTEM:

§110.0-§ 110.3: CERTIFICATION. HEATING, VENTILATION, AND AIR CONDITIONING (HVAC) EQUIPMENT, WATER HEATERS, SHOWERHEADS, FAUCETS, AND ALL OTHER REGULATED APPLIANCES MUST BE CERTIFIED BY THE MANUFACTURER TO THE CALIFORNIA ENERGY COMMISSION. \*

§110.2(A): HVAC EFFICIENCY. EQUIPMENT MUST MEET THE APPLICABLE EFFICIENCY REQUIREMENTS IN TABLE 110.2—A THROUGH TABLE 110.2—N. \*

§110.2(B): CONTROLS FOR HEAT PUMPS WITH SUPPLEMENTARY ELECTRIC RESISTANCE HEATERS. HEAT PUMPS WITH SUPPLEMENTARY ELECTRIC RESISTANCE HEATERS MUST HAVE CONTROLS THAT PREVENT SUPPLEMENTARY HEATER OPERATION WHEN THE HEATING LOAD CAN BE MET BY THE HEAT PUMP ALONE; AND IN WHICH THE CUT—ON TEMPERATURE FOR COMPRESSION HEATING IS HIGHER THAN THE CUT—ON TEMPERATURE FOR SUPPLEMENTARY HEATING, AND THE CUT—OFF TEMPERATURE FOR SUPPLEMENTARY HEATING. \*

§110.2(C): THERMOSTATS. ALL HEATING OR COOLING SYSTEMS NOT CONTROLLED BY A CENTRAL ENERGY MANAGEMENT CONTROL SYSTEM (EMCS) MUST HAVE A SETBACK THERMOSTAT. \*

§110.3(C)3: INSULATION. UNFIRED SERVICE WATER HEATER STORAGE TANKS AND SOLAR WATER—HEATING BACKUP TANKS MUST HAVE ADEQUATE INSULATION, OR TANK SURFACE HEAT LOSS RATING.

§110.3(C)6: ISOLATION VALVES. INSTANTANEOUS WATER HEATERS WITH AN INPUT RATING GREATER THAN 6.8 KBTU PER HOUR (2 KW) MUST HAVE ISOLATION VALVES WITH HOSE BIBBS OR OTHER FITTINGS ON BOTH COLD AND HOT WATER LINES TO ALLOW FOR FLUSHING THE WATER HEATER WHEN THE VALVES ARE CLOSED.

§ 110.5: PILOT LIGHTS. CONTINUOUSLY BURNING PILOT LIGHTS ARE PROHIBITED FOR NATURAL GAS: FAN-TYPE CENTRAL FURNACES; HOUSEHOLD COOKING APPLIANCES (EXCEPT APPLIANCES WITHOUT AN ELECTRICAL SUPPLY VOLTAGE CONNECTION WITH PILOT LIGHTS THAT CONSUME LESS THAN 150 BTU PER HOUR ); AND POOL AND SPA HEATERS. \*

# § 150.0(H)1:

BUILDING COOLING AND HEATING LOADS. HEATING AND/OR COOLING LOADS ARE CALCULATED IN ACCORDANCE WITH THE ASHRAE HANDBOOK, EQUIPMENT VOLUME, APPLICATIONS VOLUME, AND FUNDAMENTALS VOLUME; THE SMACNA RESIDENTIAL COMFORT SYSTEM INSTALLATION STANDARDS MANUAL; OR THE ACCA MANUAL J USING DESIGN CONDITIONS SPECIFIED IN § 150.0(H)2.

§ 150.0(H)3A: CLEARANCES. AIR CONDITIONER AND HEAT PUMP OUTDOOR CONDENSING UNITS MUST HAVE A CLEARANCE OF AT LEAST FIVE FEET FROM THE OUTLET OF ANY DRYER.

§ 150.0(H)3B: LIQUID LINE DRIER. AIR CONDITIONERS AND HEAT PUMP SYSTEMS MUST BE EQUIPPED WITH LIQUID LINE FILTER DRIERS IF REQUIRED, AS SPECIFIED BY THE MANUFACTURER'S INSTRUCTIONS.

§ 150.0(J)1:
WATER PIPING, SOLAR WATER-HEATING SYSTEM PIPING, AND SPACE CONDITIONING SYSTEM LINE INSULATION. ALL DOMESTIC HOT WATER PIPING MUST BE INSULATED AS SPECIFIED IN § 609.11 OF THE CALIFORNIA PLUMBING CODE. \*

§ 150.0(J)2: INSULATION PROTECTION. PIPING INSULATION MUST BE PROTECTED FROM DAMAGE, INCLUDING THAT DUE TO SUNLIGHT, MOISTURE, EQUIPMENT' MAINTENANCE, AND WIND AS REQUIRED BY §120.3(B). INSULATION EXPOSED TO WEATHER MUST BE WATER RETARDANT AND PROTECTED FROM UV LIGHT (NO ADHESIVE TAPES). INSULATION COVERING CHILLED WATER PIPING AND REFRIGERANT SUCTION PIPING LOCATED OUTSIDE THE CONDITIONED SPACE MUST INCLUDE, OR BE PROTECTED BY, A CLASS I OR CLASS II VAPOR RETARDER. PIPE INSULATION BURIED BELOW GRADE MUST BE INSTALLED IN A WATERPROOF AND NON-CRUSHABLE CASING OR SLEEVE.

§ 150.0(N)1: GAS OR PROPANE WATER HEATING SYSTEMS. SYSTEMS USING GAS OR PROPANE WATER HEATERS TO SERVE INDIVIDUAL DWELLING UNITS MUST DESIGNATE A SPACE AT LEAST 2.5'X 2.5'X 7'SUITABLE FOR THE FUTURE INSTALLATION OF A HEAT PUMP WATER HEATER, AND MEET ELECTRICAL AND PLUMBING REQUIREMENTS, BASED ON THE DISTANCE BETWEEN THIS DESIGNATED SPACE AND THE WATER HEATER LOCATION; AND A CONDENSATE DRAIN NO MORE THAN 2"HIGHER THAN THE BASE OF THE WATER HEATER

§ 150.0(N)3: SOLAR WATER—HEATING SYSTEMS. SOLAR WATER—HEATING SYSTEMS AND COLLECTORS MUST BE CERTIFIED AND RATED BY THE SOLAR RATING AND CERTIFICATION CORPORATION (SRCC), THE INTERNATIONAL ASSOCIATION OF PLUMBING AND MECHANICAL OFFICIALS, RESEARCH AND TESTING (IAPMO R&T), OR BY A LISTING AGENCY THAT IS APPROVED BY THE EXECUTIVE DIRECTOR.

#### **DUCTS AND FANS:**

§ 110.8(D)3: DUCTS. INSULATION INSTALLED ON AN EXISTING SPACE—CONDITIONING DUCT MUST COMPLY WITH § 604.0 OF THE CALIFORNIA MECHANICAL CODE (CMC). IF A CONTRACTOR INSTALLS THE INSULATION, THE CONTRACTOR MUST CERTIFY TO THE CUSTOMER, IN WRITING, THAT THE INSULATION MEETS THIS REQUIREMENT.

§ 150.0(M)1: CMC COMPLIANCE. ALL AIR-DISTRIBUTION SYSTEM DUCTS AND PLENUMS MUST MEET CMC §§ 601.0-605.0 AND ANSI/SMACNA-006-2006 HVAC DUCT CONSTRUCTION STANDARDS METAL AND FLEXIBLE 3RD EDITION. PORTIONS OF SUPPLY-AIR AND RETURN-AIR DUCTS AND PLENUMS MUST BE INSULATED TO R-6.0 OR HIGHER; DUCTS LOCATED ENTIRELY IN CONDITIONED SPACE AS CONFIRMED THROUGH FIELD VERIFICATION AND DIAGNOSTIC TESTING (RA3.1.4.3.8) DO NOT REQUIRE INSULATION. CONNECTIONS OF METAL DUCTS AND INNER CORE OF FLEXIBLE DUCTS MUST BE MECHANICALLY FASTENED. OPENINGS MUST BE SEALED WITH MASTIC, TAPE, OR OTHER DUCT-CLOSURE SYSTEM THAT MEETS THE APPLICABLE UL REQUIREMENTS, OR AEROSOL SEALANT THAT MEETS UL 723. THE COMBINATION OF MASTIC AND EITHER MESH OR TAPE MUST BE USED TO SEAL OPENINGS GREATER THAN ¼", IF MASTIC OR TAPE IS USED. BUILDING CAVITIES, AIR HANDLER SUPPORT PLATFORMS, AND PLENUMS DESIGNED OR CONSTRUCTED WITH MATERIALS OTHER THAN SEALED SHEET METAL, DUCT BOARD OR FLEXIBLE DUCT MUST NOT BE USED TO CONVEY CONDITIONED AIR. BUILDING CAVITIES AND SUPPORT PLATFORMS MAY CONTAIN DUCTS; DUCTS INSTALLED IN THESE SPACES MUST NOT BE COMPRESSED. \*

§ 150.0(M)2: FACTORY—FABRICATED DUCT SYSTEMS. FACTORY—FABRICATED DUCT SYSTEMS MUST COMPLY WITH APPLICABLE REQUIREMENTS FOR DUCT CONSTRUCTION, CONNECTIONS, AND CLOSURES; JOINTS AND SEAMS OF DUCT SYSTEMS AND THEIR COMPONENTS MUST NOT BE SEALED WITH CLOTH BACK RUBBER ADHESIVE DUCT TAPES UNLESS SUCH TAPE IS USED IN COMBINATION WITH MASTIC AND DRAW BANDS.

§ 150.0(M)3: FIELD-FABRICATED DUCT SYSTEMS. FIELD-FABRICATED DUCT SYSTEMS MUST COMPLY WITH APPLICABLE REQUIREMENTS FOR: PRESSURE-SENSITIVE TAPES, MASTICS, SEALANTS, AND OTHER REQUIREMENTS SPECIFIED FOR DUCT CONSTRUCTION.

§ 150.0(M)7: BACKDRAFT DAMPER. FAN SYSTEMS THAT EXCHANGE AIR BETWEEN THE CONDITIONED SPACE AND OUTDOORS MUST HAVE BACKDRAFT OR AUTOMATIC DAMPERS.

§ 150.0(M)8: GRAVITY VENTILATION DAMPERS. GRAVITY VENTILATING SYSTEMS SERVING CONDITIONED SPACE MUST HAVE EITHER AUTOMATIC OR READILY ACCESSIBLE, MANUALLY OPERATED DAMPERS IN ALL OPENINGS TO THE OUTSIDE, EXCEPT COMBUSTION INLET AND OUTLET AIR OPENINGS AND ELEVATOR SHAFT VENTS.

§ 150.0(M)9: PROTECTION OF INSULATION. INSULATION MUST BE PROTECTED FROM DAMAGE DUE TOSUNLIGHT, MOISTURE, EQUIPMENT MAINTENANCE, AND WIND. INSULATION EXPOSED TO WEATHER MUST BE SUITABLE FOR OUTDOOR SERVICE (E.G., PROTECTED BY ALUMINUM, SHEET METAL, PAINTED CANVAS, OR PLASTIC COVER). CELLULAR FOAM INSULATION MUST BE PROTECTED AS ABOVE OR PAINTED WITH A WATER RETARDANT AND SOLAR RADIATION—RESISTANT COATING.

§ 150.0(M)10: POROUS INNER CORE FLEX DUCT. POROUS INNER CORES OF FLEX DUCTS MUST HAVE A NON-POROUS LAYER OR AIR BARRIER BETWEEN THE INNER CORE AND OUTER VAPOR BARRIER.

#### § 150.0(M)11:

DUCT SYSTEM SEALING AND LEAKAGE TEST. WHEN SPACE CONDITIONING SYSTEMS USE FORCED AIR DUCT SYSTEMS TO SUPPLY CONDITIONED AIR TO AN OCCUPIABLE SPACE, THE DUCTS MUST BE SEALED AND DUCT LEAKAGE TESTED, AS CONFIRMED THROUGH FIELD VERIFICATION AND DIAGNOSTIC TESTING, IN ACCORDANCE WITH REFERENCE RESIDENTIAL APPENDIX RA3.1.

§ 150.0(M)12: AIR FILTRATION. SPACE CONDITIONING SYSTEMS WITH DUCTS EXCEEDING 10 FEET AND THE SUPPLY SIDE OF VENTILATION SYSTEMS MUST HAVE MERV 13 OR EQUIVALENT FILTERS. FILTERS FOR SPACE CONDITIONING SYSTEMS MUST HAVE A TWO INCH DEPTH OR CAN BE ONE INCH IF SIZED PER EQUATION 150.0—A. CLEAN—FILTER PRESSURE DROP AND LABELING MUST MEET THE REQUIREMENTS IN §150.0(M)12. FILTERS MUST BE ACCESSIBLE FOR REGULAR SERVICE. FILTER RACKS OR GRILLES MUST USE GASKETS, SEALING, OR OTHER MEANS TO CLOSE GAPS AROUND THE INSERTED FILTERS TO AND PREVENTS AIR FROM BYPASSING THE FILTER. \*

§ 150.0(M)13: SPACE CONDITIONING SYSTEM AIRFLOW RATE AND FAN EFFICACY. SPACE CONDITIONING SYSTEMS THAT USE DUCTS TO SUPPLY COOLING MUST HAVE A HOLE FOR THE PLACEMENT OF A STATIC PRESSURE PROBE, OR A PERMANENTLY INSTALLED STATIC PRESSURE PROBE IN THE SUPPLY PLENUM. AIRFLOW MUST BE ≥350 CFM PER TON OF NOMINAL COOLING CAPACITY, AND AN AIR—HANDLING UNIT FAN EFFICACY ≤ 0.45 WATTS PER CFM FOR GAS FURNACE AIR HANDLERS AND ≤ 0.58 WATTS PER CFM FOR ALL OTHERS. SMALL DUCT HIGH VELOCITY SYSTEMS MUST PROVIDE AN AIRFLOW ≥250 CFM PER TON OF NOMINAL COOLING CAPACITY, AND AN AIR—HANDLING UNIT FAN EFFICACY ≤ 0.62 WATTS PER CFM. FIELD VERIFICATION TESTING IS REQUIRED IN ACCORDANCE WITH REFERENCE RESIDENTIAL APPENDIX RA3.3. \*

# VENTILATION AND INDOOR AIR QUALITY:

150.0(0)1: REQUIREMENTS FOR VENTILATION AND INDOOR AIR QUALITY. ALL DWELLING UNITS MUST MEET THE REQUIREMENTS OF ASHRAE STANDARD 62.2, VENTILATION AND ACCEPTABLE INDOOR AIR QUALITY IN RESIDENTIAL BUILDINGS SUBJECT TO THE AMENDMENTS SPECIFIED IN § 150.0(0)1. \*

§ 150.0(0)1B: CENTRAL FAN INTEGRATED (CFI) VENTILATION SYSTEMS. CONTINUOUS OPERATION OF CFI AIR HANDLERS IS NOT ALLOWED TO PROVIDE THE WHOLED—WELLING UNIT VENTILATION AIRFLOW REQUIRED PER §150.0(0)1C. A MOTORIZED DAMPER(S) MUST BE INSTALLED ON THE VENTILATION DUCT(S) THAT PREVENTS ALL AIRFLOW THROUGH THE SPACE CONDITIONING DUCT SYSTEM WHEN THE DAMPER(S) IS CLOSED AND CONTROLLED PER §150.0(0)1BIII&IV. CFI VENTILATION SYSTEMS MUST HAVE CONTROLS THAT TRACK OUTDOOR AIR VENTILATION RUN TIME, AND EITHER OPEN OR CLOSE THE MOTORIZED DAMPER(S) FOR COMPLIANCE WITH §150.0(0)1C.

§ 150.0(0)1C: WHOLE-DWELLING UNIT MECHANICAL VENTILATION FOR SINGLE-FAMILY DETACHED AND TOWNHOUSES . SINGLE-FAMILY DETACHED DWELLING UNITS, AND ATTACHED DWELLING UNITS NOT SHARING CEILINGS OR FLOORS WITH OTHER DWELLING UNITS, OCCUPIABLE SPACES, PUBLIC GARAGES, OR COMMERCIAL SPACES MUST HAVE MECHANICAL VENTILATION AIRFLOW SPECIFIED IN § 150.0(0)1CI-III.

§ 150.0(0)1G: LOCAL MECHANICAL EXHAUST. KITCHENS AND BATHROOMS MUST HAVE LOCAL MECHANICAL EXHAUST; NON-ENCLOSED KITCHENS MUST HAVE DEMAND-CONTROLLED EXHAUST SYSTEM MEETING REQUIREMENTS OF §150.0(0)1GIII, ENCLOSED KITCHENS AND BATHROOMS CAN USE DEMAND-CONTROLLED OR CONTINUOUS EXHAUST MEETING §150.0(0)1GIII-IV. AIRFLOW MUST BE MEASURED BY THE INSTALLER PER §150.0(0)1GV, AND RATED FOR SOUND PER §150.0(0)1GVI. \*

§ 150.0(0)1H&I: AIRFLOW MEASUREMENT AND SOUND RATINGS OF WHOLE—DWELLING UNIT VENTILATION SYSTEMS. THE AIRFLOW REQUIRED PER § 150.0(0)1C MUST BE MEASURED BY USING A FLOW HOOD, FLOW GRID, OR OTHER AIRFLOW MEASURING DEVICE AT THE FAN'S INLET OR OUTLET TERMINALS/GRILLES PER REFERENCE RESIDENTIAL APPENDIX RA3.7. WHOLE—DWELLING UNIT VENTILATION SYSTEMS MUST BE RATED FOR SOUND PER ASHRAE 62.2 §7.2 AT NO LESS THAN THE MINIMUM AIRFLOW RATE REQUIRED BY §150.0(0)1C.

§ 150.0(0)2: FIELD VERIFICATION AND DIAGNOSTIC TESTING. WHOLE—DWELLING UNIT VENTILATION AIRFLOW, VENTED RANGE HOOD AIRFLOW AND SOUND RATING, AND HRV AND ERV FAN EFFICACY MUST BE VERIFIED IN ACCORDANCE WITH REFERENCE RESIDENTIAL APPENDIX RA3.7. VENTED RANGE HOODS MUST BE VERIFIED PER REFERENCE RESIDENTIAL APPENDIX RA3.7.4.3 TO CONFIRM IF IT IS RATED BY HVI OR AHAM TO COMPLY WITH THE AIRFLOW RATES AND SOUND REQUIREMENTS PER §150.0(0)1G

# POOL AND SPA SYSTEMS AND EQUIPMENT:

110.4(A): CERTIFICATION BY MANUFACTURERS. ANY POOL OR SPA HEATING SYSTEM OR EQUIPMENT MUST BE CERTIFIED TO HAVE ALL OF THE FOLLOWING: COMPLIANCE WITH THE APPLIANCE EFFICIENCY REGULATIONS AND LISTING IN MAEDBS; AN ON-OFF SWITCH MOUNTED OUTSIDE OF THE HEATER THAT ALLOWS SHUTTING OFF THE HEATER WITHOUT ADJUSTING THE THERMOSTAT SETTING; A PERMANENT WEATHERPROOF PLATE OR CARD WITH OPERATING INSTRUCTIONS; AND MUST NOT USE ELECTRIC RESISTANCE HEATING. \*

§ 110.4(B)1: PIPING. ANY POOL OR SPA HEATING SYSTEM OR EQUIPMENT MUST BE INSTALLED WITH AT LEAST 36 INCHES OF PIPE BETWEEN THE FILTER AND THE HEATER, OR DEDICATED SUCTION AND RETURN LINES, OR BUILT—IN OR BUILT—UP CONNECTIONS TO ALLOW FOR FUTURE SOLAR HEATING.

§ 110.4(B)2: COVERS. OUTDOOR POOLS OR SPAS THAT HAVE A HEAT PUMP OR GAS HEATER MUST HAVE A COVER.

§ 110.4(B)3: DIRECTIONAL INLETS AND TIME SWITCHES FOR POOLS. POOLS MUST HAVE DIRECTIONAL INLETS THAT ADEQUATELY MIX THE POOL WATER, AND A TIME SWITCH THAT WILL ALLOW ALL PUMPS TO BE SET OR PROGRAMMED TO RUN ONLY DURING OFF—PEAK ELECTRIC DEMAND PERIODS.

§ 110.5: PILOT LIGHT. NATURAL GAS POOL AND SPA HEATERS MUST NOT HAVE A CONTINUOUSLY BURNING PILOT LIGHT.

§ 150.0(P): POOL SYSTEMS AND EQUIPMENT INSTALLATION. RESIDENTIAL POOL SYSTEMS OR EQUIPMENT MUST MEET THE SPECIFIED REQUIREMENTS FOR PUMP SIZING, FLOW RATE, PIPING, FILTERS, AND VALVES. \*

#### LIGHTING:

§ 110.9: LIGHTING CONTROLS AND COMPONENTS. ALL LIGHTING CONTROL DEVICES AND SYSTEMS, BALLASTS, AND LUMINAIRES MUST MEET THE APPLICABLE REQUIREMENTS OF § 110.9. \*

§ 150.0(K)1A: LUMINAIRE EFFICACY. ALL INSTALLED LUMINARIES MUST MEET THE REQUIREMENTS IN TABLE 150.0—A, EXCEPT LIGHTING INTEGRAL TO EXHAUST FANS, KITCHEN RANGE HOODS, BATH VANITY MIRRORS, AND GARAGE DOOR OPENERS; NAVIGATION LIGHTING LESS THAN 5 WATTS; AND LIGHTING INTERNAL TO DRAWERS, CABINETS, AND LINEN CLOSETS WITH AN EFFICACY OF AT LEAST 45 LUMENS PER WATT.

§ 150.0(K)1B: SCREW BASED LUMINARIES. SCREW BASED LUMINARIES MUST CONTAIN LAMPS THAT COMPLY WITH REFERENCE JOINT APPENDIX JA8. \*

§ 150.0(K)1C: RECESSED DOWNLIGHT LUMINAIRES IN CEILINGS. LUMINAIRES RECESSED INTO CEILINGS MUST NOT CONTAIN SCREW BASED SOCKETS, MUST BE AIRTIGHT, AND MUST BE SEALED WITH A GASKET OR CAULK. CALIFORNIA ELECTRICAL CODE § 410.116 MUST ALSO BE MET.

§ 150.0(K)1D: LIGHT SOURCES IN ENCLOSED OR RECESSED LUMINAIRES. LAMPS AND OTHER SEPARABLE LIGHT SOURCES THAT ARE NOT COMPLIANT WITH THE JA8 ELEVATED TEMPERATURE REQUIREMENTS, INCLUDING MARKING REQUIREMENTS, MUST NOT BE INSTALLED IN ENCLOSED OR RECESSED LUMINAIRES.

§ 150.0(K)1E: BLANK ELECTRICAL BOXES. THE NUMBER OF ELECTRICAL BOXES THAT ARE MORE THAN FIVE FEET ABOVE THE FINISHED FLOOR AND DO NOT CONTAIN A LUMINAIRE OR OTHER DEVICE SHALL BE NO MORE THAN THE NUMBER OF BEDROOMS. THESE BOXES MUST BE SERVED BY A DIMMER, VACANCY SENSOR CONTROL, LOW VOLTAGE WIRING, OR FAN SPEED CONTROL.

§ 150.0(K)1F: LIGHTING INTEGRAL TO EXHAUST FANS. LIGHTING INTEGRAL TO EXHAUST FANS (EXCEPT WHEN INSTALLED BY THE MANUFACTURER IN KITCHEN EXHAUST HOODS) MUST MEET THE APPLICABLE REQUIREMENTS OF § 150.0(K).

JOINT APPENDIX JA8. \*

§ 150.0(K)1H: LIGHT SOURCES IN ENCLOSED OR RECESSED LUMINAIRES. LAMPS AND OTHER SEPARABLE LIGHT SOURCES

§ 150.0(K)1G: SCREW BASED LUMINAIRES. SCREW BASED LUMINAIRES MUST CONTAIN LAMPS THAT COMPLY WITH REFERENCE

THAT ARE NOT COMPLIANT WITH THE JAS ELEVATED TEMPERATURE REQUIREMENTS, INCLUDING MARKING REQUIREMENTS, MUS'NOT BE INSTALLED IN ENCLOSED OR RECESSED LUMINAIRES.

§ 150.0(K)1I: LIGHT SOURCES IN DRAWERS, CABINETS, AND LINEN CLOSETS. LIGHT SOURCES INTERNAL TO DRAWERS, CABINETRY OR LINEN CLOSETS ARE NOT REQUIRED TO COMPLY WITH TABLE 150.0—A OR BE CONTROLLED BY VACANCY SENSORS PROVIDED THAT THEY ARE RATED TO CONSUME NO MORE THAN 5 WATTS OF POWER, EMIT NO MORE THAN 150 LUMENS, AND ARE EQUIPPED WITH CONTROLS THAT AUTOMATICALLY TURN THE LIGHTING OFF WHEN THE DRAWER, CABINET OR LINEN CLOSET IS CLOSED.

§ 150.0(K)2A: INTERIOR SWITCHES AND CONTROLS. ALL FORWARD PHASE CUT DIMMERS USED WITH LED LIGHT SOURCES MUST COMPLY WITH NEMA SSL 7A.

§ 150.0(K)2B: INTERIOR SWITCHES AND CONTROLS. EXHAUST FANS MUST BE CONTROLLED SEPARATELY FROM LIGHTING SYSTEMS.

§ 150.0(K)2A: ACCESSIBLE CONTROLS. LIGHTING MUST HAVE READILY ACCESSIBLE WALL—MOUNTED CONTROLS THAT ALLOW THE LIGHTING TO BE MANUALLY TURNED ON AND OFF. \*

§ 150.0(K)2B: MULTIPLE CONTROLS. CONTROLS MUST NOT BYPASS A DIMMER, OCCUPANT SENSOR, OR VACANCY SENSOR FUNCTION IF THE DIMMER OR SENSOR IS INSTALLED TO COMPLY WITH § 150.0(K).

§ 150.0(K)2C: MANDATORY REQUIREMENTS. LIGHTING CONTROLS MUST COMPLY WITH THE APPLICABLE REQUIREMENTS OF § 110.9.

§ 150.0(K)2D: ENERGY MANAGEMENT CONTROL SYSTEMS. AN ENERGY MANAGEMENT CONTROL SYSTEM (EMCS) MAY BE USED TO COMPLY WITH DIMMING, OCCUPANCY, AND CONTROL REQUIREMENTS IF IT PROVIDES THE FUNCTIONALITY OF THE SPECIFIED CONTROL PER § 110.9 AND THE PHYSICAL CONTROLS SPECIFIED IN § 150.0(K)2A.

§ 150.0(K)2E: AUTOMATIC SHUTOFF CONTROLS. IN BATHROOMS, GARAGES, LAUNDRY ROOMS, UTILITY ROOMS AND WALK—IN CLOSETS, AT LEAST ONE INSTALLED LUMINAIRE MUST BE CONTROLLED BY AN OCCUPANCY OR VACANCY SENSOR PROVIDING AUTOMATIC—OFF FUNCTIONALITY. LIGHTING INSIDE DRAWERS AND CABINETS WITH OPAQUE FRONTS OR DOORS MUST HAVE CONTROLS THAT TURN THE LIGHT OFF WHEN THE DRAWER OR DOOR IS CLOSED.

§ 150.0(K)2F: DIMMERS. LIGHTING IN HABITABLE SPACES (E.G., LIVING ROOMS, DINING ROOMS, KITCHENS, AND BEDROOMS)
MUST HAVE READILY ACCESSIBLE WALL—MOUNTED DIMMING CONTROLS THAT ALLOW THE LIGHTING TO BE MANUALLY ADJUSTED UP
AND DOWN. FORWARD PHASE CUT DIMMERS CONTROLLING LED LIGHT SOURCES IN THESE SPACES MUST COMPLY WITH NEMA SSL 7A.

§ 150.0(K)2K: INDEPENDENT CONTROLS. INTEGRATED LIGHTING OF EXHAUST FANS SHALL BE CONTROLLED INDEPENDENTLY FROM THE FANS. LIGHTING UNDER CABINETS OR SHELVES, LIGHTING IN DISPLAY CABINETS, AND SWITCHED OUTLETS MUST BE CONTROLLED SEPARATELY FROM CEILING—INSTALLED LIGHTING.

§ 150.0(K)3A: RESIDENTIAL OUTDOOR LIGHTING. FOR SINGLE—FAMILY RESIDENTIAL BUILDINGS, OUTDOOR LIGHTING PERMANENTLY MOUNTED TO A RESIDENTIAL BUILDING, OR TO OTHER BUILDINGS ON THE SAME LOT, MUST HAVE A MANUAL ON/OFF SWITCH AND EITHER A PHOTOCELL AND MOTION SENSOR OR AUTOMATIC TIME SWITCH CONTROL) OR AN ASTRONOMICAL TIME CLOCK. AN ENERGY MANAGEMENT CONTROL SYSTEM THAT PROVIDES THE SPECIFIED CONTROL FUNCTIONALITY AND MEETS ALL APPLICABLE REQUIREMENTS MAY BE USED TO MEET THESE REQUIREMENTS.

§ 150.0(K)4: INTERNALLY ILLUMINATED ADDRESS SIGNS. INTERNALLY ILLUMINATED ADDRESS SIGNS MUST EITHER COMPLY WITH § 140.8 OR CONSUME NO MORE THAN 5 WATTS OF POWER.

§ 150.0(K)5: RESIDENTIAL GARAGES FOR EIGHT OR MORE VEHICLES. LIGHTING FOR RESIDENTIAL PARKING GARAGES FOR EIGHT OR MORE VEHICLES MUST COMPLY WITH THE APPLICABLE REQUIREMENTS FOR NONRESIDENTIAL GARAGES IN §§ 110.9, 130.0, 130.1. 130.4. 140.6. AND 141.0.

# SOLAR READINESS:

110.10(A)1: SINGLE—FAMILY RESIDENCES. SINGLE—FAMILY RESIDENCES LOCATED IN SUBDIVISIONS WITH 10 OR MORE SINGLE—FAMILY RESIDENCES AND WHERE THE APPLICATION FOR A TENTATIVE SUBDIVISION MAP FOR THE RESIDENCES HAS BEEN DEEMED COMPLETE AND APPROVED BY THE ENFORCEMENT AGENCY, WHICH DO NOT HAVE A PHOTOVOLTAIC SYSTEM INSTALLED, MUST COMPLY WITH THE REQUIREMENTS OF § 110.10(B)—(E).

#### \$110.10(B)1A MINIMUM SOL

MINIMUM SOLAR ZONE AREA. THE SOLAR ZONE MUST HAVE A MINIMUM TOTAL AREA AS DESCRIBED BELOW. THE SOLAR ZONE MUST COMPLY WITH ACCESS, PATHWAY, SMOKE VENTILATION, AND SPACING REQUIREMENTS AS SPECIFIED IN TITLE 24, PART 9 OR OTHER PARTS OF TITLE 24 OR IN ANY REQUIREMENTS ADOPTED BY A LOCAL JURISDICTION. THE SOLAR ZONE TOTAL AREA MUST BE COMPRISED OF AREAS THAT HAVE NO DIMENSION LESS THAN 5 FEET AND ARE NO LESS THAN 80 SQUARE FEET EACH FOR BUILDINGS WITH ROOF AREAS LESS THAN OR EQUAL TO 10,000 SQUARE FEET OR NO LESS THAN 160 SQUARE FEET EACH FOR BUILDINGS WITH ROOF AREAS GREATER THAN 10,000 SQUARE FEET. FOR SINGLE—FAMILY RESIDENCES, THE SOLAR ZONE MUST BE LOCATED ON THE ROOF OR OVERHANG OF THE BUILDING AND HAVE A TOTAL AREA NO LESS THAN 250 SQUARE FEET. \*

§ 110.10(B)2: AZIMUTH. ALL SECTIONS OF THE SOLAR ZONE LOCATED ON STEEP-SLOPED ROOFS MUST HAVE AN AZIMUTH BETWEEN 90-300° OF TRUE NORTH.

§ 110.10(B)3A: SHADING. THE SOLAR ZONE MUST NOT CONTAIN ANY OBSTRUCTIONS, INCLUDING BUT NOT LIMITED TO: VENTS, CHIMNEYS, ARCHITECTURAL FEATURES, AND ROOF MOUNTED EQUIPMENT. \*

§ 110.10(B)3B: SHADING. ANY OBSTRUCTION LOCATED ON THE ROOF OR ANY OTHER PART OF THE BUILDING THAT PROJECTS ABOVE A SOLAR ZONE MUST BE LOCATED AT LEAST TWICE THE HORIZONTAL DISTANCE OF THE HEIGHT DIFFERENCE BETWEEN THE HIGHEST POINT OF THE OBSTRUCTION AND THE HORIZONTAL PROJECTION OF THE NEAREST POINT OF THE SOLAR ZONE, MEASURED IN THE VERTICAL PLANE. \*

§ 110.10(B)4: STRUCTURAL DESIGN LOADS ON CONSTRUCTION DOCUMENTS. FOR AREAS OF THE ROOF DESIGNATED AS A SOLAR ZONE, THE STRUCTURAL DESIGN LOADS FOR ROOF DEAD LOAD AND ROOF LIVE LOAD MUST BE CLEARLY INDICATED ON THE CONSTRUCTION DOCUMENTS.

§ 110.10(C): INTERCONNECTION PATHWAYS. THE CONSTRUCTION DOCUMENTS MUST INDICATE: A LOCATION RESERVED FOR INVERTERS AND METERING EQUIPMENT AND A PATHWAY RESERVED FOR ROUTING OF CONDUIT FROM THE SOLAR ZONE TO THE POINT OF INTERCONNECTION WITH THE ELECTRICAL SERVICE; AND FOR SINGLE—FAMILY RESIDENCES AND CENTRAL WATER—HEATING SYSTEMS. A PATHWAY RESERVED FOR ROUTING PLUMBING FROM THE SOLAR ZONE TO THE WATER—HEATING SYSTEM.

§ 110.10(D): DOCUMENTATION. A COPY OF THE CONSTRUCTION DOCUMENTS OR A COMPARABLE DOCUMENT INDICATING THE INFORMATION FROM § 110.10(B)—(C) MUST BE PROVIDED TO THE OCCUPANT.

§ 110.10(E)1: MAIN ELECTRICAL SERVICE PANEL. THE MAIN ELECTRICAL SERVICE PANEL MUST HAVE A MINIMUM BUSBAR RATING OF 200 AMPS.

§ 110.10(E)2: MAIN ELECTRICAL SERVICE PANEL. THE MAIN ELECTRICAL SERVICE PANEL MUST HAVE A RESERVED SPACE TO ALLOW FOR THE INSTALLATION OF A DOUBLE POLE CIRCUIT BREAKER FOR A FUTURE SOLAR ELECTRIC INSTALLATION. THE RESERVED SPACE MUST BE PERMANENTLY MARKED AS "FOR FUTURE SOLAR ELECTRIC."

§ 150.0(S) ENERGY STORAGE SYSTEM (ESS) READY. ALL SINGLE-FAMILY RESIDENCES MUST MEET ALL OF THE FOLLOWING: EITHER ESS-READY INTERCONNECTION EQUIPMENT WITH BACKED UP CAPACITY OF 60 AMPS OR MORE AND FOUR OR MORE ESS SUPPLIED BRANCH CIRCUITS, OR A DEDICATED RACEWAY FROM THE MAIN SERVICE TO A SUB-PANEL THAT SUPPLIES THE BRANCH CIRCUITS IN § 150.0(S); AT LEAST FOUR BRANCH CIRCUITS MUST BE IDENTIFIED AND HAVE THEIR SOURCE COLLOCATED AT A SINGLE PANEL-BOARD SUITABLE TO BE SUPPLIED BY THE ESS, WITH ONE CIRCUIT SUPPLYING THE REFRIGERATOR, ONE LIGHTING CIRCUIT NEAR THE PRIMARY EXIT, AND ONE CIRCUIT SUPPLYING A SLEEPING ROOM RECEPTACLE OUTLET; MAIN PANEL-BOARD MUST HAVE A MINIMUM BUSBAR RATING OF 225 AMPS; SUFFICIENT SPACE MUST BE RESERVED TO ALLOW FUTURE INSTALLATION OF A SYSTEM ISOLATION EQUIPMENT/TRANSFER SWITCH WITHIN 3' OF THE MAIN PANEL-BOARD, WITH RACEWAYS INSTALLED BETWEEN THE PANEL-BOARD AND THE SWITCH LOCATION TO ALLOW THE CONNECTION OF BACKUP POWER SOURCE.

§ 150.0(T) HEAT PUMP SPACE HEATER READY. SYSTEMS USING GAS OR PROPANE FURNACES TO SERVE INDIVIDUAL DWELLING UNITS MUST INCLUDE: A DEDICATED UNOBSTRUCTED 240V BRANCH CIRCUIT WIRING INSTALLED WITHIN 3' OF THE FURNACE WITH CIRCUIT CONDUCTORS RATED AT LEAST 30 AMPS WITH THE BLANK COVER IDENTIFIED AS "240V READY;" AND A RESERVED MAIN ELECTRICAL SERVICE PANEL SPACE TO ALLOW FOR THE INSTALLATION OF A DOUBLE POLE CIRCUIT BREAKER PERMANENTLY MARKED AS "FOR FUTURE 240V USE."

§ 150.0(U) ELECTRIC COOKTOP READY. SYSTEMS USING GAS OR PROPANE COOKTOP TO SERVE INDIVIDUAL DWELLING UNITS MUST INCLUDE: A DEDICATED UNOBSTRUCTED 240V BRANCH CIRCUIT WIRING INSTALLED WITHIN 3' OF THE COOKTOP WITH CIRCUIT CONDUCTORS RATED AT LEAST 50 AMPS WITH THE BLANK COVER IDENTIFIED AS "240V READY;" AND A RESERVED MAIN ELECTRICAL SERVICE PANEL SPACE TO ALLOW FOR THE INSTALLATION OF A DOUBLE POLE CIRCUIT BREAKER PERMANENTLY MARKED AS "FOR FUTURE 240V USE."


§ 150.0(V) ELECTRIC CLOTHES DRYER READY. CLOTHES DRYER LOCATIONS WITH GAS OR PROPANE PLUMBING TO SERVE INDIVIDUAL DWELLING UNITS MUST INCLUDE: A DEDICATED UNOBSTRUCTED 240V BRANCH CIRCUIT WIRING INSTALLED WITHIN 3' OF THE DRYER LOCATION WITH CIRCUIT CONDUCTORS RATED AT LEAST 30 AMPS WITH THE BLANK COVER IDENTIFIED AS "240V READY;" AND A RESERVED MAIN ELECTRICAL SERVICE PANEL SPACE TO ALLOW FOR THE INSTALLATION OF A DOUBLE POLE CIRCUIT BREAKER PERMANENTLY MARKED AS "FOR FUTURE 240V USE."

anura design

REVISIONS

<u>/1\</u> 06/27/2025

<u>2</u> 07/25/2025

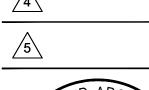



ROMAIN CURTIS
ARCHITECT #C35019
367 CIVIC DR #3,
PLEASANT HILL, CA94523
phone: 510.612.0345
roman@anuradesign.com

ADDITION / REMODE 301 FERNSIDE BLVD ALAMEDA, CA 94501

MANDATOR

CA008
CHECKED BY

05/07/2025

SCALE N/A

ANURA JOB NO CA2504-0002

| GN-3

RESIDENTIAL VOLUNTARY MEASURES

| RESIDENTIAL OCCUPANCIES APPLICA  | SECTION A4.60:<br>TION CHECKLIS |                         |                           |                     |  |             |  |  |
|--|---------------------------------|-------------------------|---------------------------|---------------------|--|-------------|--|--|
|  | APPLICANT TO S                  | LEVELS<br>ELECT ELECTIV | 'E MEASURES               | <b>ENFORCING</b>    | VERIFICATIONS<br>ENFORCING AGENCY TO SP<br>VERIFICATION METHOL |             |  |  |
| FEATURE OR MEASURE   |                                 | Prerequisites a         | nd electives <sup>1</sup> | Enforcing<br>Agency | Installer or<br>Designer                                       | Third party |  |  |
|  | Mandatory                       | Tier 1                  | Tier 2                    | □<br>All            | □<br>All   | □<br>All    |  |  |
| A4.106.1 Reserved  |                                 |                         |                           |                     |  |             |  |  |
| A4.106.2.1 Soil analysis is performed by a licensed design professional and the findings utilized in the structural design of the building.  |                                 |                         |                           |                     |  |             |  |  |
| A4.106.2.2 Soil disturbance and erosion are minimized by at least one of the following:  |                                 |                         |                           |                     |  |             |  |  |
| Natural drainage patterns are evaluated and erosion controls are<br>implemented to minimize erosion during construction and after<br>occupancy.  |                                 |                         |                           |                     |  |             |  |  |
| Site access is accomplished by minimizing the amount of cut and fill needed to install access roads and driveways.   |                                 |                         |                           |                     |  |             |  |  |
| Underground construction activities are coordinated to utilize the same trench, minimize the amount of time the disturbed soil is exposed and the soil is replaced using accepted compaction methods.                  |                                 | _                       |                           |                     |  |             |  |  |
| A4.106.2.3 Topsoil shall be protected or saved for reuse as specified in this section.   |                                 |                         |                           |                     |  |             |  |  |
| Tier 1. Displaced topsoil shall be stockpiled for reuse in a designated area and covered or protected from erosion.  |                                 |                         |                           |                     |  |             |  |  |
| Tier 2. The construction area shall be identified and delineated by fencing or flagging to limit construction activity to the construction area.   |                                 |                         |                           |                     |  |             |  |  |
| A4.106.3 Postconstruction landscape designs accomplish one or more of the following:   |                                 |                         |                           |                     |  |             |  |  |
| Areas disrupted during construction are restored to be consistent with native vegetation species and patterns.   |                                 |                         |                           |                     |  |             |  |  |
| Utilize at least 75 percent native California or drought tolerant plant and tree species appropriate for the climate zone region.  |                                 |                         |                           |                     |  |             |  |  |
| A4.106.4 Permeable paving is utilized for the parking, walking or patio surfaces in compliance with the following:   |                                 |                         |                           |                     |  |             |  |  |
| Tier 1. Not less than 20 percent of the total parking, walking or patio surfaces shall be permeable.   |                                 |                         |                           |                     |  |             |  |  |
| Tier 2. Not less than 30 percent of the total parking, walking or patio surfaces shall be permeable.   |                                 |                         |                           |                     |  |             |  |  |
| A4.106.5 Roofing materials shall have a minimum 3-year aged solar reflectance and thermal emittance or a minimum Solar Reflectance Index (SRI) equal to or greater than the values specified in the applicable tables. |                                 |                         |                           |                     |  |             |  |  |
| Low-rise Residential   |                                 |                         |                           |                     |  |             |  |  |
| Tier 1 roof covering shall meet or exceed the values contained in Table A4.106.5.1(1).   |                                 |                         |                           |                     |  |             |  |  |
| Tier 2 roof covering shall meet or exceed the values contained in Table A4.106.5.1(2).   |                                 |                         |                           |                     |  |             |  |  |
| High-rise Residential, Hotels and Motels   |                                 |                         |                           |                     |  |             |  |  |
| Tier 1 roof covering shall meet or exceed the values contained in Table A4.106.5.1(3).   |                                 |                         |                           |                     |  |             |  |  |
| Tier 2 roof covering shall meet or exceed the values contained in Table A4.106.5.1(4).   |                                 |                         |                           |                     |  |             |  |  |

2022 CALIFORNIA GREEN BUILDING STANDARDS CODE RESIDENTIAL VOLUNTARY MEASURES

A4.103.1 A site which complies with at least one of the following

A4.103.2 Facilitate community connectivity by one of the following Locate project within a 1/4-mile true walking distance of at least 4 2. Locate project within 1/2-mile true walking distance of at least 7 basic services;

3. Other methods increasing access to additional resources.

A4.104.1 An individual with oversight responsibility for the project has participated in an educational program promoting environmentally friendly design or development and has provided training or instruction to appropriate entities.

4.106.2 A plan is developed and implemented to manage storm water drainage during construction.

4.106.3 Construction plans shall indicate how site grading or a drainage system will manage all surface water flows to keep water from entering buildings.

4.106.4.1 Provide capability for electric vehicle charging in one- and hwo-family dwellings: townhouses with attached private garages;

4.106.4.1 Provide capability for electric vehicle charging in one- and two-family dwellings; townhouses with attached private garages; in accordance with Section 4.106.4.1,

4.106.4.2 Provide capability for electric vehicle charging for multifamily dwellings and hotels/motels in accordance with Section 4.106.4.2.1 or 4.106.4.2 as applicable.

4.106.4.3 Provide capability for electric vehicle charging for existing parking lots or new parking lots for existing residential buildings in accordance with section 4.106.4.3 as applicable.

Deconstruction and Reuse of Existing Materials

following materials which can be easily reused:

1. Light fixtures
2. Plumbing fixtures
3. Doors and trim

characteristics is selected: 2. A greyfield site is selected.

Site Preservation

Masonry
 Electrical devices

SECTION A4.602

| RESIDENTIAL OCCUPANCIES APPLIC   | CATION CHECKLIS  | ST—continued    |                            |                     |                          |             |
|--|--|-----------------|----------------------------|---------------------|--------------------------|-------------|
|  | LEVELS APPLICANT TO SELECT ELECTIVE MEASURES ENFORCING AGENCY VERIFICATION MET |                 |                            |                     |                          | SPECIFY     |
| FEATURE OR MEASURE   |  | Prerequisites a | and electives <sup>1</sup> | Enforcing<br>Agency | Installer or<br>Designer | Third party |
|  | Mandatory  | Tier 1          | Tier 2                     | □<br>All            | □<br>All                 | □<br>All    |
| WATER REUSE SYSTEMS  |  |                 | •                          |                     |                          |             |
| A4.305.1 Piping is installed to permit future use of a graywater irrigation system served by the clothes washer or other fixtures. |  |                 |                            |                     |                          |             |
| A4.305.2 Recycled water piping is installed.   |  |                 |                            |                     |                          |             |
| A4.305.3 Recycled water is used for landscape irrigation.  |  |                 |                            |                     |                          |             |
| Innovative Concepts and Local Environmental Conditions   |  |                 | •                          |                     |                          |             |
| A4.306.1 Items in this section are necessary to address innovative concepts or local environmental conditions.                     |  |                 |                            |                     |                          |             |
| Item 1   |  |                 |                            |                     |                          |             |
| Item 2   |  |                 |                            |                     |                          |             |
| Item 3   |  |                 |                            |                     |                          |             |
| MATERIAL CONSERVATION AND RESOURCE EFFICIENCY  |  |                 |                            |                     |                          |             |
| Foundation Systems   |  |                 |                            |                     |                          |             |
| A4.403.1 A Frost-protected Shallow Foundation (FPSF) is designed and constructed.  |  |                 |                            |                     |                          |             |
| A4.403.2 Cement use in foundation mix design is reduced.   |  |                 |                            |                     |                          |             |
| Tier 1. Not less than a 20 percent reduction in cement use.  |  |                 |                            |                     |                          |             |
| Tier 2. Not less than a 25 percent reduction in cement use.  |  |                 |                            |                     |                          |             |
| Efficient Framing Techniques   |  |                 |                            |                     |                          |             |
| A4.404.1 Beams and headers and trimmers are the minimum size to adequately support the load.                                       |  |                 |                            |                     |                          |             |
| A4.404.2 Building dimensions and layouts are designed to minimize waste.   |  |                 |                            |                     |                          |             |
| A4.404.3 Use premanufactured building systems to eliminate solid sawn lumber whenever possible.                                    |  |                 |                            |                     |                          |             |
| A4.404.4 Material lists are included in the plans which specify material quantity and provide direction for on-site cuts.          |  |                 |                            |                     |                          |             |

2022 CALIFORNIA GREEN BUILDING STANDARDS CODE

2022 CALIFORNIA GREEN BUILDING STANDARDS CODE

RESIDENTIAL VOLUNTARY MEASURES

SECTION A4.602
RESIDENTIAL OCCUPANCIES APPLICATION CHECKLIST—continued

| NESIDENTIAL OCCUPANCIES AFFEICA   | THO TO OT LONG | i continued              |                            |                          |                          |             |  |  |
|---|----------------|--------------------------|----------------------------|--------------------------|--------------------------|-------------|--|--|
|   | APPLICANT TO S | LEVELS<br>SELECT ELECTIV | /E MEASURES                | VE<br>ENFORCING<br>VERIF | SPECIFY                  |             |  |  |
| FEATURE OR MEASURE  |                | Prerequisites a          | and electives <sup>1</sup> | Enforcing<br>Agency      | Installer or<br>Designer | Third party |  |  |
|   | Mandatory      | Tier 1                   | Tier 2                     | □<br>All                 | □<br>All                 | □<br>All    |  |  |
| Material Sources  |                |                          |                            |                          |                          |             |  |  |
| A4.405.1 One or more of the following building materials, that do not require additional resources for finishing are used:  |                |                          |                            |                          |                          |             |  |  |
| 1. Exterior trim not requiring paint or stain   |                |                          |                            |                          |                          |             |  |  |
| 2. Windows not requiring paint or stain   |                |                          |                            |                          | _                        |             |  |  |
| 3. Siding or exterior wall coverings which do not require paint or stain  |                |                          |                            |                          |                          |             |  |  |
| A4.405.2 Floors that do not require additional coverings are used including but not limited to stained, natural or stamped concrete floors.   |                |                          |                            |                          | 0                        |             |  |  |
| A4.405.3 Postconsumer or preconsumer recycled content value (RCV) materials are used on the project.  |                |                          |                            |                          |                          |             |  |  |
| Tier 1. Not less than a 10-percent recycled content value.  |                |                          |                            |                          |                          |             |  |  |
| Tier 2. Not less than a 15-percent recycled content value.  |                |                          |                            |                          |                          |             |  |  |
| A4.405.4 Renewable source building products are used.   |                |                          |                            |                          |                          |             |  |  |
| Enhanced Durability and Reduced Maintenance   |                |                          |                            |                          |                          |             |  |  |
| 4.406.1 Annular spaces around pipes, electric cables, conduits or<br>other openings in plates at exterior walls shall be protected against<br>the passage of rodents by closing such openings with cement mortar,<br>concrete masonry or similar method acceptable to the enforcing agency. | X              |                          |                            | _                        | _                        |             |  |  |
| Water Resistance and Moisture Management  |                |                          |                            |                          |                          |             |  |  |
| A4.407.1 Install foundation and landscape drains.   |                |                          |                            |                          |                          |             |  |  |
| A4.407.2 Install gutter and downspout systems to route water at least<br>5 feet away from the foundation or connect to landscape drains which<br>discharge to a dry well, sump, bioswale, rainwater capture system or<br>other approved on-site location.                                   |                |                          |                            |                          | _                        |             |  |  |
| A4.407.3 Provide flashing details on the building plans and comply with accepted industry standards or manufacturer's instructions.   |                |                          |                            |                          |                          |             |  |  |
| A4.407.4 Protect building materials delivered to the construction site from rain and other sources of moisture.   |                |                          |                            |                          |                          |             |  |  |
| A4.407.5 In Climate Zone 16 an ice/water barrier is installed at roof valleys, eaves and wall to roof intersections.  |                |                          |                            |                          |                          |             |  |  |
| A4.407.6 Exterior doors to the dwelling are protected to prevent water intrusion.   |                |                          |                            |                          |                          |             |  |  |
| A4.407.7 A permanent overhang or awning at least 2 feet in depth is provided.   |                |                          |                            |                          |                          |             |  |  |
|   |                |                          |                            | •                        |                          |             |  |  |

2022 CALIFORNIA GREEN BUILDING STANDARDS CODE

RESIDENTIAL VOLUNTARY MEASURES

SECTION A4.602
RESIDENTIAL OCCUPANCIES APPLICATION CHECKLIST—continued

|   | APPLICANT TO S | LEVELS<br>ELECT ELECTIV | E MEASURES                | ENFORCING           | ERIFICATIONS<br>AGENCY TO<br>ICATION MET | SPECIFY     |
|---|----------------|-------------------------|---------------------------|---------------------|--|-------------|
| FEATURE OR MEASURE  |                | Prerequisites a         | nd electives <sup>1</sup> | Enforcing<br>Agency | Installer or<br>Designer                 | Third party |
|   | Mandatory      | Tier 1                  | Tier 2                    | □<br>All            | □<br>All                                 | □<br>All    |
| A4.106.6 Install a vegetated roof for at least 50 percent of the roof area. Vegetated roofs shall comply with requirements for roof gardens and landscaped roofs in the California Building Code, Chapters 15 and 16.   |                | 0                       |                           |                     |  |             |
| A4.106.7 Reduce nonroof heat islands for 50 percent of sidewalks, patios, driveways or other paved areas by using one or more of the methods listed.  |                |                         |                           |                     |  |             |
| A4.106.8.1 Tier 1 and Tier 2 for one- and two-family dwellings and townhouses with attached private garages.  Install a dedicated 208/240-volt branch circuit, including an overcurrent protective device rated at 40 amperes minimum per dwelling unit.  |                |                         |                           |                     |  |             |
| A4.106.8.2 Provide capability for future electric vehicle charging in new multifamily dwellings, hotels and motels, as specified.   |                |                         |                           |                     |  |             |
| Tier 1. 35 percent of the total number of parking spaces shall be electric vehicle (EV ready) with low power Level 2 EV charging receptacles. For projects with 20 or more dwelling units, sleeping units or guest rooms, 10 percent of the total number of parking spaces shall be equipped with Level 2 EVSE. |                | _                       |                           |                     |  |             |
| Tier 2. 40 percent of the total number of parking spaces shall be electric vehicle (EV ready) with low power Level 2 EV charging receptacles. For projects with 20 or more dwelling units, sleeping units or guest rooms, 15 percent of the total number of parking spaces shall be equipped with Level 2 EVSE  |                |                         |                           | _                   |  |             |
| 4.106.9 Provide bicycle parking facilities as noted below or meet a local ordinance, whichever is more stringent. Number of bicycle parking spaces may be reduced, as approved by the enforcing agency, due to building site characteristics, including but not limited to, isolation from other development.   |                |                         |                           |                     |  |             |
| 1. Provide short-term bicycle parking, per Section A4.106.9.1.  |                |                         |                           |                     |  |             |
| Provide long-term bicycle parking for multifamly buildings, per<br>Section A4.106.9.2.  |                |                         |                           |                     |  |             |
| Provide long-term bicycle parking for hotel and motel buildings,<br>per Section A4.106.9.3.   |                |                         |                           |                     |  |             |

2022 CALIFORNIA GREEN BUILDING STANDARDS CODE

RESIDENTIAL VOLUNTARY MEASURES

SECTION A4 602

| RESIDENTIAL OCCUPANCIES APP   | SECTION A4.60<br>LICATION CHEC |  | nued        |                     |   |             |
|---|--------------------------------|--|-------------|---------------------|---|-------------|
|   | APPLICANT TO S                 | LEVELS<br>SELECT ELECTIV                 | VE MEASURES | ENFORCING           | ERIFICATIONS<br>G AGENCY TO<br>TICATION MET | SPECIFY     |
| FEATURE OR MEASURE  |                                | Prerequisites and electives <sup>1</sup> |             | Enforcing<br>Agency | Installer or<br>Designer                    | Third party |
|   | Mandatory                      | Tier 1                                   | Tier 2      | □<br>All            | □<br>All                                    | □<br>All    |
| Construction Waste Reduction, Disposal and Recycling  |                                |  |             |                     |   |             |
| 4.408.1 Recycle and/or salvage for reuse a minimum of 65 percent of<br>the nonhazardous construction and demolition waste in accordance<br>with one of the following:   | X                              |  |             |                     |   |             |
| Comply with a more stringent local construction and demolition waste management ordinance; or   |                                |  |             |                     |   |             |
| 2. A construction waste management plan, per Section 4.408.2; or  |                                |  |             |                     |   |             |
| 3. A waste management company, per Section 4.408.3; or  |                                |  |             |                     |   |             |
| 4. The waste stream reduction alternative, per Section 4.408.4.   |                                |  |             |                     |   |             |
| A4.408.1 Construction waste generated at the site is diverted to recycle or salvage in compliance with one of the following:  |                                |  |             |                     |   |             |
| 1. Tier 1 at least a 65 percent reduction with a third-party verification.  |                                |  |             |                     |   |             |
| 2. Tier 2 at least a 75 percent reduction with a third-party verification.  |                                |  |             |                     |   |             |
| Exception: Equivalent waste reduction methods are developed by working with local agencies.   |                                |  |             |                     |   |             |
| Building Maintenance and Operation  |                                |  |             |                     |   |             |
| 4.410.1 An operation and maintenance manual shall be provided to the building occupant or owner.  | ×                              |  |             |                     |   |             |
| 4.410.2 Where 5 or more multifamily dwelling units are constructed on<br>a building site, provide readily accessible areas that serve the entire<br>building and are identified for the depositing, storage and collection of<br>non-hazardous materials for recycling, including (at a minimum) paper,<br>corrugated cardboard, glass, plastics, organic waste, and metals or<br>meet a lawfully enacted local recycling ordinance, if more restrictive. | X                              |  |             |                     |   |             |
| Exception: Rural jurisdictions that meet and apply for the exemption in Public Resources Code Section 42649.82 (a)(2)(A) et seq. will also be exempt from the organic waste portion of this section   |                                |  |             |                     |   |             |
| Innovative Concepts and Local Environmental Conditions  |                                | •  | •           |                     |   |             |
| A4.411.1 Items in this section are necessary to address innovative concepts or local environmental conditions.  |                                |  |             |                     |   |             |
| Item 1  |                                |  |             |                     |   |             |
| Item 2  |                                |  |             |                     |   |             |
| Item 3  |                                |  |             |                     |   |             |
| ENVIRONMENTAL QUALITY   |                                |  |             |                     |   |             |
| Fireplaces  |                                |  |             |                     |   |             |
| 4.503.1 Any installed gas fireplace shall be a direct-vent sealed-combustion type. Any installed woodstove or pellet stove shall comply with U.S. EPA New Source Performance Standards (NSPS) emission limits as applicable, and shall have a permanent label indicating they are certified to meet the emission limits. Woodstoves, pellet stoves and fireplaces shall also comply with applicable local ordinances.                                     | ×                              |  |             |                     |   |             |
| Pollutant Control   |                                | •  | •           | •                   | •   |             |
| 4.504.1 Duct openings and other related air distribution component openings shall be covered during construction.   | ×                              |  |             |                     |   |             |
| 4.504.2.1 Adhesives, sealants and caulks shall be compliant with VOC and other toxic compound limits.   | ×                              |  |             |                     |   |             |
| 4.504.2.2 Paints, stains and other coatings shall be compliant with VOC limits  | ×                              |  |             |                     |   |             |

2022 CALIFORNIA GREEN BUILDING STANDARDS CODE

RESIDENTIAL VOLUNTARY MEASURES

SECTION A4.602

| RESIDENTIAL OCCUPANCIES APPLICATION   | FION CHECKLIS  |                          |                           |                     |                          |             |
|---|----------------|--------------------------|---------------------------|---------------------|--------------------------|-------------|
|   | APPLICANT TO S | LEVELS<br>SELECT ELECTIV | VERIFICATION N            |                     |                          | SPECIFY     |
| FEATURE OR MEASURE  |                | Prerequisites a          | nd electives <sup>1</sup> | Enforcing<br>Agency | Installer or<br>Designer | Third party |
|   | Mandatory      | Tier 1                   | Tier 2                    | □<br>All            | □<br>All                 | □<br>All    |
| Innovative Concepts and Local Environmental Conditions  |                |                          |                           |                     |                          |             |
| A4.108.1 Items in this section are necessary to address innovative concepts or local environmental conditions.  |                |                          |                           |                     |                          |             |
| Item 1  |                |                          |                           |                     |                          |             |
| Item 2  |                |                          |                           |                     |                          |             |
| Item 3  |                |                          |                           |                     |                          |             |
| ENERGY EFFICIENCY   |                |                          |                           |                     |                          |             |
| General   |                |                          |                           |                     |                          |             |
| 4.201.1 Building meets or exceeds the requirements of the California Building Energy Efficiency Standards3  | X              |                          |                           |                     |                          |             |
| Performance Approach for Newly Constructed Buildings  |                |                          |                           |                     |                          |             |
| A4.203.1.1 Hourly Source Energy Rating (EDR1).  EDR1 ratings for building design shall be computed by Energy Compliant software and shall reduce the EDR1 required by the software by the compliance margins specified in Table A4 203.1.1.   |                |                          |                           | 0                   | _                        |             |
| A4.203.1.2 Prerequisite options. In addition, a minimum of two of the efficiency measures specified in Sections A4 203. 1.2.1 through A4 203.1.2.8 will be required to be met.  |                |                          |                           |                     |                          |             |
| - Roof deck insulation or ducts in conditioned space.   |                |                          |                           |                     |                          |             |
| - High-performance walls.   |                |                          |                           |                     |                          |             |
| - Compact Hot Water Distribution System   |                |                          |                           |                     |                          |             |
| - Drain water Heat Recovery   | 1              | _                        | _                         |                     | "                        | _           |
| - High Performance Vertical Fenestration  |                |                          |                           |                     |                          |             |
| - Heat Pump Water Heater Demand Management  | 1              |                          |                           |                     |                          |             |
| - Battery Storage System Controls   | ]              |                          |                           |                     |                          |             |
| - Heat Pump Space and Water Heating   |                |                          |                           |                     |                          |             |
| A4.203.1.3 Consultation with local electric service provider.  Local jurisdictions considering adoption of reduced DR targets based on using solar photovoltaic (PV) systems larger than required by the California Energy Code shall consult with the local electric service provider to ensure that PV system sizing required to comply with the EDR targets will be acceptable to the local electric service provider. |                |                          | _                         | 0                   |                          |             |

2022 CALIFORNIA GREEN BUILDING STANDARDS CODE

RESIDENTIAL VOLUNTARY MEASURES

|   | APPLICANT TO S | LEVELS<br>SELECT ELECTI | VE MEASURES                | ENFORCING           | VERIFICATIONS<br>ENFORCING AGENCY TO SP<br>VERIFICATION METHOD |             |  |
|---|----------------|-------------------------|----------------------------|---------------------|--|-------------|--|
| FEATURE OR MEASURE  |                | Prerequisites           | and electives <sup>1</sup> | Enforcing<br>Agency | Installer or<br>Designer                                       | Third party |  |
|   | Mandatory      | Tier 1                  | Tier 2                     | □<br>All            | □<br>All   | □<br>All    |  |
| 4.504.3 Carpet and carpet systems shall be compliant with VOC limits.   | ×              |                         |                            |                     |  |             |  |
| 4.504.4 80 percent of floor area receiving resilient flooring shall comply with specified VOC criteria.   | ×              |                         |                            |                     |  |             |  |
| 4.504.5 Particleboard, medium density fiberboard (MDF) and<br>hardwood plywood used in interior finish systems shall comply with<br>low formaldehyde emission standards.                        | ×              |                         |                            | _                   |  |             |  |
| A4.504.1 Use composite wood products made with either California<br>Air Resources Board approved no-added formaldehyde (NAF) resins<br>or ultra-low emitting formaldehyde (ULEF) resins.        |                |                         |                            |                     |  |             |  |
| A4.504.2 Install VOC compliant resilient flooring systems.  |                |                         |                            |                     |  |             |  |
| Tier 1. At least 90 percent of the resilient flooring installed shall comply.   |                |                         |                            |                     |  |             |  |
| Tier 2. At least 100 percent of the resilient flooring installed shall comply.  |                |                         |                            |                     |  |             |  |
| A4.504.3 Thermal insulation installed in the building shall meet the following requirements:  |                |                         |                            |                     |  |             |  |
| Tier 1. Install thermal insulation in compliance with VOC limits.   |                |                         |                            |                     |  |             |  |
| Tier 2. Install insulation which contains No-Added Formaldehyde (NAF) and is in compliance with Tier 1.   |                |                         |                            |                     |  |             |  |
| Interior Moisture Control   |                |                         |                            |                     |  |             |  |
| 4.505.2 Vapor retarder and capillary break is installed at slab-on-<br>grade foundations.   | ×              |                         |                            |                     |  |             |  |
| 4.505.3 Moisture content of building materials used in wall and floor framing is checked before enclosure.  | ×              |                         |                            |                     |  |             |  |
| Indoor Air Quality and Exhaust  |                |                         |                            |                     |  |             |  |
| 4.506.1 Each bathroom shall be provided with the following:   |                |                         |                            |                     |  |             |  |
| ENERGY STAR fans ducted to terminate outside the building.  |                |                         |                            |                     |  |             |  |
| Fans must be controlled by a humidity control (separate or built-in); OR functioning as a component of a whole-house ventilation system.  | ×              |                         |                            | _                   |  |             |  |
| <ol> <li>Humidity controls with manual or automatic means of adjustment,<br/>capable of adjustment between a relative humidity range of ≤ 50 percent<br/>to a maximum of 80 percent.</li> </ol> | X              |                         |                            |                     |  |             |  |
| A4.506.1 Reserved.  |                |                         |                            |                     |  |             |  |
| A4.506.2 [HR] Provide filters on return air openings rated MERV 6<br>or higher during construction when it is necessary to use HVAC<br>equipment.   |                | 0                       |                            |                     | 0  |             |  |
| A4.506.3 Direct-vent appliances shall be used when equipment is<br>ocated in conditioned space; or the equipment must be installed in an<br>solated mechanical room.                            |                |                         |                            |                     |  |             |  |

2022 CALIFORNIA GREEN BUILDING STANDARDS CODE

RESIDENTIAL VOLUNTARY MEASURES

SECTION A4.602
RESIDENTIAL OCCUPANCIES APPLICATION CHECKLIST—continued

| RESIDENTIAL OCCUPANO  | IES APPLICATION | ON CHECKLIS              | T—continued                |  |                          |            |  |
|---|-----------------|--------------------------|----------------------------|--|--------------------------|------------|--|
| WATER EFFICIENCY AND CONSERVATION Indoor Water Use  303.1 Plumbing fixtures (water closets and urinals) and fittings showerheads, faucets and pre-rinse spray valves) installed in sesidential buildings shall comply with the prescriptive requirements of Sections 4.303.1.1 through 4.303.1.4.5.  303.2 Submeters for multifamily building and dwelling units in mixed-us essidential/commercial buildings. Submeters shall be installed to neasure water usage of individual rental dwelling units in accordance with the California Plumbing Code.  303.3 Plumbing fixtures and fittings required in Section 4.303.1 shall e installed in accordance with the California Plumbing Code, and shaneet the applicable referenced standards.  4.303.1 The maximum flow rate of kitchen faucets shall not exceed .5 gallons per minute at 60 psi. Kitchen faucets may temporarily norcease the flow above the maximum rate, but not to exceed 2.2 pallons per minute at 60 psi, and must default to a maximum flow rate of 1.5 gallons per minute at 60 psi.  4.303.1 Where complying faucets are unavailable, aerators or other means may be used to achieve reduction.  4.303.1 A.3 Metering faucets in residential buildings shall not deliver more than 0.2 gallons per cycle.  4.303.2 Alternate water sources shall be installed in accordance with the California Plumbing Code.  4.303.3 Install at least one qualified ENERGY STAR dishwasher or clothes washer.  4.303.4 Nonwater urinals or waterless toilets are installed.  4.303.5 One- and two-family dwellings shall be equipped with a lemand hot water recirculation system.  5.4.303.4 Nonwater urinals or waterless toilets are installed.  4.303.5 One- and two-family dwellings shall be equipped with a lemand hot water recirculation system.  5.4.303.4 Nonwater urinals or waterless toilets are installed.  4.303.5 One- and two-family dwellings shall be equipped with a lemand hot water recirculation system.  5.4.304.1 A rainwater capture, storage and re-use system is designed and installed. | APPLICANT TO    | LEVELS<br>SELECT ELECTIV | VE MEASURES                | VERIFICATIONS<br>ENFORCING AGENCY TO SPEC<br>VERIFICATION METHOD |                          |            |  |
| FEATURE OR MEASURE  |                 | Prerequisites a          | and electives <sup>1</sup> | Enforcing<br>Agency  | Installer or<br>Designer | Thi<br>par |  |
|   | Mandatory       | Tier 1                   | Tier 2                     | □<br>All   | □<br>All                 | Al         |  |
| WATER EFFICIENCY AND CONSERVATION   |                 |                          | -                          |  |                          |            |  |
| Indoor Water Use  |                 |                          |                            |  |                          |            |  |
| 4.303.1 Plumbing fixtures (water closets and urinals) and fittings (showerheads, faucets and pre-rinse spray valves) installed in residential buildings shall comply with the prescriptive requirements of Sections 4.303.1.1 through 4.303.1.4.5.  | ⊠               |                          |                            |  |                          |            |  |
| 4.303.2 Submeters for multifamily building and dwelling units in mixed-use<br>residential/commercial buildings. Submeters shall be installed to<br>measure water usage of individual rental dwelling units in accordance<br>with the California Plumbing Code.  | X               |                          |                            |  |                          | _          |  |
| 4.303.3 Plumbing fixtures and fittings required in Section 4.303.1 shall<br>be installed in accordance with the California Plumbing Code, and shall<br>meet the applicable referenced standards.  | ×               |                          |                            |  |                          |            |  |
| A4.303.1 The maximum flow rate of kitchen faucets shall not exceed 1.5 gallons per minute at 60 psi. Kitchen faucets may temporarily increase the flow above the maximum rate, but not to exceed 2.2 gallons per minute at 60 psi, and must default to a maximum flow rate of 1.5 gallons per minute at 60 psi.  Note: Where complying faucets are unavailable, aerators or other means may be used to achieve reduction.   |                 |                          |                            | 0  |                          |            |  |
| 4.303.1.4.3 Metering faucets in residential buildings shall not deliver more than 0.2 gallons per cycle.  | ×               |                          |                            | _  |                          |            |  |
| A4.303.2 Alternate water source for nonpotable applications. Alternate nonpotable water sources are used for indoor potable water reduction. Alternate nonpotable water sources shall be installed in accordance with the California Plumbing Code.   |                 |                          |                            |  | 0                        |            |  |
| A4.303.3 Install at least one qualified ENERGY STAR dishwasher or clothes washer.   |                 |                          |                            |  |                          |            |  |
| A4.303.4 Nonwater urinals or waterless toilets are installed.   |                 |                          |                            |  |                          |            |  |
| demand hot water recirculation system.  |                 |                          |                            |  |                          |            |  |
| Outdoor Water Use   |                 |                          | _                          |  |                          |            |  |
| 4.304.1 Residential developments shall comply with a local water efficient landscape ordinance or the current California Department of Water Resources' Model Water Efficient Landscape Ordinance (MWELO), whichever is more stringent.   | ×               |                          |                            |  |                          |            |  |
| A4.304.1 A rainwater capture, storage and re-use system is designed and installed.  |                 |                          |                            |  |                          |            |  |
| A4.304.2 A landscape design is installed, which does not utilize potable water.   |                 |                          |                            |  |                          |            |  |
| A4.304.3 For new water service connections, landscaped irrigated areas less than 5,000 square feet shall be provided with separate submeters or metering devices for outdoor potable water use.   |                 |                          | _                          |  |                          |            |  |

2022 CALIFORNIA GREEN BUILDING STANDARDS CODE

RESIDENTIAL VOLUNTARY MEASURES

2022 CALGREEN RESIDENTIAL VOLUNTARY MEASURES

SECTION A4.602
RESIDENTIAL OCCUPANCIES APPLICATION CHECKLIST—continued

|   | APPLICANT TO S | LEVELS<br>ELECT ELECTIV | /E MEASURES                | VERIFICATION METHOD |           |             |  |
|---|----------------|-------------------------|----------------------------|---------------------|-----------|-------------|--|
| FEATURE OR MEASURE  |                | Prerequisites a         | ind electives <sup>1</sup> | Enforcing<br>Agency | AGENCY TO | Third party |  |
|   | Mandatory      | Tier 1                  | Tier 2                     | □<br>All            |           | □<br>All    |  |
| Environmental Comfort   |                |                         |                            |                     |           |             |  |
| 4.507.2 Duct systems are sized, designed, and equipment is selected using the following methods:  |                |                         |                            |                     |           |             |  |
| Establish heat loss and heat gain values according to ANSI/ACCA 2     Manual J-2016 or equivalent.  | IXI            |                         |                            |                     |           |             |  |
| Size duct systems according to ANSI/ACCA 1 Manual D-2016 or equivalent.   |                |                         |                            |                     |           |             |  |
| Select heating and cooling equipment according to ANSI/ACCA 3     Manual S-2014 or equivalent.  |                |                         |                            |                     |           |             |  |
| Outdoor Air Quality Reserved  |                | -                       |                            |                     | -         |             |  |
| Innovative Concepts and Local Environmental Conditions  | 7              |                         |                            |                     |           |             |  |
| A4.509.1 Items in this section are necessary to address innovative concepts or local environmental conditions.  |                |                         |                            |                     |           |             |  |
| Item 1  |                |                         |                            |                     | _         |             |  |
| Item 2  |                |                         |                            |                     |           |             |  |
| Item 3  |                |                         |                            |                     |           |             |  |
| Installer and Special Inspector Qualifications  |                |                         |                            |                     |           |             |  |
| Qualifications  |                |                         |                            |                     |           |             |  |
| 702.1 HVAC system installers are trained and certified in the proper installation of HVAC systems.  | ×              |                         |                            |                     |           |             |  |
| 702.2 Special inspectors employed by the enforcing agency must be qualified and able to demonstrate competence in the discipline they are inspecting.   | X              |                         |                            |                     |           |             |  |
| Verifications   |                |                         |                            |                     |           |             |  |
| 703.1 Verification of compliance with this code may include construction documents, plans, specifications builder or installer certification, inspection reports, or other methods acceptable to the enforcing agency which show substantial conformance. | X              |                         |                            | 0                   |           |             |  |

1. Green building measures listed in this table may be mandatory if adopted by a city, county, or city and county as specified in Section 101.7. Required prerequisite for this Tier.
 These measures are currently required elsewhere in statute or in regulation.

2022 CALIFORNIA GREEN BUILDING STANDARDS CODE

ROMAIN CURTIS ARCHITECT #C35019 367 CIVIC DR #3, PLEASANT HILL, CA94523 phone: 510.612.0345 roman@anuradesign.com

**REVISIONS** 

<u></u> 06/27/2025

<u>2</u> 07/25/2025

CA008

ISSUE DATE

# Construction Best Management Practices (BMPs)

Construction projects are required to implement the stormwater best management practices (BMP) on this page, as they apply to your project, all year long.

# Materials & Waste Management

# **Non-Hazardous Materials**

- Berm and cover stockpiles of sand, dirt or other construction material with tarps when rain is forecast or if not actively being used within 14 days.
- ☐ Use (but don't overuse) reclaimed water for dust control.

### **Hazardous Materials**

- ☐ Label all hazardous materials and hazardous wastes (such as pesticides, paints, thinners, solvents, fuel, oil, and antifreeze) in accordance with city, county, state and federal regulations.
- Store hazardous materials and wastes in water tight containers, store in appropriate secondary containment, and cover them at the end of every work day or during wet weather or when rain is forecast.
- ☐ Follow manufacturer's application instructions for hazardous materials and be careful not to use more than necessary. Do not apply chemicals outdoors when rain is forecast within 24 hours.
- ☐ Arrange for appropriate disposal of all hazardous wastes.

# Waste Management

- Cover waste disposal containers securely with tarps at the end of every work day and during wet weather.
- Check waste disposal containers frequently for leaks and to make sure they are not overfilled. Never hose down a dumpster on the construction site.
- Clean or replace portable toilets, and inspect them frequently for leaks and spills.
- Dispose of all wastes and debris properly. Recycle materials and wastes that can be recycled (such as asphalt, concrete, aggregate base materials, wood, gyp board, pipe, etc.)
- Dispose of liquid residues from paints, thinners, solvents, glues, and cleaning fl uids as hazardous waste.

# **Construction Entrances and Perimeter**

- Establish and maintain effective perimeter controls and stabilize all construction entrances and exits to suffi ciently control erosion and sediment discharges from site and tracking off site.
- Sweep or vacuum any street tracking immediately and secure sediment source to prevent further tracking. Never hose down streets to clean up tracking.

# **Equipment Management & Spill Control**

#### **Maintenance and Parking**

- Designate an area, fi tted with appropriate BMPs, for vehicle and equipment parking and storage.
- Perform major maintenance, repair jobs, and vehicle and equipment washing off site.
- ☐ If refueling or vehicle maintenance must be done onsite, work in a bermed area away from storm drains and over a drip pan or drop cloths big enough to collect fl uids. Recycle or dispose of fl uids as hazardous waste.
- ☐ If vehicle or equipment cleaning must be done onsite, clean with water only in a bermed area that will not allow rinse water to run into gutters, streets, storm drains, or surface waters.
- ☐ Do not clean vehicle or equipment onsite using soaps, solvents, degreasers, or steam cleaning equipment.

# **Spill Prevention and Control**

- Keep spill cleanup materials (e.g., rags, absorbents and cat litter) available at the construction site at all times.
- Inspect vehicles and equipment frequently for and repair leaks promptly. Use drip pans to catch leaks until repairs are made.
- Clean up spills or leaks immediately and dispose of cleanup materials properly.
- Do not hose down surfaces where fl uids have spilled. Use dry cleanup methods (absorbent materials, cat litter, and/or rags).
- Sweep up spilled dry materials immediately. Do not try to wash them away with water, or bury them.
- Clean up spills on dirt areas by digging up and properly disposing of contaminated soil.
- Report significant spills immediately. You are required by law to report all significant releases of hazardous materials, including oil. To report a spill: 1) Dial 911 or your local emergency response number, 2) Call the Governor's Offi ce of Emergency Services Warning Center, (800) 852-7550 (24 hours).

# **Earthmoving**

- ☐ Schedule grading and excavation work during dry weather.
- Stabilize all denuded areas, install and maintain temporary erosion controls (such as erosion control fabric or bonded fi ber matrix) until vegetation is established.
- Remove existing vegetation only when absolutely necessary, and seed or plant vegetation for erosion control on slopes or where construction is not immediately planned.
- Prevent sediment from migrating offsite and protect storm drain inlets, gutters, ditches, and drainage courses by installing and maintaining appropriate BMPs, such as fi ber rolls, silt fences, sediment basins, gravel bags, berms, etc.
- Keep excavated soil on site and transfer it to dump trucks on site, not in the streets.

# **Contaminated Soils**

- ☐ If any of the following conditions are observed, test for contamination and contact the Regional Water Quality Control Board:
- Unusual soil conditions, discoloration, or odor.
- Abandoned underground tanks.
- Abandoned wells
- Buried barrels, debris, or trash

# Paving/Asphalt Work

- Avoid paving and seal coating in wet weather or when rain is forecast, to prevent materials that have not cured from contacting stormwater runoff.
- Cover storm drain inlets and manholes when applying seal coat, tack coat, slurry seal, fog seal, etc.
- Collect and recycle or appropriately dispose of excess abrasive gravel or sand. Do NOT sweep or wash it into gutters.
- Do not use water to wash down fresh asphalt concrete pavement.

# Sawcutting & Asphalt/Concrete Removal

- Protect nearby storm drain inlets when saw cutting. Use fi lter fabric, catch basin inlet fi lters, or gravel bags to keep slurry out of the storm drain system.
- Shovel, abosorb, or vacuum saw-cut slurry and dispose of all waste as soon as you are fi nished in one location or at the end of each work day (whichever is sooner!).
- If sawcut slurry enters a catch basin, clean it up immediately.

# Concrete, Grout & Mortar **Application**

# ☐ Store concrete, grout, and mortar away from storm drains or waterways, and on pallets under cover to protect them from rain, runoff, and wind

- Wash out concrete equipment/trucks offsite or in a designated washout area, where the water will fl ow into a temporary waste pit, and in a manner that will prevent leaching into the underlying soil or onto surrounding areas. Let concrete harden and dispose of as
- When washing exposed aggregate, prevent washwater from entering storm drains. Block any inlets and vacuum gutters, hose washwater onto dirt areas, or drain onto a bermed surface to be pumped and disposed of properly.

# **Dewatering**

- Discharges of groundwater or captured runoff from dewatering operations must be properly managed and disposed. When possible send dewatering discharge to landscaped area or sanitary sewer. If discharging to the sanitary sewer call your local wastewater treatment plant.
- Divert run-on water from offsite away from all disturbed areas.
- When dewatering, notify and obtain approval from the local municipality before discharging water to a street gutter or storm drain. Filtration or diversion through a basin, tank, or sediment trap may be required.
- In areas of known or suspected contamination, call your local agency to determine whether the ground water must be tested. Pumped groundwater may need to be collected and hauled off-site for treatment and proper disposal.

# **Painting & Paint Removal**

# **Painting Cleanup and Removal**

- ☐ Never clean brushes or rinse paint containers into a street, gutter, storm drain, or stream.
- ☐ For water-based paints, paint out brushes to the extent possible, and rinse into a drain that goes to the sanitary sewer. Never pour paint down a storm drain.
- ☐ For oil-based paints, paint out brushes to the extent possible and clean with thinner or solvent in a proper container. Filter and reuse thinners and solvents. Dispose of excess liquids as hazardous waste.
- Paint chips and dust from non-hazardous dry stripping and sand blasting may be swept up or collected in plastic drop cloths and disposed of as trash.
- Chemical paint stripping residue and chips and dust from marine paints or paints containing lead, mercury, or tributyltin must be disposed of as hazardous waste. Lead based paint removal requires a statecertifi ed contractor.

# Landscaping

- Protect stockpiled landscaping materials from wind and rain by storing them under tarps all year-round.
- ☐ Stack bagged material on pallets and under cover.
- ☐ Discontinue application of any erodible landscape material within 2 days before a forecast rain event or during wet weather.

CA008 CHECKED BY CA007

SHEET

ISSUE DATE 05/07/2025 SCALE

> N/A ANURA JOB NO CA2504-0002

anura

design

<u>/</u>1\ 06/27/2025

<u>2</u> 07/25/2025

C-35019

ROMAIN CURTIS ARCHITECT #C35019 367 CIVIC DR #3,

phone: 510.612.0345 roman@anuradesign.com

REMODEL

NOILIC

ADI

130 AL

UTION TION PL

PLEASANT HILL, CA94523

**REVISIONS** 

Storm drain polluters may be liable for fines of up to \$10,000 per day!

#### PRESCRIPTIVE RESIDENTIAL ALTERATIONS

CF1R-ALT-01-E (Page 1 of 7)

| CERTIFICATE OF COMP | LIANCE |
|---------------------|--------|
| •                   |        |

| Project Name:     | 1301 FERNSIDE BLVD - ALT | Enforcement Agency:      | Alameda, City of |
|-------------------|--------------------------|--------------------------|------------------|
| Dwelling Address: | 1301 Fernside Blvd       | Permit Number:           |                  |
| City and Zip Code | Alameda, 94501           | Permit Application Date: | 2025-04-28       |

| tion        |  |  |  |   |  |  |  |
|-------------|--|--|--|---|--|--|--|
|             |  |  |  | <u> </u>  |  |  |  |
| 1           | 1301 FERNSIDE BLVD - ALT   |  | 02   | Date Prepared   | 2025-07-24   |  |  |
| on 1        | 1301 Fernside Blvd   |  | 04   | Building Front Orientation (deg)  | 131  |  |  |
| ,           | Alameda  |  | 06   | Number of Altered Dwelling Units  | 1  |  |  |
| 2           | 94501  |  | 08   | Fuel Type   | Natural gas  |  |  |
| 3           | 3  |  | 10   | Total Conditioned Floor Area (ft²):   | 1093   |  |  |
| 5           | Single family  |  | 12   | Slab Area (ft <sup>2</sup> ):   | 0  |  |  |
| F<br>I<br>H | Adding Fenestration/Glazing less than or equal to 16 ft <sup>2</sup> Skylights Replacing Fenestration/Glazing less than or equal to 75 ft <sup>2</sup> Windows Insulation Kitchen Range Hood Installation (new or replacement) Kitchen Remodel Water heating |  |  |   |  |  |  |
|             | n  | n 1301 Fernside Blvd  Alameda  94501  3  Single family  Adding Fenestration/Glazing Replacing Fenestration/Glazi Insulation Kitchen Range Hood Installat Kitchen Remodel Water heating | Alameda  94501  3  Single family  Adding Fenestration/Glazing less than or equal to 16 ft² Skylight Replacing Fenestration/Glazing less than or equal to 75 ft² Wind Insulation  Kitchen Range Hood Installation (new or replacement)  Kitchen Remodel Water heating | Alameda  94501  Single family  Adding Fenestration/Glazing less than or equal to 16 ft² Skylights Replacing Fenestration/Glazing less than or equal to 75 ft² Windows Insulation Kitchen Range Hood Installation (new or replacement) Kitchen Remodel Water heating | Alameda  O6 Number of Altered Dwelling Units  94501  08 Fuel Type  3 |  |  |

Registration Number: 425-A010225925A-000-000-0000000-0000 Registration Date/Time: 2025-07-24 18:32:13 HERS Provider: CHEERS NOTICE: This document has been generated by California Home Energy Efficiency Rating Services (CHEERS) using information uploaded by third parties not affiliated with or related to CHEERS. Therefore, CHEERS is not responsible for, and cannot guarantee, the accuracy or completeness of the information contained in this document. Report Generated: 2025-07-24 18:32:24 CA Building Energy Efficiency Standards - 2022 Residential Compliance Report Version: 2022.0.000 Schema Version: rev 20220101

# CALIFORNIA ENERGY COMMISSION

#### PRESCRIPTIVE RESIDENTIAL ALTERATIONS

CF1R-ALT-01-E (Page 4 of 7)

| in a second |  | (rage 4 01 /)  |
|-------------|--|--|
| 20          | Compliance Statement                       | Design complies with the total allowed west-facing fenestration area |
| 21          | Proposed Fenestration U-factor (Windows)   | n/a  |
| 22          | Required Fenestration U-factor (Windows)   | 0.3  |
| 23          | Compliance Statement                       | n/a  |
| 24          | Proposed Fenestration SHGC (Windows)       | n/a  |
| 25          | Required Fenestration SHGC (Windows)       | n/a  |
| 26          | Compliance Statement                       | n/a  |
| 27          | Proposed Fenestration U-factor (Skylights) | 0.3  |
| 28          | Required Fenestration U-factor (Skylights) | 0.55   |
| 29          | Compliance Statement                       | Design complies with the maximum allowed fenestration U-value        |
| 30          | Proposed Fenestration SHGC (Skylights)     | 0.23   |
| 31          | Required Fenestration SHGC (Skylights)     | 0.3  |
| 32          | Compliance Statement                       | Design complies with the maximum allowed fenestration SHGC           |

|        | H. Fenestration Proposed Areas and Efficiencies - Replace (Section 150.2(b)1B)  Note: Doors with greater than or equal to 25 percent glazed area are considered glazed doors and are treated as fenestration products. |            |                    |                              |                                       |                                  |                                      |                      |                                |                  |                         |                               |                                   |
|--------|--|------------|--------------------|------------------------------|---------------------------------------|----------------------------------|--------------------------------------|----------------------|--------------------------------|------------------|-------------------------|-------------------------------|-----------------------------------|
| 01     | 02   | 03         | 04                 | 05                           | 06                                    | 07 🦳                             | 08                                   | 09                   | 10                             | 11               | 12                      | 13                            | 14                                |
| Tag/ID | Fenestration<br>Type   | Frame Type | Dynamic<br>Glazing | Orientation<br>N, S, W, or E | Area<br>Removed<br>(ft <sup>2</sup> ) | Area Added<br>(ft <sup>2</sup> ) | Net Added<br>Area (ft <sup>2</sup> ) | Proposed<br>U-factor | Proposed<br>U-factor<br>Source | Proposed<br>SHGC | Proposed<br>SHGC Source | Exterior<br>Shading<br>Device | Combined SHGC from<br>CF1R-ENV-03 |
| WIN1   | Operable window  | Non-metal  | None               | South                        | 11.66                                 | 15.75                            | 4.09                                 | 0.3                  | NFRC                           | 0.23             | NFRC                    | None                          |                                   |
| WIN6   | Operable window  | Non-metal  | None               | North                        | 11.25                                 | 18                               | 6.75                                 | 0.3                  | NFRC                           | 0.23             | NFRC                    | None                          |                                   |
| 15     | 15 Net Added West-facing Fenestration Area   |            |                    |                              |                                       |                                  |                                      | 0                    |                                |                  |                         |                               |                                   |

Registration Number: 425-A010225925A-000-000-000000-0000 NOTICE: This document has been generated by California Home Energy Efficiency Rating Services (a and cannot guarantee, the accuracy or completeness of the information contained in this document. Registration Date/Time: 2025-07-24 18:32:13 HERS Provider: CHEERS EERS) using information uploaded by third parties not affiliated with or related to CHEERS. Therefore, CHEERS is not responsible for, Report Version: 2022.0.000 CA Building Energy Efficiency Standards - 2022 Residential Compliance Report Generated: 2025-07-24 18:32:24 Schema Version: rev 20220101



# PRESCRIPTIVE RESIDENTIAL ALTERATIONS

CF1R-ALT-01-E

(Page 7 of 7)

| DOCUMENTATION AUTHOR'S DECLARATION STATEMEN  | T                              |   |
|--|--------------------------------|---|
| 1. I certify that this Certificate of Compliance documentation is accurat  | e and complete.                |   |
| Documentation Author Name:<br>Studio 01  |                                | Documentation Author Signature: Studio 01               |
| Company:<br>Anura Design   |                                | Signature Date: 2025-07-23                              |
| Address:<br>367 Civic Drive  |                                | CEA/ HERS Certification Identification (if applicable): |
| City/State/Zip:<br>Pleasant Hill CA 94523  |                                | Phone:<br>6024038322                                    |
| RESPONSIBLE PERSON'S DECLARATION STATEMENT   |                                | 7,4   |
| I certify the following under penalty of perjury, under the     The information provided on this Certificate of     I am eligible under Division 3 of the Business ar     Compliance (responsible designer). | Compliance is true and correct |   |

3. The energy features and performance specifications, materials, components, and manufactured devices for the building design or system design identified on this Certificate of Compliance conform to the requirements of Title 24, Part 1 and Part 6 of the California Code of Regulations. 4. The building design features or system design features identified on this Certificate of Compliance are consistent with the information provided on other applicable

compliance documents, worksheets, calculations, plans and specifications submitted to the enforcement agency for approval with this building permit application. 5. I understand that a registered copy of this Certificate of Compliance shall be made available with the building permit(s) issued for the building, and made available to

the enforcement agency for all applicable inspections, and I will take the necessary steps to accomplish this requirement. 6. I understand that a registered copy of this Certificate of Compliance is required to be included with the documentation the builder provides to the building owner at occupancy, and I will take the necessary steps to accomplish these requirements.

| Responsible Designer Name: Romain Curtis  | Responsible Designer Signature: Romain Curtis |
|---|---|
| Company :<br>Anura Design                 | Date Signed: 2025-07-24                       |
| Address:<br>367 Civic Drive               | License:<br>C 35019                           |
| City/State/Zip:<br>Pleasant Hill CA 94523 | Phone: 6024038322                             |

Registration Number: 425-A010225925A-000-000-0000000-0000 Registration Date/Time: 2025-07-24 18:32:13 HERS Provider: CHEERS NOTICE: This document has been generated by California Home Energy Efficiency Rating Services (CHEERS) using information uploaded by third parties not affiliated with or related to CHEERS. Therefore, CHEERS is not responsible for, and cannot guarantee, the accuracy or completeness of the information contained in this document. HERS Provider: CHEERS CA Building Energy Efficiency Standards - 2022 Residential Compliance Report Version: 2022.0.000 Report Generated: 2025-07-24 18:32:24 Schema Version: rev 20220101

PRESCRIPTIVE RESIDENTIAL ALTERATIONS CF1R-ALT-01-E CALIFORNIA ENERGY COMMISSION (Page 2 of 7)

| 01        | 02               | 03         | 04                      | 05                     | 0       | 16                       | 07       | 08                 | 09   | 10          | 11       |
|-----------|------------------|------------|-------------------------|------------------------|---------|--------------------------|----------|--------------------|------|-------------|----------|
|           |                  |            |                         |                        |         |                          | Proposed |                    |      | Required    |          |
| Tag/ID    | Assembly<br>Type | Frame Type | Frame Depth<br>(inches) | Frame Spacing (inches) | Cavity  | Continuous<br>Insulation | U-Factor | Joint App<br>Refer |      | U-Factor Or | Comments |
|           |                  |            |                         |                        | R-value | -value R-value           | 0-ractor | Table              | Cell | R-value     |          |
| WALL1     | Wall             | Wood       | 2x4                     | @ 16 in. O. C.         | 15      | 0                        | 0.095    | 4.3.1              | 4A   | 0.048       |          |
| FLOOR - 1 | Floor            | Wood       | 2x8                     | @ 16 in. O. C.         | 19      | 0                        | 0.037    | 4.4.1              | 5A   | 0.037       |          |
| ROOF - 1  | Roof             | Wood       | 2x6                     | @ 24 in. O. C.         | 30      | 0                        | 0.031    | 4.2.1              | 20A  | 0.031       |          |

tested according to American Society for Testing and Materials (ASTM) Standard C272.

This section does not apply to this project.

This section does not apply to this project.

C. Building Insulation Details - Non-Framed

D. Building Insulation Details - Mass Walls This section does not apply to this project.

E. Roof Replacement (Section 150.2(b)1H)

Registration Number: 425-A010225925A-000-000-0000000-0000 Registration Date/Time: 2025-07-24 18:32:13 NOTICE: This document has been generated by California Home Energy Efficiency Rating Services (CHEERS) using information uploaded by third parties not affiliated with or related to CHEERS. Therefore, CHEERS is not responsible for, and cannot guarantee, the accuracy or completeness of the information contained in this document. Report Generated: 2025-07-24 18:32:24 CA Building Energy Efficiency Standards - 2022 Residential Compliance Report Version: 2022.0.000

# CALIFORNIA ENERGY COMMISSION

H1. Opaque Swinging Doors to Exterior (Section 150.1(c)5)

Registration Number: 425-A010225925A-000-000-000000-0000 NOTICE: This document has been generated by California Home Energy Efficiency Rating Services and cannot guarantee, the accuracy or completeness of the information contained in this document

CA Building Energy Efficiency Standards - 2022 Residential Compliance

# PRESCRIPTIVE RESIDENTIAL ALTERATIONS

Schema Version: rev 20220101

CF1R-ALT-01-E (Page 5 of 7)

HERS Provider: CHEERS

Report Generated: 2025-07-24 18:32:24

| 16 | Is Net Added Fenestration Area <= zero for west-facing fenestration? | Yes   |
|----|--|---|
| 17 | Net Added Fenestration Area (all orientations)                       | 10.84   |
| 18 | Is Net Added Fenestration Area <= zero for all orientations?         | No  |
| 19 | Proposed Fenestration U-factor (Windows)                             | 0.3   |
| 20 | Required Fenestration U-factor (Windows)                             | 0.4   |
| 21 | Compliance Statement   | Design complies with the maximum allowed fenestration U-value |
| 22 | Proposed Fenestration SHGC (Windows)                                 | 0.23  |
| 23 | Required Fenestration SHGC (Windows)                                 | n/a   |
| 24 | Compliance Statement   | Design complies with the maximum allowed fenestration SHGC    |
| 25 | Proposed Fenestration U-factor (Skylights)                           | n/a   |
| 26 | Required Fenestration U-factor (Skylights)                           | 0.55  |
| 27 | Compliance Statement   | n/a   |
| 28 | Proposed Fenestration SHGC (Skylights)                               | n/a   |
| 29 | Required Fenestration SHGC (Skylights)                               | 0.3   |
| 30 | Compliance Statement   | n/a   |
|    |  |   |

I. Space Conditioning (SC) Systems - Heating/Cooling (Section 150.2(b). This section does not apply to this project.

This section does not apply to this project.

Registration Date/Time: 2025-07-24 18:32:13

Report Version: 2022.0.000

Schema Version: rev 20220101

CHEERS) using information uploaded by third parties not affiliated with or related to CHEERS. Therefore, CHEERS is not responsible for,

CALIFORNIA ENERGY COMMISSION

Glazing less

to 16 ft2 Skylights Replacing Glazing less

than or equa

to 75 ft2

Maximum Allowed

Orientation (ft<sup>2</sup>)

Fenestration Area for All

Allowed

West-Facing

Fenestration

Area Only (ft<sup>2</sup>)

n/a

None

Existing

Fenestration

Area for All

Orientations (ft<sup>2</sup>)

F. Fenestration/Glazing Allowed Areas and Efficiencies (Section 150.2(b)1)

G. Fenestration Proposed Areas and Efficiencies - Add (Section 150.2(b)1A)

Frame Type

Metal with

18 Existing + Proposed West-Facing Fenestration Area

19 Maximum Allowed West Facing Fenestration Area

Registration Number: 425-A010225925A-000-000-0000000-0000

CA Building Energy Efficiency Standards - 2022 Residential Compliance

Skylight

17 Compliance Statement

15 Existing + Proposed Fenestration Area

16 Maximum Allowed Fenestration Area

CALIFORNIA ENERGY COMMISSION

PRESCRIPTIVE RESIDENTIAL ALTERATIONS

Allowed U-factor | Allowed U-factor

(Windows) (Skylights)

0.55

Existing

West-Facing

Fenestration

Area (ft<sup>2</sup>)

Note: Doors with greater than or equal to 25 percent glazed area are considered glazed doors and are treated as fenestration products.

South Double pane

S, W, or E

CF1R-ALT-01-E (Page 3 of 7)

(Skylights)

0.23

SHGC SHGC Source

NFRC

0.23

Allowed SHGC

(Windows)

n/a


U-factor Source

NFRC

Design complies with the total allowed fenestration area

REVISIONS 1 06/27/2025

2 07/25/2025

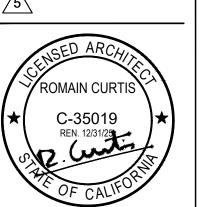

ROMAIN CURTIS ARCHITECT #C35019 367 CIVIC DR #3, PLEASANT HILL, CA94523 phone: 510.612.0345

roman@anuradesign.com

REMODE

CF1R-ALT-01-E

(Page 6 of 7)

HERS Provider: CHEERS

Report Generated: 2025-07-24 18:32:24

Shading SHGC from Device CF1R-ENV-03

# PRESCRIPTIVE RESIDENTIAL ALTERATIONS

NOTICE: This document has been generated by California Home Energy Efficiency Rating Services (CHEERS) using information uploaded by third parties not affiliated with or related to CHEERS. Therefore, CHEERS is not responsible for, and cannot guarantee, the accuracy or completeness of the information contained in this document.

Report Version: 2022.0.000

Schema Version: rev 20220101

06 07 08 09 10

Fenestration | West Facing

Panes Area N, S, E Fenestration U-factor

162.58

Registration Date/Time: 2025-07-24 18:32:13

(ft<sup>2</sup>) Area (ft<sup>2</sup>)


4.58

| 01                              | Is the existing water he     | ater electric resistance? | Yes                   |        |             |  |
|---------------------------------|------------------------------|---------------------------|-----------------------|--------|-------------|--|
| 02                              | 03                           | 04                        | 05                    | 06     | 07          | 08   |
| Water Heating System ID or Name | Water Heating System<br>Type | System Option (from )     | Water Heater Type     | Volume | Fuel Type   | # of Water Heaters i<br>System                 |
| 1 WH1                           | Domestic Hot Water           | Option1GasPropane         | InstantaneousConsumer | n/a    | Natural Gas | $\phantom{aaaaaaaaaaaaaaaaaaaaaaaaaaaaaaaaaaa$ |

1. A natural gas or propane water heating system.

2. A single heat pump water heater, storage tank shall not be located outdoors and placed on an incompressible, rigid insulated surface with a minimum thermal resistance of R-10

3. A single Tier 3 or higher heat pump water heater (as rated by Northwest Energy Efficiency Alliance (NEEA)) 4. If the existing water heater is electric resistance, a consumer electric water heater

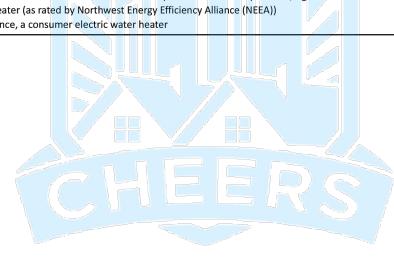

Registration Number: 425-A010225925A-000-000-0000000-00000 Registration Date/Time: 2025-07-24 18:32:13 HERS Provider: CHEERS NOTICE: This document has been generated by California Home Energy Efficiency Rating Services (CHEERS) using information uploaded by third parties not affiliated with or related to CHEERS. Therefore, CHEERS is not responsible for, and cannot guarantee, the accuracy or completeness of the information contained in this document. CA Building Energy Efficiency Standards - 2022 Residential Compliance Report Version: 2022.0.000

HERS Provider: CHEERS Report Generated: 2025-07-24 18:32:24 Schema Version: rev 20220101

DRAWN BY CA008

ISSUE DATE

SCALE

#### PRESCRIPTIVE ADDITIONS 1000 FT2 OR LESS

CF1R-ADD-01-E

(Page 1 of 7)

#### CERTIFICATE OF COMPLIANCE

| Project Name:     | 1301 FERNSIDE BLVD - ADD | Enforcement Agency:      | Alameda, City of |
|-------------------|--------------------------|--------------------------|------------------|
| Dwelling Address: | 1301 Fernside Blvd       | Permit Number:           |                  |
| City and Zip Code | Alameda, 94501           | Permit Application Date: | 2025-04-28       |

|   | A. General Information |                  |  |  |    |  |                                 |  |
|---|------------------------|------------------|--|--|----|--|---------------------------------|--|
|   | 01                     | Project Name     | 1301 FERNSIDE BLVD - ADD                     |  | 02 | Date Prepared  | 2025-08-09                      |  |
|   | 03                     | Project Location | 1301 Fernside Blvd                           |  | 04 | Building Front Orientation (deg)                           | 131                             |  |
|   | 05                     | CA City          | Alameda                                      |  | 06 | Number of Dwelling Units with Additions                    | 1                               |  |
|   | 07                     | Zip Code         | 94501  |  | 08 | Fuel Type  | Natural gas                     |  |
|   | 09                     | Climate Zone     | 3  |  | 10 | Total Conditioned Floor Area (ft <sup>2</sup> ) (Addition) | 280                             |  |
| Γ | 11                     | Building Type    | Single family                                |  | 12 | Slab Area (ft <sup>2</sup> )                               | 0                               |  |
| ſ | 13                     | Project Scope    | Addition 300 ft <sup>2</sup><br>Fenestration |  | 14 | Fenestration Exceptions                                    | NA (do not allow other entries) |  |

| B. Building In | sulation Detai   | ls - Framed Wa | ills/ Framed Flo        | oors (Section 15             | 50.2(a)) |                |          |             |             |                        |          |
|----------------|------------------|----------------|-------------------------|------------------------------|----------|----------------|----------|-------------|-------------|------------------------|----------|
| 01             | 02               | 03             | 04                      | 05                           |          | 6              | 07       | 08          | 09          | 10                     | 11       |
|                |                  |                | Y                       |                              |          |                | Proposed |             |             | Required               |          |
| Tag/ID         | Assembly<br>Type | Frame Type     | Frame Depth<br>(inches) | Frame<br>Spacing<br>(inches) | Cavity   | Continuous     | U-Factor | Appendix JA | 4 Reference | U-Factor<br>from Table | Comments |
|                |                  |                |                         |                              | R-value  | ' I Insulation |          | Table       | Cell        | 150.1-A                |          |
| WALL2          | Wall             | Wood           | 2x6                     | @ 16 in. O.<br>C.            | 21       | 0              | 0.069    | 4.3.1       | 6A          | 0.069                  |          |

Registration Number: 425-D010243501A-000-000-000000-0000

NOTICE: This document has been generated by California Home Energy Efficiency Rating Services (Cl and cannot guarantee, the accuracy or completeness of the information contained in this document. Registration Date/Time: 2025-08-09 10:20:29 HERS Provider: CHEERS CHEERS) using information uploaded by third parties not affiliated with or related to CHEERS. Therefore, CHEERS is not responsible for, CA Building Energy Efficiency Standards - 2022 Residential Compliance Report Version: 2022.0.000 Report Generated: 2025-08-09 10:20:46 Schema Version: rev 20220101

# CALIFORNIA ENERGY COMMISSION

#### PRESCRIPTIVE ADDITIONS 1000 FT2 OR LESS

CF1R-ADD-01-E (Page 4 of 7)

| H. Fenestration/             | Glazing Allowed A                           | Areas and Efficien   | cies (Section 150.2   | 2(a)1)   |                       |                         |                           |      |          |
|------------------------------|---|--|---|--|-----------------------|-------------------------|---------------------------|------|----------|
| 01                           | 02  | 03   | 04 05   |  | 06                    | 07                      | 08                        | 09   | 10       |
| Addition Type                | For All Orie                                | Maximum Allowed Fenestration Area For All Orientations ft <sup>2</sup> The Greater |   | Maximum Allowed West-Facing Fenestration Area Only ft <sup>2</sup> The Greater |                       | Maximum<br>Allowed      | Maximum                   |      |          |
| ft <sup>2</sup>              | Maximum<br>Calculated based<br>on Allowed % | Maximum<br>Calculated<br>Allowed ft <sup>2</sup>                                   | The Greater  Maximum Calculated based on Allowed %  Maximum Calculated Calculated Allowed ft <sup>2</sup> |  | U-factor<br>(Windows) | U-factor<br>(Skylights) | Allowed SHGC<br>(Windows) |      | Comments |
| Addition 300 ft <sup>2</sup> | 84  | 75   | n/a   | n/a  | 0.3                   | 0.3                     | n/a                       | 0.23 |          |

| lote: If meet                       | ion Proposed A<br>ting Exception 1 to<br>Exception 1 to 150<br>h greater than or 6 | o 150.1(c)3A, In<br>D.1(c)3A, Install   | stalling less than<br>ing less than or | equal to 3 squa           | re feet (ft²) tubu | ılar skylight, it is   | assumed to meet  | the minimum r        |                                | , ,              | . ,                     |                               |                                |
|-------------------------------------|--|---|--|---------------------------|--------------------|--|--|----------------------|--------------------------------|------------------|-------------------------|-------------------------------|--------------------------------|
| 01                                  | 02   | 03  | 04                                     | 05                        | 06                 | 07   | 08   | 09                   | 10                             | 11               | 12                      | 13                            | 14                             |
| Tag/ID                              | Fenestration<br>Type   | Frame Type  | Dynamic<br>Glazing                     | Orientation<br>N, S, W, E | Number of<br>Panes | Proposed<br>Fenestration<br>Area ft <sup>2</sup>   | Proposed West Facing Fenestration Area ft <sup>2</sup> | Proposed<br>U-factor | Proposed<br>U-factor<br>Source | Proposed<br>SHGC | Proposed<br>SHGC Source | Exterior<br>Shading<br>Device | Combin<br>SHGC fro<br>CF1R-ENV |
| WIN2                                | Operable<br>window   | Non-metal   | None                                   | West                      | Double pane        |  | 22   | 0.3                  | NFRC                           | 0.23             | NFRC                    | None                          | n/a                            |
| WIN3                                | Operable<br>window   | Non-metal   | None                                   | West                      | Double pane        |  | 8.75   | 0.3                  | NFRC                           | 0.23             | NFRC                    | None                          | n/a                            |
| WIN4 2X                             | Operable<br>window   | Non-metal   | None                                   | West                      | Double pane        | Sound Sound on the Sound | 24   | 0.3                  | NFRC                           | 0.23             | NFRC                    | None                          | n/a                            |
| WIN5                                | Operable<br>window   | Non-metal   | None                                   | West                      | Double pane        |  | 6  | 0.3                  | NFRC                           | 0.23             | NFRC                    | None                          | n/a                            |
| 15 Total Proposed Fenestration Area |  |   |  |                           |                    |  |  | 60                   | ).75                           |                  |                         |                               |                                |
| 16                                  | Maximum Allowed Fenestration Area 84   |   |  |                           |                    |  |  |                      | 34                             |                  |                         |                               |                                |
| 17                                  | Compliance St  | Compliance Statement Design complies with the total allowed fenestration area |  |                           |                    |  |  |                      |                                |                  |                         |                               |                                |
| 18                                  | Total Propose West-Facing Fenestration Area 60.75                                  |   |  |                           |                    |  |  |                      |                                |                  |                         |                               |                                |

Registration Number: 425-D010243501A-000-000-0000000-0000 Registration Date/Time: 2025-08-09 10:20:29 HERS Provider: CHEERS NOTICE: This document has been generated by California Home Energy Efficiency Rating Services (CHEERS) using information uploaded by third parties not affiliated with or related to CHEERS. Therefore, CHEERS is not responsible for, and cannot guarantee, the accuracy or completeness of the information contained in this document. Report Generated: 2025-08-09 10:20:46 CA Building Energy Efficiency Standards - 2022 Residential Compliance Report Version: 2022.0.000 Schema Version: rev 20220101

# CALIFORNIA ENERGY COMMISSION

# PRESCRIPTIVE ADDITIONS 1000 FT2 OR LESS

CF1R-ADD-01-E

(Page 7 of 7)

| DOCUMENTATION AUTHOR'S DECLARATION STATEMENT   |  |
|--|--|
| 1. I certify that this Certificate of Compliance documentation is accurate and comp  | plete  |
| Documentation Author Name:<br>Studio 01  | Documentation Author Signature: Studio 01  |
| Company:<br>Anura Design   | Signature Date: 2025-08-08   |
| Address:<br>367 Civic Drive  | CEA/ HERS Certification (dentification (if applicable):  |
| City/State/Zip:<br>Pleasant Hill CA 94523  | Phone:<br>6024038322   |
| RESPONSIBLE PERSON'S DECLARATION STATEMENT   |  |
| Compliance (responsible designer).  3. The energy features and performance specifications, ma Certificate of Compliance conform to the requirements of the building design features or system design features in compliance documents, worksheets, calculations, plans of the enforcement agency for all applicable inspections, and | nce is true and correct.  Issions Code to accept responsibility for the building design or system design identified on this Certificate of aterials, components, and manufactured devices for the building design or system design identified on this of Title 24, Part 1 and Part 6 of the California Code of Regulations.  Identified on this Certificate of Compliance are consistent with the information provided on other applicable and specifications submitted to the enforcement agency for approval with this building permit application.  Compliance shall be made available with the building permit(s) issued for the building, and made available to and I will take the necessary steps to accomplish this requirement.  Compliance is required to be included with the documentation the builder provides to the building owner at |
| Responsible Designer Name: Romain Curtis   | Responsible Designer Signature:  Romain Curtis   |
| Company:<br>Anura Design   | Date Signed: 2025-08-09  |
| Address:<br>367 Civic Drive  | License:<br>C 35019  |
| City/State/Zip:<br>Pleasant Hill CA 94523  | Phone: 6024038322  |

Digitally signed by California Home Energy Efficiency Rating Services (CHEERS). This digital signature is provided in order to secure the content of this registered document, and in no way implies Registration Provider responsibility for the accuracy of the information.

Registration Number: 425-D010243501A-000-000-0000000-0000 Registration Date/Time: 2025-08-09 10:20:29 HERS Provider: CHEERS NOTICE: This document has been generated by California Home Energy Efficiency Rating Services (CHEERS) using information uploaded by third parties not affiliated with or related to CHEERS. Therefore, CHEERS is not responsible for, and cannot guarantee, the accuracy or completeness of the information contained in this document. HERS Provider: CHEERS CA Building Energy Efficiency Standards - 2022 Residential Compliance Report Version: 2022.0.000 Report Generated: 2025-08-09 10:20:46 Schema Version: rev 20220101

# PRESCRIPTIVE ADDITIONS 1000 FT2 OR LESS

CF1R-ADD-01-E (Page 2 of 7)

| 01     | 02               | 03         | 04                      | 05                           | 0       | 16                       | 07       | 08          | 09          | 10                     | 11       |
|--------|------------------|------------|-------------------------|------------------------------|---------|--------------------------|----------|-------------|-------------|------------------------|----------|
|        |                  |            |                         |                              |         |                          | Proposed | 7           | ì           | Required               |          |
| Tag/ID | Assembly<br>Type | Frame Type | Frame Depth<br>(inches) | Frame<br>Spacing<br>(inches) | Cavity  | Continuous<br>Insulation | U-Factor | Appendix JA | 4 Reference | U-Factor<br>from Table | Comments |
|        |                  |            |                         |                              | R-value | R-value                  | 0-ractor | Táble       | Cell        | 150.1-A                |          |
| FLOOR  | Floor            | Wood       | 2x8                     | @ 16 in. O.<br>C.            | 19      | 0                        | 0.037    | 4.4.1       | 5A          | 0.037                  |          |
| ROOF   | Roof             | Wood       | 2x6                     | @ 24 in. O.<br>C.            | 30      | 0                        | 0.031    | 4,2.1       | 20A         | 0.031                  |          |

• Where insulation is installed above the roofing membrane, or above the layer used to seal the roof from water penetration, the insulation shall have a maximum water absorption of 0.3 percent by volume when tested according to American Society for Testing and Materials (ASTM) Standard C272. Extensions of existing wood-framed walls may retain the dimensions of the existing walls and shall install cavity insulation of R-15 in a 2x4 framing and R-21 in a 2x6 framing.

This section does not apply to this project.

This section does not apply to this project.

C. Building Insulation Details - Non-framed (Section 150.1(c)1)

D. Building Insulation Details - Mass Walls (Section 150.1(c)1Bii)

E. Slab On Grade/Concrete Raised Floor Insulation (Table 150.1-A)

This section does not apply to this project.

Registration Number: 425-D010243501A-000-000-0000000-0000 Registration Date/Time: 2025-08-09 10:20:29 HERS Provider: CHEERS NOTICE: This document has been generated by California Home Energy Efficiency Rating Services (CHEERS) using information uploaded by third parties not affiliated with or related to CHEERS. Therefore, CHEERS is not responsible for, and cannot guarantee, the accuracy or completeness of the information contained in this document. Report Version: 2022.0.000 Report Generated: 2025-08-09 10:20:46 CA Building Energy Efficiency Standards - 2022 Residential Compliance Schema Version: rev 20220101

# CALIFORNIA ENERGY COMMISSION

J. Opaque Swinging Doors to Exterior (Section 150.1(c)5)

#### PRESCRIPTIVE ADDITIONS 1000 FT2 OR LESS

CF1R-ADD-01-E

(Page 5 of 7)

| 19 | Maximum Allowed West Fa    | ing Fenestration Area  | n/a  |  |  |  |  |  |  |
|----|----------------------------|--|------|--|--|--|--|--|--|
| 20 | Compliance Statement       | Design complies with the total allowed west-facing fenestration area | •    |  |  |  |  |  |  |
| 21 | Proposed Fenestration U-fa | Proposed Fenestration U-factor (Windows)                             |      |  |  |  |  |  |  |
| 22 | Required Fenestration U-fa | or (Windows)   | 0.3  |  |  |  |  |  |  |
| 23 | Compliance Statement       | Design complies with the total allowed fenestration area             | •    |  |  |  |  |  |  |
| 24 | Proposed Fenestration SHG  | (Windows)  | 0.23 |  |  |  |  |  |  |
| 25 | Required Fenestration SHG  | (Windows)  | n/a  |  |  |  |  |  |  |
| 26 | Compliance Statement       | Design complies with the maximum allowed fenestration SHGC           | ·    |  |  |  |  |  |  |
| 27 | Proposed Fenestration U-fa | tor (Skylights)  | n/a  |  |  |  |  |  |  |
| 28 | Required Fenestration U-fa | or (Skylights)   | 0.3  |  |  |  |  |  |  |
| 29 | Compliance Statement       | n/a  | •    |  |  |  |  |  |  |
| 30 | Proposed Fenestration SHG  | C(Skylights)   | n/a  |  |  |  |  |  |  |
| 31 |                            |  | 0.23 |  |  |  |  |  |  |
| 32 | Compliance Statement       | n/a  | •    |  |  |  |  |  |  |

|       | ( ) |             | 333        |             |             |
|-------|-----|-------------|------------|-------------|-------------|
| 1     |     | TI:         | . V/ /.    |             |             |
|       |     | inis sectio | n does not | apply to th | is project. |
| <br>1 | 100 |             |            |             |             |
|       |     |             |            |             |             |

K. Space Conditioning (SC) Systems - Heating/ Cooling (Section 150.2(b) or (Section 150.1(c)7) This section does not apply to this project.

L. Water Heating Systems (Section 150.2(a)1D)

| List water heaters                 | and boilers for both         | domestic hot wate   | r (DHW) heaters and                            | hydronic space hea        | iting.      |             |               |                              |
|------------------------------------|------------------------------|---------------------|--|---------------------------|-------------|-------------|---------------|------------------------------|
| 01                                 | 02                           | 03                  | 04   | 05                        | 06          | 07          | 08            | 09                           |
| Water Heating System<br>ID or Name | Water Heating System<br>Type | System Option (from | # of Water<br>Heaters/Compressors<br>in System | Water Heater Type         | Fuel Type   | Rated Input | Tank Location | Distribution Type            |
| WH1                                | Hydronic                     | 3                   | 1  | Consumer<br>Instantaneous | Natural Gas | 200000      | n/a           | Standard Distribution System |

Registration Number: 425-D010243501A-000-000-0000000-0000 Registration Date/Time: 2025-08-09 10:20:29 NOTICE: This document has been generated by California Home Energy Efficiency Rating Services (CHEERS) using information uploaded by third parties not affiliated with or related to CHEERS. Therefore, CHEERS is not responsible for, and cannot guarantee, the accuracy or completeness of the information contained in this document. CA Building Energy Efficiency Standards - 2022 Residential Compliance Report Version: 2022.0.000 Report Generated: 2025-08-09 10:20:46 Schema Version: rev 20220101

# PRESCRIPTIVE ADDITIONS 1000 FT2 OR LESS

Radiant Barrier installed below the roof deck and on all gable end walls

Yes

CALIFORNIA ENERGY COMMISSION

F. Radiant Barrier (Section 150.1(c).2)

CF1R-ADD-01-E (Page 3 of 7)

Comments

A radiant barrier is required (for Climate Zones 2-15) Radiant barriers shall meet specific eligibility and installation criteria to receive energy credit for compliance with the Building Energy Efficiency Standards for low-rise residential buildings.

Refer to Reference Appendices, Residential Appendix RA4.2.1. • The emittance of the radiant barrier shall be less than or equal to 0.05 as tested in accordance with American Society for Testing and Materials (ASTM) C1371 or ASTM E408. • For Prescriptive Compliance the attic shall be ventilated to provide a minimum free ventilation area of not less than 1 square foot (ft<sup>2</sup> of vent area for each 300 square feet ft<sup>2</sup> of attic floor

area with a minimum of 40 percent to no more than 50 percent upper vents. Ridge vents or gable end vents are recommended to achieve the best performance. The material should be cut

G. Roofing Products (Cool Roof) (Section 150.1(c).11)

to allow for full airflow to the venting.

| G. Rooting Pro | baucts (Cool Re | oor) (Section 13 | 0.1(6).11) |              |              |                              |                           |                      |                |                           |                      |                |
|----------------|-----------------|------------------|------------|--------------|--------------|------------------------------|---------------------------|----------------------|----------------|---------------------------|----------------------|----------------|
| 01             | 02              | 03               | 04         | 05           | 06           | 07                           | 08                        | 09                   | 10             | 11                        | 12                   | 13             |
|                |                 |                  | Method of  |              | CRRC Product |                              | Prop                      | osed                 |                |                           | Required             |                |
| Tag/ID         | Exception       | Roof Pitch       | Compliance | Product Type | ID Number    | Initial Solar<br>Reflectance | Aged Solar<br>Reflectance | Thermal<br>Emittance | SRI (optional) | Aged Solar<br>Reflectance | Thermal<br>Emittance | SRI (optional) |

Exception 1 Any roof area covered by building integrated photovoltaic (PV) panels and solar thermal panels are exempt from the above Cool Roof requirements

 Exception 2: Roof construction with a weight of 25 pounds per square foot (lb/ft²) are also exempt. Liquid field applied coatings must comply with installation criteria from Section 110.8(i)4

Registration Number: 425-D010243501A-000-000-0000000-0000 NOTICE: This document has been generated by California Home Energy Efficiency Rating Services (CHEER and cannot guarantee, the accuracy or completeness of the information contained in this document. Registration Date/Time: 2025-08-09 10:20:29 HERS Provider: CHEERS i) using information uploaded by third parties not affiliated with or related to CHEERS. Therefore, CHEERS is not responsible for, CA Building Energy Efficiency Standards - 2022 Residential Compliance Report Version: 2022.0.000 Report Generated: 2025-08-09 10:20:46



#### PRESCRIPTIVE ADDITIONS 1000 FT2 OR LESS

Schema Version: rev 20220101

CF1R-ADD-01-E

(Page 6 of 7)

|                                    | stems (Section 150.2(a<br>and boilers for both |                     | r (DHW) heaters and                            | I hydronic space h | eating.   |             |               |                   |
|------------------------------------|--|---------------------|--|--------------------|-----------|-------------|---------------|-------------------|
| 01                                 | 02   | 03                  | 04   | 05                 | 06        | 07          | 08            | 09                |
| Water Heating System<br>ID or Name | Water Heating System<br>Type                   | System Option (from | # of Water<br>Heaters/Compressors<br>in System | Water Heater Type  | Fuel Type | Rated Input | Tank Location | Distribution Type |
|                                    |  |                     |  | 110                |           |             |               |                   |

1. A single heat pump water heater. The storage tank shall not be located outdoors and shall be placed on an incompressible, rigid insulated surface with a minimum thermal resistance of R-10. The water heater

This section does not apply to this project.

shall be installed with a communication interface that meets either the requirements of Section 110.12(a) or has an ANSI/CTA-2045-B communications port; or 2. A single heat pump water heater that meets the requirements of NEEA Advanced Water Heater Specification Tier 3 or higher; or

3. A gas or propane instantaneous water heater with an input rating of 200,000 Btu per hour or less and no storage tank; or 4. For additions that are 500 square feet or less, an instantaneous electric water heater with point of use distribution as specified in the Reference Appendices, Residential Appendix RA4.4.5


M. Indoor Air Quality (IAQ) Fan Information

CA Building Energy Efficiency Standards - 2022 Residential Compliance

Registration Number: 425-D010243501A-000-000-0000000-0000 Registration Date/Time: 2025-08-09 10:20:29 HERS Provider: CHEERS NOTICE: This document has been generated by California Home Energy Efficiency Rating Services (CHEERS) using information uploaded by third parties not affiliated with or related to CHEERS. Therefore, CHEERS is not responsible for, and cannot guarantee, the accuracy or completeness of the information contained in this document. HERS Provider: CHEERS Report Version: 2022.0.000 Report Generated: 2025-08-09 10:20:46 Schema Version: rev 20220101

REVISIONS

2 07/25/2025

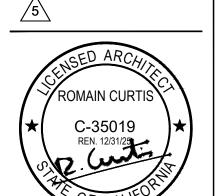

ROMAIN CURTIS ARCHITECT #C35019 367 CIVIC DR #3, phone: 510.612.0345

PLEASANT HILL, CA94523 roman@anuradesign.com

REMODEI 

DRAWN BY CA008

ISSUE DATE

SCALE

SHALL BE AT THE OWNER'S RISK AND THE OWNER AGREES TO DEFEND, INDEMNIFY AND HOLD HARMLESS THE ENGINEER FROM ALL CLAIMS, DAMAGES, AND EXPENSES INCLUDING ATTORNEYS' FEES ARISING OUT OF SUCH UNAUTHORIZED REUSE OF THE ENGINEER'S INSTRUMENTS OF SERVICE BY THE OWNER OR BY OTHERS ACTING THROUGH THE OWNER.

## GENERAL NOTES

- 1. ALL MATERIAL AND WORKMANSHIP SHALL CONFORM TO 2021 IBC, 2022 CALIFORNIA BUILDING
- 2. THE GENERAL CONTRACTOR SHALL VERIFY ALL DIMENSIONS ON JOBSITE WITH COMPLETE SET OF LATEST DRAWINGS, NOTES AND DIMENSIONS SHALL BE CHECKED AND VERIFIED WITH ARCHITECTURAL AND STRUCTURAL DRAWINGS. ANY DISCREPANCIES IN NOTES OR DIMENSIONS SHALL BE BROUGHT TO THE ATTENTION OF THE ARCHITECT BEFORE COMMENCING WORK SO THAT PROPER REMEDIAL WORK CAN BE EXECUTED.
- 3. UNLESS SPECIFICALLY DETAILED ON THESE DRAWINGS, CONTRACTOR SHALL FURNISH AND INSTALL ADEQUATE SHORING, BRACING, ETC. REQUIRED TO SAFELY EXECUTE ALL WORK AND SHALL BE FULLY RESPONSIBLE FOR THE SAME.
- 4. DETAILS AND CONDITIONS NOT SPECIFICALLY SHOWN SHALL BE CONSTRUCTED IN ACCORDANCE WITH DETAILS SHOWN FOR SIMILAR CONDITIONS AND MATERIAL
- 5. THE STRUCTURAL DRAWING SHALL BE READ IN CONJUNCTION WITH THE SPECIFICATIONS AND ALL OTHER DRAWINGS RELATED TO WORK.
- 6. NOTES AND DETAILS ON DRAWINGS SHALL TAKE PRECEDENCE OVER THESE GENERAL NOTES. 7. THE ENGINEER HAS NOT CONSIDERED VIBRATION EFFECTS OF MECHANICAL EQUIPMENT.
- 8. THE ENGINEER HAS NOT DESIGNED CONCRETE SLAB ON GRADE.
- 9. IT SHALL BE THE RESPONSIBILITY OF THE CONTRACTOR TO LOCATE ALL EXISTING UTILITIES WHETHER SHOWN HEREON OR NOT AND TO PROTECT THEM FROM DAMAGE. THE CONTRACTOR SHALL BEAR ALL EXPENSE OF REPAIR OR REPLACEMENT IN CONJUNCTION WITH THE PROSECUTION OF THIS WORK.
- 10. THE CONTRACTOR SHALL BE RESPONSIBLE FOR THE SAFETY OF THE BUILDING DURING CONSTRUCTION AND SHALL PROVIDE ADEQUATE SHORING, BRACING AND GUYS DURING CONSTRUCTION. SAFETY AND BRACING REQUIREMENTS SHALL BE IN ACCORDANCE WITH ALL NATIONAL, STATE AND LOCAL SAFETY ORDINANCES.
- 11. IN ALL CASES WHERE A CONFLICT MAY OCCUR, SUCH AS BETWEEN ITEMS COVERED IN SPECIFICATIONS AND NOTES ON THE DRAWINGS OR BETWEEN GENERAL NOTES AND SPECIFIC DETAILS, THE ARCHITECT SHALL BE NOTIFIED AND HE WILL INTERPRET THE INTENT OF THE
- 12. WHERE CONSTRUCTION MATERIALS ARE TEMPORARILY STORED ON ROOF OR FLOOR FRAMING, THEY SHALL BE DISTRIBUTED SO THAT THE LOADS DO NOT EXCEED THE DESIGN
- 13. THE CONTRACT DRAWINGS AND SPECIFICATIONS REPRESENT THE FINISHED STRUCTURE UNLESS OTHERWISE SHOWN, THEY DO NOT INDICATE THE METHOD OF CONSTRUCTION. THE CONTRACTOR SHALL SUPERVISE AND DIRECT THE WORK AND HE SHALL BE SOLELY RESPONSIBLE FOR ALL CONSTRUCTION MEANS, METHODS, TECHNIQUES, SEQUENCES AND PROCEDURES. OBSERVATION VISITS TO THE SITE BY FIELD REPRESENTATIVES OF THE ENGINEER SHALL NOT INCLUDE INSPECTIONS OF THE PROTECTIVE MEASURES OR THE CONSTRUCTION PROCEDURES REQUIRED FOR IT. ANY SUPPORT SERVICES PERFORMED BY THE ENGINEER DURING CONSTRUCTION SHALL BE DISTINGUISHED FROM CONTINUOUS AND DETAILED INSPECTION SERVICES. WHICH ARE FURNISHED BY OTHERS. THESE SUPPORT SERVICES PERFORMED BY THE ENGINEER, WHETHER OF MATERIAL OR WORK, AND WHETHER PERFORMED PRIOR TO, DURING, OR AFTER COMPLETION OF CONSTRUCTION ARE PERFORMED SOLELY FOR THE PURPOSE OF ASSISTING IN QUALITY CONTROL AND IN ACHIEVING CONFORMANCE WITH CONTRACT DRAWINGS AND SPECIFICATIONS, BUT THEY DO NOT GUARANTEE CONTRACTOR'S PERFORMANCE AND SHALL NOT BE CONSTRUED AS SUPERVISION OF CONSTRUCTION
- 14. SEE ARCHITECTURAL DRAWINGS FOR THE FOLLOWING: SIZE AND LOCATION OF ALL DOOR AND WINDOW OPENINGS, EXCEPT AS NOTED. SIZE AND LOCATION OF INTERIOR AND EXTERIOR NON-BEARING PARTITIONS. SIZE AND LOCATION OF ALL CONCRETE CURBS, FLOOR DRAINS SLOPES DEPRESSED AREAS CHANGES IN LEVEL CHAMFERS GROOVES INSERTS ETC. SIZE AND LOCATION OF ALL FLOOR AND ROOF OPENINGS EXCEPT AS SHOWN. FLOOR AND ROOF FINISHES. STAIR FRAMING AND DETAILS (EXCEPT AS SHOWN), DIMENSIONS NOT SHOWN ON STRUCTURAL DRAWINGS.
- 15. SEE MECHANICAL, PLUMBING, AND ELECTRICAL DRAWINGS FOR THE FOLLOWING: PIPE RUNS, SLEEVES, HANGERS, TRENCHES, WALL AND SLAB OPENINGS, ETC. (EXCEPT AS SHOWN OR NOTED), ELECTRIC CONDUIT RUNS, BOXES, OUTLETS IN WALLS AND SLABS. CONCRETE INSERTS FOR ELECTRICAL, MECHANICAL OR PLUMBING FIXTURES. SIZE AND, LOCATION OF MACHINE OR EQUIPMENT BASES, ANCHOR BOLTS FOR MOTOR MOUNTS.
- 16. CONTRACTOR SHALL INVESTIGATE SITE DURING CLEARING AND EARTHWORK OPERATIONS FOR FILLED EXCAVATIONS OR BURIED STRUCTURES SUCH AS CESSPOOLS, CISTERNS, FOUNDATIONS, ETC. IF ANY SUCH STRUCTURES ARE FOUND, ENGINEER SHALL BE NOTIFIED IMMEDIATELY.
- 17. OPENINGS, POCKETS, ETC. LARGER THAN 6 INCHES SHALL NOT BE PLACED IN CONCRETE SLABS, DECK BEAMS, JOISTS, COLUMNS, WALLS ETC., UNLESS SPECIFICALLY DETAILED ON THE STRUCTURAL DRAWINGS. NOTIFY THE ENGINEER WHEN DRAWINGS BY OTHERS SHOW OPENINGS, POCKETS, ETC. LARGER THAN 6 INCHES NOT SHOWN ON THE STRUCTURAL DRAWINGS, BUT WHICH ARE LOCATED IN STRUCTURAL MEMBERS
- 18. DESIGN, MATERIALS, EQUIPMENT, AND PRODUCTS OTHER THAN THOSE INDICATED ON THE DRAWINGS MAY BE CONSIDERED FOR USE, PROVIDED PRIOR APPROVAL IS OBTAINED FROM THE OWNER, ENGINEER, AND THE APPLICABLE GOVERNING CODE AUTHORITY.
- 19. ALL RETAINING WALLS SHALL BE ADEQUATELY SHORED DURING BACK FILLING. 20. STRUCTURAL OBSERVATIONS PERFORMED BY ARCHITECT/ENGINEER DURING CONSTRUCTION ARE NOT THE CONTINUOUS AND SPECIAL INSPECTION SERVICES AND DO NOT WAIVE THE RESPONSIBILITY FOR THE INSPECTIONS REQUIRED OF THE BUILDING INSPECTOR OR THE DEPUTY INSPECTOR. OBSERVATIONS ALSO DO NOT GUARANTEE CONTRACTOR'S PERFORMANCE AND SHALL NOT BE CONSIDERED AS SUPERVISION OF CONSTRUCTION.
- 21. APPROVAL BY THE INSPECTOR DOES NOT MEAN APPROVAL OF FAILURE TO COMPLY WITH THE PLANS OR SPECIFICATIONS. ANY DETAIL WHICH FAILS TO BE CLEAR OR IS AMBIGUOUS MUST BE REFERRED TO THE ENGINEER FOR INTERPRETATION OR CLARIFICATION.
- 22. SEWER AND UTILITY LINES ARE NOT INDICATED ON STRUCTURAL DRAWINGS FOR THEIR LOCATION, PROFILE AND DETAILS. THE CONTRACTOR MUST COORDINATE SEWER AND UTILITY LINES WITH FOUNDATIONS SHOWN ON STRUCTURAL DRAWINGS. ANY INTERFERENCE BETWEEN SEWER AND UTILITY LINES SHALL BE BROUGHT TO THE ATTENTION OF THE ENGINEER BEFORE PROCEEDING FURTHER WITH THE CONSTRUCTION.
- 23. THE CONTRACTOR SHALL FIELD-VERIFY ALL DIMENSIONS, ELEVATIONS, FOUNDATION TYPE. AND EXISTING FRAMING CONDITIONS PRIOR TO CONSTRUCTION. NOTIFY THE ENGINEER IF DISCREPANCIES WITH THE DRAWINGS ARE DISCOVERED.

# SHEAR WALL HOLD-DOWNS:

- THE CONCRETE CONTRACTOR IS TO VERIFY LOCATION OF HOLD-DOWNS AND ANCHOR BOLTS WITH ROUGH FRAMING TO ASSURE PROPER AND ACCURATE INSTALLATION, WITH THE FRAMING CONTRACTOR.
- 2. ALL 'HDU' HOLD-DOWNS ARE TO BE INSTALLED ACCORDING TO SIMPSON STRONG-TIE SPECIFICATIONS AND REQUIREMENTS OF ICC-ES# ESR-2330 AND LARR# 25720.
- 3. 'HDU' HOLD-DOWNS SHALL BE INSTALLED IN FOOTINGS HAVING A MINIMUM WIDTH OF AT
- LEAST 8" (U.N.O.) 4. ALL HOLD-DOWN ANCHORS MUST BE TIED IN PLACE PRIOR TO FOUNDATION INSPECTION.
- 5. POWER DRIVEN STEEL ANCHORS SHALL NOT PENETRATE INTO POST-TENSIONED ELEMENT A DISTANCE GREATER THAN THE MINIMUM COVER OF THE TENDONS.

# **FOUNDATIONS**

COMPACTED-FILL

- FOUNDATIONS SHALL BE OF THE SIZE AND TYPE AS INDICATED ON THE DRAWINGS. 2. FOOTINGS ARE TO BE CARRIED A MINIMUM OF 24" INTO FIRM UNDISTURBED, NATURAL SOIL OR APPROVED
- 3. DESIGN BEARING PRESSURE IS 1500 PSF IN UNDISTURBED NATURAL SOIL PER TABLE 1806.2. 4. DESIGN LATERAL BEARING PRESSURE IS 200 PSF./FT WITH A 33% INCREASED FOR SHORT-TERM LOADING, THE FOOTINGS OF THE PROPOSED STRUCTURES SHALL BE SUPPORTED COMPLETELY BY A UNIFORM THICKNESS OF NON-EXPANSIVE COMPACTED SOIL. THE STRUCTURES SHALL NOT BE SUPPORTED OVER A CUT/FILL TRANSITION
- . CONTRACTOR TO PROVIDE FOR DE-WATERING OF EXCAVATIONS FROM EITHER SURFACE WATER, GROUND WATER OR SEEPAGE.
- 3. ALL EXCAVATIONS SHALL BE PROPERLY BACK FILLED. DO NOT PLACE BACKFILL BEHIND RETAINING WALLS BEFORE CONCRETE HAS ATTAINED FULL DESIGN STRENGTH. CONTRACTOR SHALL BRACE OR PROTECT ALL INSTALLATION OF SUCH BRACING.
- ALL ABANDONED FOOTINGS, UTILITIES, ETC., THAT INTERFERE WITH NEW CONSTRUCTION SHALL BE REMOVED. NEW FOOTINGS MUST EXTEND INTO UNDISTURBED SOILS.
- FOUNDATION PLATES OR SILLS SHALL BE BOLTED TO THE FOUNDATION OR FOUNDATION WALL WITH NOT LESS THAN 5/8" NOMINAL DIAMETER STEEL BOLTS EMBEDDED AT LEAST 7" INTO THE CONCRETE OR MASONRY AND SPACED NOT MORE THAN 4'-0" APART. THERE SHALL BE A MINIMUM OF TWO BOLTS PER PIECE WITH ONE BOLT LOCATED WITHIN 12" OF EACH END OF EACH PIECE. A PROPERLY SIZED NUT AND WASHER SHALL BE TIGHTENED ON EACH BOLT TO THE PLATE, USE 3"x3"x0.229 SQUARE WASHER SPECIFIED IN SECTION 2306. ALL INTERIOR NON-SHEAR WALLS TO HAVE HILTI X-CR (WITH A MINIMUM PENETRATION OF 1-1/4" INTO SLAB) AT 24" ON CENTER, UNLESS NOTED OTHERWISE, TO BE INSTALLED IN ACCORDANCE WITH ICC ES# ESR-1663 AND LARR# 25646. ACTUAL SLAB THICKNESS TO BE MINIMUM OF  $3\frac{1}{2}$ ".
- ). CONTINUOUS FOOTING IN ADDITION (1) #4 BAR EXTRA FOR ELECTRICAL GROUND. LOCATION TO BE VERIFIED WITH ELECTRICAL CONTRACTOR.
- PROVIDE 2-#4 REINFORCING BAR TOP & BOTTOM OF ALL CONTINUOUS FOOTINGS.
- 11. FOUNDATION SILL SHALL BE NATURALLY DURABLE OR PRESERVATIVE-TREATED WOOD. (2304.12.1.4)

# **CONCRETE**

GREATER THAN 2500 PSI.

- 1. THE MINIMUM ULTIMATE COMPRESSIVE STRENGTH AT 28 DAYS SHALL BE 2500 PSI.
- 2. ALL CEMENT USED SHALL CONFORM TO A.S.T.M. C-150
- 3. FINE AND COARSE AGGREGATE SHALL CONFORM TO A.S.T.M. C-33.
- 4. ALL CONCRETE UNLESS OTHERWISE NOTED ON PLANS WILL BE REGULAR WEIGHT HARD ROCK TYPE (150 LB./CU.FT.) AGGREGATE SHALL CONFORM TO A.S.T.M. C-33 WITH PROVEN SHRINKAGE CHARACTERISTICS PER A.S.T.M. C-157.
- 5. MAXIMUM SLUMP OF CONCRETE USED IN FLOOR SLAB AT FLAT WORK SHALL BE FOUR (4") INCHES.
- 6. VIBRATION: VIBRATION OF CONCRETE SHALL BE IN ACCORDANCE WITH GENERAL PROVISION OUTLINED IN PORTLAND CEMENT ASSOCIATION SPECIFICATIONS ST26.
- CURING: CONCRETE SHALL BE MAINTAINED IN MOIST CONDITION FOR A MINIMUM OF FIVE (5) DAYS AFTER ITS PLACEMENT. APPROVED CURING COMPOUND MAY BE USED IN LIEU OF MOIST CURING.
- 3. STRENGTH TEST OF CONCRETE SHALL BE REQUIRED AS PER CODE AND OUTLINED IN SPECIFICATION  $\,$  REPORT SHALL BE FORWARDED TO THE STRUCTURAL ENGINEER.
- ANCHOR BOLTS, DOWELS, INSERT, ETC. SHALL BE SECURELY TIED IN PLACE PRIOR TO POURING CONCRETE. 10. THE ENGINEER MUST APPROVE LOCATION OF CONSTRUCTION OR POUR JOINTS.
- 11. PIPES OR DUCTS EXCEEDING ONE THIRD THE SLAB, OR WALL THICKNESS SHALL NOT BE PLACED IN STRUCTURAL CONCRETE UNLESS SPECIFICALLY DETAILED. SEE MECHANICAL AND/OR ELECTRICAL DRAWINGS FOR LOCATION OF SLEEVES, ACCESSORIES ETC.
- 12. PIPES MAY PASS THROUGH STRUCTURAL CONCRETE IN SLEEVES, BUT SHALL NOT BE EMBEDDED THEREIN.
- 13. PROVIDE 3/4 INCH CHAMFER AT ALL EXPOSED CORNERS. 14. REFER TO ARCHITECTURAL DRAWINGS FOR MOLDS, GROOVES, ORNAMENTS, CLIPS, OR GROUNDS REQUIRED
- TO BE CAST IN CONCRETE. AND FOR LOCATIONS OF FLOOR FINISHED AND SLAB DEPRESSIONS 15. CONTINUOUS INSPECTION BY A DEPUTY INSPECTOR IS REQUIRED FOR ALL CONCRETE DESIGNED WITH F'C

# ADHESIVE AND EXPANSION ANCHORS

- . MECHANICAL ANCHORS INTO CONCRETE: HILTI KWIK BOLT TZ (LARR #25701; ICC ES #ESR-1917) OR ITW RAMSET/ RED HEAD TRUBOLT WEDGE (LARR #2748; ICBO ES #ER-1372).
- 2. ADHESIVE ANCHORS AND DOWELS INSTALLED INTO CONCRETE AND GROUT-FILLED MASONRY UNITS: CIA-GEL 7000 BY COVERT OPERATIONS (LARR #25113), HIT HY-150 BY HILTI (LARR #25257), OR EPOXY-TIE 'SET-XP' ANCHOR SYSTEM BY SIMPSON STRONG-TIE (LARR #25744; ICC ES #ESR-2508).
- . ADHESIVE ANCHORS AND DOWELS INSTALLED INTO HOLLOW MASONRY UNITS AND UNREINFORCED BRICK MASONRY (URM): CIA-GEL 7000 BY COVERT OPERATIONS(LARR #25113), HIT HY-20 BY HILTI (LARR #24564), OR EPOXY-TIE 'SET-XP' ADHESIVE ANCHOR SYSTEM BY SIMPSON STRONG-TIE (LARR #25744; ICC ES #ESR-2508). USE SCREENS AS SPECIFIED BY THE MANUFACTURER.
- . MECHANICAL FASTENERS: STAINLESS STEEL FOR EXTERIOR USE OR WHEN EXPOSED TO WEATHER. PROVIDE GALVANIZED CARBON STEEL ANCHORS AT OTHER LOCATIONS, UNLESS OTHERWISE NOTED.
- . ADHESIVE ANCHORS: ASTM A36 THREADED RODS WITH ASTM A 563 GRADE A NUTS AND ANSI B18.22.1 TYPE A WASHERS, UNLESS OTHERWISE NOTED. ANCHORS DESIGNATED AS ASTM A193 GRADE B7 THREADED RODS TO USE ASTM A 563 GRADE DH HEAVY HEX NUTS AND ASTM F 436 WASHERS. ADHESIVE DOWELS: ASTM A615 GRADE 60 REINFORCING STEEL.
- 7. ALL ANCHORS SHALL BE INSTALLED IN ACCORDANCE WITH ICBO AND COLA REPORT AND MANUFACTURERS RECOMMENDATIONS.
- 8. UNLESS OTHERWISE NOTED, PROVIDE MINIMUM EMBEDMENT OF ANCHORS PER ICBO, COLA REPORTS &
- MANUFACTURERS RECOMMENDATIONS.
- . PRIOR TO ALL DRILLING OR CORING, THE CONTRACTOR SHALL (1) VERIFY THE EXISTING CONCRETE OR MASONRY THICKNESS TO PREVENT DAMAGE TO THE OPPOSITE FACE OF CONCRETE AND MAINTAIN 1-1/2" CLEAR COVER U.N.O., AND (2) IDENTIFY EXISTING REINFORCING LOCATIONS BY PACHHOMETER, PROBING, CHIPPING, ETC. TO AVOID DAMAGE EXISTING REINFORCING.
- 0. IF REINFORCEMENT IS ENCOUNTERED DURING DRILLING, ABANDON AND SHIFT THE HOLE LOCATION TO AVOID THE REINFORCEMENT. PROVIDE A MINIMUM OF 2 ANCHOR DIAMETERS OR 1 INCH, WHICHEVER IS LARGER, OF SOUND CONCRETE BETWEEN THE DOWEL AND THE ABANDONED HOLE. FILL THE ABANDONED HOLE WITH NON-SHRINK GROUT. IF THE ANCHOR OR DOWEL MAY NOT BE SHIFTED AS NOTED ABOVE, THE ENGINEER WILL DETERMINE A NEW LOCATION.

# STRUCTURAL SHEATHING

- I. ALL PLYWOOD SHALL BE APA RATED SHEATHING WITH EXTERIOR GLUE AND SHALL BEAR THE STAMP OF AN APPROVED TESTING AGENCY. LAY PLYWOOD WITH FACE GRAIN PERPENDICULAR TO SUPPORTS. USE A MINIMUM OF 4-PLY SHEATHING. STAGGER JOINTS AND NAILS.
- . DIAPHRAGM SHEATHING NAILS OR OTHER APPROVED SHEATHING CONNECTORS SHALL BE DRIVEN SO THAT THEIR HEAD OR CROWN IS FLSH WITH THE SURFACE OF THE SHEATHING.
- . ROOF SHEATHING; ½ APA RATED SHEATHING SPAN RATING 40/20, UNBLOCKED WITH 10d COMMON NAILS AT 6" O.C. ALL BOUNDARIES AND SUPPORTED PANEL EDGES 12, UNLESS NOTED OTHERWISE ON PLAN.
- 4. FLOOR/DECK SHEATHING: 3/4" APA RATED STURDI-I-FLOOR SPAN RATING 24 GLUED AND NAILED, WITH 10d COMMON NAILS AT 6 PANEL EDGES, 12" O.C. FIELD NAILING, UNLESS NOTED OTHERWISE ON PLAN. i. SHEAR WALL SHEATHING: STRUCTURAL I RATED SHEATHING BLOCKED WITH THE NAILING PER SHEAR WALL
- SCHEDULE. 6. PLYWOOD PANELS TO BE SPACED WITH 1/8" GAP AT WALL CONSTRUCTION.
- . ALL DECKS SHALL BE SHEATHED WITH EXTERIOR GRADE PLYWOOD AND SCREWED BLOCKING IS REQUIRED WITH "Z" CLIPS AND FASTENER CONNECTIONS PER 2022 CBC TABLE 2304.10.1.

# **WOOD FRAME**

- . ALL WOOD SHALL CONFORM TO THE CHAPTER 23OF C.B.C AND 2018 NDS. ALL STRUCTURAL FRAMING MEMBERS SHALL BE GRADE MARKED DOUGLAS FIR AS FOLLOWS UNLESS NOTED OTHERWISE ON PLANS (MOISTURE 19% MAXIMUM)
- 2X RAFTERS AND JOISTS (U.O.N.) .NO. 2 ALL 4x10 AND LARGER HORIZONTAL FRAMING MEMBERS. ...NO. 1 ..NO. 2 4X BEAMS AND HEADERS 6X BEAMS AND STRINGERS. ..NO. 1 LAMINATED BEAMS

.24F-V3, V4 OR V8 FOR CANTILEVER POSTS AND TIMBER. NO 1 .NO. 2 OR BETTER U.O.N. ALL STUDS AND BRACES.. NON-BEARING WALL STUDS, PARTITION WALLS STUDS..

- GRADE AND SPECIES OF ALL LUMBER MUST BE GRADE MARKED, . ALL BOLTS SHALL BE STANDARD MACHINE BOLTS WITH STEEL PL WASHERS WHEN HEAD OR NUT BEARS ON WOOD. HOLES FOR BOLTS SHALL BE DRILLED WITH A BIT 1/32" LARGER THAN THE NOMINAL BOLT DIAMETER. TIGHTEN ALL BOLTS BEFORE PLASTERING.
- NOTCHING, BORING OF WOOD SHALL CONFORM THE LOCAL BUILDING CODE. DO NOT NOTCH JOISTS, RAFTERS OR BEAMS, EXCEPT WHERE SHOWN IN DETAILS. OBTAIN ENGINEER'S APPROVAL FOR ANY HOLES OR NOTCHES NOT DETAILED. HOLES THROUGH SILLS, PLATES, STUDS,

B. NO STRUCTURAL MEMBER SHALL BE CUT WITHOUT THE APPROVAL OF THE STRUCTURAL ENGINEER. ANY CUTTING,

- AND DOUBLE PLATES IN INTERIOR BEARING AND SHEAR WALLS SHALL NOT EXCEED 1/3 THE PLATE WIDTH. USE BORED HOLES LOCATED IN THE CENTER OF THE STUD OR PLATE.
- . TYPICAL SILL BOLTING SHALL BE 5/8" DIA. X 10" ANCHOR BOLTS AT 4'-0" O.C. PROVIDE ONE BOLTS WITHIN NINE INCHES OF EACH END OF EACH SILL PIECE AND AT CORNERS.
- i. UNLESS OTHERWISE NOTED ON PLANS, ALL STRUCTURAL PLYWOOD SHALL BE INTERIOR GRADE PLYWOOD WITH EXTERIOR GLUE. STRUCTURAL I CONFORMING TO DOC PS 10R PS2, LATEST EDITION.
- eta. ALL SILL PLATES RESTING ON CONCRETE OR MASONRY SHALL BE PRESSURE TREATED DOUGLAS FIR UTILITY GRADE OR FOUNDATION GRADE REDWOOD.
- . ALL LEDGER BOLTS SHALL BE SET IN WALLS TO INSURE PROPER ROOF SLOPE PER DRAINAGE PLAN. VERIFY ALL CONDI-TIONS PRIOR TO SETTING BOLTS.
- 8. LAG BOLTS AND SCREWS SHALL BE PREDRILLED. THE DIA. OF PREDRILLEDHOLES SHALL BE 60% OF SHANK DIAMETER. THE THREADED PORTION OF THE SCREW SHALL BE INSERTED BY TURNING WITH A WRENCH, NOT BY DRIVING WITH A
- HAMMER. PENETRATION OF THREADED PORTION SHALL BE 7 DIAMETER MINIMUM. . WHEN LAMINATING VERTICALLY 2-2" X MEMBERS TOGETHER, USE 16d NAILS AT 9" O.C. STAGGERED.
- 10. ALL HARDWARE CONNECTING WOOD MEMBERS SHALL BE RE-CESSED WHEN REQUIRED BY ARCHITECTURAL FINISH. VERIFY WITH ARCHITECTURAL PLANS, TYPICAL.
- FRAMING ANCHORS, JOIST HANGERS, POST CAPS, POST BASES, TIE DOWNS, ETC., SHALL BE AS MANUFACTURED BY "SIMPSON" OR AN APPROVED EQUAL
- 2. NOTCHING OF EXTERIOR AND BEARING/NON-BEARING WALLS STUDS SHALL NOT EXCEED 25%/40% RESPECTIVELY.
- BORED HOLES IN BEARING/NON-BEARING WALLS STUDS SHALL NOT EXCEED 40% / 60% RESPECTIVELY. 13. NAILING FOR DIAPHRAGMS AND FOR ALL SHEAR WALLS SHALL BE INSPECTED PRIOR TO COVERING.
- 14. STUDS IN EXTERIOR WALLS OR INTERIOR BEARING PARTITIONS SHALL BE CUT OR NOTCHED NO MORE
- THAN 25% OF THEIR WIDTH. INTERIOR NON-BEARING PARTITIONS MAY BE NOTCHED 40% OF THEIR WIDTH. 5. BORED HOLES IN ANY STUD SHALL BE LIMITED TO 40% OF THEIR WIDTH AND SHALL BE LOCATED AT LEAST 5/8" FROM THE
- 6. A REGISTERED STAMP OR BRAND OF THE DOUGLAS FIR PLYWOOD ASSOCIATION SHALL IDENTIFY EACH SHEET OF
- 7. TOP PLATE OF ALL STUD WALLS SHALL BE 2 PIECES THE SAME SIZE AS STUDS. SPLICES TO LAP 4'-O' MINIMUM AND BE NAILED WITH 12-16D MINIMUM EACH SIDE OF JOINT.
- 18. EDGES OF ALL OPENINGS THROUGH THE ROOF SHALL BE NAILED PER BOUNDARY OF PLYWOOD DIAPHRAGM NAILING 9. PROVIDE LX6 DIAGONAL LET-IN BRACING (AT APPROX. 45 DEGREE) EVERY 25'-O' MAXIMUM IN ALL STUD WALLS NOT
- PLYWOOD SHEATHED. BRACING SHALL RUN CONTINUOUS FROM SILL PLATE TO TOP PLATE. NAIL WITH 2-8D PER STUD AND 3-10D EACH END TO PLATES.
- 20. PROVIDE FIRE STOPS AT ALL INTERSECTIONS OF STUD WALLS AT FLOOR, CEILING, AND ROOF. FIRE STOPS SHALL BE 2X NOMINAL THICKNESS OF WOOD AND SHALL BE THE FULL WIDTH OF THE ENCLOSED SPACE. PLACE FIRE STOPS AT A MAXIMUM SPACING OF 8'-0" IN THE VERTICAL DIRECTION. PROVIDE 2X FIRE STOPS IN ALL FURRED SPACES, VERTICAL AND HORIZONTAL. AND AT THE SAME LINES AS FIRE STOPS IN ADJACENT STUD WALLS.
- 1. PROVIDE 2X SOLID BLOCKING BETWEEN JOISTS AND RAFTERS AT ALL SUPPORTS. BLOCKING SHALL BE ONE PIECE AND THE FULL DEPTH OF THE JOIST OR RAFTER.
- 22. ALL STUD PARTITIONS OR WALLS OVER 10-FT. HEIGHT SHALL HAVE 2X BRIDGING, SAME WIDTH AS THE STUD, PREFERABLY AT MID-HEIGHT BUT NOT TO EXCEED INTERVALS OF 8 FT.
- CROSS BRIDGING SHALL BE PROVIDED AT 8'-O" O.C. MAXIMUM FOR ALL JOISTS AND RAFTERS MORE THAN 8" DEEP. 24. PROVIDE DOUBLE JOISTS UNDER PARTITIONS, WHICH ARE PARALLEL TO THE JOISTS. 25. BOLTS SHALL BE PLACED 9 INCHES FROM THE END OF A PLATE, OR FROM A NOTCH GREATER THAN 1/2 THE WIDTH OF A
- PLATE, AND SPACED AT INTERVALS NOTED. 26. MAXIMUM MOISTURE CONTENT OF WOOD SHALL BE VERIFIED AS 19% OR LESS BEFORE BEING COVERED WITH
- INSULATION, INTERIOR WALL FINISH AND FLOOR COVERING OF OTHER MATERIALS. (NDS 4.1.1 & CALGREEN 4.505.3) 7. EXTERIOR TREATED SOLID SAWN OR GLULAM BEAMS THAT HAVE BEEN NOTCHED OR BORED SHALL BE FIELD TREATED WITH COPPER NAPTHENATE OR EQUIVALENT EXTERIOR GRADE TREATMENT.

# REINFORCING STEEL

- . ALL REINFORCING SHALL CONFORM TO ASTM A615, 60 KSI UNLESS OTHERWISE NOTED.
- 2. REINFORCING BARS SHALL HAVE THE FOLLOWING MINIMUM COVERAGE. PLACE BARS AS NEAR TO THE CONCRETE SURFACE AS THESE MINIMUMS PERMIT WHEREVER POSSIBLE UNLESS NOTED OTHERWISE:

MIN. CONCRETE COVER CONCRETE POURED AGAINST EARTH FORMED CONCRETE IN CONTACT WITH EARTH EXPOSED TO WEATHER (#6 AND LARGER) EXPOSED TO WEATHER (#5 AND SMALLER) 1-1/2" SLABS & WALLS NOT EXPOSED TO WEATHER

- NOT EXPOSED TO WEATHER .  $\,$  #5 AND LARGER REINFORCING BARS SHALL NOT BE SPLICED EXCEPT AS LOCATED AND DETAILED ON THE DRAWINGS. #4 AND SMALLER BARS WITH LENGTH NOT SHOWN SHALL BE CONTINUOUS, LAPPING 1'-6" MINIMUM IN CONCRETE (SEE TYPICAL DETAILS). HORIZONTAL WALL SPLICES SHALL BE STAGGERED. VERTICAL BARS SHALL NOT BE SPLICED EXCEPT AT HORIZONTAL SUPPORT, SUCH AS FLOOR OR ROOF, UNLESS DETAILED OTHERWISE. ALL BARS ENDING AT THE FACE OF A WALL, COLUMN, OR BEAM SHALL EXTEND TO WITHIN 2" OF THE FAR FACE AND HAVE A 90 DEGREE HOOK UNLESS OTHERWISE SHOWN.
- . BARS SHALL BE FIRMLY SUPPORTED AND ACCURATELY PLACED AS REQUIRED BY THE A.C.I. STANDARDS, USING TIE AND SUPPORT BARS IN ADDITION TO REINFORCEMENT SHOWN WHERE NECESSARY FOR FIRM AND ACCURATE PLACING. ALL DOWELS SHALL BE ACCURATELY SET IN PLACE BEFORE PLACING CONCRETE.
- 5. DRAWINGS SHOW TYPICAL REINFORCING CONDITIONS. CONTRACTOR SHALL PREPARE DETAILED PLACEMENT DRAWINGS OF ALL CONDITIONS SHOWING QUANTITY, SPACING, SIZE, CLEARANCES, LAPS, INTERSECTIONS AND COVERAGE REQUIRED BY STRUCTURAL DETAILS, APPLICABLE CODE AND TRADE STANDARDS. CONTRACTOR SHALL NOTIFY REINFORCING INSPECTOR OF ANY ADJUSTMENTS FROM TYPICAL CONDITIONS THAT ARE PROPOSED IN
- 3. NO WELDING OF REINFORCEMENT (INCLUDING TACK WELDING) SHALL BE DONE UNLESS SHOWN ON THE DRAWINGS. WHERE SHOWN ON THE DRAWINGS, WELDING OF REINFORCING STEEL SHALL BE PERFORMED BY WELDERS SPECIFICALLY CERTIFIED FOR REINFORCING STEEL. USE E90XX ELECTRODES.

PLACEMENT DRAWINGS TO FACILITATE FIELD PLACEMENT OF REINFORCING STEEL AND CONCRETE.

# ENGINEERED WOOD PRODUCTS

- "PARALLAM" PSL, "TIMBERSTRAND" LSL, AND "MICROLAM" LVL SHALL BE DESIGNED, DETAILED AND MANUFACTURED BY TRUSS JOIST WEYERHAEUSER, AND SHALL BE IN CONFORMANCE WITH ICC ES ESR-1387 AND CITY OF L.A. LARR # 25202.
- DESIGN STRESS REQUIREMENTS SHALL BE AS FOLLOWS:

| GRADE              | E (PSI)   | Fb (PSI) | Fv (PSI) | Fc (perp) (PSI) | Fc (paral) (PSI) |
|--------------------|-----------|----------|----------|-----------------|------------------|
| TIMBERSTRAND (LSL) | 1,550,000 | 2,325    | 310      | 900             | 2,170            |
| MICROLAM<br>(LVL)  | 2,000,000 | 2,600    | 285      | 750             | 2,510            |
| PARALLAM<br>(PSL)  | 2,000,000 | 2,900    | 290      | 625             | 2,900            |

REFER TO WOOD GENERAL NOTES FOR ADDITIONAL INFORMATION

# **DESIGN CRITERIA**

BUILDING CODE: ALL WORK SHALL CONFORM TO THE MINIMUM REQUIREMENTS OF THE LATEST EDITION OF THE

UNIFORM BUILDING CODES, 2022 CBC & 2021 IBC. 2. VERTICAL LOADS - (UNLESS OTHERWISE NOTED ON DRAWINGS)

LIVE LOAD DEAD LOAD ROOF 16.5 PSF 20 PSF CEILING 10 PSF 6 PSF FLOOR 40 PSF 18 PSF EXT. WALL DL 18 PSF INT. WALL DL 10 PSF

. LATERAL LOADS

A. WIND . 92 MPH BASIC WIND, EXPOSURE C B. SEISMIC IMPORTANCE FACTOR.

C. OCCUPANCY CATEGORY... II (RESIDENTIAL) D. MAPPED SPECTRAL RESPONSE ACCELERATION

Ss =1.740 S1 =0.660 D-DEFAULT

SDS =1.392 SD1 =0.748

E. SITE CLASS.. F. SPECTRAL RESPONSE COEFFICIENT

G. SEISMIC DESIGN CATEGORY....

H. BASIC SEISMIC-FORCE-RESISTING SYSTEM... LIGHT-FRAMED WALLS WITH WOOD STRUCTURAL PANELS I. DESIGN BASE SHEAR.. - 8.7 KIPS <del>/ - </del> (44.4 KIPS) J. TOTAL WEIGHT OF BUILDING.

L. RESPONSE MODIFICATION FACTOR (R)....... 6.5 **EQUIVALENT LATERAL FORCE ASCE 7-16-12.8** M. ANALYSIS PROCEDURE USED.

O. SOIL PROFILE TYPE . CLASS D-DEFAULT

K. SEISMIC RESPONSE COEFFICIENT (Cs)....... 0.195 (ASD)

MAX

M.B.

SD-5

SD-6

N. REDUNDANCY FACTOR USED...

**ABBREVIATIONS** MFR MANUFACTURER MIN MINIMUM MISC MISCELLANEOUS ANCHOR BOLT (N) NEW ARCHITECT(URAL NHR NO HOLDWON REQUIRED ARCH **BOUNDARY NAIL** NTS CEILING BEAM O.C.

NOT TO SCALE B.N. ON CENTER CB PLYWD PLYWOOD CEILING JOIST C/J DOUBLE POUNDS PER LINEAR FOOT DBL DIAMETER POUNDS PER SQUARE FOOT DIA **EXISTING** PTDF PRESSURE TREATED DOUGLAS FIR (E) FACH RB **ROOF BEAM EDGE NAILING** REQD REQUIRED E.N. EXTERIOR EXT SEW SHEAR ENTIRE WALL FIELD NAILING SHTG SHEATHING F.N.

FOOT (FEET) SPEC SPECIFICATION(S) HOT DIPPED GALVANIZED STD HDG STANDARD HEADER STL HDR STEEL INCHES T.N. TOE NAILING INTERIOR TYP INT TYPICAL

POUND(S) U.O.N. UNLESS OTHERWISE NOTED MAXIMUM V.I.F. VERIFY IN FIELD MACHINE BOLT

STRUCTURAL PLANS - SHEET INDEX

Structural Notes S-1 S-1.1 Nailing Schedule & Additional Notes

S**-**2 Foundation Plan S**-**3 Ceiling Framing Plan S-4 Roof Framing Plan

SD-1 Typical Details Typical Details SD-1.1 Structural Details SD-2

Structural Details SD-3 SD-4 Structural Details

Structural Details

Structural Details

CITY STAMP


**REVISIONS** 

↑ PLAN CHECK REVISION 11 DATE: 07/22/2025 ARCH UPDATE

/2\ DATE: 08/11/2025 CITY CORRECTION DATE: 09/05/2025

▲ ARCH UPDATE /4\ DATE: 10/08/2025



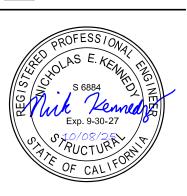

nick.kennedy@anuradesign.com Cell-530.859.8843

> $\Box$  $\tilde{\Theta}$

CA563 CHECKED BY CA562

10/08/2025

SCALE

# SPECIAL INSPECTION NOTES

- . PROVIDE SPECIAL INSPECTIONS IN ACCORDANCE WITH THE BELOW NOTED SECTION OF THE 2022 CALIFORNIA BUILDING CODE.
- 2. WHERE SPECIAL INSPECTION IS REQUIRED, IT SHALL BE PERFORMED BY A REGISTERED DEPUTY INSPECTOR EMPLOYED BY THE OWNER AND APPROVED GOVERNING JURISDICTION. COPIES OF THE INSPECTION REPORTS SHALL BE SUBMITTED TO THE BUILDING DEPARTMENT AND ENGINEER FOR REVIEW.
- 3. A CERTIFICATE OF SATISFACTORY COMPLETION OF WORK REQUIRING SPECIAL INSPECTION MUST BE COMPLETED AND SUBMITTED TO THE INSPECTION SERVICES DIVISION.
- 4. THE ITEMS LISTED ARE IN ADDITION TO THOSE REQUIRED BY THE BUILDING DEPARTMENT
- 5. THE SPECIAL INSPECTOR AND TESTING LABORATORY MUST BE APPROVED BY THE LOCAL JURISDICTION
- 6. A PROPERTY OWNER'S FINAL REPORT OF WORK REQUIRING SPECIAL INSPECTION MUST BE COMPLETED BY THE PROPERTY OWNER, THE PROPERTY OWNER'S AGENT OF RECORD, OR THE ENGINEER OF RECORD AND SUBMITTED TO THE INSPECTION SERVICES DIVISION.
- 7. THE SPECIAL INSPECTIONS IDENTIFIED ARE IN ADDITION TO THOSE REQUIRED BY SECTION 108 OF THE BUILDING CODE, AS AMENDED. SPECIAL INSPECTION IS NOT A SUBSTITUTE FOR INSPECTION BY A LOCAL JURISDICTION
- INSPECTOR. 8. SOILS SPECIAL INSPECTION SHALL BE PERFORMED BY THE REGISTERED DESIGN PROFESSIONAL IN RESPONSIBLE CHARGE (SOILS ENGINEER OR GEOTECHNICAL ENGINEER OF RECORD), WHO HAS PREPARED THE APPROVED
- GEOTECHNICAL INVESTIGATION REPORT. 9. THE SPECIAL INSPECTOR MUST BE CERTIFIED BY THE LOCAL BUILDING OFFICIAL, DEVELOPMENT SERVICES, IN THE
- CATEGORY OF WORK REQUIRED TO HAVE SPECIAL INSPECTION. 10. FABRICATOR MUST BE REGISTERED AND APPROVED BY THE LOCAL BUILDING OFFICIAL, DEVELOPMENT SERVICES,
- FOR THE FABRICATION OF MEMBERS AND ASSEMBLIES ON THE PREMISES OF THE FABRICATORS SHOP. 11. FABRICATOR SHALL SUBMIT AN APPLICATION TO PERFORM OFF-SITE FABRICATION TO THE INSPECTION SERVICES DIVISION FOR APPROVAL PRIOR TO COMMENCEMENT OF FABRICATION.
- 12. FABRICATOR SHALL SUBMIT A CERTIFICATE OF COMPLIANCE FOR OFF-SITE FABRICATION TO THE INSPECTION
- SERVICES DIVISION FOR APPROVAL PRIOR TO ERECTION OF FABRICATED ITEMS AND ASSEMBLIES. 13. A PROPERTY OWNER'S FINAL REPORT FORM OF WORK REQUIRED TO HAVE SPECIAL INSPECTION, TESTING AND
- STRUCTURAL OBSERVATIONS MUST BE COMPLETED BY THE PROPERTY OWNER, PROPERTY OWNER 'S AGENT OF RECORD, ARCHITECT OF RECORD, ENGINEER OF RECORD AND SUBMITTED TO THE INSPECTION SERVICES DIVISION.
- 14. THE SPECIAL INSPECTIONS IDENTIFIED ON PLANS ARE, IN ADDITION TO, AND NOT A SUBSTITUTE FOR, THOSE INSPECTIONS REQUIRED TO BE PERFORMED BY A BUILDING INSPECTOR.
- 15. NOTICE TO THE APPLICANT/OWNER/OWNER'S AGENT/ARCHITECT OR ENGINEER OF RECORD: BY USING THIS PERMITTED CONSTRUCTION DRAWINGS FOR CONSTRUCTION/INSTALLATION OF THE WORK SPECIFIED HEREIN, YOU AGREE TO COMPLY WITH THE REQUIREMENTS OF THE LOCAL BUILDING OFFICIAL FOR SPECIAL INSPECTIONS, AND THOSE REQUIREMENTS REQUIRED BY THE CALIFORNIA CONSTRUCTION CODES.
- 16. NOTICE TO THE CONTRACTOR/BUILDER/INSTALLER/SUBCONTRACTOR/OWNER-BUILDER: BY USING THIS PERMITTED CONSTRUCTION DRAWINGS FOR CONSTRUCTION/INSTALLATION OF THE WORK SPECIFIED HEREIN, YOU ACKNOWLEDGE AND ARE AWARE OF, THE REQUIREMENTS CONTAINED IN THE STATEMENT OF SPECIAL INSPECTIONS. YOU AGREE TO COMPLY WITH THE REQUIREMENTS OF THE LOCAL BUILDING OFFICIAL FOR SPECIAL INSPECTIONS, STRUCTURAL OBSERVATIONS, CONSTRUCTION MATERIAL TESTING, AND OFF-SITE FABRICATION OF BUILDING COMPONENTS, CONTAINED IN THE STATEMENT OF SPECIAL INSPECTIONS AND, AS REQUIRED BY THE CALIFORNIA
- CONSTRUCTION CODES. 17. ITEMS REQUIRING SPECIAL INSPECTION:
- 1705.11.1 STRUCTURAL WOOD PERIODIC SPECIAL INSPECTION IS REQUIRED FOR NAILING, BOLTING, ANCHORING AND OTHER FASTENING OF ELEMENTS OF THE MAIN FORCE-RESISTING SYSTEM, INCLUDING WOOD SHEAR WALLS, WOOD DIAPHRAGMS, DRAG STRUTS, BRACES AND HOLD-DOWNS.
- 1705.3 POST-INSTALLED ANCHORS-PERIODIC SPECIAL INSPECTION IS REQUIRED FOR POST INSTALLED MECHANICAL AND ADHESIVE ANCHORS. ICC-ESR-4057 (CONCRETE). 1705.2.1, 1705.11.2, 1705.12.1.2 STRUCTURAL STEEL.
- 17.1 PROVIDE CONTINUOUS INSPECTION FOR THE FOLLOWING:
- DURING PLACING OF ALL STRUCTURAL CONCRETE F'C > 2500 PSI @ 28 DAYS
- DURING ALL STRUCTURAL STEEL WELDING
- DURING BOLTING WITH HIGH TENSILE BOLTS
- DURING INSTALLATION OF EXPANSION ANCHORS
- DURING INSTALLATION OF EPOXY ANCHORS / DOWELS JUST PRIOR TO PLACING CONCRETE FOUNDATIONS TO ENSURE SUBGRADE IS SUITABLE. FREE FROM LOOSE SOIL. AND FOUNDATIONS ARE OF PROPER DIMENSIONS - DURING INSTALLATION OF HOLD-DOWN ANCHORS AT PLYWOOD SHEAR WALLS.
- ROOF AND WALLS NAILING IN PROGRESS VISUAL INSPECTION PER AWS D1.1-94 IS REQUIRED FOR ALL WELDING(CUTOUTS, CLEAN-UP, ROOT PASSES, FILL-IN PASSES ETC.). WELDING INSPECTORS ARE TO BE AWS Q.C.-1 CERTIFIED. APPROVAL BY THE INSPECTOR DOES NOT MEAN APPROVAL OF FAILURE TO COMPLY WITH THE PLANS OR SPECIFICATIONS. ANY DETAIL WHICH FAILS TO BE CLEAR OR IS AMBIGUOUS MUST BE REFERRED TO THE ENGINEER
- FOR INTERPRETATION OR CLARIFICATION. 2. CONTINUOUS INSPECTION BY A INSPECTOR REQUIRED FOR EDGE DISTANCE OF ANCHOR BOLTS.
- 3. CONTRACTORS RESPONSIBLE FOR THE CONSTRUCTION OF A WIND OR SEISMIC FORCE RESISTING SYSTEM /COMPONENT\_LISTED IN THE "STATEMENT OF SPECIAL INSPECTION" SHALL SUBMIT A WRITTEN STATEMENT OF RESPONSIBILITY TO THE COUNTY INSPECTORS AND THE OWNER PRIOR TO THE COMMENCEMENT OF WORK ON SUCH SYSTEM OR COMPONENT PER SEC 1706.1
- CONTINUOUS SPECIAL INSPECTION BY A REGISTERED DEPUTY INSPECTOR IS REQUIRED FOR FIELD WELDING, CONCRETE STRENGTH F=C > 2500 PSI, SPRAYED ON FIRE FOOTING, ENGINEERING MASONRY, HIGH LIFT GROUTING, PRE-STRESSED CONCRETE, HIGH LOAD DIAPHRAGMS, SPECIAL MOMENT-RESISTING CONCRETE FRAMES.(1704 & CHAPTER 19,21&22)
- 5. PERIODIC SPECIAL INSPECTION IS REQUIRED FOR WOOD SHEAR WALLS, SHEAR PANELS, AND DIAPHRAGMS, INCLUDING NAILING, BOLTING, ANCHORING, AND OTHER FASTENING TO COMPONENTS OF THE SEISMIC FORCE RESISTING SYSTEM. SPECIAL INSPECTION BY A DEPUTY INSPECTOR IS REQUIRED WHERE THE FASTENER SPACING OF THE SHEATHING IS 4 INCHES OR LESS ON CENTER. (1707.3)

|    | ITEM                                   | CONTINUOUS<br>INSPECTION | PERIODIC<br>INSPECTION | REMARK   |
|----|--|--------------------------|------------------------|--|
|    | SLAB ON GRADE<br>(fc= 2500 PSI)        |                          | YES                    | PRIOR TO POURING OF CONCRETE & DURING THE TAKING OF TEST SPECIMENS |
|    | WALL, COLUMN FOOTING<br>(fc= 2500 PSI) |                          | YES                    | PRIOR TO POURING OF CONCRETE & DURING THE TAKING OF TEST SPECIMENS |
| E  | BOLTS IN CONCRETE (307)                |                          | YES                    | PRIOR TO & DURING THE PLACEMENT OF CONCRETE AROUND BOLTS           |
| PL | YWOOD SHEAR WALL AND<br>HOLDOWN        |                          | YES                    | PRIOR TO COVERING UP   |
| G  | RADING, EXCAVATION AND FILLING         | YES                      |                        | DURING EARTH-WORK EXCAVATION, GRADING AND FILLING.                 |

# CONNECTION HARDWARE

- 1. UNLESS NOTED OTHERWISE, ALL HANGERS, STRAPS, HOLDOWNS, AND MISCELLANEOUS STRUCTURAL CONNECTIONS SHALL BE SIMPSON STRONG-TIE OR AN ENGINEER-APPROVED EQUAL. SIMPSON STRONG-TIE CONNECTORS ARE REQUIRED TO MEET THE STRUCTURAL CALCULATIONS OF THE PLAN. BEFORE SUBSTITUTING ANOTHER BRAND, CONFIRM LOAD CAPACITY BASED ON RELIABLE PUBLISHED TESTING CENTER DATA OR CALCULATIONS. THE ENGINEER OF RECORD SHOULD EVALUATE AND GIVE WRITTEN APPROVAL FOR SUBSTITUTION PRIOR TO INSTALLATION.
- 2. ALL SPECIFIED FASTENERS MUST BE INSTALLED ACCORDING TO THE INSTRUCTIONS OF THE MOST RECENT EDITION OF "WOOD CONSTRUCTION CONNECTORS" PUBLISHED ANNUALLY BY SIMPSON STRONG-TIE, INC. INCORRECT FASTENER QUANTITY, SIZE, TYPE, MATERIAL, OR FINISH MAY CAUSE THE CONNECTION TO FAIL. 16d FASTENERS ARE COMMON NAILS (8GA x 3-1/2") AND CAN NOT BE REPLACED WITH 16d SINKERS (9GA x 3-1/4") FOR FULL LOAD VALUE UNLESS OTHERWISE SPECIFIED.
- 3. THE NUMBER AND SIZE OF FASTENERS CONNECTING WOOD MEMBERS SHALL NOT BE LESS THAN 2022 CBC TABLE 2304.10.1.
- 4. ALL CONNECTORS ARE TO BE FULLY NAILED OR BOLTED PER MANUFACTURER'S RECOMMENDATIONS.
- 5. BOLT HOLES SHALL BE A MINIMUM OF 1/32" AND NO MORE THAN 1/16" LARGER THAN THE BOLT DIAMETER (PER 2015 NDS)
- 6. INSTALL ALL SPECIFIED FASTENERS BEFORE LOADING THE CONNECTION.
- 7. NUTS SHALL CONFORM TO THE REQUIREMENTS OF ASTM A563, GRADE A. 8. ALL FASTENERS ARE RECOMMENDED TO BE USED IN DRY INTERIOR APPLICATIONS TO AVOID
- PREMATURE FAILURE. 9. FOR CONNECTORS AND FASTENERS IN PRESERVATIVE-TREATED AND FIRE-RETARDANT TREATED WOOD (FRTW), HOT DIPPED ZINC COATED GALVANIZED STEEL, STAINLESS STEEL, SILICON
- BRONZE, OR COPPER CONNECTIONS SHALL BE USED. 10.WELDING GALVANIZED STEEL MAY PRODUCE HARMFUL FUMES; FOLLOW PROPER WELDING PROCEDURES AND SAFETY PRECAUTIONS. WELDING SHOULD BE IN ACCORDANCE WITH AWS
- STANDARDS, UNLESS OTHERWISE NOTED, SIMPSON CONNECTORS CAN NOT BE WELDED. 11. PNEUMATIC NAIL TOOLS MAY BE USED TO INSTALL CONNECTORS, PROVIDED THE CORRECT QUANTITY AND TYPE OF NAILS ARE PROPERLY INSTALLED IN THE NAIL HOLES, FOLLOW THE
- OVER-DRIVING NAILS MUST BE AVOIDED AS IT MAY REDUCE ALLOWABLE LOADS. 12. JOISTS SHALL BEAR COMPLETELY ON THE CONNECTOR SEAT, AND THE GAP BETWEEN THE JOIST END AND THE HEADER SHALL NOT EXCEED 1/6" PER ASTM D1761-12 TEST STANDARDS.

MANUFACTURER'S INSTRUCTIONS AND USE THE APPROPRIATE SAFETY EQUIPMENT.

- 13. FOR HOLDOWNS, ANCHOR BOLT NUTS SHOULD BE FINGER-TIGHT PLUS A 1/3 TO 1/2 TURN WITH A WRENCH, WITH CONSIDERATION GIVEN TO WOOD SHRINKAGE. CARE SHOULD BE GIVEN TO NOT OVER-TORQUE THE NUT, AS THIS MIGHT PRELOAD THE HOLDOWN.
- 14. BARS, PLATES, ANCHOR BOLTS, WASHERS, AND DRIFT BOLTS SHALL CONFORM TO THE
- REQUIREMENTS OF ASTM A36. 15. ALL NAILS SHALL BE COMMONS.

TABLE R602.3(1)

# CALIFORNIA RESIDENTIAL CODE 2022

R602.3 Design and Construction Exterior walls of wood-frame construction shall be designed and constructed in accordance with the provisions of this chapter and Figures R602.3(1) and R602.3(2), or in accordance with AWC NDS. Components of exterior walls shall be fastened in accordance with Tables R602.3(1) through R602.3(4). Wall sheathing shall be fastened directly to framing members and, where placed on the exterior side of an exterior wall, shall be capable of resisting the wind pressures listed in Table R301.2.1(1) adjusted for height and exposure using Table R301.2.1(2) and shall conform to the requirements of Table R602.3(3). Wall sheathing used only for exterior wall covering purposes shall comply with Section R703. Studs shall be continuous from support at the sole plate to a support at the top plate to resist loads perpendicular to the wall. The support shall be a foundation or floor, ceiling or roof diaphragm or shall be designed in accordance with accepted engineering practice. Exception: Jack studs, trimmer studs and cripple studs at openings in walls that comply with Tables R602.7(1) and R602.7(2).

# FASTENING SCHEDULE

| ITEM | DESCRIPTION OF<br>BUILDING ELEMENTS  | NUMBER AND TYPE OF FASTENER a, b, c  | SPACING AND LOCATION  |  |  |  |
|------|--|--|---|--|--|--|
|      | Roof   |  |   |  |  |  |
|      | Blocking between ceiling joists,<br>rafters or trusses to top plate or<br>other framing below                    | 4-8d box (2.5" x 0.113") or<br>3-8d common (2.5" x 0.131") or<br>3-10d box (3" x 0.128") or<br>3-3" x 0.131" nails   |   |  |  |  |
| 1    | Blocking between rafters or<br>truss not at the wall top plates,<br>to rafter or truss                           | 2-8d common (2.5" x 0.131") or 2-3" x 0.131" nails   | Each end toe nail   |  |  |  |
|      |  | 2-16d common (3.5" x 0.162") or 3-3" x 0.131" nails  | End nail  |  |  |  |
|      | Flat blocking to truss and web   | 16d common (3.5" x 0.162") or 3" x 0.131" nails  | 6" o.c. face nail   |  |  |  |
| 2    | Ceiling joists to top plate  | 4-8d box (2.5" x 0.113") or<br>3-8d common (2.5" x 0.131") or<br>3-10d box (3" x 0.128") or<br>3-3" x 0.131" nails   | Per joist, toe nail   |  |  |  |
| 3    | Ceiling joist not attached to parallel rafter, laps over partitions [see Section R802.5.2 and Table R802.5.2(1)] | 4-10d box (3" x 0.128") or<br>3-16d common (3.5" x 0.162") or<br>4-3" x 0.131" nails                                 | Face nail   |  |  |  |
| 4    | Ceiling joist attached to parallel rafter (heel joint) [see Section R802.5.2 and Table R802.5.2(1)]              | Table R802.5.2(1)  | Face nail   |  |  |  |
| 5    | Collar tie to rafter, face nail  | 4-10d box (3" x 0.128") or<br>3-10d common (3" x 0.148") or<br>4-3" x 0.131" nails                                   | Face nail each rafter   |  |  |  |
| 6    | Rafter or roof truss to plate  3-10d common (3" x 0.148") or  4-10d box (3" x 0.128") or  toe nail on opposite   |  | 2 toe nails on one side and 1<br>toe nail on opposite side of<br>each rafter or truss |  |  |  |
| 7    | Roof rafters to ridge, valley or<br>hip rafters or roof rafter to<br>minimum 2" ridge beam                       | 4-16d box (3.5" x 0.135") or<br>3-10d common (3" x 0.148") or<br>4-10d box (3" x 0.128") or<br>4-3" x 0.131" nails   | Toe nail  |  |  |  |
|      |  | 3-16d box (3.5" x 0.135") or<br>2-16d common (3.5" x 0.162") or<br>3-10d box (3" x 0.128") or<br>3-3" x 0.131" nails | End nail  |  |  |  |

# Wall

| <u>waii</u> |  |   |  |  |
|-------------|--|---|--|--|
| 8           | Stud to stud (not at braced wall panels)   | 16d common (3.5" x 0.162")  | 24" o.c. face nail   |  |
|             |  | 10d box (3" x 0.128") or 3" x 0.131" nails  | 16" o.c. face nail   |  |
| 9           | Stud to stud and abutting studs at intersecting wall corners (at braced wall panels)       | 16d box (3.5" x 0.135") or 3" x 0.131" nails  | 12" o.c. face nail   |  |
|             |  | 16d common (3.5" x 0.162")  | 16" o.c. face nail   |  |
| 10          | Built-up header (2" to 2"<br>header with 1/2" spacer)                                      | 16d common (3.5" x 0.162")  | 16" o.c. ea. edge face nail  |  |
|             |  | 16d box (3.5" x 0.135")   | 12" o.c. ea. edge face nail  |  |
| 11          | Continuous header to stud  | 5-8d box (2.5" x 0.113") or<br>4-8d common (2.5" x 0.131") or<br>4-10d box (3" x 0.128")                                | Toe nail   |  |
| 12          | Adjacent full-height stud to end of header   | 4-16d box (3.5" x 0.135") or<br>2-16d common (3.5" x 0.162") or<br>4-10d box (3" x 0.128") or<br>4-3" x 0.131" nails    | End nail   |  |
|             | Top plate to top plate   | 16d common (3.5" x 0.162")  | 16" o.c. face nail   |  |
| 13          |  | 10d box (3" x 0.128") or<br>3" x 0.131" nails   | 12" o.c. face nail   |  |
| 14          | Double top plate splice  | 8-16d box (3.5" x 0.135") or<br>12-16d common (3.5" x 0.162") or<br>12-10d box (3" x 0.128") or<br>12-3" x 0.131" nails | Face nail on each side of end joint (minimum 24" lap splice length each side of end joint) |  |
| 15          | Bottom plate to joist, rim joist,<br>band joist or blocking (not at<br>braced wall panels) | 16d common (3.5" x 0.162")  | 16" o.c. face nail   |  |
|             |  | 16d box (3.5" x 0.135") or 3" x 0.131" nails  | 12" o.c. face nail   |  |
| D (         |  |   |  |  |

# Roof

|    |                              | _   | 11001  |                    |
|----|------------------------------|---|--|--------------------|
|    | 16                           | Bottom plate to joist, rim<br>joist, band joist or blocking<br>(at braced wall panel)   | 3-16d box (3.5" x 0.135") or<br>2-16d common (3.5" x 0.162") or<br>4-3" x 0.131" nails   | 16" o.c. face nail |
|    | 1-7                          | Top or bottom<br>plate to stud  | 4-8d box (2.5" x 0.113") or<br>3-16d box (3.5" x 0.135") or<br>4-8d common (2.5" x 0.131") or<br>4-10d box (3" x 0.128") or<br>4-3" x 0.131" nails | Toe nail           |
|    | 17                           |   | 3-16d box (3.5" x 0.135") or<br>2-16d common (3.5" x 0.162") or<br>3-10d box (3" x 0.128") or<br>4-3" x 0.131" nails                               | End nail           |
|    | 18                           | Top plates, laps at corners and intersections   | 3-10d box (3" x 0.128") or<br>2-16d common (3.5" x 0.162") or<br>3-3" x 0.131" nails   | Face nail          |
|    | 19                           | 1" brace to each stud<br>and plate  | 3-8d box (2.5" x 0.113") or<br>2-8d common (2.5" x 0.131") or<br>2-10d box (3" x 0.128") or<br>2 staples 1.75"                                     | Face nail          |
|    | 20                           | 1" × 6" sheathing to<br>each bearing  | 3-8d box (2.5" x 0.113") or<br>2-8d common (2.5" x 0.131") or<br>2-10d box (3" x 0.128") or<br>2 staples, 1" crown, 16" ga., 1.75" long            | Face nail          |
|    |                              | 1" × 8" and wider   | 3-8d box (2.5" x 0.113") or<br>3-8d common (2.5" x 0.131") or<br>3-10d box (3" x 0.128") or<br>3 staples, 1" crown, 16" ga.,<br>1.75" long         |                    |
| 21 | sheathing to each<br>bearing | Wider than 1"x8" 4-8d box (2.5" x 0.113") or 3-8d common (2.5" x 0.131") or 3-10d box (3" x 0.128") or 4 staples, 1" crown, 16" ga., 1.75" long | Face nail  |                    |

# STRUCTURAL OBSERVATION PROGRAM AND DESIGNATION OF THE

STRUCTURAL OBSERVER PROJECT ADDRESS: 1301 FERNSIDE BLVD, ALAMEDA, CA 94501 PERMIT APPL. NO.: ADDITION & REMODEL Description of Work: STRUCTURAL OBSERVATION (only checked items are required) Firm or Individual to be responsible for the Structural Observation:

| ·   |            |                         |              |
|---|------------|-------------------------|--------------|
| FOUNDATION  | WALL       | FRAME                   | DIAPHRAGM    |
|   | ☐ Concrete | ☐ Steel Moment Frame    | ☐ Concrete   |
| ☐ Mat Foundation  | ☐ Masonry  | ☐ Steel Braced Frame    | ☐ Steel Deck |
| ☐ Caisson, Piles, Grade Beams                             | ⊠ Wood     | ☐ Concrete Moment Frame | ⊠ Wood       |
| ☐ Stepp'g/Retain'g Foundation<br>Hillside Special Anchors | ☐ Others:  | ☐ Masonry Wall Frame    | ☐ Others:    |
| ☑ Others: Holdown   |            | ☐ Others:               |              |

License No.

#### **DECLARATION BY OWNER**

Signature

I, the Owner of the project, declare that the above listed firm or individual is hired by me to be the Structural Observer.

Signature DECLARATION BY ARCHITECT OR ENGINEER OF RECORD (required if the Structural Observer is different from the Architect or Engineer of Record) I, the Architect or Engineer of record for the project, declare that above listed firm or individual is designated by me responsible for the Structural Observation.

CITY STAMP


REVISIONS

PLAN CHECK REVISION DATE: 07/22/2025

ARCH UPDATE DATE: 08/11/2025 ↑ CITY CORRECTION  $\sqrt{3}$  DATE: 09/05/2025

ARCH UPDATE DATE: 10/08/2025




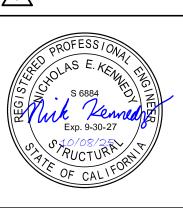

nick.kennedy@anuradesign.com Cell-530.859.8843

> **DE**| |VD| |501 3

CA563 CHECKED BY CA562 ISSUE DATE 10/08/2025

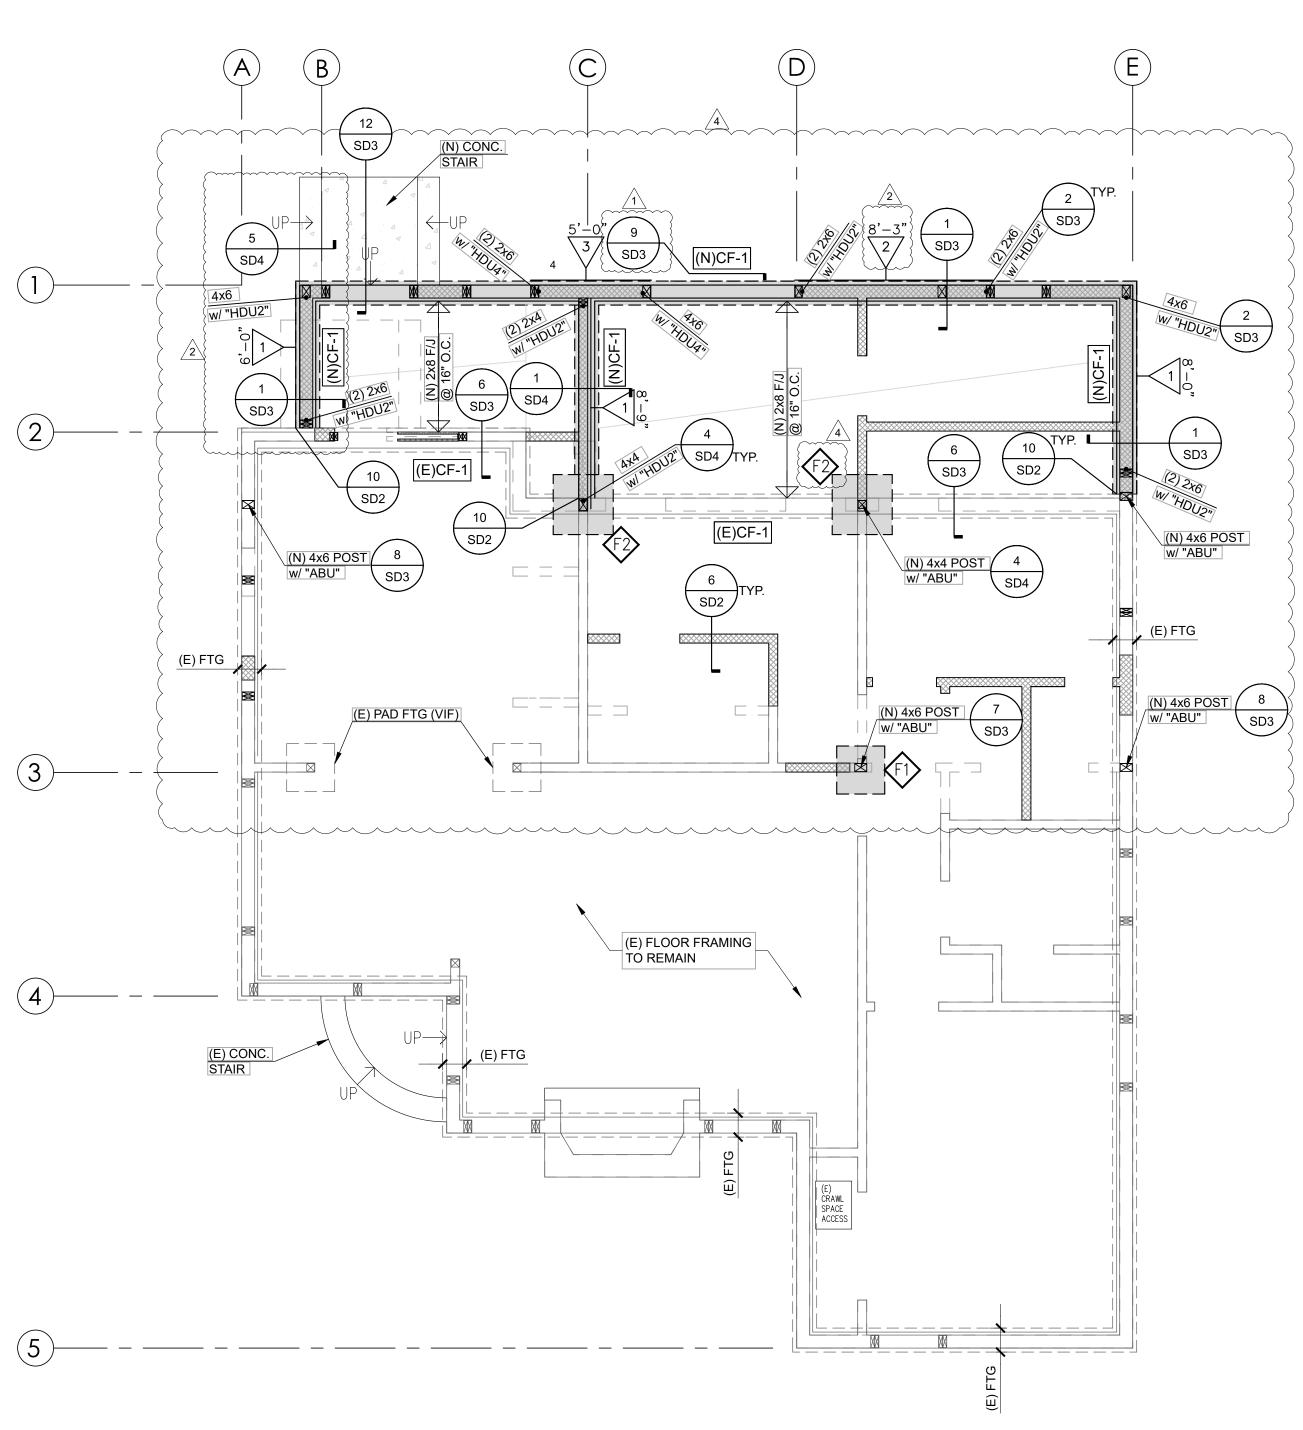

FOUNDATION PLAN

SCALE: 1/4": 1'-0"

## FLOOR FRAMING NOTES

- 1. TYPICAL FLOOR SHEATHING SHALL BE APA RATED 23/32" T&G EXPOSURE 1 (48/24) GLUE & NAIL W/ 10d SHORTS @ 6"OC ALL SUPPORTED EDGES (NO EDGE BLKG REQ'D, U.O.N) AND 10D SHORTS @ 12"OC FIELD NAILING. (OPTIONAL FASTENERS: SIMPSON WSNTL2S SCREWS). PROVIDE SHEETS NOT LESS THAN 4'x8', EXCEPT AT BOUNDARIES & CHANGES IN FRAMING WHERE MINIMUM SIZE 2'x4' IS ACCEPTABLE. INSTALL SHEETS WITH FACE GRAIN PERPENDICULAR TO SUPPORTS & STAGGER SHEETS.
- 2. ALL HOLD-DOWNS SHALL BE INSTALLED ACCORDING TO SIMPSON STRONG-TIE SPECIFICATIONS AND REQUIREMENTS OF ICC ES REPORT #ESR-2330 AND LARR #25720 AND SHALL BE TIED IN-PLACE PRIOR TO FOUNDATION INSPECTION.
- THE CAPACITY OF HOLD- DOWN CONNECTORS THAT DO NOT CONSIDER CYCLIC LOADING OF THE PRODUCT SHALL BE REDUCED TO 75% OF THE ALLOWABLE EARTHQUAKE LOAD VALUES. (2305.5)
- 3. SPLICE PLATES OF EXTERIOR WALLS AND SHEAR WALLS W/(14) 16d AT 4'-0" SPLICE (U.O.N.).
- 4. PROVIDE MULTIPLE STUDS UNDER MULTIPLE JOISTS.
- 5. FRAMING PLAN SHALL REFLECT THE STRUCTURAL REQUIREMENT ONLY. ALL BUILDING DIMENSIONS SHOWN ON THE PLANS HAVE BEEN DETERMINED BY THE ARCHITECT. REFER TO ARCHITECTURAL PLANS FOR DIMENSIONS NOT SHOWN. ACCURACY OF THE DIMENSIONS AND FINAL FIT OF THE BUILDING SHALL BE REVIEWED BY THE ARCHITECT AND THE CONTRACTOR PRIOR TO CONSTRUCTION.
- 6. STRUCTURAL WOOD PANEL SHEAR WALLS SHALL BE COVERED WITH MINIMUM 2 LAYERS 15# FELT
- UNDERLAYMENT PRIOR TO PLACING FINISH MATERIAL.
- 8. HOLD-DOWN CONNECTOR BOLTS INTO WOOD FRAMING REQUIRE APPROVED PLATE WASHERS; AND HOLD-DOWNS SHALL BE FINGER TIGHT AND  $rac{1}{2}$  WRENCH TURN JUST PRIOR TO COVERING THE WALL FRAMING. CONNECTOR BOLTS INTO WOOD FRAMING REQUIRE STEEL PLATE WASHERS ON THE POST ON THE OPPOSITE SIDE OF THE ANCHORAGE DEVICE. PLATE SIZE SHALL BE A MINIMUM OF 0.299 INCH BY 3

7. SOLID BLOCKING SHALL BE PROVIDED AT ALL HORIZONTAL JOINTS OCCURRING IN BRACED WALL PANELS.

- 9. ALL BOLT HOLES SHALL BE DRILLED 1/32" TO 1/16" OVERSIZED.
- 10. THE FOLLOWING APPLIES TO ALL SHEAR WALLS WITH A SHEAR VALUE GREATER THAN 350 PLF. THESE WALLS SHALL BE CLEARLY IDENTIFIED ON THE PLANS AND PROVIDE WITH THE FOLLOWING: (TABLE 2306.4.1 FOOTNOTE 8)
  - a. 3x FOUNDATION / WALL SILL PLATES
- b. 3x STUDS AND BLOCKS BETWEEN ADJACENT PANELS.
- c. 1/2" EDGE DISTANCE FOR PLYWOOD BOUNDARY NAILING.
- d. ALL PANEL JOINT AND SILL PLATE NAILING SHALL BE STAGGERED.
- e. FOR THE ANCHOR BOLTS IN SHEAR WALL SILL PLATE, PROVIDE STEEL PLATE WASHERS 3"x3"x0.229" WITH SLOTTED CUT HOLE AS AS PER 2305.3.11 OR AS SPECIFIED ON THE TABLE 2305.3.11 FOR
- NON-SLOTTED CUT PLATE WASHERS.
- 11. SEE 1/SD1 FOR SHEAR WALL SCHEDULE.

INCHES BY 3 INCHES. (2305.5)

- 12. USE 2-2X BLOCKING OR 2-2X JOIST AT ALL DRAG STRAPS.
- 13. LAG BOLTS: PROVIDE LEAD HOLE 40%-70% OF THREADED SHANK DIA. AND FULL DIA. FOR SMOOTH SHANK PORTION.
- 14. ALL DIAPHRAGM AND SHEAR WALL NAILING SHALL UTILIZE COMMON NAILS OR GALVANIZED BOX. 15. USE 4x6 POST TO SUPPORT 5.25x PRLLM OR 6x BEAMS U.N.O.
- 16. USE 2X6 OR 3X4 @ 16" O.C. STUD WALL FRAMING FOR WALLS WITH HEIGHT OF 10'-0" TO 15'-6".
- 17. ALL ROOF AND ROOF DECK SHEAR TRANSFER NAILING SHALL BE VERIFIED BY THE CITY BUILDING DIVISION PRIOR TO COVERING. ANY CRICKETS OR SIMILAR COVERING SHALL BE ENTIRELY REMOVED BEFORE THE HORIZONTAL DIAPHRAGM INSPECTION WILL BE MADE BY THE CITY BUILDING DIVISION.
- 18. ROOF DIAPHRAGM NAILING TO BE INSPECTED BEFORE COVERING. FACE GRAIN OF PLYWOOD SHALL BE PERPENDICULAR TO SUPPORTS. FLOOR SHALL HAVE TONGUE & GROOVE OR BLOCKED PANEL EDGES. PLYWOOD SPANS SHALL CONFORM WITH TABLE 2304.8(1).
- 19. WHERE POST IS NOT CONTINUOUS BETWEEN FLOORS, PROVIDE FULL HEIGHT KING STUD EACH SIDE OF POST WITH 16d @ 12" O.C.
- 20.FASTENER IN PRESERVATIVE TREATED WOOD OR FIRE RETARDANT TREATED WOOD SHALL BE OF HOT DIPPED ZINC COATED GALVANIZED OR STAINLESS STEEL. (2304.10.5.1)


### **FOUNDATION NOTES**


1. CONCRETE STRENGTH SHALL BE MINIMUM 2500 PSI AND 3000 PSI FOR GRADE BEAMS.

REQUIREMENTS OF ICC ES REPORT #ESR-2330 AND LARR #25720.


- 2. THE MAXIMUM SOIL BEARING PRESSURE IS 1500 PSF PER TABLE 1806.2. 3. ALL HOLD-DOWNS SHALL BE INSTALLED ACCORDING TO SIMPSON STRONG-TIE SPECIFICATIONS AND
- 4. ALL CONTINUOUS EXTERIOR FOOTINGS SHALL HAVE 5/8" DIAMETER X 12" A.B.'S WITH 3"X3"X0.229" WASHERS, MIN. 7" EMBEDMENT ONTO CONCRETE, AT 72" O.C. UNLESS NOTED OTHERWISE ON PLANS. ONE ANCHOR BOLT SHOULD BE LOCATED MAX. 12" AWAY FROM THE END OF THE SILL PLATES. MIN. (2) A.B.'S PER SILL PLATE PER SHEAR PANEL.
- 5. ALL INTERIOR NON-BEARING WALLS SHALL HAVE HILTI X-CR WITH MIN. PENETRATION OF 1 1/4" INTO SLAB, AT 24" O.C. UNLESS NOTED OTHERWISE. TO BE INSTALLED IN ACCORDANCE WITH ICC ES #ESR-1663 AND LARR #25646. ACTUAL SLAB THICKNESS SHALL BE MINIMUM 3-1/2".
- 6. MIN. CONCRETE WIDTH SHALL BE 8" FOR RECEIVING 'HDU' HOLD-DOWNS. VERIFY LOCATIONS OF HOLD-DOWNS AND ANCHOR BOLTS WITH ROUGH FRAMING TO ASSURE PROPER AND ACCURATE
- INSTALLATION. 7. PROVIDE #3x24" DOWEL AT 24" O.C. AND 12" FROM THE CORNER AT ALL CONCRETE STOOP AND PORCHES.
- 8. ALL FOOTINGS SHALL BE FOUNDED IN UNDISTURBED SOIL PER CODE, A MINIMUM OF 24" INTO COMPETENT BEARING MATERIALS, NATURAL SOILS OR COMPACTED FILL. SEE SOIL REPORT WHERE IT IS REQUIRED. 9. THE FOLLOWING APPLIES TO ALL SHEAR WALLS WITH A SHEAR VALUE GREATER THAN 350 PLF. THESE
- WALLS SHALL BE CLEARLY IDENTIFIED ON THE PLANS AND PROVIDE WITH THE FOLLOWING: (TABLE 2306.4.1 FOOTNOTE 8)
- a. 3x FOUNDATION / WALL SILL PLATES
- b. 3x STUDS AND BLOCKS BETWEEN ADJACENT PANELS.
- c. 1/2" EDGE DISTANCE FOR PLYWOOD BOUNDARY NAILING.
- d. ALL PANEL JOINT AND SILL PLATE NAILING SHALL BE STAGGERED.
- e. FOR THE ANCHOR BOLTS IN SHEAR WALL SILL PLATE, PROVIDE STEEL PLATE WASHERS 3"x3"x0.229" WITH SLOTTED CUT HOLE AS AS PER 2305.3.11 OR AS SPECIFIED ON THE TABLE 2305.3.11 FOR NON-SLOTTED CUT PLATE WASHERS.
- 10. VERIFY MINIMUM FOUNDATION DEPTH, WIDTH, REINFORCING STEEL AND ADDITIONAL EXPANSIVE SOIL REQUIREMENTS WITH VALID SOILS REPORT (WHERE IT IS REQUIRED) AND IF ANY MORE RESTRICTIVE THEY
- SHALL SUPERSEDE THE ABOVE MINIMUMS. 11. FOUNDATION DRAWING SHALL REFLECT THE STRUCTURAL REQUIREMENT ONLY. ALL BUILDING DIMENSIONS SHOWN ON THE PLANS HAVE BEEN DETERMINED BY THE ARCHITECT. REFER TO ARCHITECTURAL PLANS FOR DIMENSIONS NOT SHOWN. ACCURACY OF THE DIMENSIONS AND FINAL FIT OF
- THE BUILDING SHALL BE REVIEWED BY THE ARCHITECT AND THE CONTRACTOR PRIOR TO CONSTRUCTION. 12. TO REPLACE MISSING OR DISLOCATED 5/8" DIAMETER ANCHOR BOLTS, USE 5/8" DIAMETER THREADED RODS EMBEDDED MIN. 7" INTO CONCRETE WITH SIMPSON STRONG-TIE "SET-3G" EPOXY. SPECIAL
- INSPECTION IS REQUIRED DURING INSTALLATION. FOLLOW MANUFACTURER'S RECOMMENDATIONS, ICC ES #ESR-4057.
- 13. SEE 1/SD1 FOR SHEAR WALL SCHEDULE. 14. HOLD-DOWN CONNECTOR BOLTS INTO WOOD FRAMING REQUIRE APPROVED PLATE WASHERS; AND
- HOLD-DOWNS SHALL BE FINGER TIGHT AND ½ WRENCH TURN JUST PRIOR TO COVERING THE WALL FRAMING. CONNECTOR BOLTS INTO WOOD FRAMING REQUIRE STEEL PLATE WASHERS ON THE POST ON THE OPPOSITE SIDE OF THE ANCHORAGE DEVICE. PLATE SIZE SHALL BE A MINIMUM OF 0.299 INCH BY 3 INCHES BY 3 INCHES.
- 15. USE 2X6 OR 3X4 @ 16" O.C. STUD WALL FRAMING FOR WALLS 10'-0" TO 15'-6" HIGH
- 16. HOLD-DOWN HARDWARE SHALL BE SECURED IN PLACE PRIOR TO FOUNDATION INSPECTION.
- 17. IF ADVERSE SOIL CONDITIONS ARE ENCOUNTERED, A SOIL'S REPORT MAY BE REQUIRED. 18. IN THE EVENT EXCAVATIONS REVEAL UNFAVORABLE CONDITIONS, THE SERVICES OF A SOILS ENGINEER AND/OR GEOLOGIST MAY BE REQUIRED.
- 19. FOUNDATION SILL SHALL BE NATURALLY DURABLE OR PRESERVATIVE-TREATED WOOD USING WATER-BORNE PRESERVATIVES, IN ACCORDANCE WITH AWPA U1 (COMMODITY SPECIFICATIONS A OR F)
- FOR ABOVE GROUND USE. (CBC 2304.12.1) 20. CONTINUOUS INSPECTION BY A REGISTERED SPECIAL INSPECTOR IS REQUIRED FOR ALL CONCRETE DESIGNED WITH fc' GREATER THAN 2,500 PSI AND INSTALLATION OF EPOXY/EXPANSION ANCHORS. (CBC
- 1704.2.3. SECTION 8-9.10 OF ORDINANCE NO. 1301) 21. FOOTINGS SHALL BE SET BACK FROM THE DESCENDING SLOPE SURFACE EXCEEDING 3 HORIZONTAL TO 1 VERTICAL AS PER SECTION 91.1805.3.7.
- 22. CONTINUOUS INSPECTION BY DEPUTY INSPECTOR IS REQUIRED FOR INSTALLING SIMPSON STRONG WALL OR HARDY FRAME HOLD-DOWNS.

# FOUNDATION PLAN LEGEND

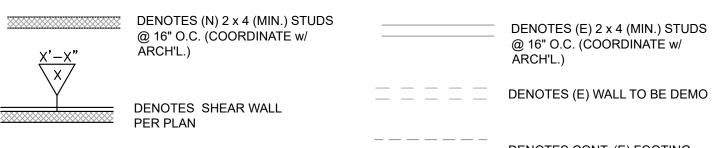

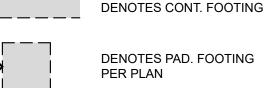

CF-1

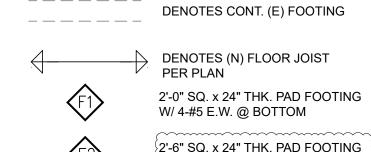

| CONTIN  | IUOUS F | OOTING S  | SCHEDULE   | r Z          | W/ 4-#!      | 5 E.W. @ BOTTON |
|---------|---------|-----------|------------|--------------|--------------|-----------------|
| MARK    | WIDTH   | THICKNESS | TOP REINF. | BOTT. REINF. | TIES         | REMARKS         |
| (E)CF-1 | 1'-0"   | 1'-0"     | (2) - #4   | (2) - #4     | -            | V.I.F.          |
| (N)CF-1 | 1'-0"   | 1'-0"     | (2) - #4   | (2) - #4     | #4 @48" O.C. |                 |

CITY STAMP

CA563 CHECKED BY CA562 **ISSUE DATE** 10/08/2025

1/4" = 1'-0" ANURA JOB NO

OUND,

REVISIONS

PLAN CHECK REVISION DATE: 07/22/2025

ARCH UPDATE DATE: 08/11/2025

CITY CORRECTION

/3\ DATE: 09/05/2025

↑ ARCH UPDATE

4 DATE: 10/08/2025

nick.kennedy@anuradesign.com

Cell-

530.859.8843

**MODE!**E BLVD,
94501

R


0

 $\infty$ 

4

CA2504-0002

G.C. TO VERIFY ALL EXISTING FOUNDATION & FRAMING AND NOTIFY ENGINEER FOR ANY DISCREPANCIES.

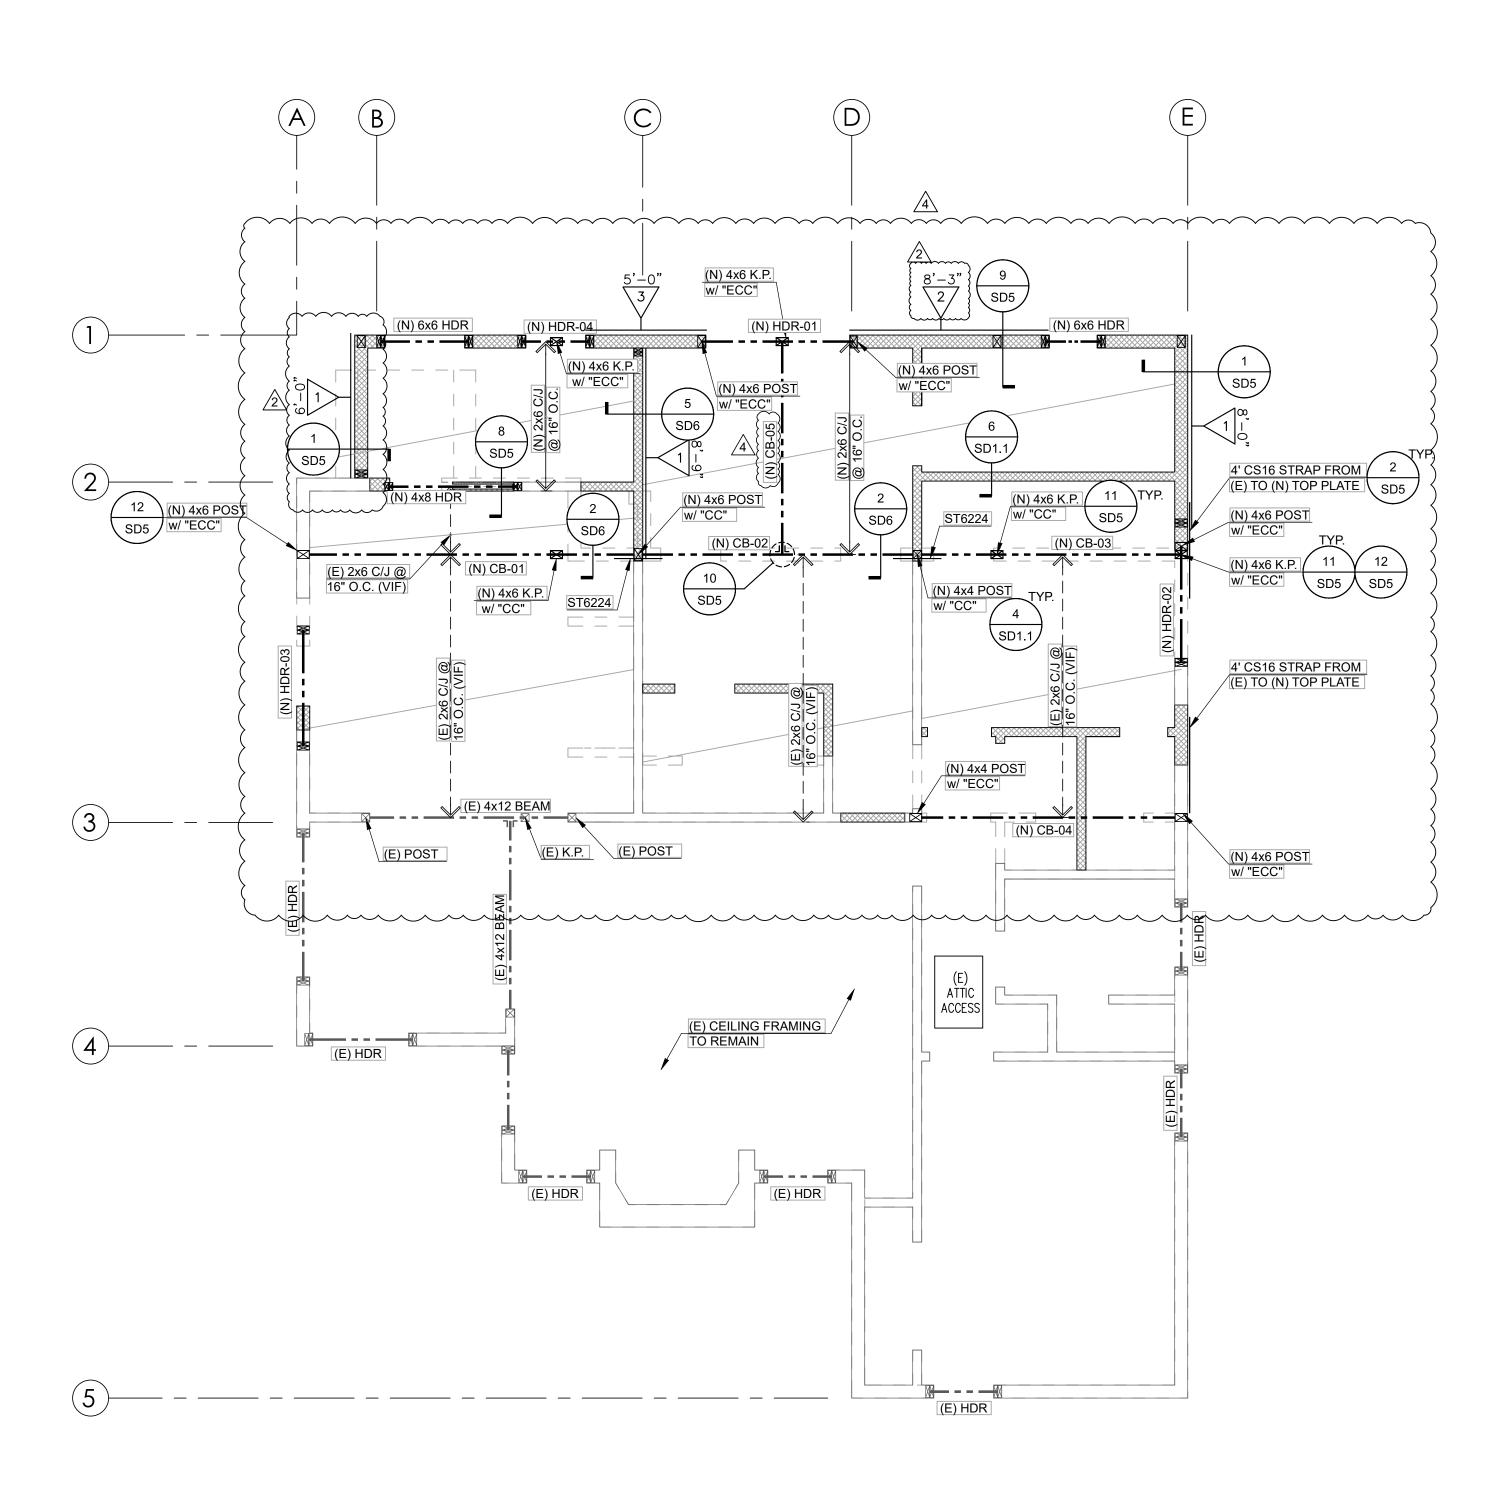


CEILING FRAMING PLAN SCALE: 1/4" : 1'-0"

### ROOF FRAMING NOTES

- 1. TYPICAL ROOF SHEATHING SHALL BE APA RATED  $^{15}$ /<sub>32</sub>" EXPOSURE 1 ( $^{32}$ /<sub>16</sub>) NAILED W/8d @ 6" O.C. ALL SUPPORTED EDGES (NO EDGE BLK'G REQ'D, U.O.N.) AND 8d @ 12" O.C. FIELD NAILING. PROVIDE SHEETS NOT LESS THAN 4'x8', EXCEPT AT BOUNDARIES &
- CHANGES IN FRAMING WHERE MINIMUM SIZE 2'x4' IS ACCEPTABLE. INSTALL SHEETS WITH FACE GRAIN PERPENDICULAR TO SUPPORTS & STAGGER SHEETS
- 2. PROVIDE MULTIPLE STUDS UNDER MULTIPLE JOISTS. 3. FRAMING PLAN SHALL REFLECT THE STRUCTURAL REQUIREMENT ONLY. ALL BUILDING DIMENSIONS
- SHOWN ON THE PLANS HAVE BEEN DETERMINED BY THE ARCHITECT. REFER TO ARCHITECTURAL PLANS FOR DIMENSIONS NOT SHOWN. ACCURACY OF THE DIMENSIONS AND FINAL FIT OF THE BUILDING SHALL BE REVIEWED BY THE ARCHITECT AND THE CONTRACTOR PRIOR TO CONSTRUCTION.
- 4. SOLID BLOCKING SHALL BE PROVIDED AT ALL HORIZONTAL JOINTS OCCURRING IN BRACED WALL PANELS.
- 6. USE 2-2X BLOCKING OR 2-2X JOIST AT ALL DRAG STRAPS. 7. LAG BOLTS: PROVIDE LEAD HOLE 40%-70% OF THREADED SHANK DIA. AND FULL DIA. FOR SMOOTH SHANK

5. ALL BOLT HOLES SHALL BE DRILLED 1/32" TO 1/16" OVERSIZED.

- PORTION OF LAG SCREW (NDS 12.1.4) 8. USE 4x6 POST TO SUPPORT 5.25x PRLLM OR 6x BEAMS U.N.O.
- 9. USE 2X6 OR 3X4 @ 16" O.C. STUD WALL FRAMING FOR WALLS WITH HEIGHT OF 10'-0" TO 15'-6". 10. ALL ROOF AND ROOF DECK SHEAR TRANSFER NAILING SHALL BE VERIFIED BY THE CITY BUILDING DIVISION PRIOR TO COVERING. ANY CRICKETS OR SIMILAR COVERING SHALL BE ENTIRELY REMOVED BEFORE THE
- HORIZONTAL DIAPHRAGM INSPECTION WILL BE MADE BY THE CITY BUILDING DIVISION. 11. ROOF DIAPHRAGM NAILING TO BE INSPECTED BEFORE COVERING. FACE GRAIN OF PLYWOOD SHALL BE PERPENDICULAR TO SUPPORTS. FLOOR SHALL HAVE TONGUE & GROOVE OR BLOCKED PANEL EDGES.
- PLYWOOD SPANS SHALL CONFORM WITH TABLE 2304.7. 12. WHERE POST IS NOT CONTINUOUS BETWEEN FLOORS, PROVIDE FULL HEIGHT KING STUD EACH SIDE OF
- POST WITH 16d @ 12" O.C. 13. SEE 1-SD1 FOR SHEAR WALL TYPE.
- 14. SHEARWALL CAN BE ON EITHER SIDE OF WALL.
- 15. FASTENERS IN PRESERVATIVE TREATED WOOD OR FIRE RETARDANT TREATED WOOD SHALL BE OF HOT ZINC COATED GALVANIZED STEEL OR STAINLESS STEEL.

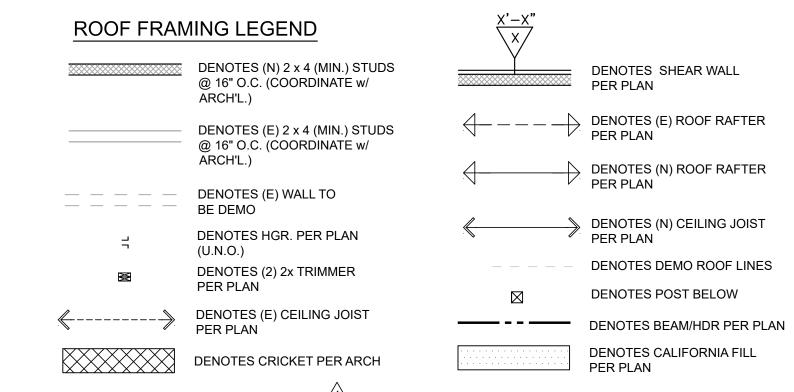

# BEAM/HEADER SCHEDULE

| <del>~~~~~~~~~~~~~~~~~~~~~~~~~~~~~~~~~~~~~</del> |                         |  |  |  |
|--|-------------------------|--|--|--|
| MARK_  | SIZES                   |  |  |  |
| HDR-01<br>RB-01,RB-02                            | 6x8                     |  |  |  |
| HDR-02, HDR-03, HDR-04                           | 6x6                     |  |  |  |
| CB-03  | 3 1/2"x9 1/2" 2.0E PSL  |  |  |  |
| CB-01, CB-02                                     | 3 1/2"x11 1/4" 2.0E PSL |  |  |  |
| CB-04, CB-05                                     | 4x10                    |  |  |  |
|  |                         |  |  |  |

CITY STAMP


anura d e s i g n


REVISIONS

PLAN CHECK REVISION DATE: 07/22/2025

ARCH UPDATE DATE: 08/11/2025

CITY CORRECTION DATE: 09/05/2025 ARCH UPDATE DATE: 10/08/2025

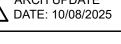

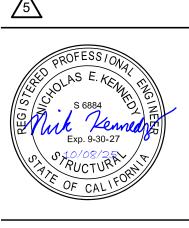

nick.kennedy@anuradesign.com Cell-530.859.8843


REMODEL SIDE BLVD, CA 94501 ADDITION 301 FERN 4

CA563 CHECKED BY CA562 10/08/2025

1/4" = 1'-0" ANURA JOB NO

CA2504-0002


S-3

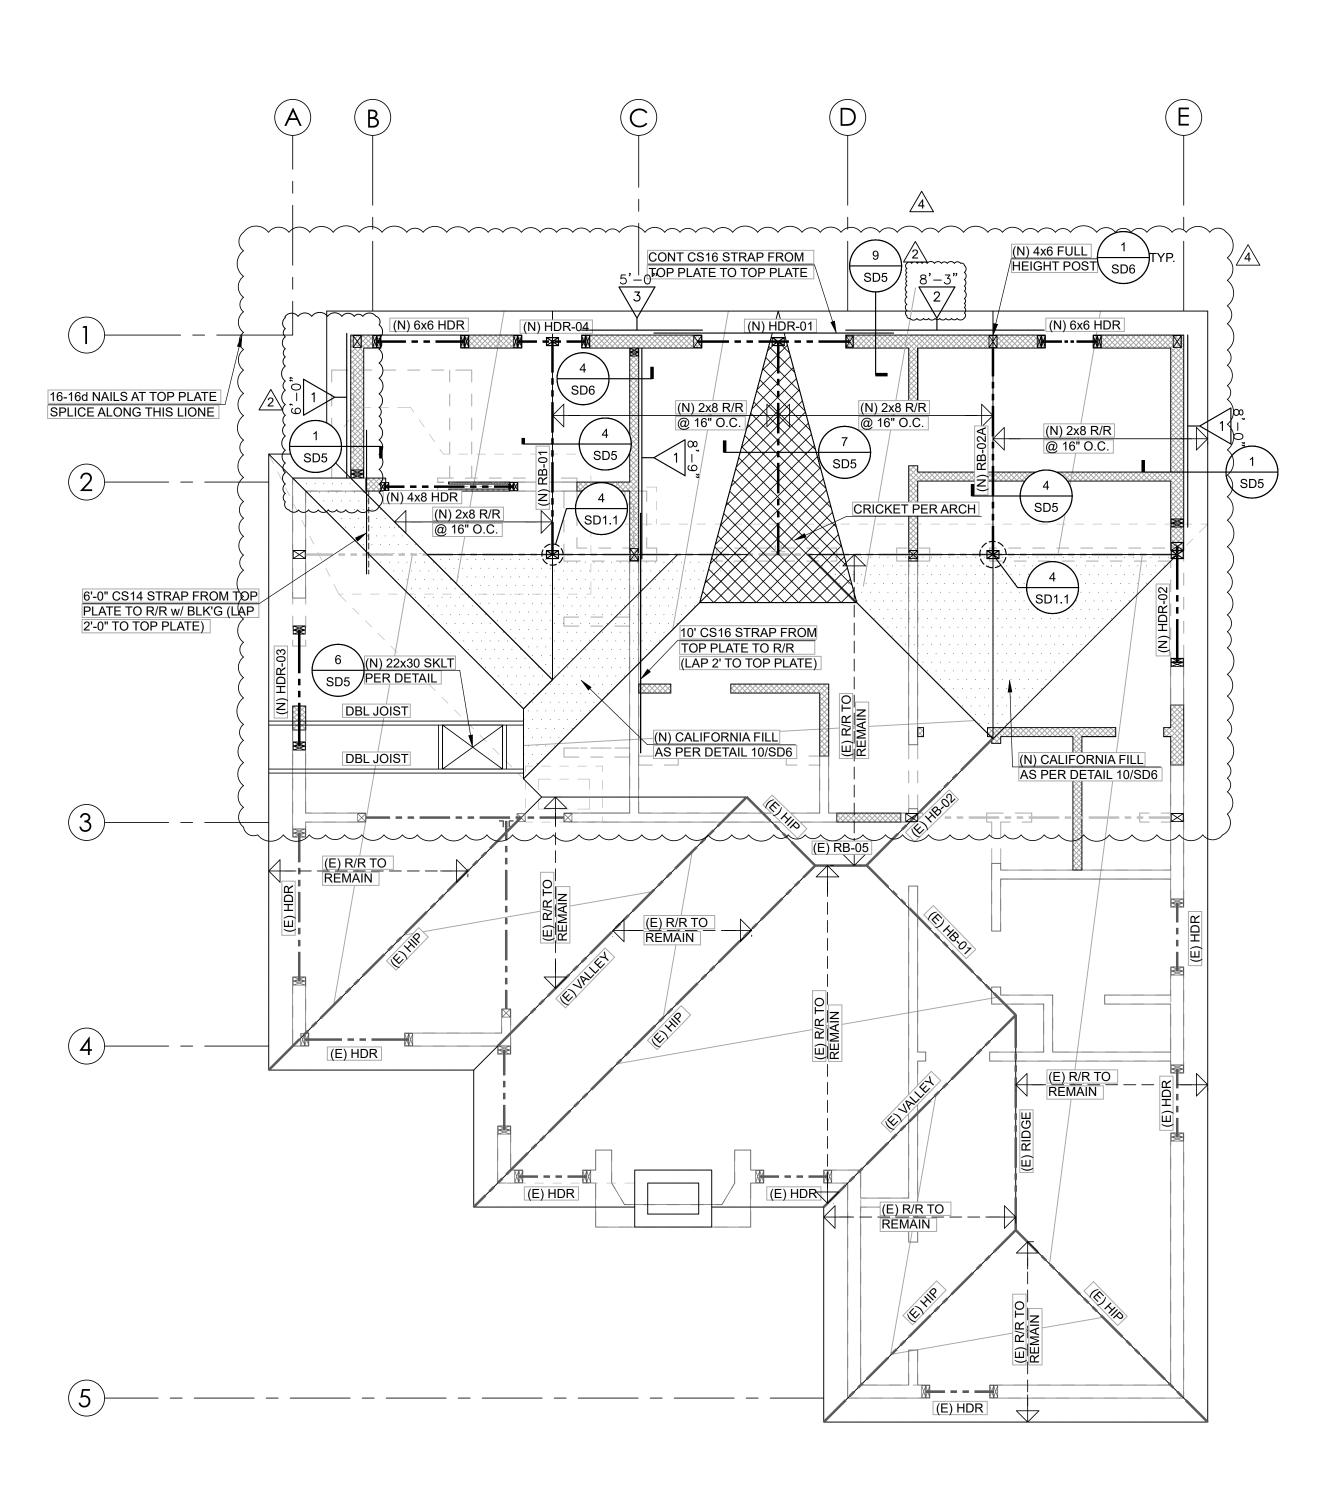

ROOF FRAMING PLAN SCALE: 1/4" : 1'-0"


#### ROOF FRAMING NOTES

- 1. TYPICAL ROOF SHEATHING SHALL BE APA RATED  $^{15}$ /<sub>32</sub>" EXPOSURE 1 ( $^{32}$ /<sub>16</sub>) NAILED W/8d @ 6" O.C. ALL SUPPORTED EDGES (NO EDGE BLK'G REQ'D, U.O.N.) AND 8d @ 12" O.C. FIELD NAILING. PROVIDE SHEETS NOT LESS THAN 4'x8', EXCEPT AT BOUNDARIES &
- CHANGES IN FRAMING WHERE MINIMUM SIZE 2'x4' IS ACCEPTABLE. INSTALL SHEETS WITH FACE GRAIN PERPENDICULAR TO SUPPORTS & STAGGER SHEETS 2. PROVIDE MULTIPLE STUDS UNDER MULTIPLE JOISTS.
- 3. FRAMING PLAN SHALL REFLECT THE STRUCTURAL REQUIREMENT ONLY. ALL BUILDING DIMENSIONS SHOWN ON THE PLANS HAVE BEEN DETERMINED BY THE ARCHITECT. REFER TO ARCHITECTURAL PLANS
- FOR DIMENSIONS NOT SHOWN. ACCURACY OF THE DIMENSIONS AND FINAL FIT OF THE BUILDING SHALL BE REVIEWED BY THE ARCHITECT AND THE CONTRACTOR PRIOR TO CONSTRUCTION.
- 4. SOLID BLOCKING SHALL BE PROVIDED AT ALL HORIZONTAL JOINTS OCCURRING IN BRACED WALL PANELS.
- 5. ALL BOLT HOLES SHALL BE DRILLED 1/32" TO 1/16" OVERSIZED. 6. USE 2-2X BLOCKING OR 2-2X JOIST AT ALL DRAG STRAPS.
- 7. LAG BOLTS: PROVIDE LEAD HOLE 40%-70% OF THREADED SHANK DIA. AND FULL DIA. FOR SMOOTH SHANK PORTION OF LAG SCREW (NDS 12.1.4)
- 8. USE 4x6 POST TO SUPPORT 5.25x PRLLM OR 6x BEAMS U.N.O.
- 9. USE 2X6 OR 3X4 @ 16" O.C. STUD WALL FRAMING FOR WALLS WITH HEIGHT OF 10'-0" TO 15'-6".
- 10. ALL ROOF AND ROOF DECK SHEAR TRANSFER NAILING SHALL BE VERIFIED BY THE CITY BUILDING DIVISION PRIOR TO COVERING. ANY CRICKETS OR SIMILAR COVERING SHALL BE ENTIRELY REMOVED BEFORE THE HORIZONTAL DIAPHRAGM INSPECTION WILL BE MADE BY THE CITY BUILDING DIVISION.
- 11. ROOF DIAPHRAGM NAILING TO BE INSPECTED BEFORE COVERING. FACE GRAIN OF PLYWOOD SHALL BE PERPENDICULAR TO SUPPORTS. FLOOR SHALL HAVE TONGUE & GROOVE OR BLOCKED PANEL EDGES. PLYWOOD SPANS SHALL CONFORM WITH TABLE 2304.7.
- 12. WHERE POST IS NOT CONTINUOUS BETWEEN FLOORS, PROVIDE FULL HEIGHT KING STUD EACH SIDE OF
- POST WITH 16d @ 12" O.C. 13. SEE 1-SD1 FOR SHEAR WALL TYPE.
- 14. SHEARWALL CAN BE ON EITHER SIDE OF WALL.
- 15. FASTENERS IN PRESERVATIVE TREATED WOOD OR FIRE RETARDANT TREATED WOOD SHALL BE OF HOT ZINC COATED GALVANIZED STEEL OR STAINLESS STEEL.

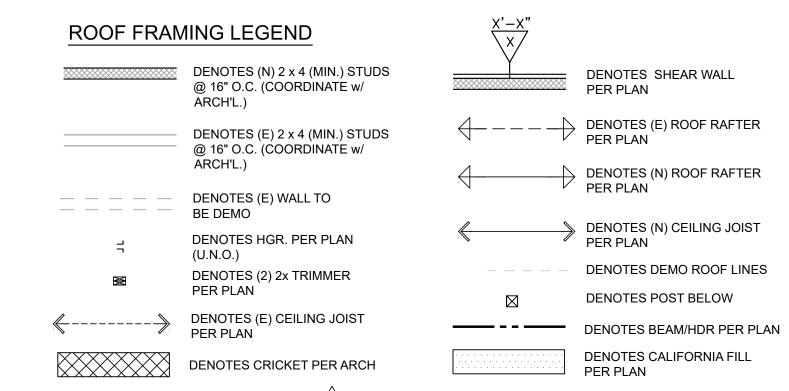

# BEVIVILEVDED SCHEDITIE?
 
| BEAM/HEADER SCHEDULE)  |                         |  |  |
|------------------------|-------------------------|--|--|
| MARK                   | SIZES                   |  |  |
| HDR-01<br>RB-01,RB-02  | 6x8                     |  |  |
| HDR-02, HDR-03, HDR-04 | 6x6                     |  |  |
| CB-03                  | 3 1/2"x9 1/2" 2.0E PSL  |  |  |
| CB-01, CB-02           | 3 1/2"x11 1/4" 2.0E PSL |  |  |
| CB-04, CB-05           | 4x10                    |  |  |
| ·                      |                         |  |  |



CA563 CHECKED BY CA562 ISSUE DATE 10/08/2025

1/4" = 1'-0" ANURA JOB NO CA2504-0002

anura

design

PLAN CHECK REVISION DATE: 07/22/2025

ARCH UPDATE DATE: 08/11/2025

ARCH UPDATE DATE: 10/08/2025

CITY CORRECTION DATE: 09/05/2025

nick.kennedy@anuradesign.com

Cell-

530.859.8843

REMODEL SIDE BLVD, CA 94501

ADDITION 301 FERN


4

REVISIONS

CITY STAMP

NOTIFY ENGINEER FOR ANY DISCREPANCIES.

G.C. TO VERIFY ALL EXISTING FOUNDATION & FRAMING AND

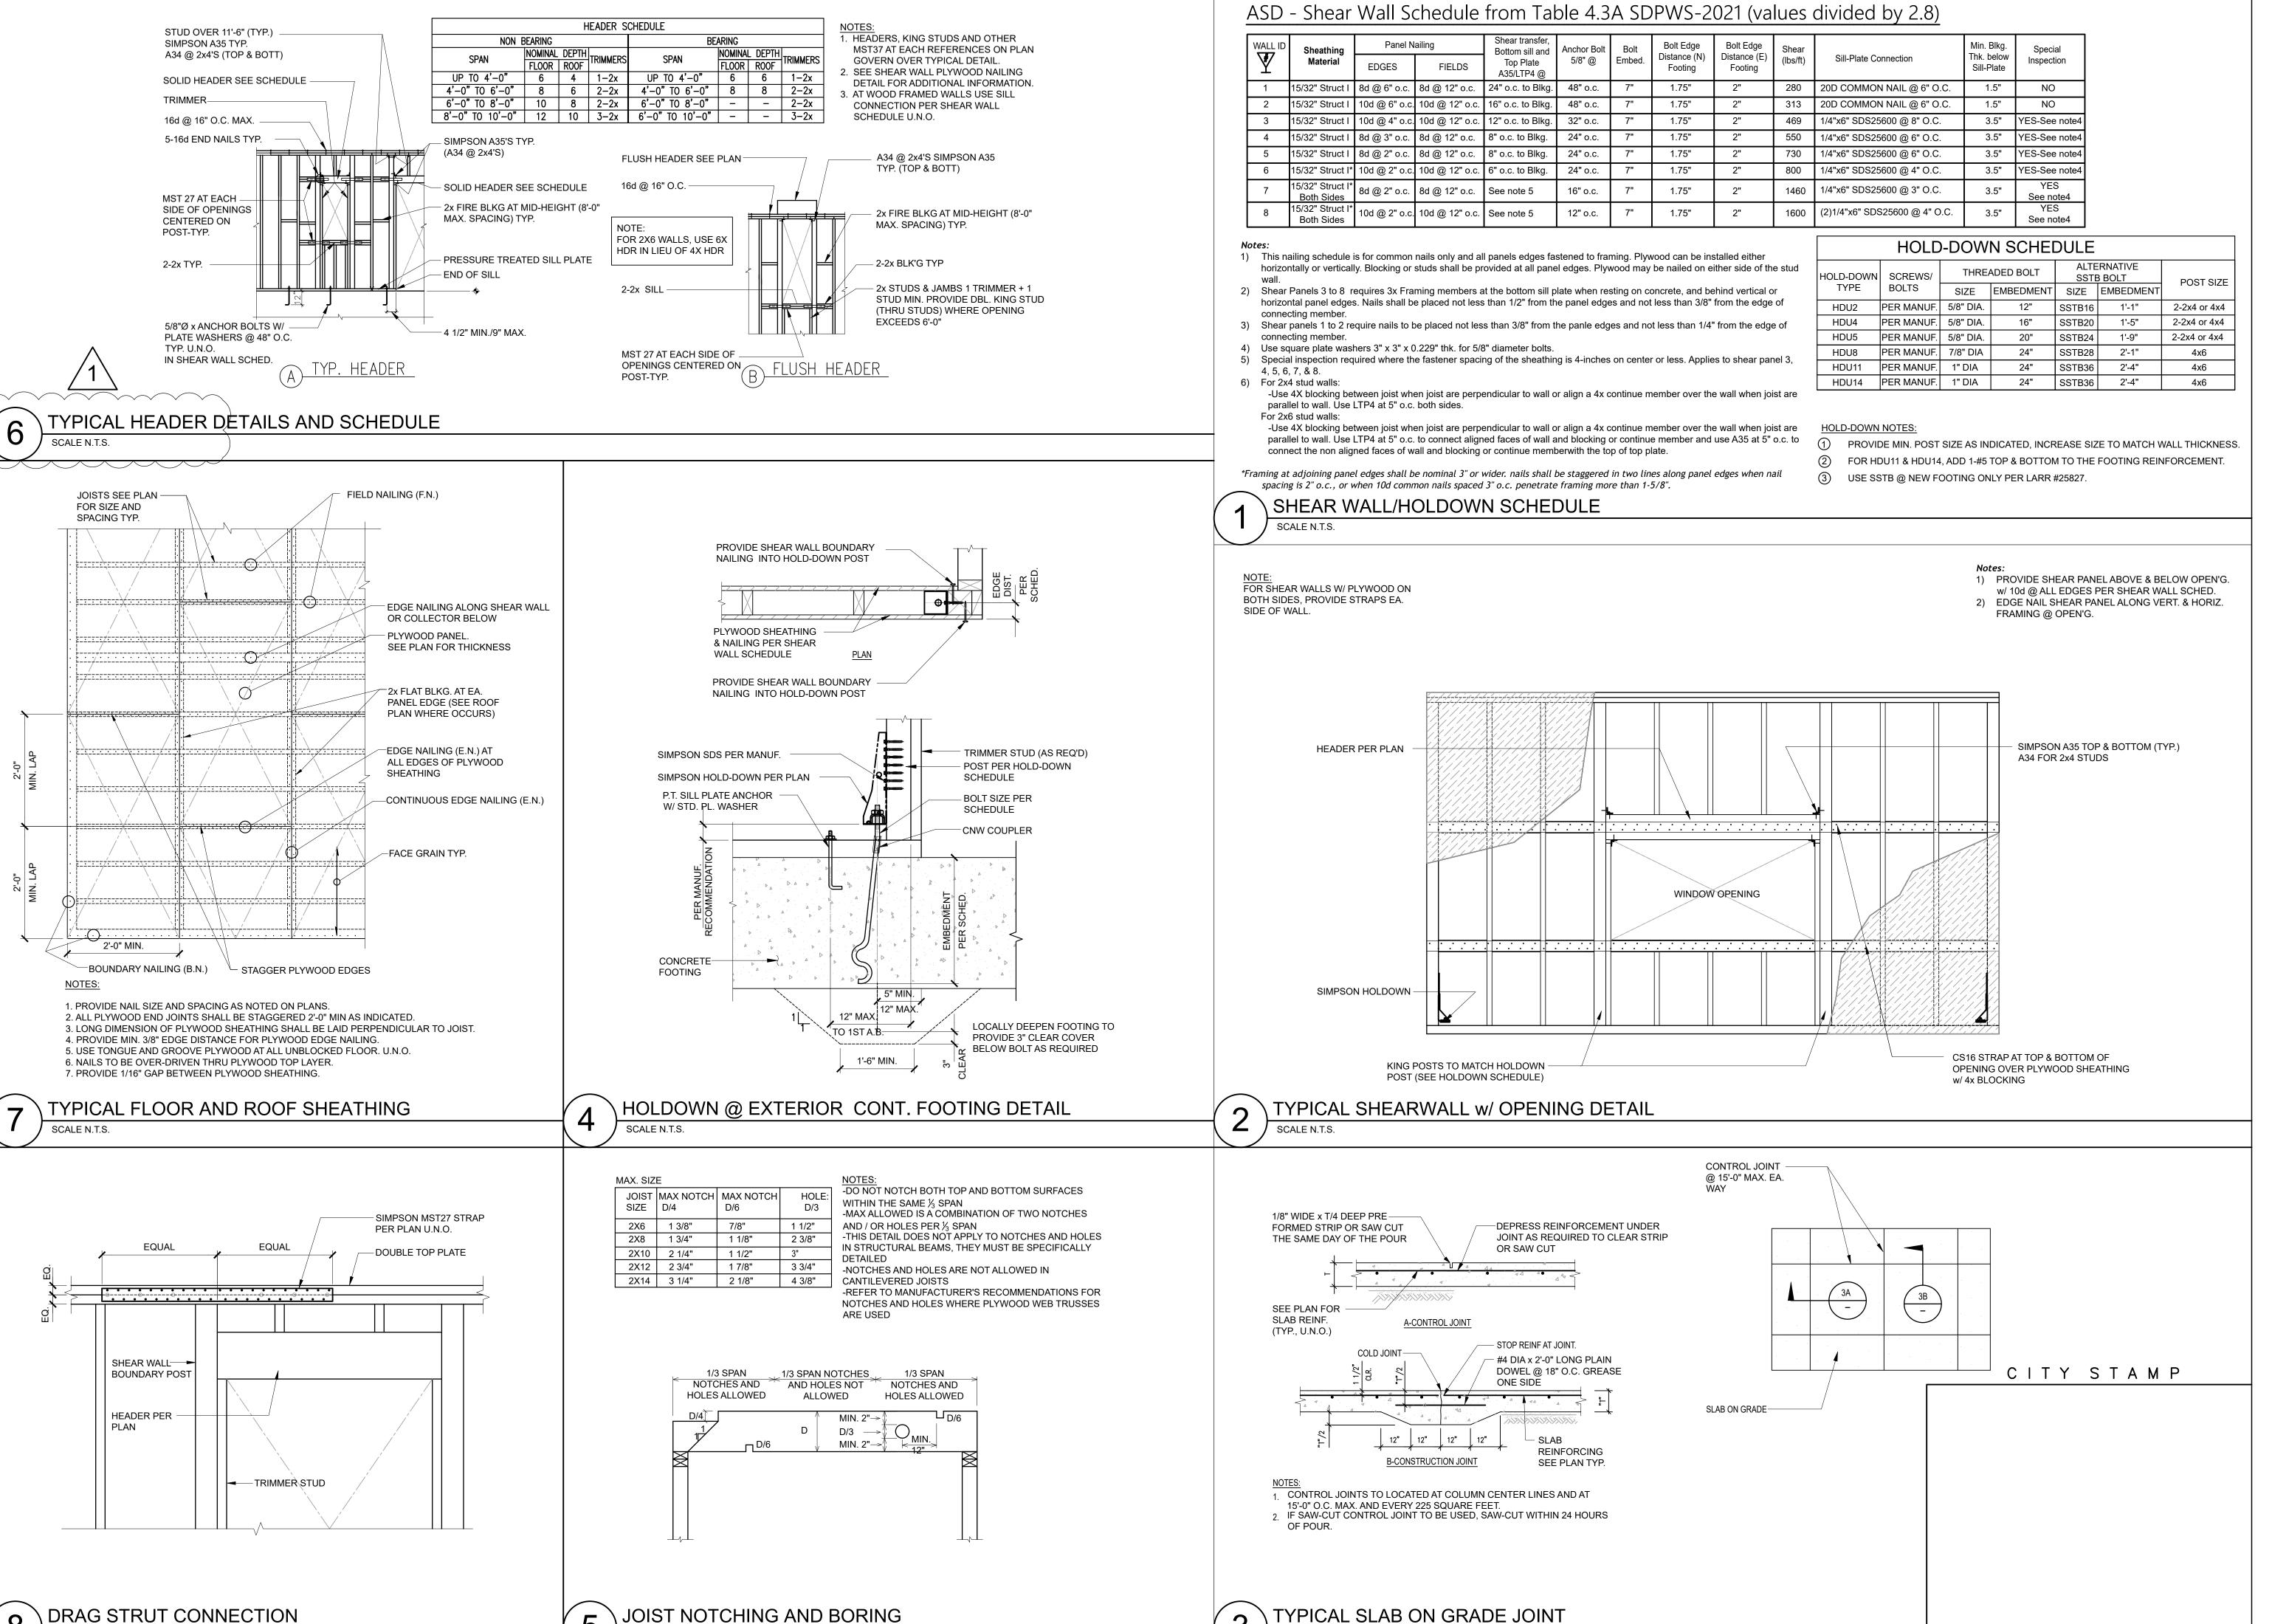

SCALE N.T.S.


SCALE N.T.S.

**REVISIONS** 

PLAN CHECK REVISION DATE: 07/22/2025

ARCH UPDATE DATE: 08/11/2025 CITY CORRECTION DATE: 09/05/2025

ARCH UPDATE DATE: 10/08/2025

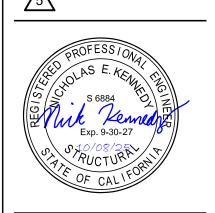

nick.kennedy@anuradesign.com Cell-

530.859.8843

REMODEL SIDE BLVD, CA 94501 DITIO 01 FEF

0

 $\infty$ 


4

CA563 CHECKED BY CA562 ISSUE DATE 10/08/2025

SCALE N/A

ANURA JOB NO CA2504-0002

SD

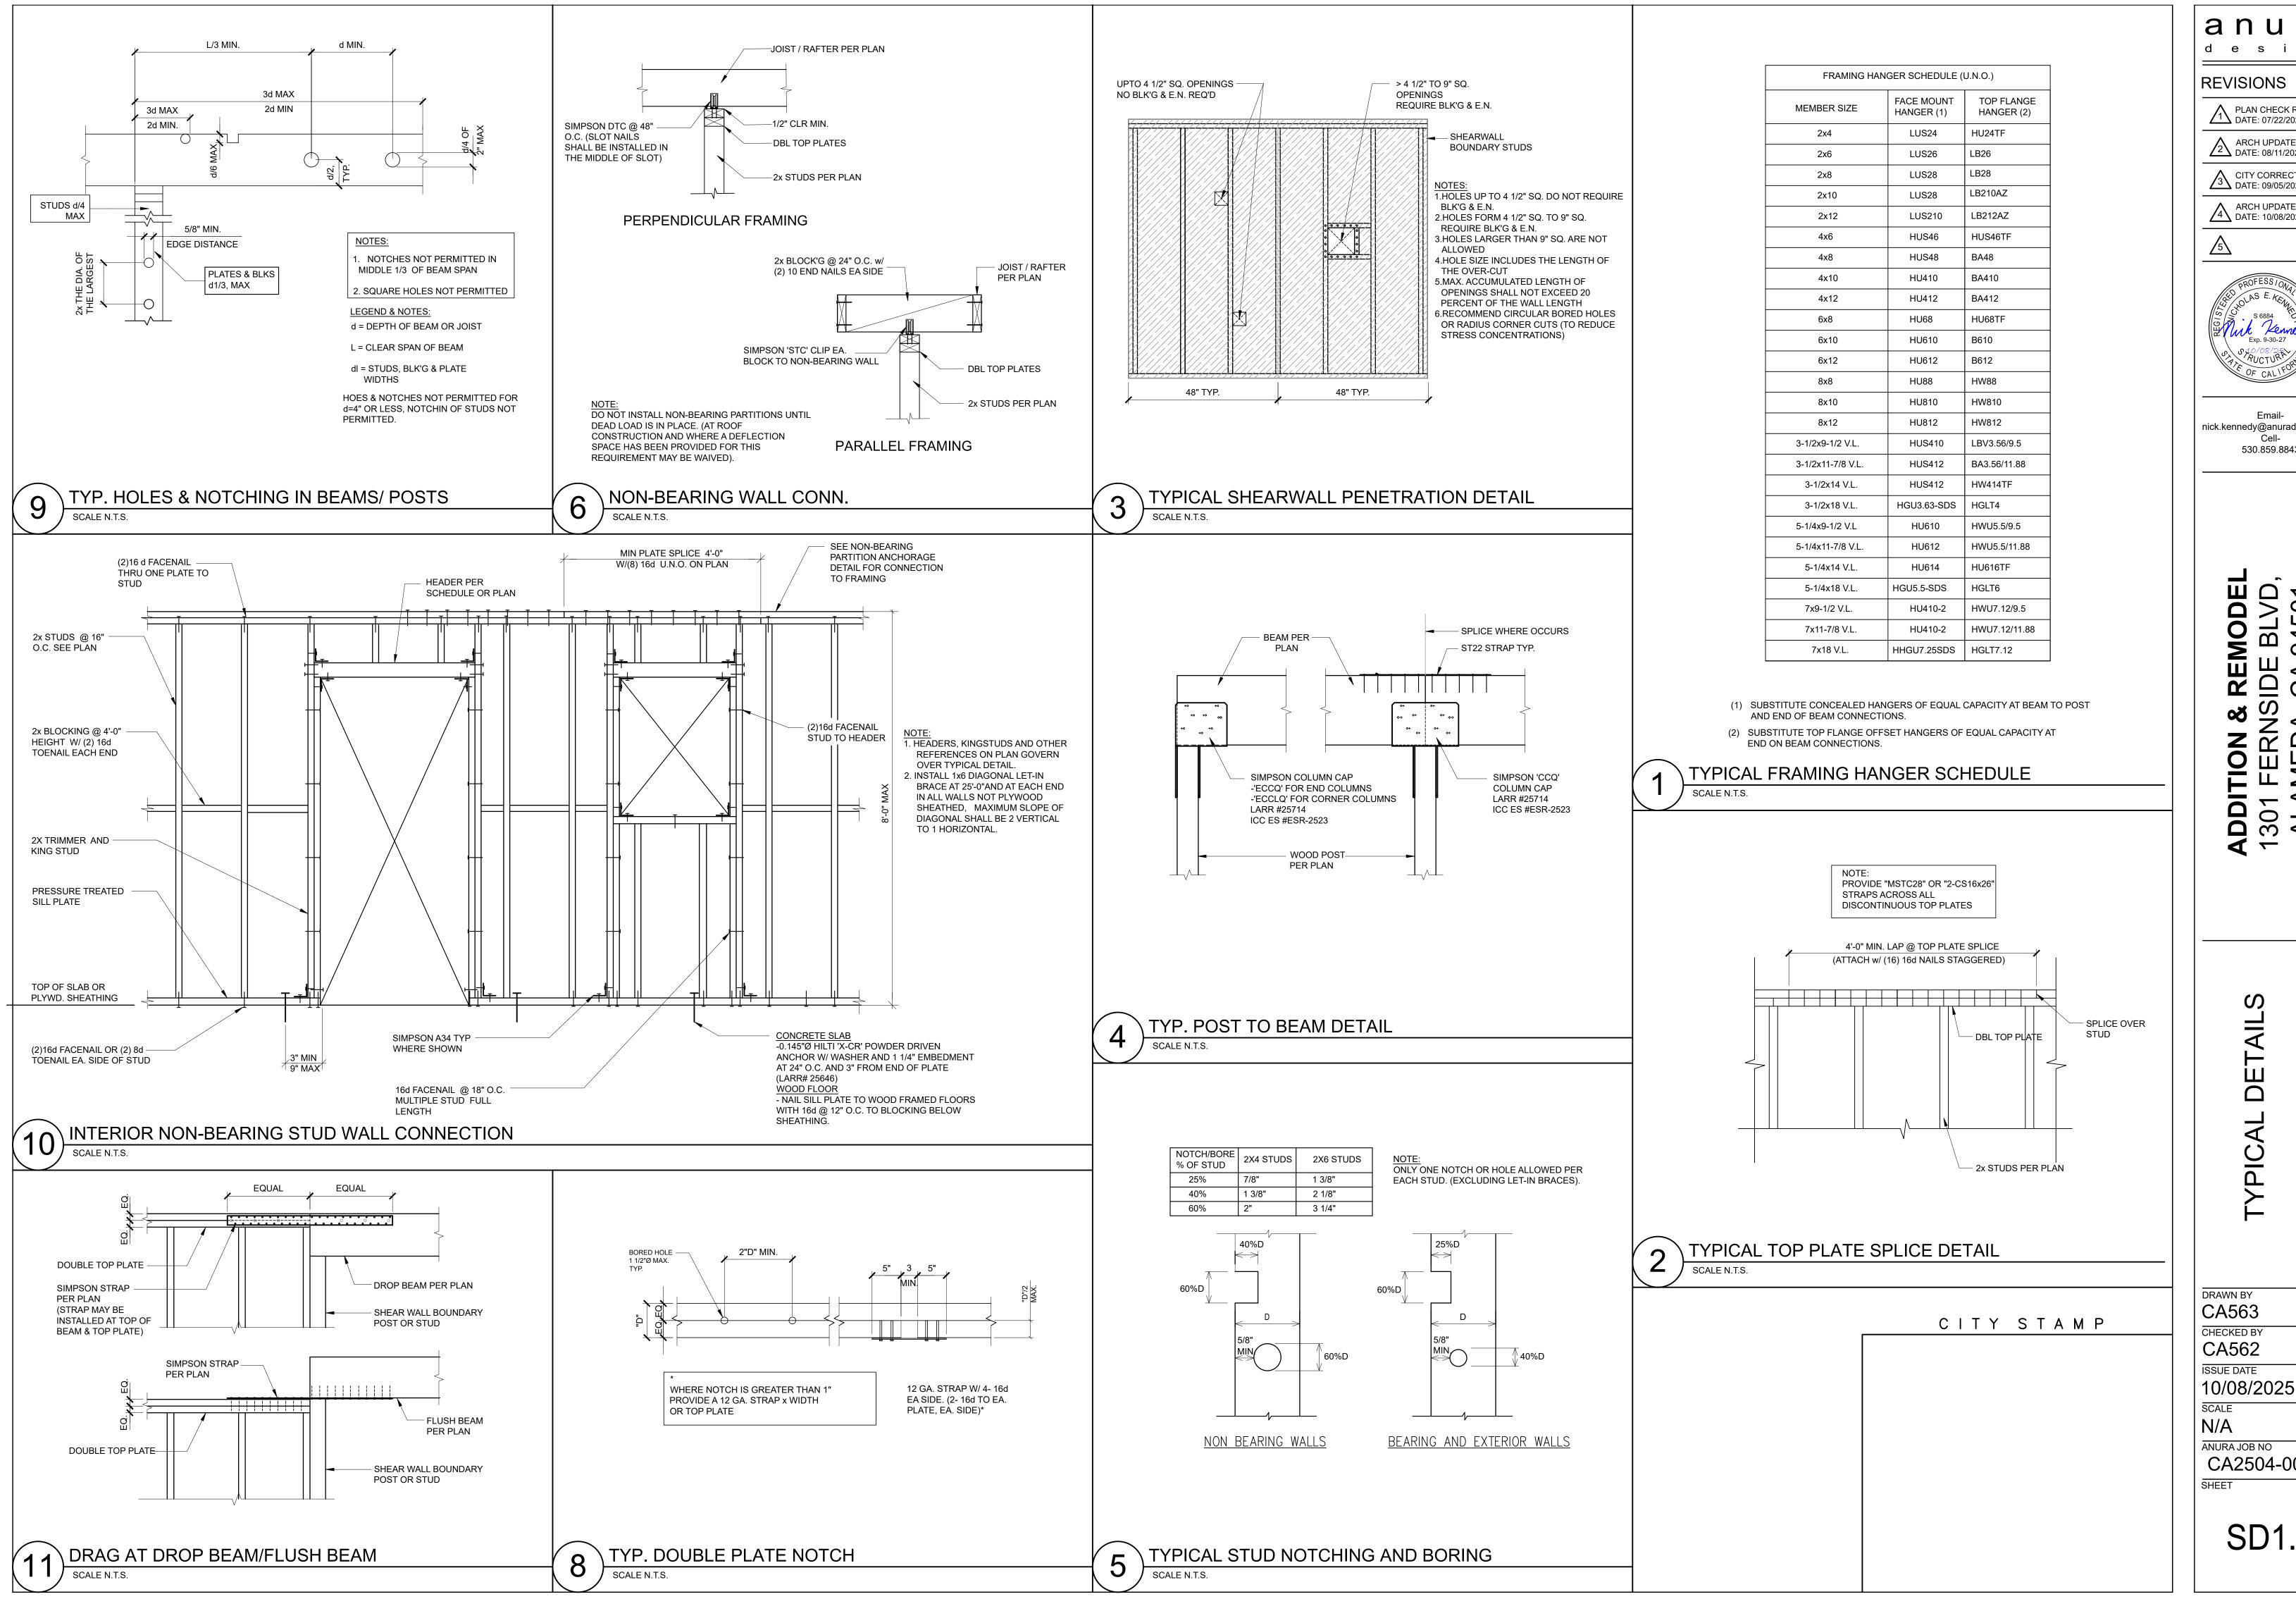


REVISIONS

PLAN CHECK REVISION DATE: 07/22/2025

ARCH UPDATE DATE: 08/11/2025 CITY CORRECTION DATE: 09/05/2025

ARCH UPDATE DATE: 10/08/2025

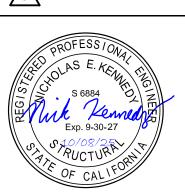

Emailnick.kennedy@anuradesign.com Cell-

530.859.8843

REMODEL SIDE BLVD, CA 94501 ADDITION 301 FERN

DETAIL TYPIC/

4

CA563 CHECKED BY CA562 ISSUE DATE

ANURA JOB NO CA2504-0002

SD1.

