



CITY OF ALAMEDA

BAY FARM ISLAND PUMP STATION REHABILITATION PROJECT

VOLUME 2 - DRAWINGS

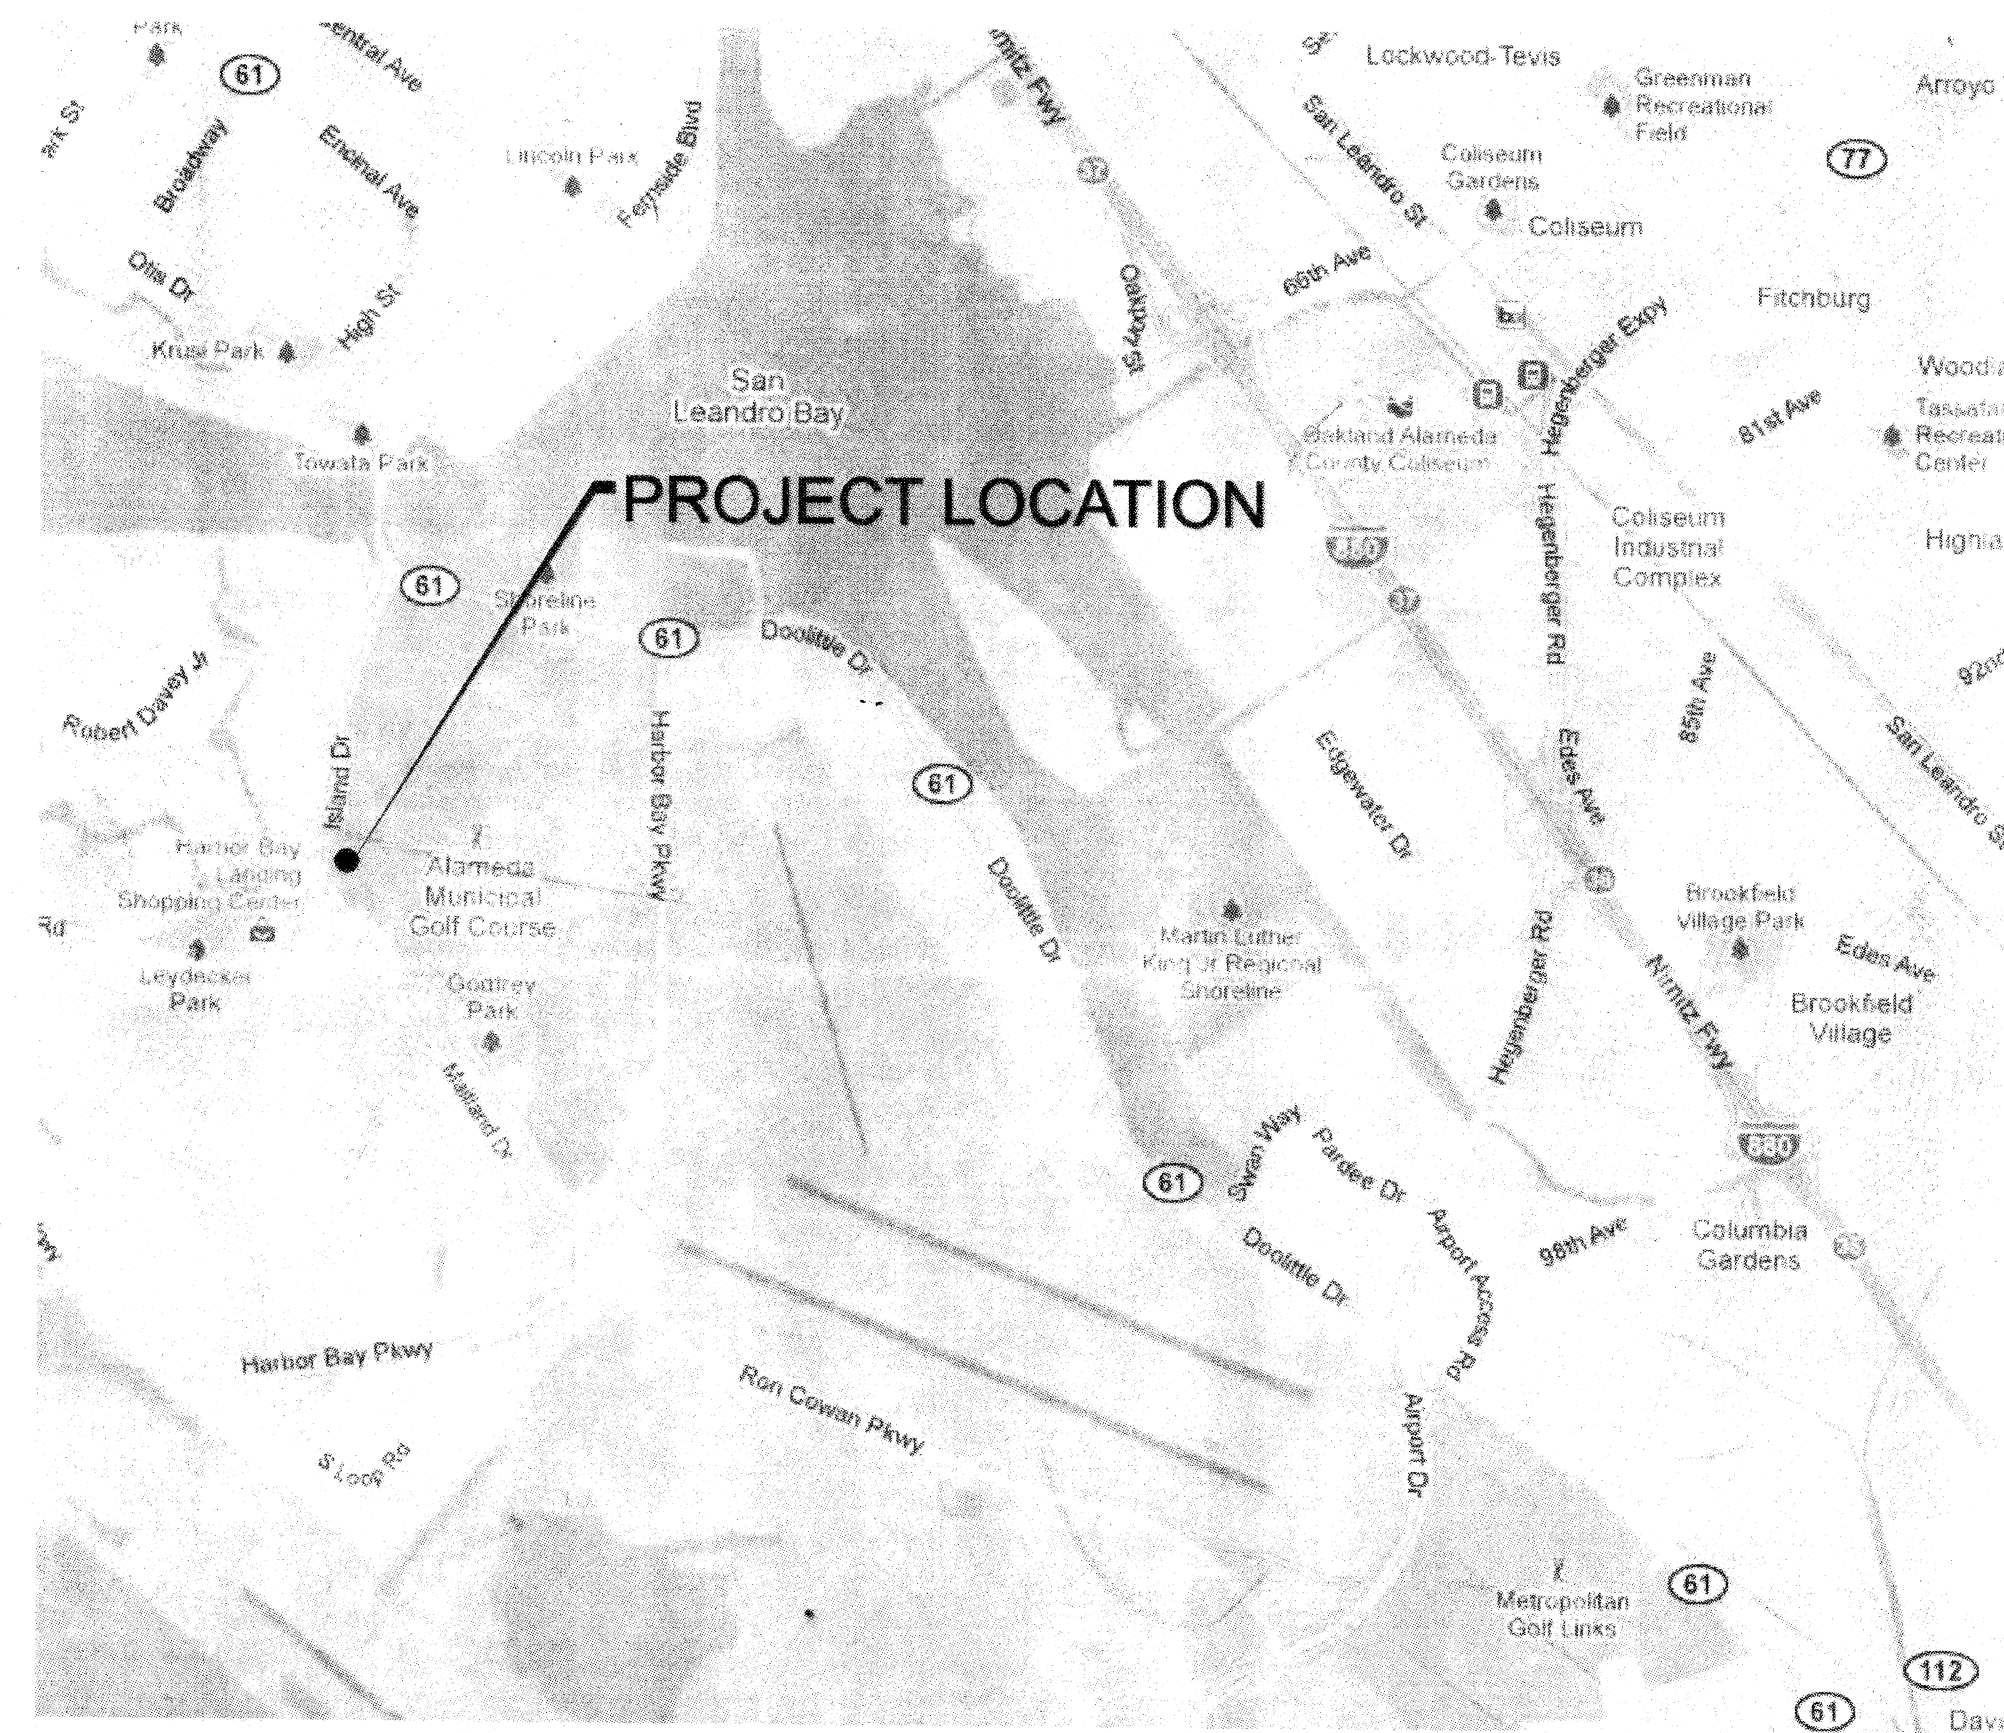

VICINITY MAP
NTS

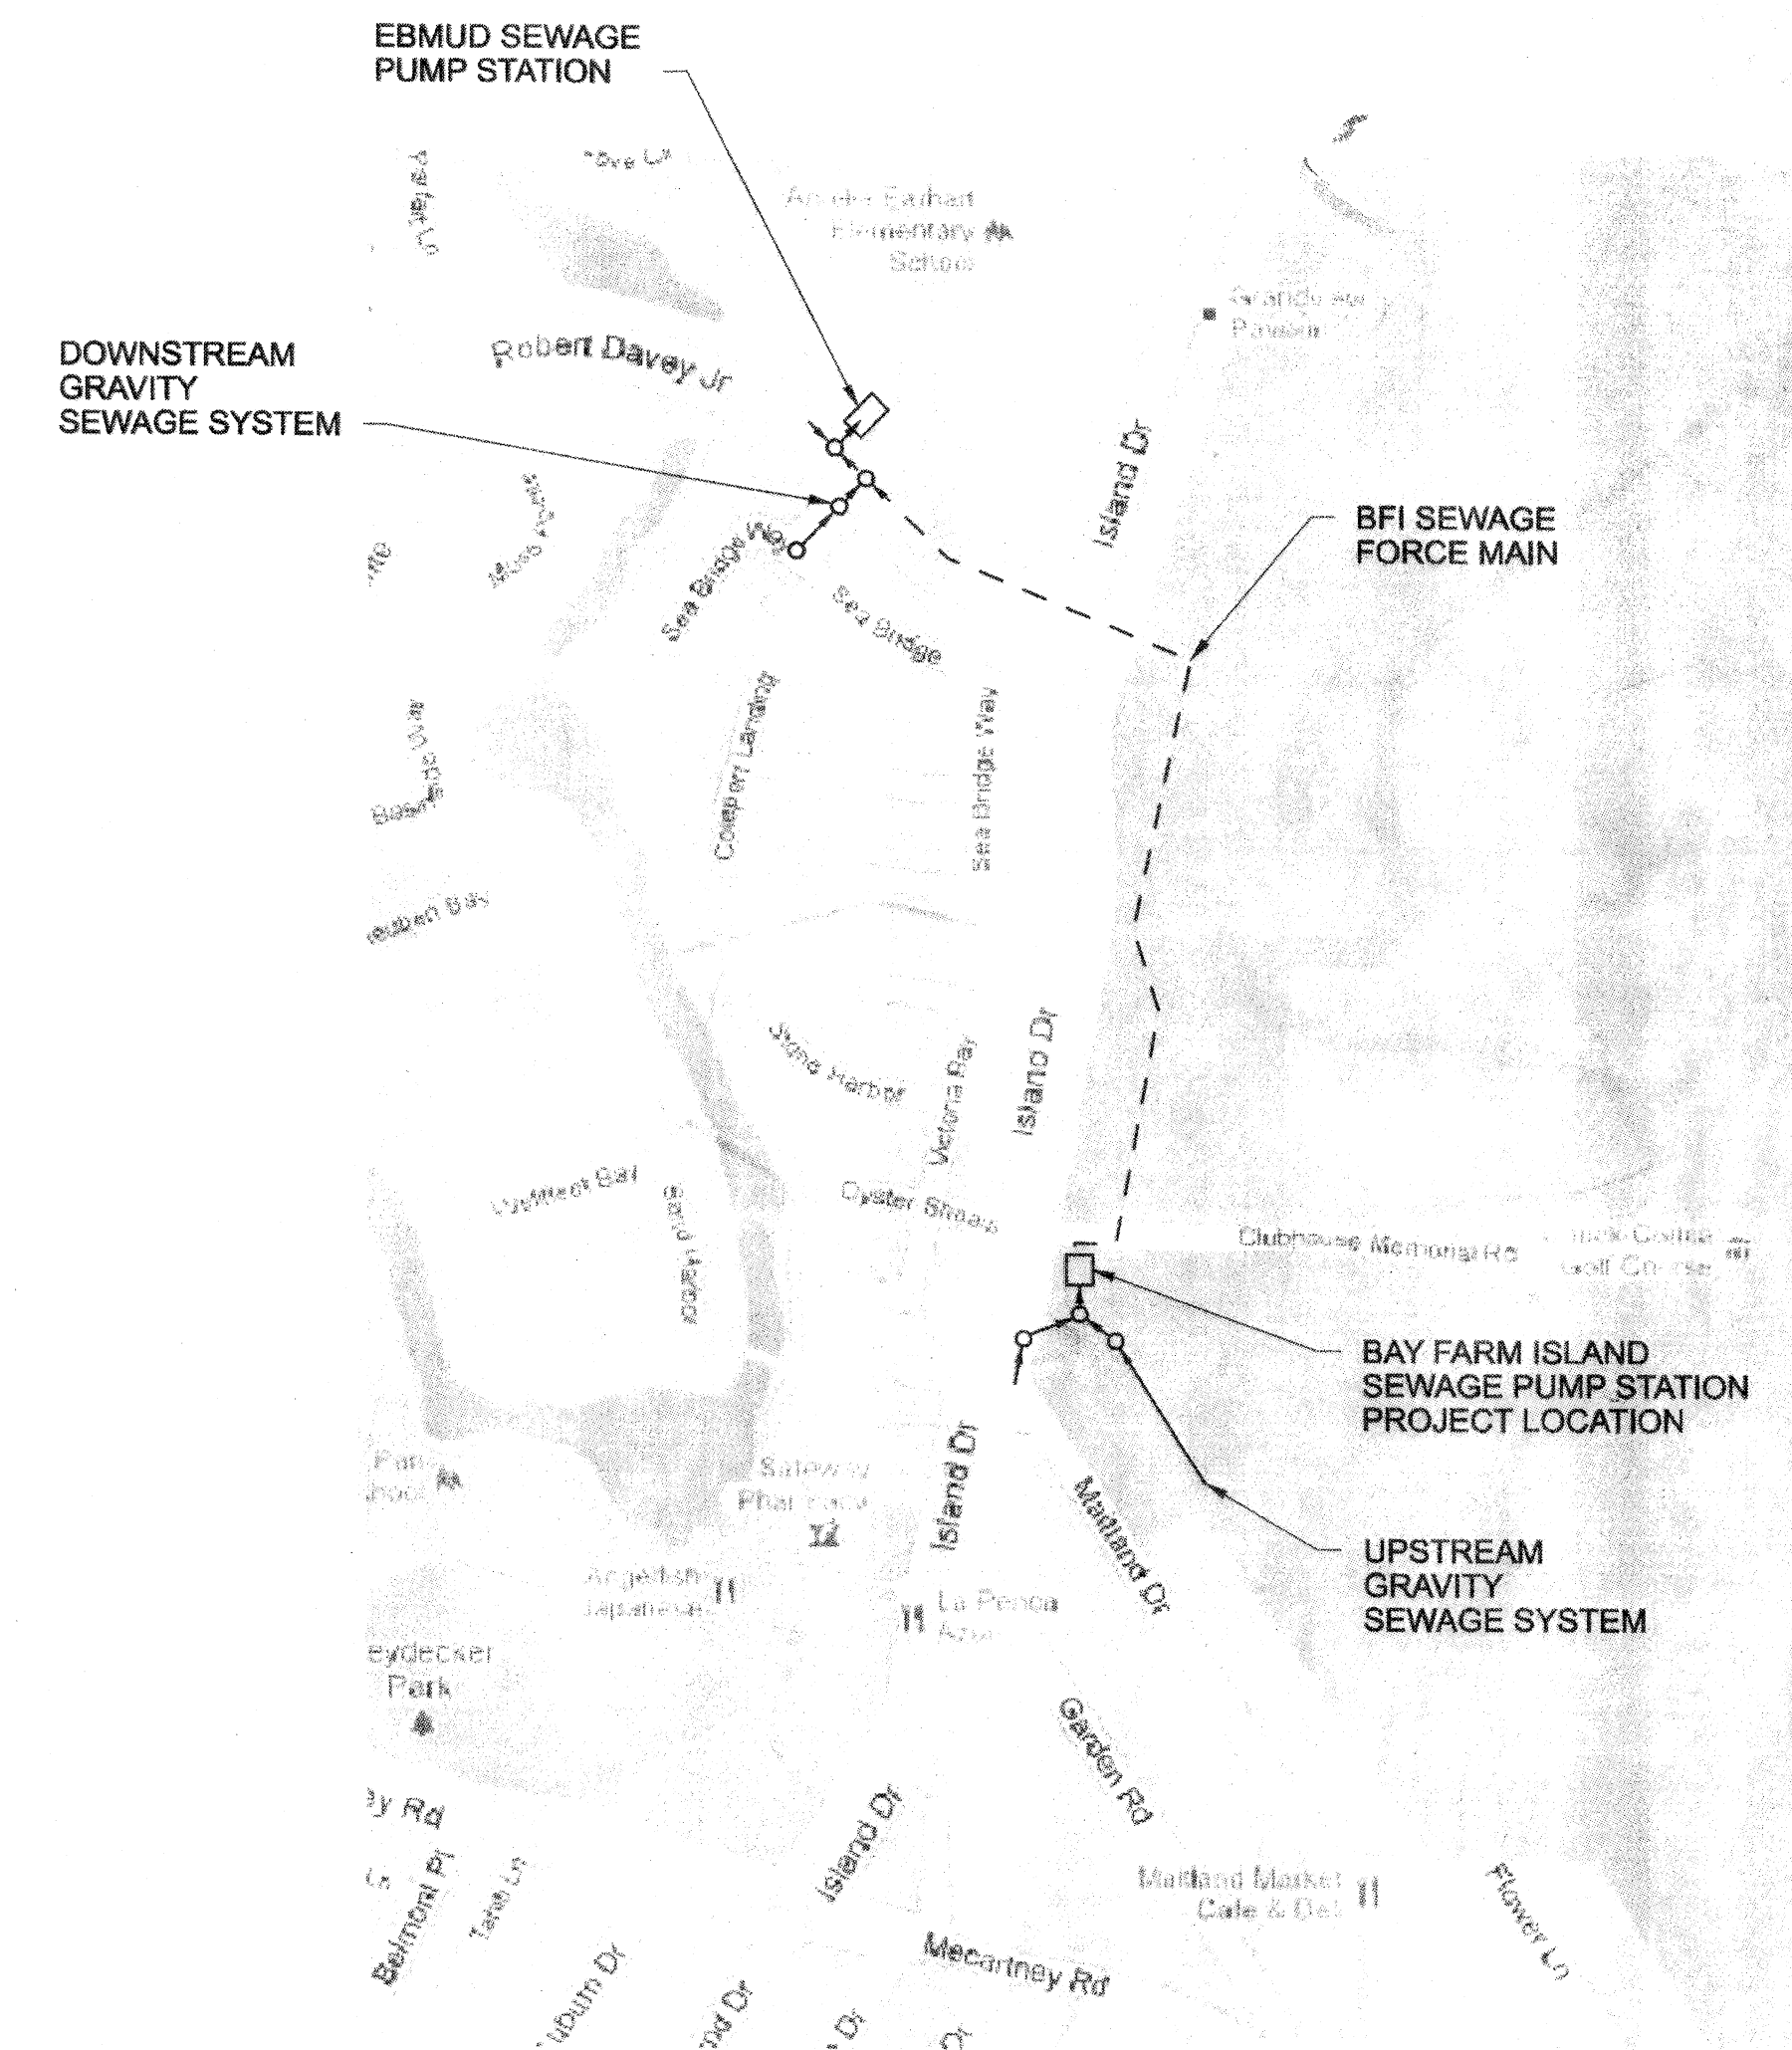

LOCATION MAP
NTS



WATERWORKS
ENGINEERS
JULY 2011



AS-BUILTS
FOR INFORMATION REGARDING
THIS PROJECT CONTACT:
TIMOTHY DURBIN, PE
(510) 428-9590 EXT.112

FILENAME: 1105D-G001.dgn

PLOT DATE: 08-JUL-2011

PLOT TIME: 08:46:08

934-9-95

JOB SITE COPY CB11-0427

INDEX TO DRAWINGS

DRAWING NO.	DESCRIPTION
GENERAL	
G-1	COVER SHEET
G-2	INDEX TO DRAWINGS
G-3	ABBREVIATIONS
G-4	STANDARD DESIGNATIONS
G-5	CIVIL LEGEND
G-6	STRUCTURAL NOTES
G-7	MECHANICAL LEGEND
CIVIL	
C-1	DEMOLITION PLAN
C-2	SITE PLAN
C-3	GRADING AND DRAINAGE PLAN
YARD PIPING	
Y-1	YARD PIPING
PUMP STATION	
D-1	ROOF PLAN
D-2	LOWER PLAN
D-3	PHOTOS
D-4	PHOTOS
D-5	PHOTOS
S-1	JET GROUT PLAN AND ELEVATION
S-2	ROOF PLAN
S-3	LOWER PLAN
S-4	SECTIONS
S-5	SECTION
S-6	DETAILS
M-1	ROOF PLAN
M-2	LOWER PLAN
M-3	SECTIONS
M-4	SECTION
M-5	SECTION
ELECTRICAL	
E01	SYMBOLS AND ABBREVIATIONS
E02	SYMBOLS AND ABBREVIATIONS
E03	PUMP STATION P&ID
E04	ONE-LINE DIAGRAM AND AUXILIARY WIRING DIAGRAMS
E05	CONTROL PEDESTAL ELEVATION AND DETAILS
E06	PUMP ELEMENTARY DIAGRAM
E07	PLC PANEL BACKPAN LAYOUT AND POWER DISTRIBUTION DIAGRAM
E08	PLC WIRING DIAGRAM
E09	SITE PLAN
E10	DETAILS I
E11	DETAILS II
STANDARD DETAILS	
SD-1	DETAILS
SD-2	DETAILS
SD-3	DETAILS
SD-4	DETAILS
SD-5	DETAILS
SD-6	DETAILS


GENERAL NOTE


NO WORK SHALL BE CONCEALED UNTIL AFTER INSPECTION AND APPROVAL BY PROPER AUTHORITIES. IF WORK IS CONCEALED WITHOUT INSPECTION AND APPROVAL, THE CONTRACTOR SHALL BE RESPONSIBLE FOR ALL WORK REQUIRED TO OPEN AND RESTORE THE CONCEALED AREAS IN ADDITION TO ALL REQUIRED MODIFICATIONS. THE CONTRACTOR SHALL OBTAIN AND PAY FOR ALL PERMITS FOR ALL WORK AND SHALL HAVE HIS WORK INSPECTED BY STATE AND LOCAL AGENCIES HAVING APPLICABLE JURISDICTION. CALL 510-747-6800 BETWEEN 7:30 AM TO 8:30 AM TO SCHEDULE ALL INSPECTIONS.



CITY OF ALAMEDA
BAY FARM ISLAND PUMP STATION
REHABILITATION PROJECT

INDEX TO DRAWINGS

GENERAL		INDEX TO DRAWINGS		DATE JULY 2011	
		PROJECT NUMBER 11-005		PROJECT NUMBER 11-005	
		DRAWING NUMBER G-2		DRAWING NUMBER G-2	
		SHEET NUMBER 2		SHEET NUMBER 2	
		CITY OF ALAMEDA BAY FARM ISLAND PUMP STATION REHABILITATION PROJECT		WATERWORKS ENGINEERS 5767 Broadway #201 • Oakland, CA 94618 • 510-428-9590	
					
		DESIGN T DURBIN		BAR IS ONE INCH ON ORIGINAL DRAWING.	
		DRAWN J MARTIN		0 1"	
		CHECKED M FISHER		IF NOT ONE INCH ON THIS SHEET, ADJUST SCALES ACCORDINGLY.	
		APPROVED J GESELBRACHT			

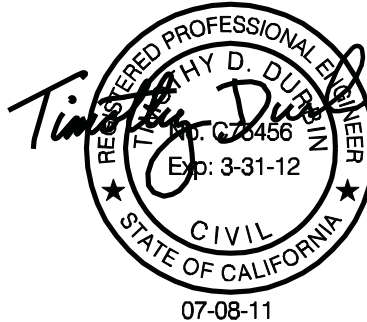

ABBREVIATIONS

@	AT	CU FT	CUBIC FOOT	HD	HUB DRAIN	PREFAB	PREFABRICATED	T	TANGENT, TELEPHONE LINE, TOP
AB	ANCHOR BOLT, AGGREGATE BASE	CU IN	CUBIC INCH	HDPE	HIGH DENSITY POLYETHYLENE PIPE	PRESS	PRESSURE	TBG	TUBING
AC	ASPHALTIC CONCRETE	CU YD	CUBIC YARD	HDR	HEADER	PRC	POINT OF REVERSE CURVE	T&B	TOP AND BOTTOM
ACI	AMERICAN CONCRETE INSTITUTE	CULV	CULVERT	HDW	HARDWARE	PRI	PRIMARY	TC	TOP OF CURB, TOP OF CONCRETE
ADD	ADDITIONAL	CV	CHECK VALVE	HGT	HEIGHT	PROP	PROPERTY	TCE	TEMPORARY CONSTRUCTION EASEMENT
ADH AB	ADHESIVE ANCHOR BOLT	°C	CELSIUS	HM	HOLLOW METAL	PRV	PRESSURE RELEASE VALVE	TDH	TOTAL DYNAMIC HEAD
ADJ	ADJACENT, ADJUSTABLE	d	PENNY	HORIZ	HORIZONTAL	PSF	POUNDS PER SQUARE FOOT	TECH	TECHNICAL
AFF	ABOVE FINISH FLOOR	DBA	DEFORMED BAR ANCHOR	HP	HORSEPOWER	PS	PUMP STATION	TEL	TELEPHONE
AFG	ABOVE FINISH GRADE	DR	DRAIN	HPT	HIGH POINT	PSI	POUNDS PER SQUARE INCH	TEMP	TEMPORARY, TEMPERATURE
AHP	AIR: HIGH PRESSURE	DBL	DOUBLE	HR	HANDRAIL	PSIG	POUNDS PER SQUARE INCH, GAUGE	TF	TOP FACE
AISC	AMERICAN INSTITUTE OF STEEL CONSTRUCTION	DEC	DECANT	HSS	HOLLOW STRUCTURE STEEL	PT	POINT OF TANGENCY	T&G	TONGUE AND GROOVE
AL, ALUM	ALUMINUM	DET	DETAIL	HV	HOSE VALVE	P.U.E.	PUBLIC UTILITY EASEMENT	THD	THREAD
ALP	AIR LOW PRESSURE	DIA	DIAMETER	HWY	HIGHWAY	PV	PLUG VALVE	THK	THICK
ALTN	ALTERNATE	DIAG	DIAGONAL	HYD	HYDRANT	PVC	POLYVINYL CHLORIDE PLASTIC	TP	TURNING POINT, TEST PIT
ANSI	AMERICAN NATIONAL STANDARDS INSTITUTE	DIL	DILUTE	I&C	INSTRUMENTATION & CONTROL	PVCGS	POINT OF VERTICAL CURVE	TRANS	TRANSITION
APPROX	APPROXIMATE	DI	DROP INLET, DUCTILE IRON	ID	INSIDE DIAMETER	PVCW	POLYVINYL CHLORIDE PLASTIC- GRAVITY SEWER TYPE	TRANSV	TRANSVERSE
APVD	APPROVED	DIL	DIMENSION	IF	INSIDE FACE	PVMT	POLYVINYL CHLORIDE PLASTIC- WATER DISTRIBUTION SERVICE TYPE	TS	TUBE STEEL
APWA	AMERICAN PUBLIC WORKS ASSOCIATION	DIMJ	DUCTILE IRON MECHANICAL JOINT	IN	INCH	PVT	PAVEMENT	TST	TOP OF STEEL
ARCH, A	ARCHITECTURAL	DIP	DUCTILE IRON PIPE	INFL	INFLUENT	PW	POTABLE WATER	TT	THRUST TIE
ARV	AIR RELEASE VALVE	DIPPL	DUCTILE IRON PIPE, POLYETHYLENE LINED	INSTM	INSTRUMENTATION			TW	TOP OF WALL
ASTM	AMERICAN SOCIETY FOR TESTING AND MATERIALS	DIR	DIRECTION	INSUL	INSULATE, INSULATION			TWS	TRACER WIRE STATION
AUTO	AUTOMATIC	DIST	DISTANCE	INV	INVERT			TYP	TYPICAL
AUX	AUXILIARY	DN	DOWN	INVERT EL	INVERT ELEVATION			t, T	THICKNESS
AV	AIR/VACUUM ASSEMBLY	do	DITTO	IP	IRON PIPE	R, RAD	RADIUS	UBC	UNIFORM BUILDING CODE
AVE	AVENUE	DWG	DRAWING	IR	IRON ROD	RC	REINFORCED CONCRETE	UD	UNDERDRAIN
AWG	AMERICAN WIRE GAGE			JT	JOINT	RCP	REINFORCED CONCRETE PIPE	UG	UNDERGROUND
AWWA	AMERICAN WATER WORKS ASSOCIATION			KIP	THOUSAND POUNDS	RD	ROAD, ROOF DRAIN	UH	UNIT HEATER
				KW	KILOWATT	RDCR	REDUCER	UNK	UNKNOWN
						REF	REFER OR REFERENCE	UNO	UNLESS NOTED OTHERWISE
						REINF	REINFORCED, REINFORCING, REINFORCE		
B	BORING	E	EAST, ELECTRIC, ELECTRICAL			REQD	REQUIRED	V	VENT, VOLT, VALVE
BC	BEGIN CURVE, BOTTOM OF CURB	EA	EACH			RJ	RESTRAINED JOINT	VAC	VACUUM
BF	BLIND FLANGE, BOTTOM FACE	EC	END CURVE	L	LEFT, ANGLE, LENGTH	RLS	RUBBER LINED STEEL	VAR	VENT ACID RESISTANT
BFD	BUTTERFLY VALVE DAMPER	ECC	ECCENTRIC	LAB	LABORATORY	RM	ROOM	VC	VERTICAL CURVE
BFV	BUTTERFLY VALVE	EF	EACH FACE, EXHAUST FAN	LAT'L	LATERAL	RMJ	RESTRAINED MECHANICAL JOINT	VERT	VERTICAL
BLDG	BUILDING	EFL	EFFLUENT	LB	POUNDS	RO	ROUGH OPENING	VPI	VERTICAL POINT OF INTERSECTION
BLM	BUREAU OF LAND MANAGEMENT	EJ	EXPANSION JOINT	LB/CU FT	POUNDS PER CUBIC FOOT	RP	RADIUS POINT	VPS	VENEER PLASTER SYSTEM
BM	BENCH MARK, BEAM	EL	ELEVATION	LF	LINEAR FEET	R/R	REMOVE AND REPLACE	VTR	VENT THRU ROOF
BO	BLOW OFF	ELB, ELL	ELBOW	LG	LONG	RST	REINFORCING STEEL		
BOO	BOTTOM OF OPENING	ELC	ELECTRICAL LOAD CENTER	LONG	LONGITUDINAL	RT	RIGHT	W/	WITH
BOT	BOTTOM	ELEC	ELECTRIC, ELECTRICAL	LP	LOW POINT	RTN	RETURN	W	WIDE FLANGE (BEAM), WEST, WATER
BRG	BEARING	ENGR	ENGINEER	LR	LONG RADIUS	RV	ROOF VENT	WC	WATER CLOSET
BV	BALL VALVE	EO	EMERGENCY OVERFLOW			RW	RAW WATER	WD	WOOD
BVC	BEGINNING OF VERTICAL CURVE	EP	EDGE OF PAVEMENT			R/W	RIGHT-OF-WAY	WH	WATER HEATER
BYP	BYPASS	EQL SP	EQUALLY SPACED					WM	WATER METER
		EQPT	EQUIPMENT					WR	WATER RESISTANT
		ESC	EROSION SEDIMENT CONTROL	MAX	MAXIMUM			WS	WATER SURFACE, WATER STOP
		ERW	EFFLUENT REUSE WATER	MCC	MOTOR CONTROL CENTER	S	I-BEAM, SOUTH, SLOPE	W SH ST	WEATHERING SHEET STEEL
		ESA	ENVIRONMENTALLY SENSITIVE AREA	MCJ	MASONRY CONTROL JOINT	S =	SLOPE EQUALS	WSP	WELDED STEEL PIPE
C to C, CC	CENTER TO CENTER	EVC	END OF VERTICAL CURVE	MECH	MECHANICAL	SA	SAMPLE	WT	WATER TIGHT
C	CHANNEL (BEAM)	EW	EACH WAY	MFR	MANUFACTURER	SAT	SUSPENDED ACOUSTIC TILE	WTR	WATER
CAA/ARV	COMBINATION AIR ADMISION/ AIR RELEASE VALVE	EWEF	EACH WAY, EACH FACE	MGD	MILLION GALLONS PER DAY	SC	SCUM	WW	WASHWATER
CARV	COMBINATION AIR RELEASE VALVE	EXC	EXCAVATE	MH	MANHOLE	SCFH	STANDARD CUBIC FEET PER HOUR	WWF	WELDED WIRE FABRIC
CATH	CATHODIC PROTECTION	EXP	EXPOSED, EXPANSION	MIN	MINIMUM, MINUTE	SCFM	STANDARD CUBIC FEET PER MINUTE		
CATV	CABLE TELEVISION	EXP JT	EXPANSION JOINT	MISC	MISCELLANEOUS	SCH	SCHEDULE	YD	YARD
CB	CATCH BASIN	EXST	EXISTING	MJ	MECHANICAL JOINT	SD	STORM DRAIN		
CCP	CONCRETE CYLINDER PIPE			MPH	MILES PER HOUR	SE	SOUTHEAST		
CCS	CENTRAL CONTROL SYSTEM			MSNRY	MASONRY	SEC	SECONDARY		
CFM	CUBIC FEET PER MINUTE	FB	FLAT BAR	MSP	MILL STEEL PIPE, MANUAL OF STANDARD PRACTICE	SECT	SECTION		
CFS	CUBIC FEET PER SECOND	FC	FLEXIBLE COUPLING			SH	SHEET		
CHEM	CHEMICAL	FCA	FLANGED COUPLING ADAPTER			SIM	SIMILAR		
CI	CAST IRON	FCO	FLOOR CLEAN OUT			SLD	SLUDGE		
CIGC	CAST IRON GROOVED COUPLING	FD	FLOOR DRAIN	MTL	MATERIAL	SLP	SLOPE		
CIMJ	CAST IRON MECHANICAL JOINT	FDA	FLOOR DRAIN W/INTEGRAL TRAP	MWS	MAXIMUM WATER SURFACE	SOLN	SOLUTION		
CIP	CAST IRON PIPE	FDN	FOUNDATION			SP	SPACE OR SPACES		
CIRJ	CAST IRON RESTRAINED JOINT	FES	FLARED END SECTION	N	NORTH	SPD	SUMP PUMP DRAIN		
CISP	CAST IRON SOIL PIPE	FEXT	FIRE EXTINGUISHER	NC	NORTHWEST	SPEC	SPECIFICATIONS		
CJ	CONSTRUCTION JOINT, CONTRACTION JOINT	FF	FINISH FLOOR	NE	NORTHEAST	SPLY	SUPPLY		
CLDIP	CEMENT-LINED DUCTILE IRON PIPE	FG	FINISH GRADE	NIC	NOT IN CONTRACT	SQ	SQUARE		
CLG	CEILING	FHY	FIRE HYDRANT	NO	NUMBER, NUMBERING	SQ FT	SQUARE FOOT		
CLR	CLEAR, CLEARANCE	FIG	FIGURE	NPT	NATIONAL PIPE THREAD	SQ IN	SQUARE INCH		
CLSM	CONTROLLED LOW STRENGTH MATERIAL	FL	FLOOR, FLOW LINE	NTS	NOT TO SCALE	SS	SANITARY SEWER		
CL	CENTERLINE	FLG	FLANGE	NW	NORTHWEST	SSH	SAFETY SHOWER		
CML, CSP	CONCRETE MORTAR LINED AND COATED STEEL PIPE	FLH	FLAT HEAD			SST	STAINLESS STEEL		
		FLL	FLOW LINE			ST	STRAIGHT, STREET		
CMLSP	CEMENT MORTAR LINED STEEL PIPE	FLTR	FILTER			STA	STATION		
CMP	CORRUGATED METAL PIPE	FNH	FINISH	OC	ON CENTER	STD	STANDARD		
CMU	CONCRETE MASONRY UNIT	FOC	FACE OF CONCRETE	OD	OUTSIDE DIAMETER, OVERFLOW DRAIN	STIF	STIFFENER		
CO	CLEANOUT	FRP	FIBERGLASS REINFORCED PLASTIC	OF	OUTSIDE FACE, OVERFLOW	STL	STEEL, STEEL PIPE		
COL	COLUMN	FT	FOOT OR FEET	OFR	OVERFLOW RETURN	STLS	STEEL PIPE (SPECIAL)		
COM	COMMUNICATION	FTG	FOOTING	OG	ORIGINAL GROUND	STR	STRAIGHT		
COMB	COMBINED	FWD	FORWARD	OHE	OVERHEAD ELECTRIC	STRL	STRUCTURAL		
CONC	CONCRETE	°F	DEGREE FAHRENHEIT	OMRF	ORDINARY MOMENT RESISTING FRAME	SUBFL	SUBFLOOR		
CONN	CONNECTION			O TO O	OUT TO OUT	SUSP	SUSPEND		
CONT	CONTINUOUS, CONTINUATION	G	GAS	OPNG	OPENING	SW	SOUTHWEST		
COORD	COORDINATE	GAL	GALLON	OPP	OPPOSITE	SYMM	SYMMETRICAL		
CU	COPPER	GALV	GALVANIZED	OZ	OUNCE				
CPLG	COUPLING	GB	GRADE BREAK	PC	POINT OF CURVE				
CTD	CENTERED	GC	GROOVED COUPLING	PE	PLAIN END, POLYETHYLENE AND PERMANENT EASEMENT				
CTR	CENTER	GCO	GRADE CLEAN OUT						
		GCF	GROOVED COUPLING FITTING						
		GE	GROOVED END	PENT	PENETRATION				
		GL	GLASS	PI	POINT OF INTERSECTION				
		GPD	GALLONS PER DAY	PJF	PREMOLDED JOINT FILLER				
		GPH	GALLONS PER HOUR	PL	PLATE, PROPERTY LINE				
		GPM	GALLONS PER MINUTE	PLYWD	PLYWOOD				
		GRTG	GRATING	POB	POINT OF BEGINNING				
		GSP	GALVANIZED STEEL PIPE	POC	POINT OF CONNECTION				
		GV	GATE VALVE	POE	POINT OF ENDING				
		GVL	GRAVEL	PP, P&P	PLAN AND PROFILE, POWER POLE				
		GW	GROUND WATER	PPM	PARTS PER MILLION				
				PRC	POINT OF REVERSE CURVE				
				PRCST	PRECAST				
				PREFAB	PREFABRICATED				


WATERWORKS
ENGINEERING & SURVEYING
5767 Broadway #201 • Oakland, CA 94618 • 510-423-9590



CITY OF ALAMEDA
BAY FARM ISLAND PUMP STATION
REHABILITATION PROJECT

ABBREVIATIONS

- NOTES
- FOR ELECTRICAL AND INSTRUMENTATION ABBREVIATIONS, SEE ELECTRICAL AND INSTRUMENTATION DRAWINGS.
 - CONTACT THE ENGINEER FOR ABBREVIATIONS NOT LISTED.
 - THIS IS A STANDARD LEGEND SHEET, THEREFORE, SOME SYMBOLS OR ABBREVIATIONS MAY APPEAR ON THIS SHEET AND MAY NOT BE UTILIZED ON THIS PROJECT.

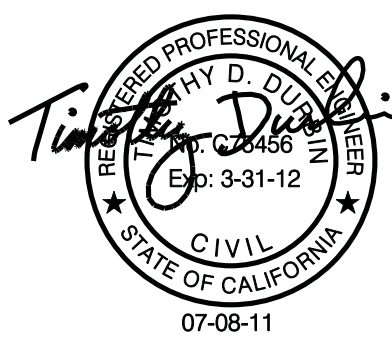


DATE
JULY 2011
PROJECT NUMBER
11-005
DRAWING NUMBER
G-3
SHEET NUMBER 3



DISCIPLINE

LETTER	DISCIPLINE
G	GENERAL
D	DEMOLITION
C	CIVIL
A	ARCHITECTURAL
S	STRUCTURAL
M	MECHANICAL
H	HEATING, VENTILATION AND COOLING
P	PLUMBING
E	ELECTRICAL
N	INSTRUMENTATION
Y	YARD PIPING

DRAWING NUMBER

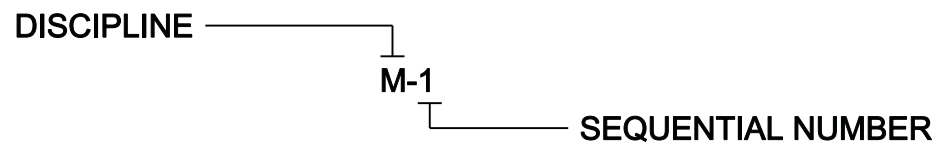

SECTION

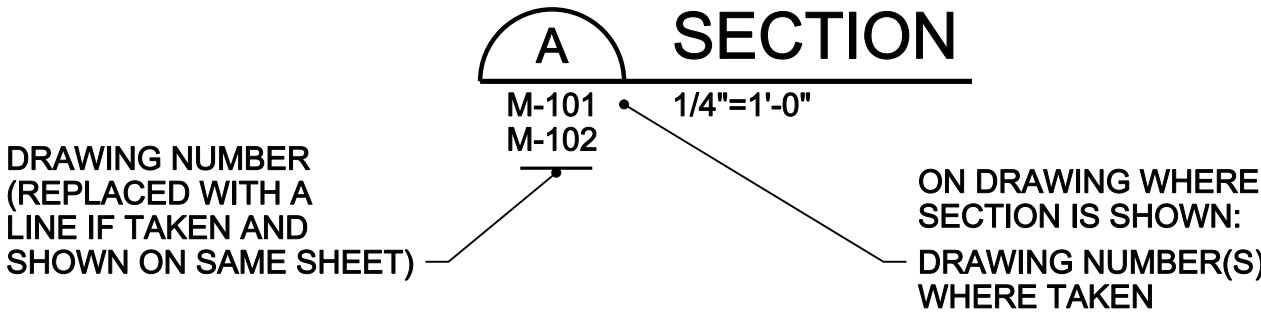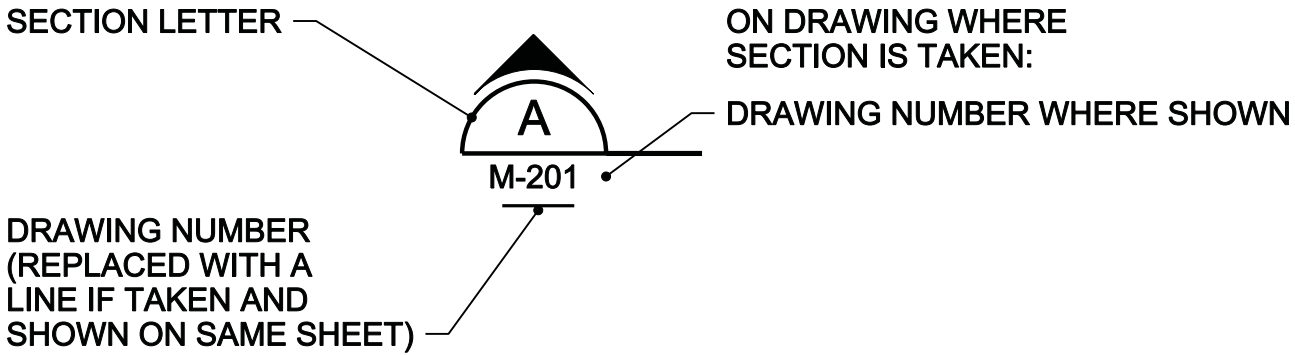

DETAIL



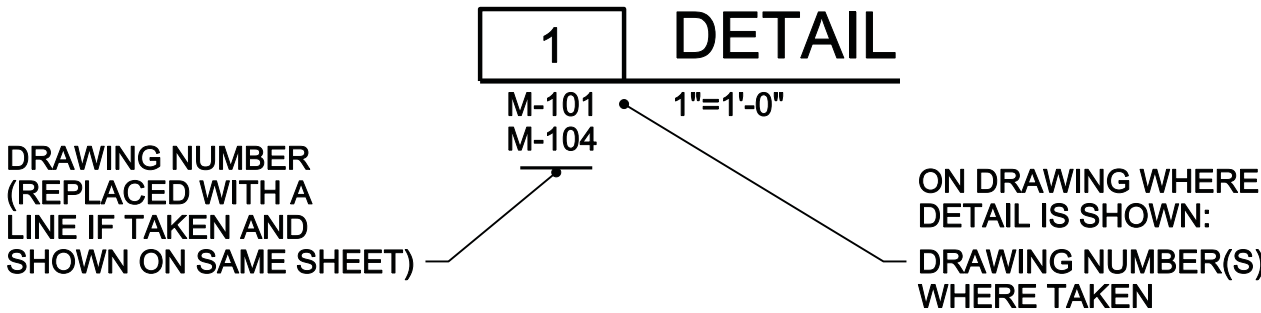


PHOTO OR ELEVATION

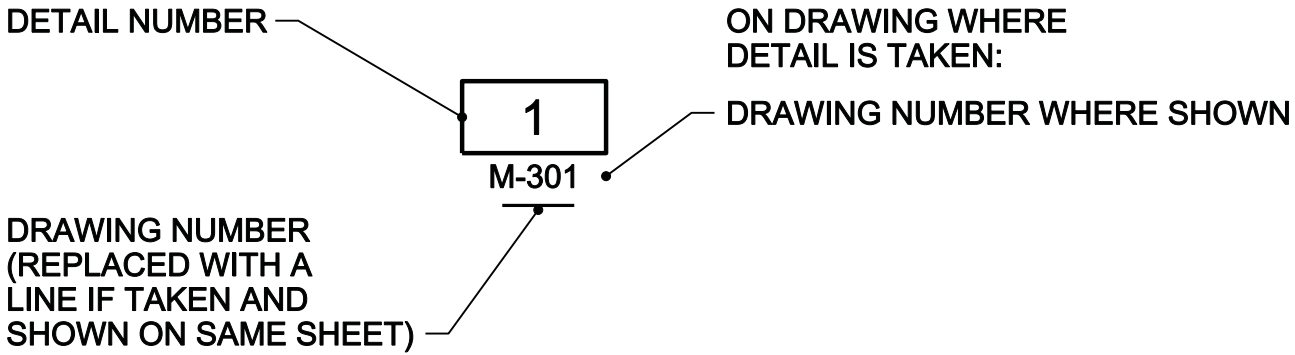


STANDARD DETAIL

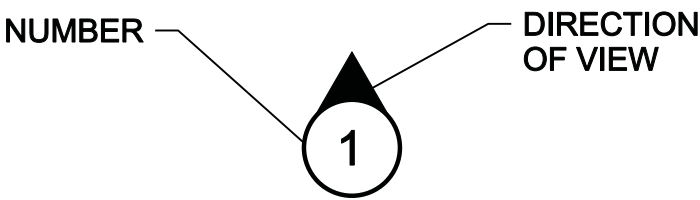

NOTES:

1. STANDARD DETAIL CALLOUTS ARE SHOWN TO INDICATE DETAIL REQUIRED AT SPECIFIC LOCATIONS. DETAILS ARE NOT CALLED OUT AT ALL LOCATIONS. WHERE A STANDARD DETAIL CALLOUT IS NOT SHOWN, THE CONTRACTOR SHALL USE THE STANDARD DETAIL MOST APPLICABLE AND CONSISTENT WITH OTHER WORK UNDER THIS CONTRACT.


STANDARD VALVE AND OPERATION

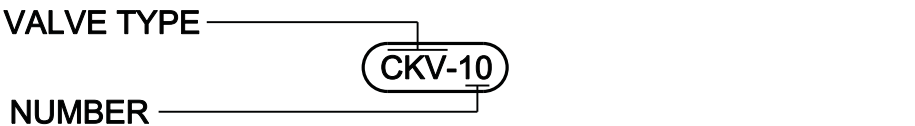

NOTES:

1. SEE SPECIFICATION SECTION 15200.


UNIQUE VALVE AND OPERATOR

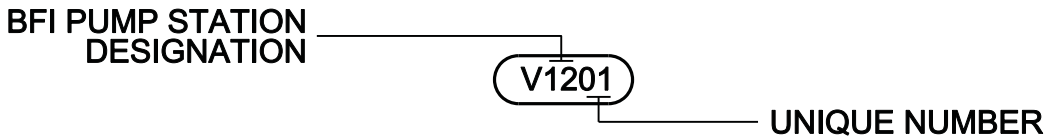

NOTES:

1. SEE SPECIFICATION SECTION 15200 FOR VALVE SCHEDULE.


EQUIPMENT DESIGNATION

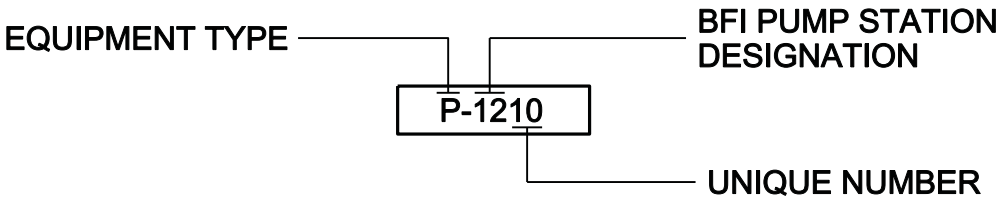

LINE TYPE APPEARANCE

———	BLACK	NEW 'ON' DISCIPLINE
———	LIGHT OR MEDIUM GRAY OR SCREENED	EXISTING 'ON' OR 'OFF' DISCIPLINE
———	DARK GRAY	NEW 'OFF' DISCIPLINE

GENERAL SYMBOLOGY

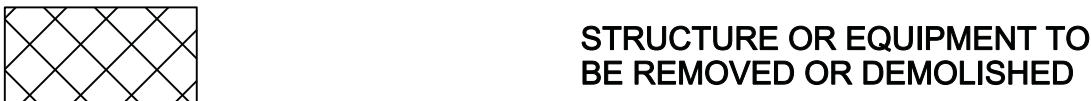


WATERWORKS
ENGINEERS
5767 Broadway #201 • Oakland, CA 94618 • 510-428-5590



CITY OF ALAMEDA
BAY FARM ISLAND PUMP STATION
REHABILITATION PROJECT

GENERAL
STANDARD DESIGNATIONS

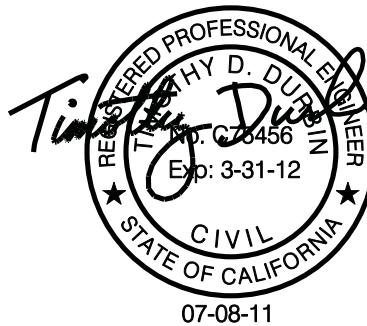

DATE	JULY 2011
PROJECT NUMBER	11-005
DRAWING NUMBER	G-4
SHEET NUMBER	4

CIVIL LEGEND

	SPOT ELEVATION
	CONTOUR LINE
	CUT SLOPE (HORIZ:VERT)
	EMBANKMENT - FILL SLOPE (HORIZ:VERT)
	DRAINAGEWAY OR DITCH
	DIRECTION OF FLOW
	CENTER LINE, BUILDING, ROAD
	PROPERTY LINE
	RIGHT OF WAY, EASEMENT OR SETBACK
	STAGING OR WORK AREA LIMITS
	STRUCTURE, BUILDING OR FACILITYLOCATION POINT COORDINATES
	STRUCTURE, BUILDING OR FACILITY
	RETAINING WALL
	CONCRETE CURB
	ARCHITECTURAL FENCE
	GUARD RAIL/BARRICADE
	CHAIN LINK FENCE WITH 3 STRAND BARBED WIRE TOPPING
	WIRE FENCE
	BARBED WIRE
	SINGLE SWING GATE
	DOUBLE SWING GATE
	SLIDING GATE
	CULVERT
	WALL
	BRUSH/TREE LINE
	TREE
	DEMOLITION
	AUTOMATIC AIR RELEASE VALVE
	MANUAL AIR RELEASE VALVE

	BEDROCK
	ROCKS OR RIPRAP
	SAND
	AGGREGATE BASE
	NATURAL SOIL
	COMPACTED SOIL
	CONCRETE
	GROUT
	CONTROLLED LOW STRENGTH MATERIAL (CLSM)
	PAVEMENT
	GRATING

MAPPING LEGEND

	AIR RELEASE VALVE		REBAR
	ASPHALT PAVEMENT		RIGHT-OF-WAY
	BOLLARD		SEWER CLEANOUT
	CABLE TELEVISION		SEWER MANHOLE
	CATCH BASIN		SOLAR PANEL
	ELECTRIC METER		STORM DRAIN MANHOLE
	ELECTRIC PULLBOX		STREET SIGN
	ELECTRIC RISER		SURVEY CONTROL POINT OR POINT OF INTERSECTION
	ELECTRIC SWITCHBOX		TELEPHONE BOX
	ELECTRIC TRANSFORMER		TRAFFIC CONTROL BOX
	FIRE HYDRANT		TRAFFIC SIGNAL BOX
	GAS VALVE		TRAFFIC SIGNAL WITH ARM
	GRAY PVC CONDUIT PIPES		TRAFFIC SIGNAL WITH NO ARM
	GUARD POST		TRAFFIC WALK SWITCH
	GUY WIRE		UTILITY POLE
	IRRIGATION BOX		WATER VALVE
	IRRIGATION VALVE		WATER MANHOLE
	LIGHT POLE WITH NO ARM		WATER METER
	LIGHT POLE WITH ARM ATTACHED TO UTILITY POLE		WELL

- NOTES:
- EXISTING PIPING, EQUIPMENT, AND TOPOGRAPHY IS SHOWN SCREENED AND/OR LIGHT-LINED. NEW PIPING, EQUIPMENT, STRUCTURE, AND FINISHED GRADE IS SHOWN HEAVY-LINED.
 - THIS IS A STANDARD LEGEND SHEET. SOME SYMBOLS MAY APPEAR ON THIS SHEET AND NOT BE USED ON THE PLANS.

WATERWORKS
ENGINEERS
5767 Broadway #201 • Oakland, CA 94618 • 510-428-5590

CITY OF ALAMEDA
BAY FARM ISLAND PUMP STATION
REHABILITATION PROJECT

GENERAL
CIVIL LEGEND

DATE
JULY 2011
PROJECT NUMBER
11-005
DRAWING NUMBER
G-5
SHEET NUMBER
5

DESIGN CRITERIA:

1. APPLICABLE CODE: 2010 CALIFORNIA BUILDING CODE (CBC)
2. REFER TO THE SPECIFICATIONS FOR ADDITIONAL AND SPECIFIC STRUCTURE LOADINGS AND REQUIREMENTS.
3. ROOF LOADS:
125 PSF MINIMUM LIVE LOAD
4. WIND LOAD:
ASCE 7-05 METHOD 1 (SIMPLIFIED PROCEDURE)
BASIC WIND SPEED: 85 MPH, EXPOSURE CATEGORY: C
lw: 1.15
5. SEISMIC LOAD:
SEISMIC OCCUPANCY CATEGORY: III
SEISMIC IMPORTANCE FACTOR Ie: 1.25
SEISMIC DESIGN CATEGORY: D
SDS: 1.000g
SD1: 0.600g
SITE CLASS: D

GENERAL INFORMATION:

1. ALL CONSTRUCTION SHALL CONFORM TO THE LATEST EDITION OF THE CBC.
2. FOR ABBREVIATIONS NOT LISTED, SEE ASME Y14.38 "ABBREVIATIONS AND ACRONYMS" PUBLICATION AS DISTRIBUTED BY THE AMERICAN SOCIETY OF MECHANICAL ENGINEERS (ASME).
3. DESIGN DETAILS ARE INTENDED TO BE TYPICAL AND SHALL APPLY TO ALL SIMILAR SITUATIONS OCCURRING THROUGHOUT THE PROJECT, WHETHER OR NOT THEY ARE KEYED IN EACH LOCATION. CONSULT THE ENGINEER FOR REVIEW PRIOR TO CONSTRUCTION.
4. VERIFY ALL OPENING DIMENSIONS IN WALLS, SLABS, AND DECKS WITH THE ARCHITECTURAL, MECHANICAL, HVAC AND ELECTRICAL DRAWINGS.
5. FOR NUMBER, TYPE, SIZE ARRANGEMENT, AND/OR LOCATION OF EQUIPMENT PADS SEE ARCHITECTURAL, MECHANICAL, ELECTRICAL, HVAC AND PLUMBING DRAWINGS. COORDINATE WITH EQUIPMENT SUPPLIER PRIOR TO PLACING SLABS, WALLS AND FOUNDATIONS. COORDINATE ALL MECHANICAL, ELECTRICAL, AND HVAC PIPING OPENINGS WITH MECHANICAL, ELECTRICAL AND HVAC DRAWINGS.
6. NO STRUCTURAL MEMBERS SHALL BE CUT FOR PIPES, DUCTS, ETC UNLESS SPECIFICALLY DETAILED OR APPROVED IN WRITING BY THE ENGINEER.
7. SPECIAL INSPECTION IS REQUIRED IN ACCORDANCE WITH IBC SECTION 108.4 AND CHAPTER 17 ON THE FOLLOWING PORTIONS OF THE WORKS:
CONCRETE PLACEMENT, REINFORCING STEEL PLACMENT, EMBEDS AND BOLTS INSTALLED IN CONCRETE, POST INSTALLED CONCRETE BOLTS.

CONCRETE:

1. CONCRETE SHALL HAVE A MINIMUM COMPRESSIVE STRENGTH AT 28 DAYS AND A MAXIMUM SLUMP AS SPECIFIED IN SECTION 03300.
2. THE CONTRACTOR SHALL SUBMIT THE CONCRETE MIX DESIGNS TO THE ENGINEER FOR REVIEW PRIOR TO USE.
3. THE CONTRACTOR SHALL NOTIFY THE ENGINEER 48 HOURS PRIOR TO THE PLACEMENT OF CONCRETE.
4. HORIZONTAL CONSTRUCTION JOINTS SHALL BE PREPARED TO EXPOSE CLEAN, SOLIDLY EMBEDDED AGGREGATE OVER THE ENTIRE JOINT INTERFACE.
5. PLACEMENT OF PIPES, CONDUITS OR OTHER EMBEDDED ITEMS IN THE CONCRETE SHALL BE IN ACCORDANCE WITH THESE DRAWINGS OR SHALL BE APPROVED BY THE ENGINEER.
6. NO ALUMINUM CONDUIT OR PRODUCTS CONTAINING ALUMINUM OR ANY OTHER MATERIAL INJURIOUS TO CONCRETE SHALL BE EMBEDDED IN THE CONCRETE.
7. ALL DIMENSIONS SHOWN FOR LOCATION OF REINFORCING STEEL ARE TO FACE OF BAR AND DENOTE CLEAR COVERAGE. UNLESS SPECIFICALLY NOTED OTHERWISE, CONCRETE COVERAGE SHALL BE 3" WHERE CONCRETE IS PLACED DIRECTLY AGAINST THE GROUND AND 2" WHERE CONCRETE IS EXPOSED TO THE GROUND BUT IS PLACED AGAINST THE FORMS. SLABS ON GRADE SHALL HAVE REINFORCING AT MID-DEPTH UNLESS NOTED OTHERWISE.
8. CONCRETE SHALL BE MIXED AND DELIVERED IN ACCORDANCE WITH ASTM C 94.
9. THE REQUIREMENTS FOR CONCRETE MIXES, PLACING, TESTING AND CURING ARE CONTAINED IN CBC SECTIONS 1905 - 1906.
10. PORTLAND CEMENT SHALL CONFORM TO ASTM C150 TYPE II, AGGREGATE SHALL CONFORM TO ASTM C33.

FOUNDATIONS

1. FOUNDATIONS HAVE BEEN DESIGNED AS FULLY COMPENSATED AS STATED IN THE GEOTECHNICAL INVESTIGATION REPORT.
2. NO BACKFILL SHALL BE PLACED BEHIND WALLS UNTIL THE CONCRETE HAS ATTAINED 100% OF ITS SPECIFIED COMPRESSIVE STRENGTH.
3. THE CONTRACTOR SHALL PROVIDE THE ENGINEER AT LEAST 48 HOURS NOTICE FOLLOWING EXCAVATION FOR FOUNDATIONS AND PRIOR TO THE PLACEMENT OF FORMWORK, REINFORCING STEEL AND CONCRETE.

CONCRETE REINFORCING

1. PROVIDE LARGER SIZES AND MORE REINFORCING IN ALL SECTIONS OF CONCRETE WHERE REQUIRED BY THE DETAILS ON THE DRAWINGS OR BY THE SPECIFICATIONS.
2. CLEARANCE FOR REINFORCEMENT BARS, UNLESS SHOWN OTHERWISE, SHALL BE: CAST AGAINST EARTH = 3", ALL OTHER CONCRETE SURFACES = 2".
3. ALL BENDS, UNLESS OTHERWISE SHOWN, SHALL BE 90 DEGREE ACI 318 STANDARD HOOKS.
4. PROVIDE A MINIMUM OF TWO VERTICAL DOWELS AT WALL ENDS, CORNERS AND INTERSECTIONS WITH SIZE TO MATCH TYPICAL VERTICAL REINFORCING STEEL SHOWN.
5. ALL REINFORCING BENDS AND LAPS, UNLESS OTHERWISE NOTED, SHALL SATISFY THE FOLLOWING MINIMUM REQUIREMENTS:

CONCRETE DESIGN STRENGTH = 4,000 PSI			GRADE 60 REINF STEEL			
BAR SIZE		#3	#4	#5	#6	#7
LAP SPLICE LENGTH						
SPACING < 6"	TOP BAR *	1'-4"	2'-0"	3'-0"	4'-0"	5'-10"
	OTHER BAR	1'-4"	1'-7"	2'-4"	3'-1"	4'-6"
SPACING ≥ 6"	TOP BAR *	1'-4"	1'-8"	2'-0"	2'-5"	3'-6"
	OTHER BAR	1'-4"	1'-4"	1'-7"	1'-10"	2'-9"
EMBEDMENT LENGTH						
SPACING < 6"	TOP BAR *	1'-0"	1'-7"	2'-4"	3'-1"	4'-6"
	OTHER BAR	1'-0"	1'-3"	1'-9"	2'-5"	3'-6"
SPACING ≥ 6"	TOP BAR *	1'-0"	1'-3"	1'-7"	1'-10"	2'-9"
	OTHER BAR	1'-0"	1'-0"	1'-3"	1'-5"	2'-1"

* TOP BARS SHALL BE DEFINED AS ANY HORIZONTAL BARS PLACED SUCH THAT MORE THAN 12" OF CONCRETE IS CAST IN THE MEMBER BELOW THE BAR IN ANY SINGLE POUR. HORIZONTAL WALL BARS ARE CONSIDERED TOP BARS.

** WHERE 3000 PSI CONCRETE IS USED, INCREASE ABOVE LENGTHS BY 16%.

STRUCTURAL STEEL

1. STRUCTURAL STEEL SHALL BE FABRICATED AND ERECTED IN ACCORDANCE WITH AISC SPECIFICATIONS AND CODE OF STANDARD PRACTICE.

STRUCTURAL STEEL SHALL CONFORM TO ASTM:
HOLLOW STRUCTURAL SECTIONS: A500 GRADE B MINIMUM Fy = 46 ksi
PIPE: A53 GRADE B MINIMUM Fy = 35 ksi
WIDE FLANGE SECTIONS: A992 MINIMUM Fy = 50 ksi
PLATES, ANGLES, AND CHANNELS: A36 MINIMUM Fy = 36 ksi
STAINLESS STEEL PLATES: A240
STAINLESS STEEL SHAPES: A276 OR A479

2. ALL WELDING SHALL BE PERFORMED BY AWS CERTIFIED WELDERS AND SHALL CONFORM TO THE REQUIREMENTS OF ANSI/AWS D1.1-06 AND CBC SECTION 2204.
3. WELDING ELECTRODES SHALL BE THE FOLLOWING TYPES: E70XX.
4. ALL BOLTS SHALL BE STAINLESS STEEL ASTM A320 UNLESS NOTED OTHERWISE.
5. STRUCTURAL STEEL SHALL BE FREE OF EXCESSIVE RUST, MILL SCALE OR GREASE.
6. ALL FILLET WELDS SHALL BE AISC MINIMUM AND BUTT WELDS SHALL BE FULL PENETRATION.
7. INSTALLATION AND INSPECTION OF HIGH STRENGTH BOLTS SHALL CONFORM TO THE REQUIREMENTS OF THE 2005 AISC SPECIFICATION. CONTACT FACES OF STEEL AT CONNECTIONS WHERE HIGH STRENGTH BOLTS ARE USED SHALL NOT BE PAINTED.
8. OPENINGS SHALL NOT BE PLACED IN STEEL MEMBERS UNLESS SPECIFICALLY DETAILED ON THE STRUCTURAL PLANS.
9. DISTANCE FROM EDGE OF PLATE TO CENTER OF BOLT SHALL BE 1 1/2" UNLESS NOTED OTHERWISE.
10. THE STRUCTURAL STEEL FABRICATOR/CONTRACTOR SHALL FURNISH SHOP DRAWINGS OF ALL STRUCTURAL STEEL FOR ARCHITECTS AND ENGINEERS REVIEW PRIOR TO FABRICATION.

STRUCTURAL ABBREVIATIONS


AB	ANCHOR BOLT	IN	INCHES
ACI	AMERICAN CONCRETE INSTITUTE	JT	JOINT
ADDL	ADDITIONAL	L	LOW / ANGLE
AFF	ABOVE FINISH FLOOR	LONG	LONGITUDINAL
AISC	AMERICAN INSTITUTE OF STEEL CONSTRUCTION	LLH	LONG LEG HORIZONTAL
AL	ALUMINUM	LLV	LONG LEG VERTICAL
ALT	ALTERNATE	LSH	LONG SLOTTED HOLE
ANC	ANCHOR	MFR	MANUFACTURER
ANSI	AMERICAN NATIONAL STANDARDS INSTITUTE	MAX	MAXIMUM
APVD	APPROVED	MB	MACHINE BOLT
ARCH	ARCHITECT, ARCHITECTURAL	MECH	MECHANICAL
BC	BOTTOM CHORD	MIN	MINIMUM
BLK	BLOCK	MTL	METAL
BOC	BOTTOM OF CONCRETE	NDT	NON-DESTRUCTIVE TESTING
BOS	BOTTOM OF STEEL	NIC	NOT IN CONTRACT
BOT	BOTTOM, BOTTOM OF TRENCH	NS	NEAR SIDE
BM	BEAM	NTS	NOT TO SCALE
BRG	BEARING	OC	ON CENTER
BTWN	BETWEEN	OD	OUTSIDE DIAMETER
C	CAMBER	OF	OUTSIDE FACE
CC	CENTER TO CENTER	O/O	OUT TO OUT
CHKD	CHECKERED	OPNG	OPENING
CIP	CAST IN PLACE	OPP	OPPOSITE
CJ	CONSTRUCTION JOINT	OSH	OVERSIZED HOLE
CL	CENTERLINE	OWJ	OPEN WEB JOIST
CLG	CEILING	PC	PRECAST
CLR	CLEARANCE	PLCS	PLACES
CO	CLEANOUT	PJF	PREMOLDED JOINT FILLER
COL	COLUMN	PL	PLATE
CONC	CONCRETE	PLYWD	PLYWOOD
CONN	CONNECTION	PP	PARTIAL PENETRATION
CONT	CONTINUOUS	PROJ	PROJECTION
CP	COMPLETE PENETRATION	PT	PRESSURE TREATED
CTR	CENTER	PVC	POLYVINYL CHLORIDE
DBA	DEFORMED BAR ANCHOR	REINF	REINFORCE, REINFORCING
DBL	DOUBLE	REQD	REQUIRED
DIA Ø	DIAMETER	RTN	RETURN
DWG	DRAWING	SHT	SHEET
EA	EACH	SIB	STRUCTURAL ISOLATION BREAK
ECS	EPOXY COATED STEEL	SIM	SIMILAR
EE	EACH END	SJ	SAWN JOINT
EF	EACH FACE	SLV	SHORT LEG VERTICAL
ELEV	ELEVATION	SMS	SHEET METAL SCREWS (SELF-TAPPING)
EMBED	EMBEDMENT	SPCG, SPA	SPACING
EN	EDGE NAIL	SPCS	SPACES
EQ, EQL, SP	EQUALLY SPACED	SPECS	SPECIFICATIONS
ES	EASH SIDE	SQ	SQUARE
EW	EACH WAY	SS	STAINLESS STEEL
EXP	EXPANSION	SSH	SHORT SLOTTED HOLE
EXST, (E)	EXISTING	STD	STANDARD
FD	FLOOR DRAIN	STIFF	STIFFENER
FDN	FOUNDATION	STL	STEEL
FIN	FINISH	STSMS	SELF-TAPPING SHEET METAL SCREW
FF	FINISHED FLOOR	SW	STUD WELD
FLG	FLANGE	SYM	SYMMETRICAL
FLR	FLOOR	T&B	TOP & BOTTOM
FOB	FACE OF BLOCK	TC	TOP CHORD
FOC	FACE OF CONCRETE	TD	TRUSS DIAGONAL
FOS	FACE OF STUD / STEEL	THK	THICK
FP	FULL PENETRATION	TN	TOE NAIL
FRMG	FRAMING	TO	TOP OF
FRP	FIBER REINFORCED PLASTIC	TOC	TOP OF CONCRETE
FS	FAR SIDE	TOF	TOP OF FOOTING
FTG	FOOTING	TOG	TOP OF GRATING
GA	GAUGE, GAGE	TOS	TOP OF STEEL
GALV	GALVANIZED	TOT	TOTAL
GLB	GLULAM BEAM	TOW	TOP OF WALL
GRD	GRADE	TRANS	TRANSVERSE
GRT	GROUT	TV	TRUSS VERTICAL
GRTG	GRATING	TYP	TYPICAL
H	HIGH	UN	UNLESS NOTED
H.A.S.	HEADED ANCHOR STUD	UT	ULTRASONIC TESTING
HCA	HEADED CONCRETE ANCHOR	VERT	VERTICAL
HD	HOLDOWN	W	WIDE
HORIZ	HORIZONTAL	W/	WITH
HSB	HIGH STRENGTH BOLT	W/O	WITH OUT
IF	INSIDE FACE	WP	WORK POINT
		WS	WATERSTOP
		WWF	WELDED WIRE FABRIC

WATERWORKS
ENGINEERS
5767 Broadway #201 • Oakland, CA 94618 • 510-423-9590



CITY OF ALAMEDA
BAY FARM ISLAND PUMP STATION
REHABILITATION PROJECT

GENERAL
STRUCTURAL NOTES

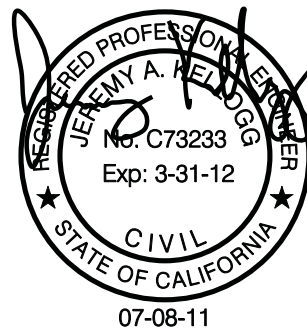

DATE
JULY 2011
PROJECT NUMBER
11-005
DRAWING NUMBER
G-6
SHEET NUMBER
6

PIPE AND FITTING SYMBOLS

DOUBLE LINE

SINGLE LINE

		EXISTING PIPE (SCREENED)
		NEW PIPE
		EXISTING PIPE TO BE ABANDONED
		EXISTING PIPE TO BE REMOVED
		WELDED JOINT
		GROOVED END JOINT - FLEXIBLE
		GROOVED END JOINT - RIGID
		FLANGED JOINT
		MECHANICAL JOINT
		HUB & SPIGOT JOINT (RUBBER GASKET PUSH-ON)
		BALL JOINT
		FLANGE COUPLING ADAPTER
		FLEXIBLE COUPLING
		FLEXIBLE COUPLING WITH THRUST TIES
		DISMANTLING JOINT
		STEEL BELLOWS EXPANSION JOINT
		ELASTOMER BELLOWS EXPANSION JOINT
		ELBOW - 90 DEGREE
		ELBOW UP - 90 DEGREE
		ELBOW DOWN - 90 DEGREE
		ELBOW - 45 DEGREE
		ELBOW UP - 45 DEGREE
		ELBOW DOWN - 45 DEGREE
		TEE
		TEE UP
		TEE DOWN
		CROSS
		LATERAL
		LATERAL UP
		LATERAL DOWN
		REDUCER - CONCENTRIC

PIPE AND FITTING SYMBOLS

DOUBLE LINE

SINGLE LINE

		REDUCER - ECCENTRIC
		UNION
		BLIND FLANGE
		PLUG
		CAP

VALVE SYMBOLS

DOUBLE LINE

SINGLE LINE

		GATE
		KNIFE GATE
		BUTTERFLY
		GLOBE
		BALL
		VEE BALL
		PLUG OR COCK
		ECCENTRIC PLUG WITH REQUIRED SEAT LOCATION
		FULL PORT PLUG
		NEEDLE
		DIAPHRAGM
		PINCH VALVE
		SWING CHECK
		DOUBLE DISK OR SILENT CHECK
		BALL CHECK
		HOSE VALVE
		NON FREEZE HOSE VALVE
		NON FREEZE HOSE VALVE WITH HOSE RACK
		SAMPLE
		MUD
		PRESSURE RELIEF
		AIR AND OR VACUUM RELEASE
		REGULATED SIDE
		PRESSURE CONTROL
		MULTI-PORT VALVE ARROWS INDICATE FLOW PATTERN. SEAT PORTS ARE IMPLIED BY INDICATED FLOW PATTERN. BALL VALVE SHOWN. FOR OTHER VALVE TYPES, APPROPRIATE VALVE SYMBOL SHOWN.
		FIRE HYDRANT
		CATHODIC PROTECTION TEST STATION
		CATHODIC PROTECTION ANODE

FLOW METERS

DOUBLE LINE

SINGLE LINE

		MAGMETER
		PROPELLER METER
		INSERTION METER

PUMPS

	METERING
	DIAPHRAGM
	CENTRIFUGAL
	PERISTALTIC

MIXERS


	STATIC MIXER
	PNEUMATIC
	MOTORIZED
	SOLENOID

MISCELLANEOUS PIPING SYMBOLS


	STRAINER
	SIGHT GLASS
	FLEXIBLE (ELASTOMER) PIPE CONNECTION
	GAUGE WITH COCK
	THERMOMETER
	ROTAMETER
	GALVANIC ANODE
	AIR SET
	XX = SUPPLY PRESSURE - PSIG
	TYPICAL INSTRUMENT SYMBOL (SEE I&C LEGEND)
	DRAIN
	DOUBLE CONTAINMENT PIPE

PIPING DESIGNATION


DOUBLE LINE

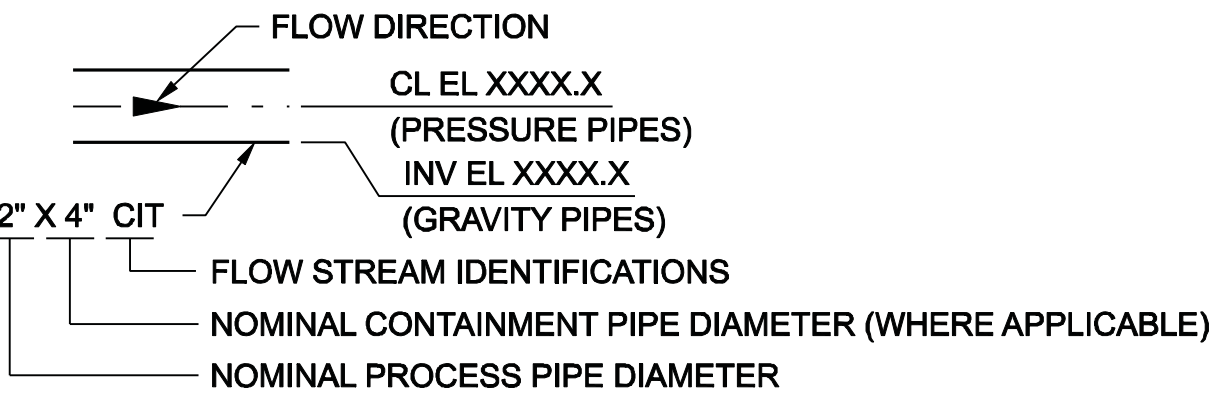

SINGLE LINE

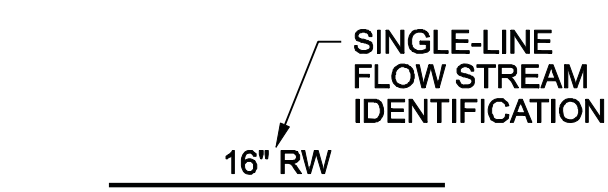

VALVE DESIGNATIONS

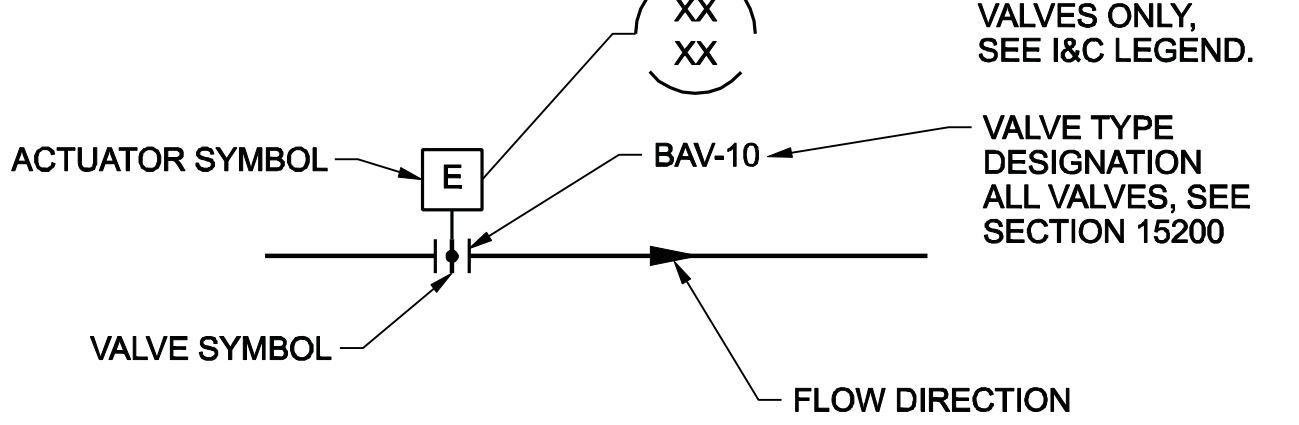

- NOTES
- ELECTRIC VALVE SHOWN, MANUAL VALVE SIMILAR.

- NOTES
- ONLY FLANGED END CONNECTIONS ARE SHOWN HERE FOR DOUBLE LINE FITTINGS. FITTINGS WITH OTHER END PATTERNS ARE SHOWN SIMILARLY ON THE CONSTRUCTION DRAWINGS. ALSO SEE PIPING SPECIFICATIONS AND THE PIPING SCHEDULE.
 - SYMBOLS SHOWN HERE FOR SINGLE LINE FITTINGS ARE GENERIC ONLY. REFER TO PIPING SPECIFICATIONS FOR SPECIFIC END CONNECTIONS FOR SINGLE LINE PIPE AND FITTINGS.

- GENERAL PIPING NOTES
- LAY PIPE TO UNIFORM GRADE BETWEEN INDICATED ELEVATION POINTS. MINIMUM COVER SHALL BE 36 INCHES UNLESS OTHERWISE SHOWN.
 - SIZE OF FITTINGS SHOWN ON DRAWINGS SHALL CORRESPOND TO ADJACENT STRAIGHT RUN OF PIPE, UNLESS OTHERWISE INDICATED. TYPE OF JOINT AND FITTING MATERIAL SHALL BE THE SAME AS SHOWN FOR ADJACENT STRAIGHT RUN OF PIPE.
 - LOCATION AND NUMBER OF PIPE HANGERS AND PIPE SUPPORTS SHOWN IS ONLY APPROXIMATE. FINAL SUPPORT REQUIREMENTS SHALL BE DETERMINED IN THE FIELD AND APPROVED BY THE ENGINEER PRIOR TO INSTALLATION. MAXIMUM SPACING SHALL BE AS SPECIFIED.
 - APPROPRIATE STANDARD WALL PIPE DETAIL SHALL BE USED WHEREVER PIPING PASSES FROM A STRUCTURE TO BACKFILL.
 - ALL FLEXIBLE CONNECTORS OR FLANGED COUPLING ADAPTERS SHALL BE PROVIDED WITH THRUST TIES, BLOCKS, OR ANCHORS, UNLESS OTHERWISE NOTED. THRUST PROTECTION SHALL BE ADEQUATE FOR TEST PRESSURES SPECIFIED.
 - SYMBOLS, LEGENDS, AND PIPE USE IDENTIFICATIONS SHOWN SHALL BE FOLLOWED THROUGHOUT THE DRAWINGS, WHEREVER APPLICABLE. ALL OF THE VARIOUS APPLICATIONS ARE NOT NECESSARILY USED IN THE PROJECT.
 - ALL PIPING SPECIFIED TO BE PRESSURE TESTED, EXCEPT FLANGED, WELDED, GROOVED END OR SCREWED PIPING, SHALL BE PROVIDED WITH THRUST PROTECTION AT ALL DIRECTION CHANGES, UNLESS OTHERWISE NOTED. SEE THRUST DETAILS AND NOTES ON DRAWINGS.
 - NUMBER AND LOCATION OF UNIONS SHOWN ON DRAWINGS ARE ONLY APPROXIMATE. PROVIDE ALL UNIONS NECESSARY TO FACILITATE CONVENIENT REMOVAL OF VALVES AND MECHANICAL EQUIPMENT.
 - THE CONTRACTOR FOR THIS PROJECT IS RESPONSIBLE FOR COORDINATING AND PERFORMING THE CONNECTION OF THE PIPING AND ASSOCIATED APPURTENANCES INSTALLED UNDER THIS CONTRACT TO BOTH THE EXISTING PIPING AND FACILITIES.
 - PRIOR TO SUBMITTING PIPING DRAWINGS FOR ANY NEW PIPE THAT IS TO CONNECT TO OR CROSS AN EXISTING PIPE OR STRUCTURE, THE CONTRACTOR SHALL EXPOSE THE EXISTING PIPE OR STRUCTURE TO VERIFY ITS EXACT LOCATION, SIZE, MATERIALS, AND INVERT ELEVATIONS.
 - COMPONENTS SHOWN WITH A DOUBLE ASTERISK (**) ARE PART OF A PACKAGE SYSTEM. SEE EQUIPMENT SPECIFICATIONS.
 - "NO WORK SHALL BE CONCEALED UNTIL AFTER INSPECTION AND APPROVAL BY PROPER AUTHORITIES. IF WORK IS CONCEALED WITHOUT INSPECTION AND APPROVAL, THE CONTRACTOR SHALL BE RESPONSIBLE FOR ALL WORK REQUIRED TO OPEN AND RESTORE THE CONCEALED AREAS IN ADDITION TO ALL REQUIRED MODIFICATIONS. THE CONTRACTOR SHALL OBTAIN AND PAY FOR ALL PERMITS FOR ALL WORK AND SHALL HAVE HIS WORK INSPECTED BY STATE AND LOCAL AGENCIES HAVING APPLICABLE JURISDICTION. CALL 510-747-6800 BETWEEN 7:30 AM TO 8:30 AM TO SCHEDULE ALL INSPECTIONS."

VERIFY SCALE
BAR IS ONE INCH ON ORIGINAL DRAWING.
0 1"
IF NOT ONE INCH ON THIS SHEET, ADJUST SCALES ACCORDINGLY.

DESIGN
T DURBIN
DRAWN
J MARTIN
CHECKED
M FISHER
APPROVED
J GESELBRACHT


WATERWORKS
ENGINEERS
5167 Broadway #201 • Oakland, CA 94618 • 510-423-5590

CITY OF ALAMEDA
BAY FARM ISLAND PUMP STATION
REHABILITATION PROJECT




GENERAL
MECHANICAL LEGEND

DATE
JULY 2011
PROJECT NUMBER
11-005
DRAWING NUMBER
G-7
SHEET NUMBER
7

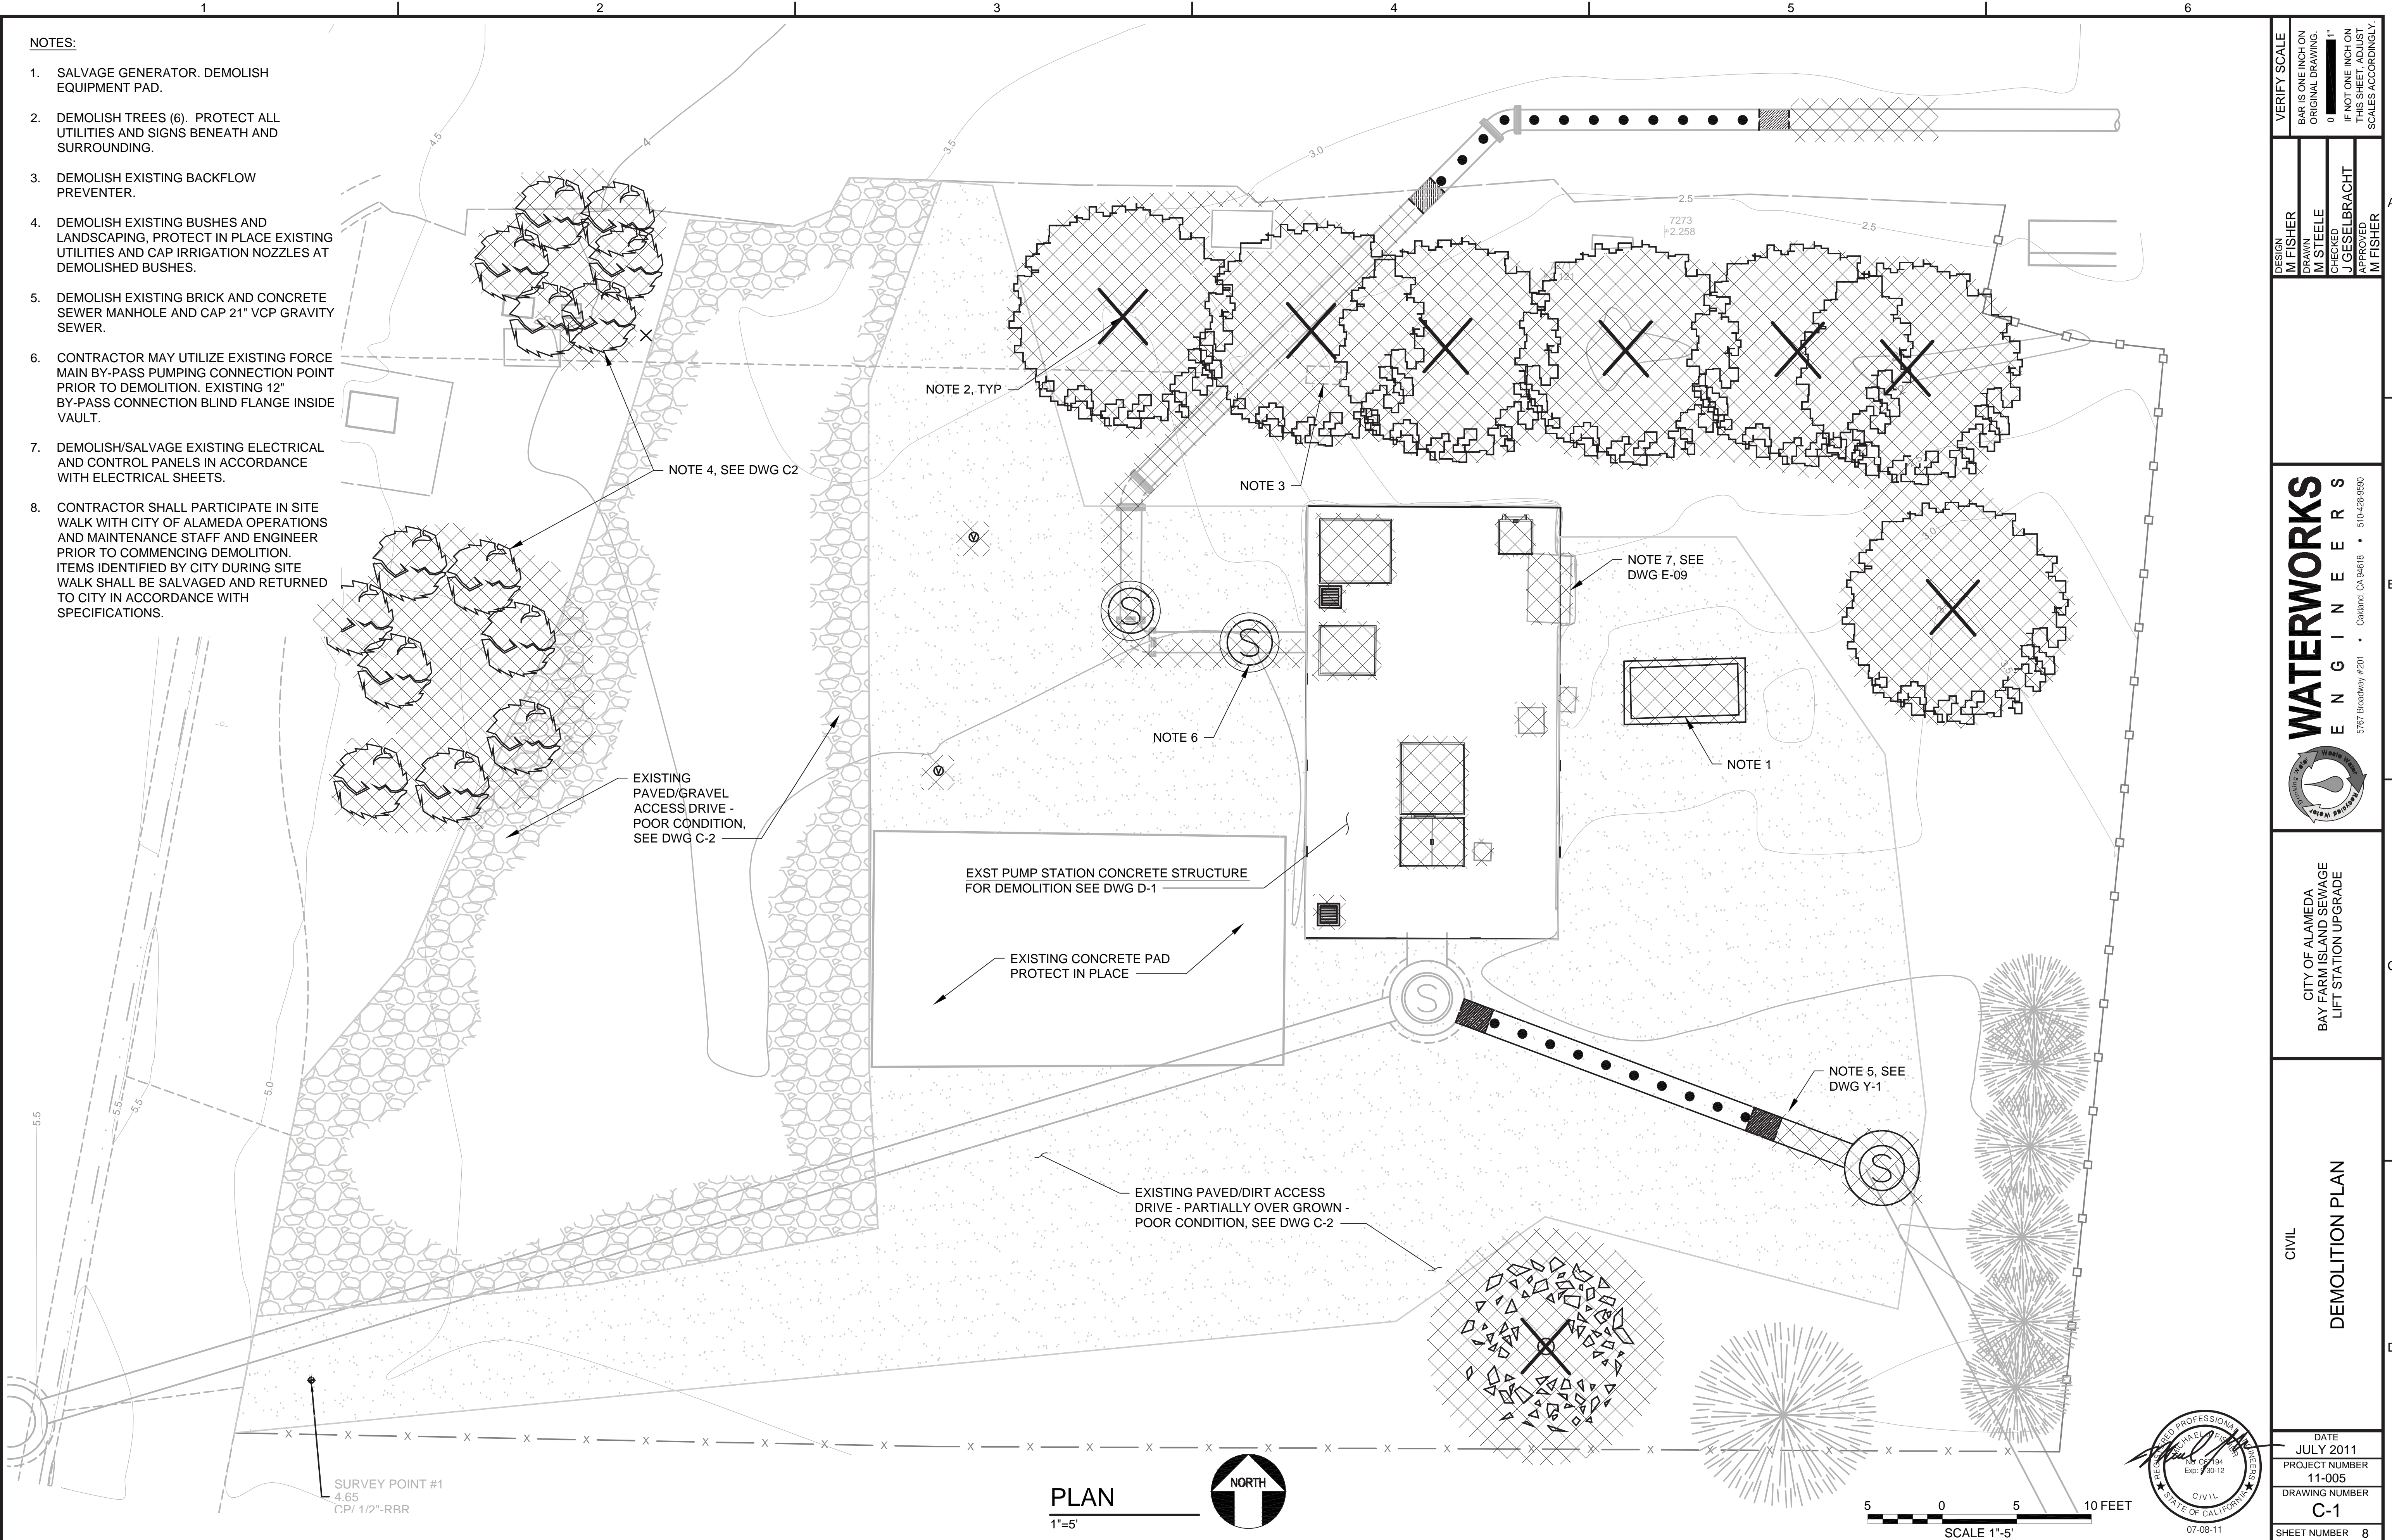T:\CAD\PROJECTS\11-005 ALAMEDA BFI PSDRAWINGS\DELIVERABLES\1105D-5-C100.DWG



VERIFY SCALE BAR IS ONE INCH ON ORIGINAL DRAWING. 0 1" IF NOT ONE INCH ON THIS SHEET, ADJUST SCALES ACCORDINGLY.	DESIGN M FISHER	WATERWORKS ENGINEERS 5767 Broadway #201 • Oakland, CA 94618 • 510-428-9590	CITY OF ALAMEDA BAY FARM ISLAND SEWAGE LIFT STATION UPGRADE	CIVIL DEMOLITION PLAN	DATE JULY 2011
	DRAWN M STEELE				PROJECT NUMBER 11-005
	CHECKED J GESELBRACHT				DRAWING NUMBER C-1
	APPROVED M FISHER				SHEET NUMBER 8

PLANT LIST				
QTY	SYMBOL	NAME	COMMON NAME	SPRINKLER TYPE
45		MACFADYENA UNGUIS-CATI	YELLOW TRUMPET VINE	0.9 GPH DRIP EMITTER
6		PHORMIUM TENAX	NEW ZEALAND FLAX	0.9 GPH DRIP EMITTER
15		ERIOGONUM ARBORESCENS	SANTA CRUZ ISLAND BUCKWHEAT	0.9 GPH DRIP EMITTER

YELLOW TRUMPET VINE



NEW ZEALAND FLAX




SANTA CRUZ ISLAND BUCKWHEAT



ROUND SIERRA BOULDER
(OR APPROVED EQUAL)

SURVEY CONTROL POINTS				
POINT #	NORTHING	EASTING	ELEVATION	RAW DESCRIPTION
1	1666984.2290	6492848.7290	4.653	CP/ 1/2"-RBR
2	1667098.8970	6492964.0710	2.322	CP/ SMAW

- NOTES:
- EXISTING CONDITIONS MAPPING PER FEB 28, 2011 FIELD SURVEY BY ANDREGG GEOMATICS.
 - UNDERGROUND UTILITY MAPPING IS BASED ON VISIBLE EVIDENCE AND INTERPRETATION OF A PARTIAL COLLECTION OF PLANS AND SCHEMATICS. VERIFY ALL LOCATIONS, SIZES, AND MATERIALS.

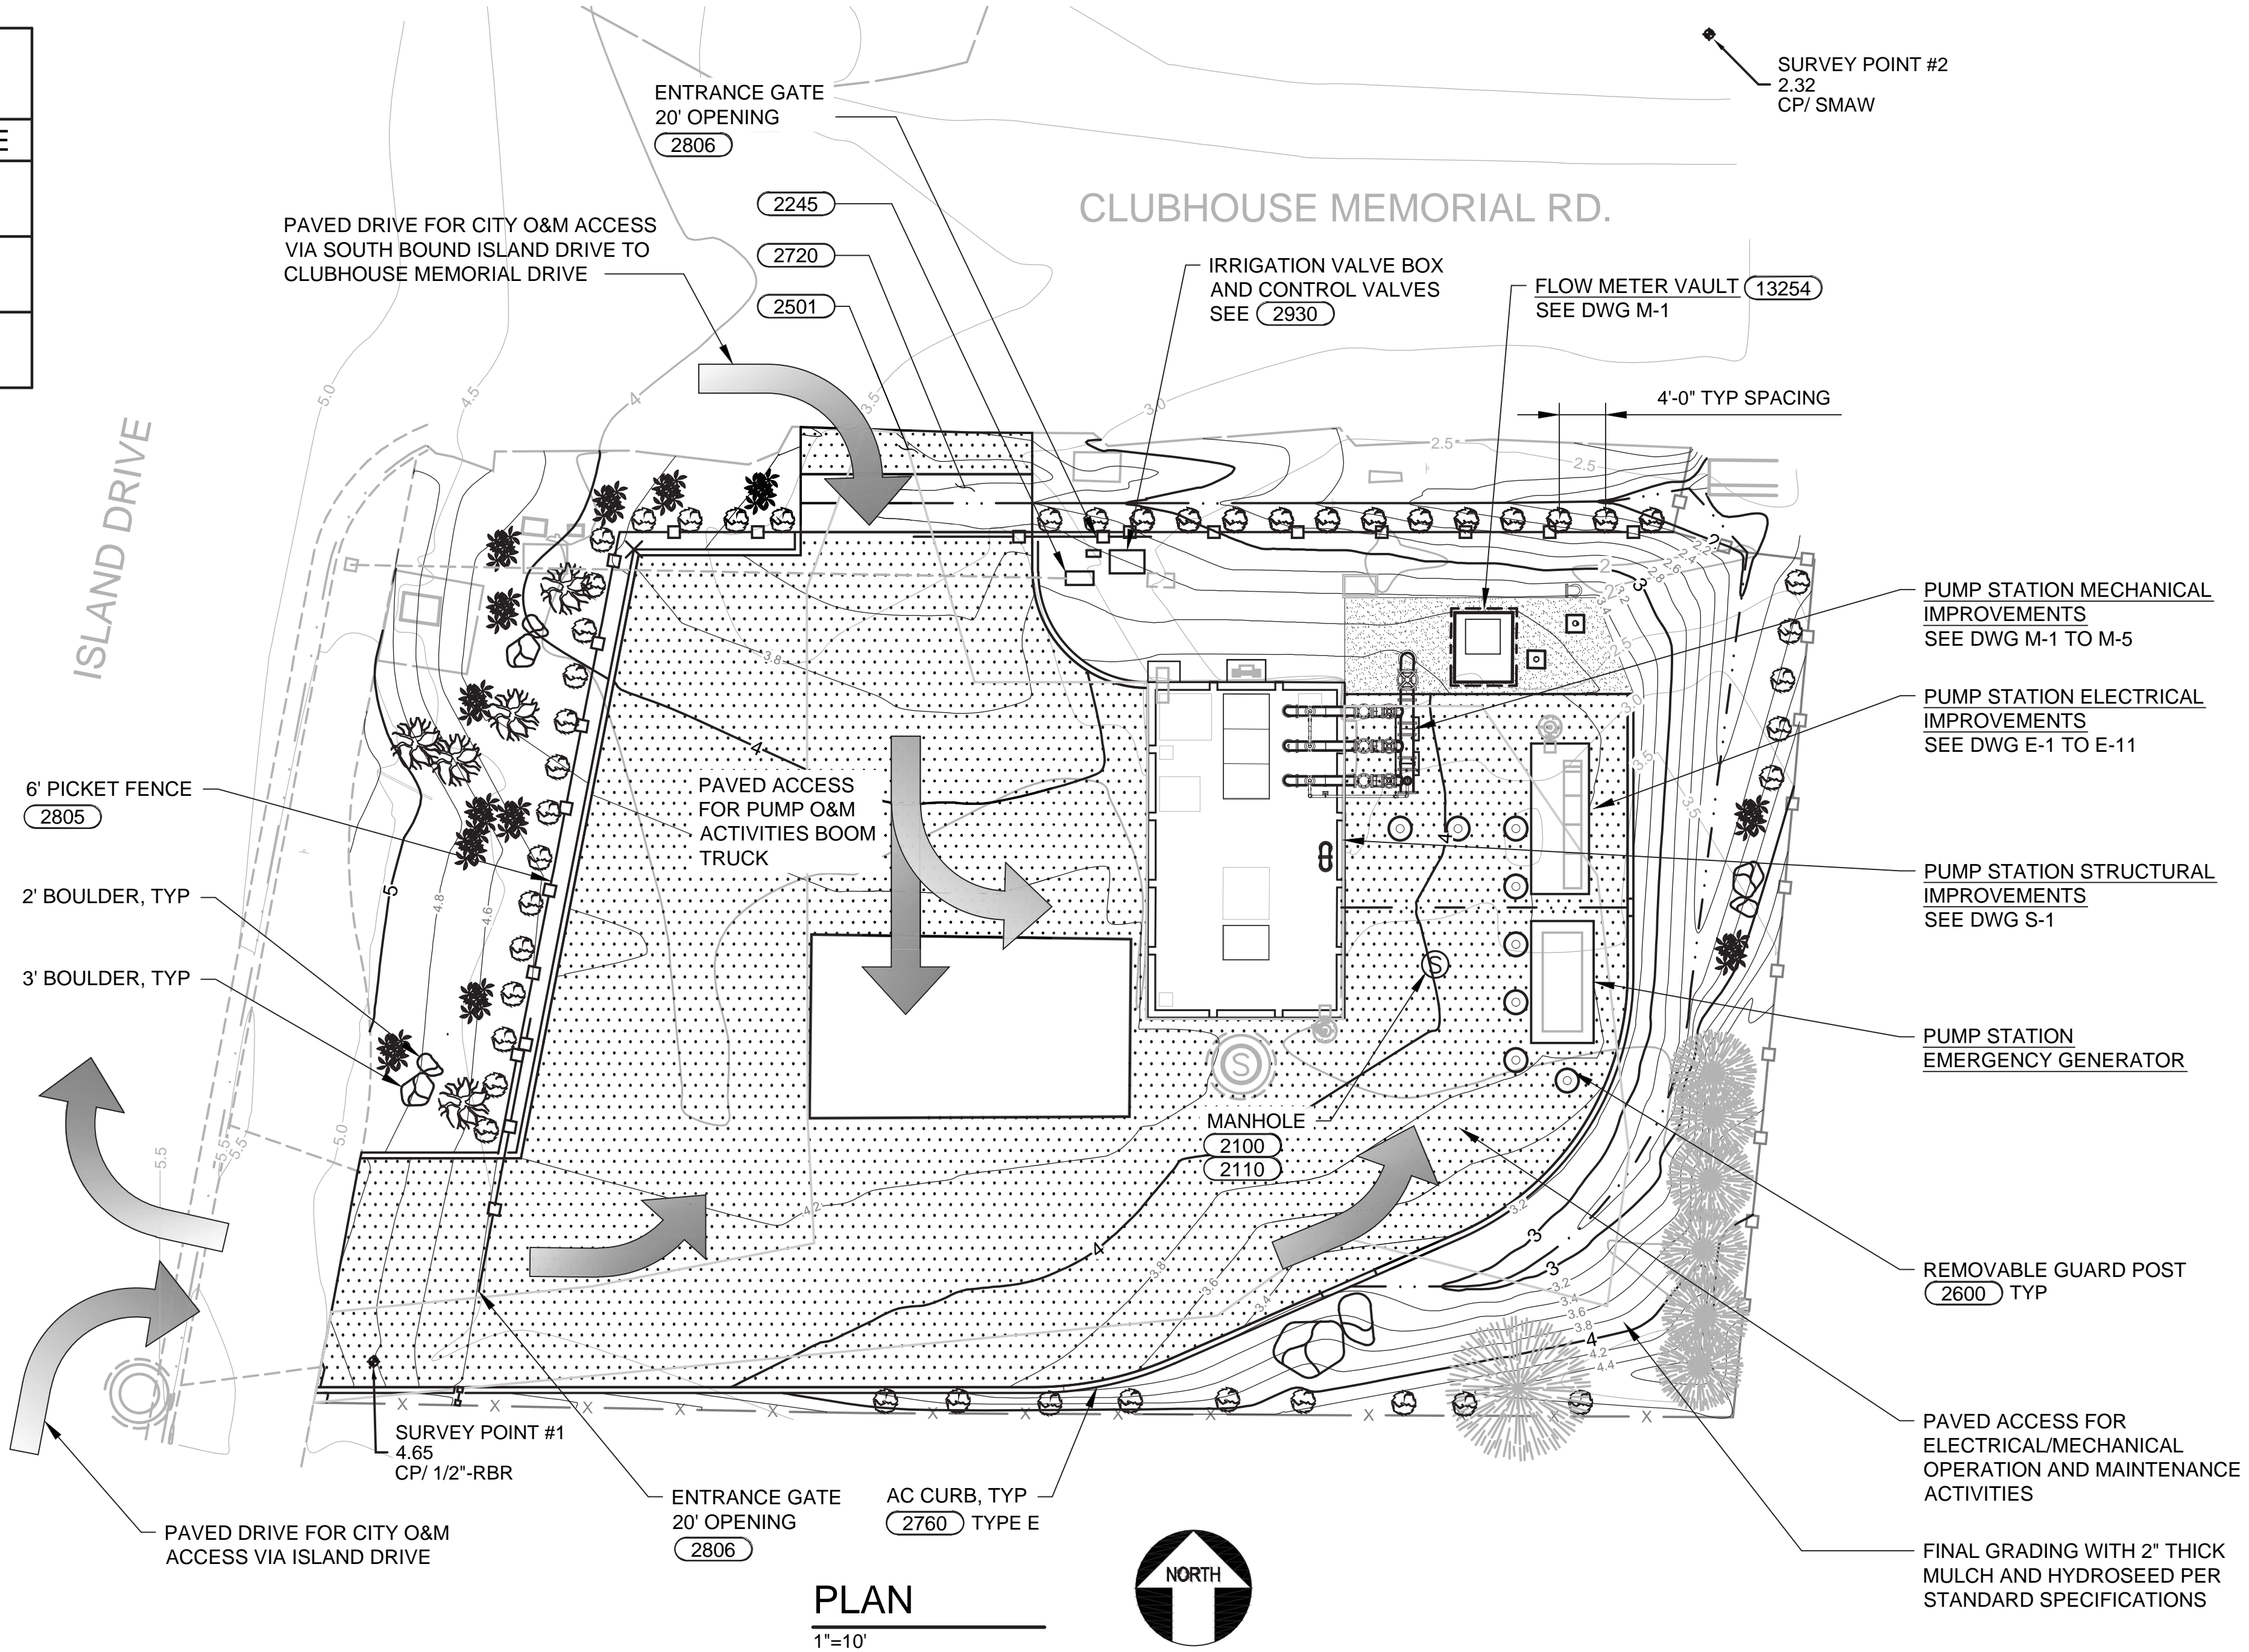



WATERWORKS
ENGINEERS
5767 Broadway #201 • Oakland, CA 94618 • 510-428-5500

CITY OF ALAMEDA
BAY FARM ISLAND SEWAGE
LIFT STATION UPGRADE


CIVIL
SITE PLAN

DATE	JULY 2011
PROJECT NUMBER	11-005
DRAWING NUMBER	C-2
SHEET NUMBER	9

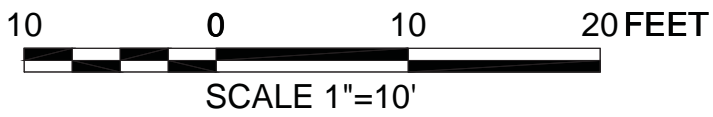

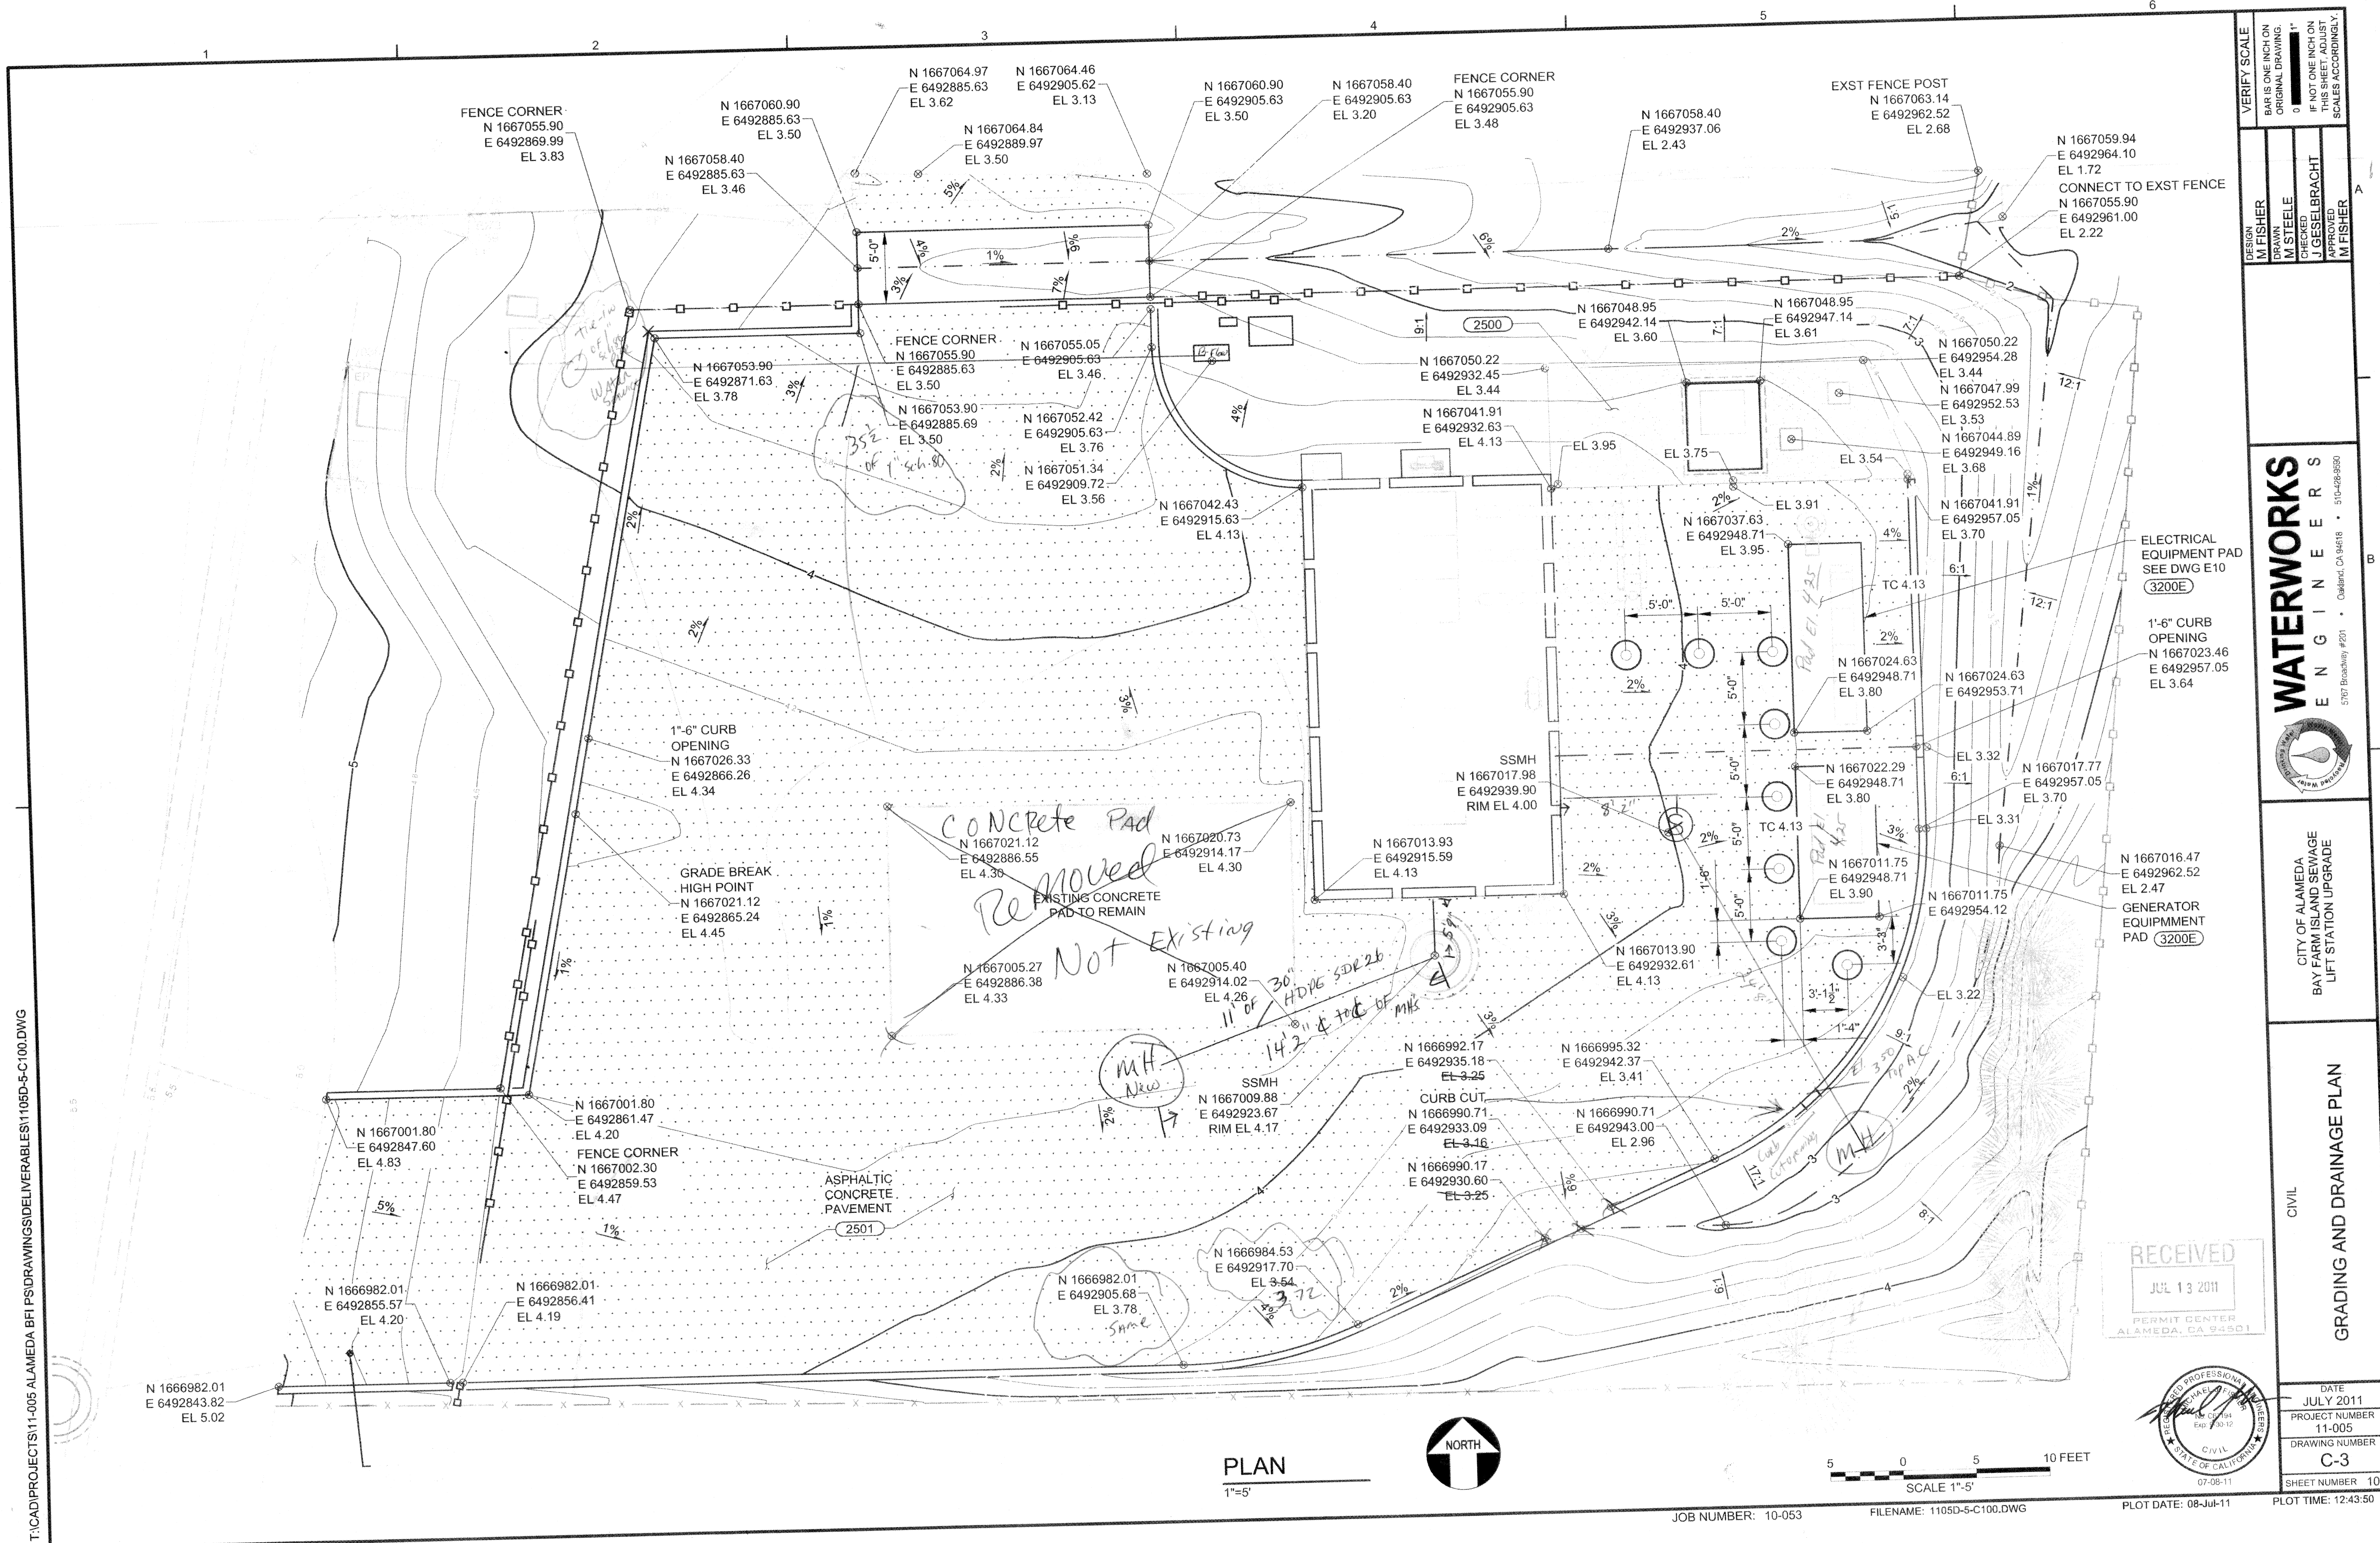

1. PLUG EXIST 16" PIPE WITH CONCRETE AND ABANDON IN PLACE.
2. ROTATE ELBOW AS NEEDED TO MAKE UP ELEVATION DIFFERENCES.
3. CUT AND REMOVE 10'-0" OF EXIST 16" PIPE, MIN.
4. ABANDON EXIST 21" GRAVITY PIPE AND CAP WITH CONCRETE PLUG INSIDE PIPE.
5. CONTRACTOR SHALL LOCATE, EXPOSE, AND SURVEY EXISTING 21" VCP SEWER LINE AT JOINT ONE FULL PIPE SEGMENT UPSTREAM OF EXISTING MANHOLE AND PROVIDE RESULTS TO ENGINEER FOR REVIEW AND CONFIRMATION OF INVERT PRIOR TO COMMENCING CONSTRUCTION.
CONTRACTOR SHALL DEMOLISH EXISTING MANHOLE AND PIPE DOWNSTREAM OF SURVEYED PIPE JOINT AND MAKE CONNECTION TO NEW 20" DIP AT THAT JOINT. CONTRACTOR SHALL NOT CUT VCP PIPE SEGMENT TO MAKE CONNECTION.
6. 21" VCP TO 20" DIP MANUFACTURED CLOSURE COUPLING WITH SST SHEAR PLATE. PIPE BEDDING AND EMBEDMENT SHALL BE 1-SACK SAND CEMENT SLURRY OR CLSM TO 1' ABOVE PIPE AND COUPLING AND EXTEND A MINIMUM OF 5' ALONG TRENCH AT BOTH ENDS OF COUPLING.
7. CONTRACTOR SHALL LOCATE EXISTING WATER SERVICE LINE AND ROUTE TO NEW BACK FLOW PREVENTER ASSEMBLY.
8. MJ x MJ SLEEVE, INSTALL WITHIN 5' OF MANHOLE.
9. CONTRACTOR SHALL MOUNT IRRIGATION CONTROLLER BOX IN ACCORDANCE WITH INSTRUMENT JUNCTION BOX DETAIL OR MANUFACTURER RECOMMENDED AND ENGINEER APPROVED EQUAL.

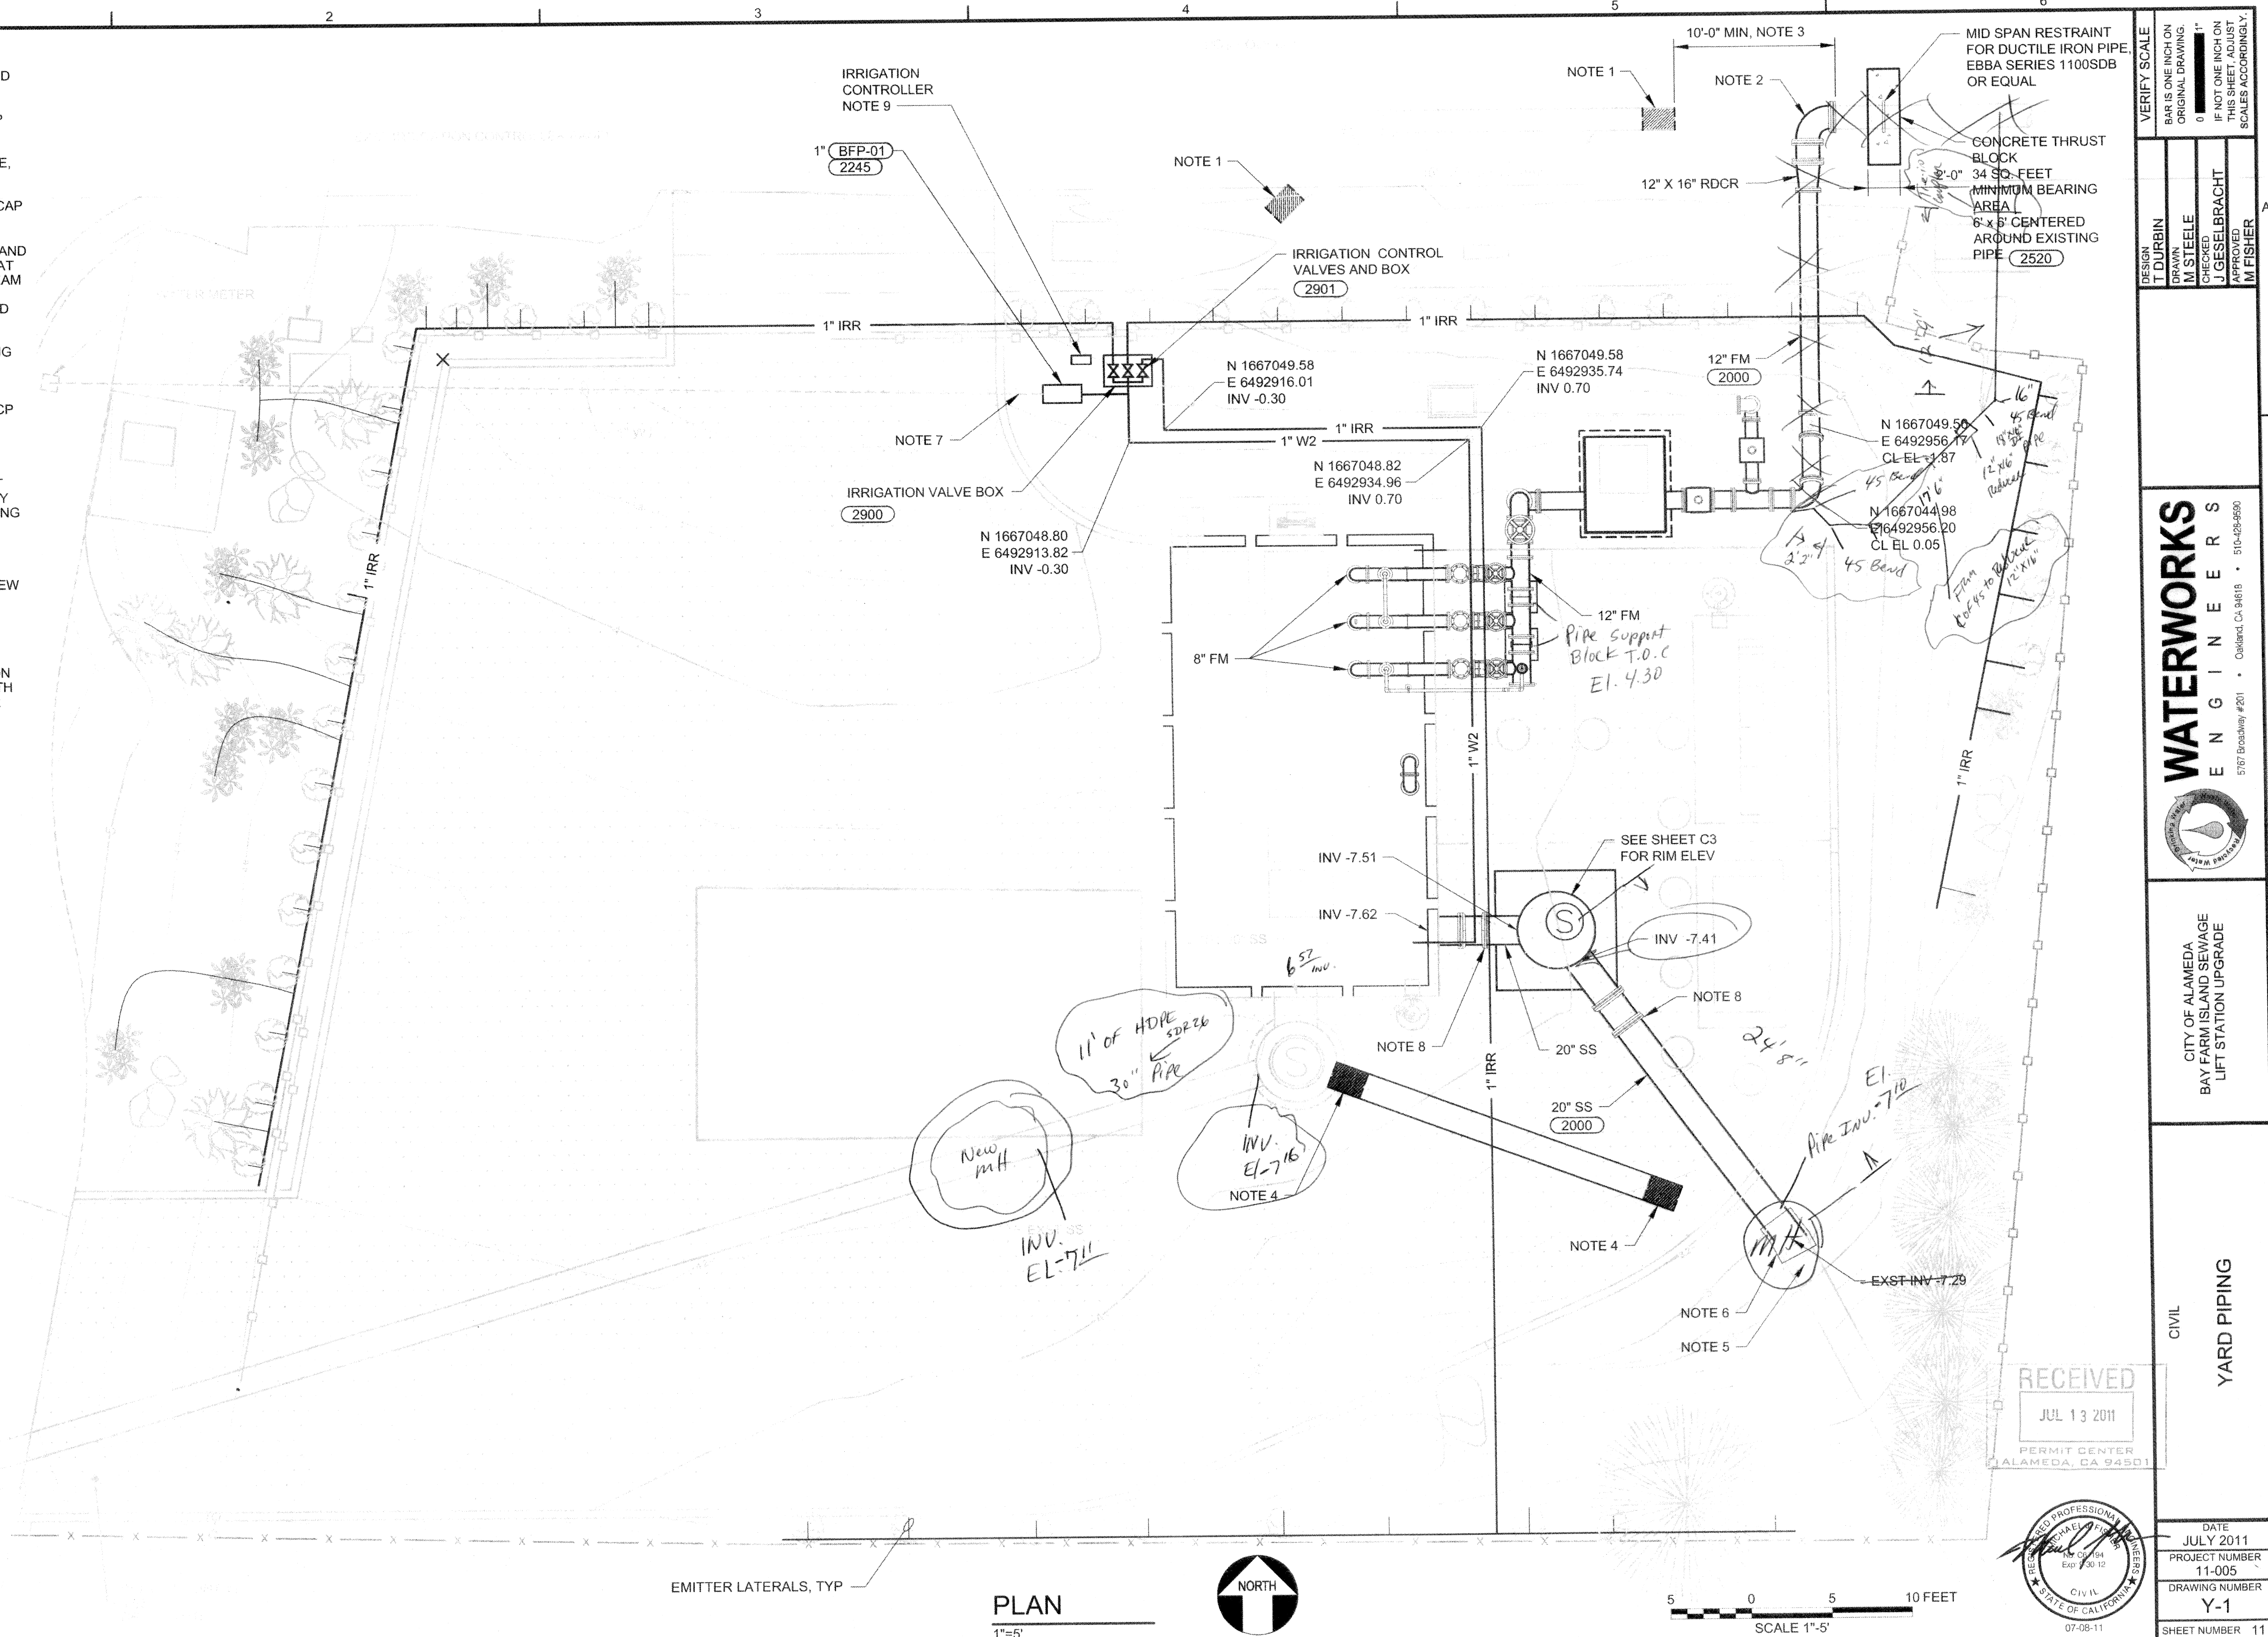

T:\CAD\PROJECTS\11-005 ALAMEDA BFI\PS\DRAWINGS\DELIVERABLES\1105D-5-C100.DWG

<div style="display: flex; align-items: center;"> <div> <p>WATERWORKS ENGINEERS</p> <p>5767 Broadway #201 • Oakland, CA 94618 • 510-429-9990</p> </div> </div>	<p>CITY OF ALAMEDA BAY FARM ISLAND SEWAGE LIFT STATION UPGRADE</p>		<p>CIVIL</p>		<p>YARD PIPING</p>		<div style="display: flex; align-items: center;"> <div> <p>J. GEISELBRACHT Professional Engineer No. 45678 • State of California</p> </div> </div>	<p>DATE JULY 2011</p>	<p>PROJECT NUMBER 11-005</p>	<p>DRAWING NUMBER Y-1</p>	<p>SHEET NUMBER 11</p>
	<p>CITY OF ALAMEDA BAY FARM ISLAND SEWAGE LIFT STATION UPGRADE</p>							<p>DESIGN T. DURBIN</p>	<p>DRAWN M. STEELE</p>	<p>CHECKED J. GEISELBRACHT</p>	<p>IN CHARGE J. GEISELBRACHT</p>

JOB NUMBER: 10-053


FILENAME: 1105D-5-C100.DWG

PLOT DATE: 08-Jul-11

PLOT TIME: 12:44:1.

NOTES:

1. PLUG EXST 16" PIPE WITH CONCRETE AND ABANDON IN PLACE.
2. ROTATE ELBOW AS NEEDED TO MAKE UP ELEVATION DIFFERENCES.
3. CUT AND REMOVE 10'-0" OF EXST 16" PIPE, MIN.
4. ABANDON EXIST 21" GRAVITY PIPE AND CAP WITH CONCRETE PLUG INSIDE PIPE.
5. CONTRACTOR SHALL LOCATE, EXPOSE, AND SURVEY EXISTING 21" VCP SEWER LINE AT JOINT ONE FULL PIPE SEGMENT UPSTREAM OF EXISTING MANHOLE AND PROVIDE RESULTS TO ENGINEER FOR REVIEW AND CONFIRMATION OF INVERT PRIOR TO COMMENCING CONSTRUCTION. CONTRACTOR SHALL DEMOLISH EXISTING MANHOLE AND PIPE DOWNSTREAM OF SURVEYED PIPE JOINT AND MAKE CONNECTION TO NEW 20" DIP AT THAT JOINT. CONTRACTOR SHALL NOT CUT VCP PIPE SEGMENT TO MAKE CONNECTION.
6. 21" VCP TO 20" DIP MANUFACTURED CLOSURE COUPLING WITH SST SHEAR PLATE. PIPE BEDDING AND EMBEDMENT SHALL BE 1-SACK SAND CEMENT SLURRY OR CLSM TO 1' ABOVE PIPE AND COUPLING AND EXTEND A MINIMUM OF 5' ALONG TRENCH AT BOTH ENDS OF COUPLING.
7. CONTRACTOR SHALL LOCATE EXISTING WATER SERVICE LINE AND ROUTE TO NEW BACK FLOW PREVENTER ASSEMBLY.
8. MJ x MJ SLEEVE, INSTALL WITHIN 5' OF MANHOLE.
9. CONTRACTOR SHALL MOUNT IRRIGATION CONTROLLER BOX IN ACCORDANCE WITH INSTRUMENT JUNCTOIN BOX DETAIL OR MANUFACTURER RECOMMENDED AND ENGIENER APPROVED EQUAL.

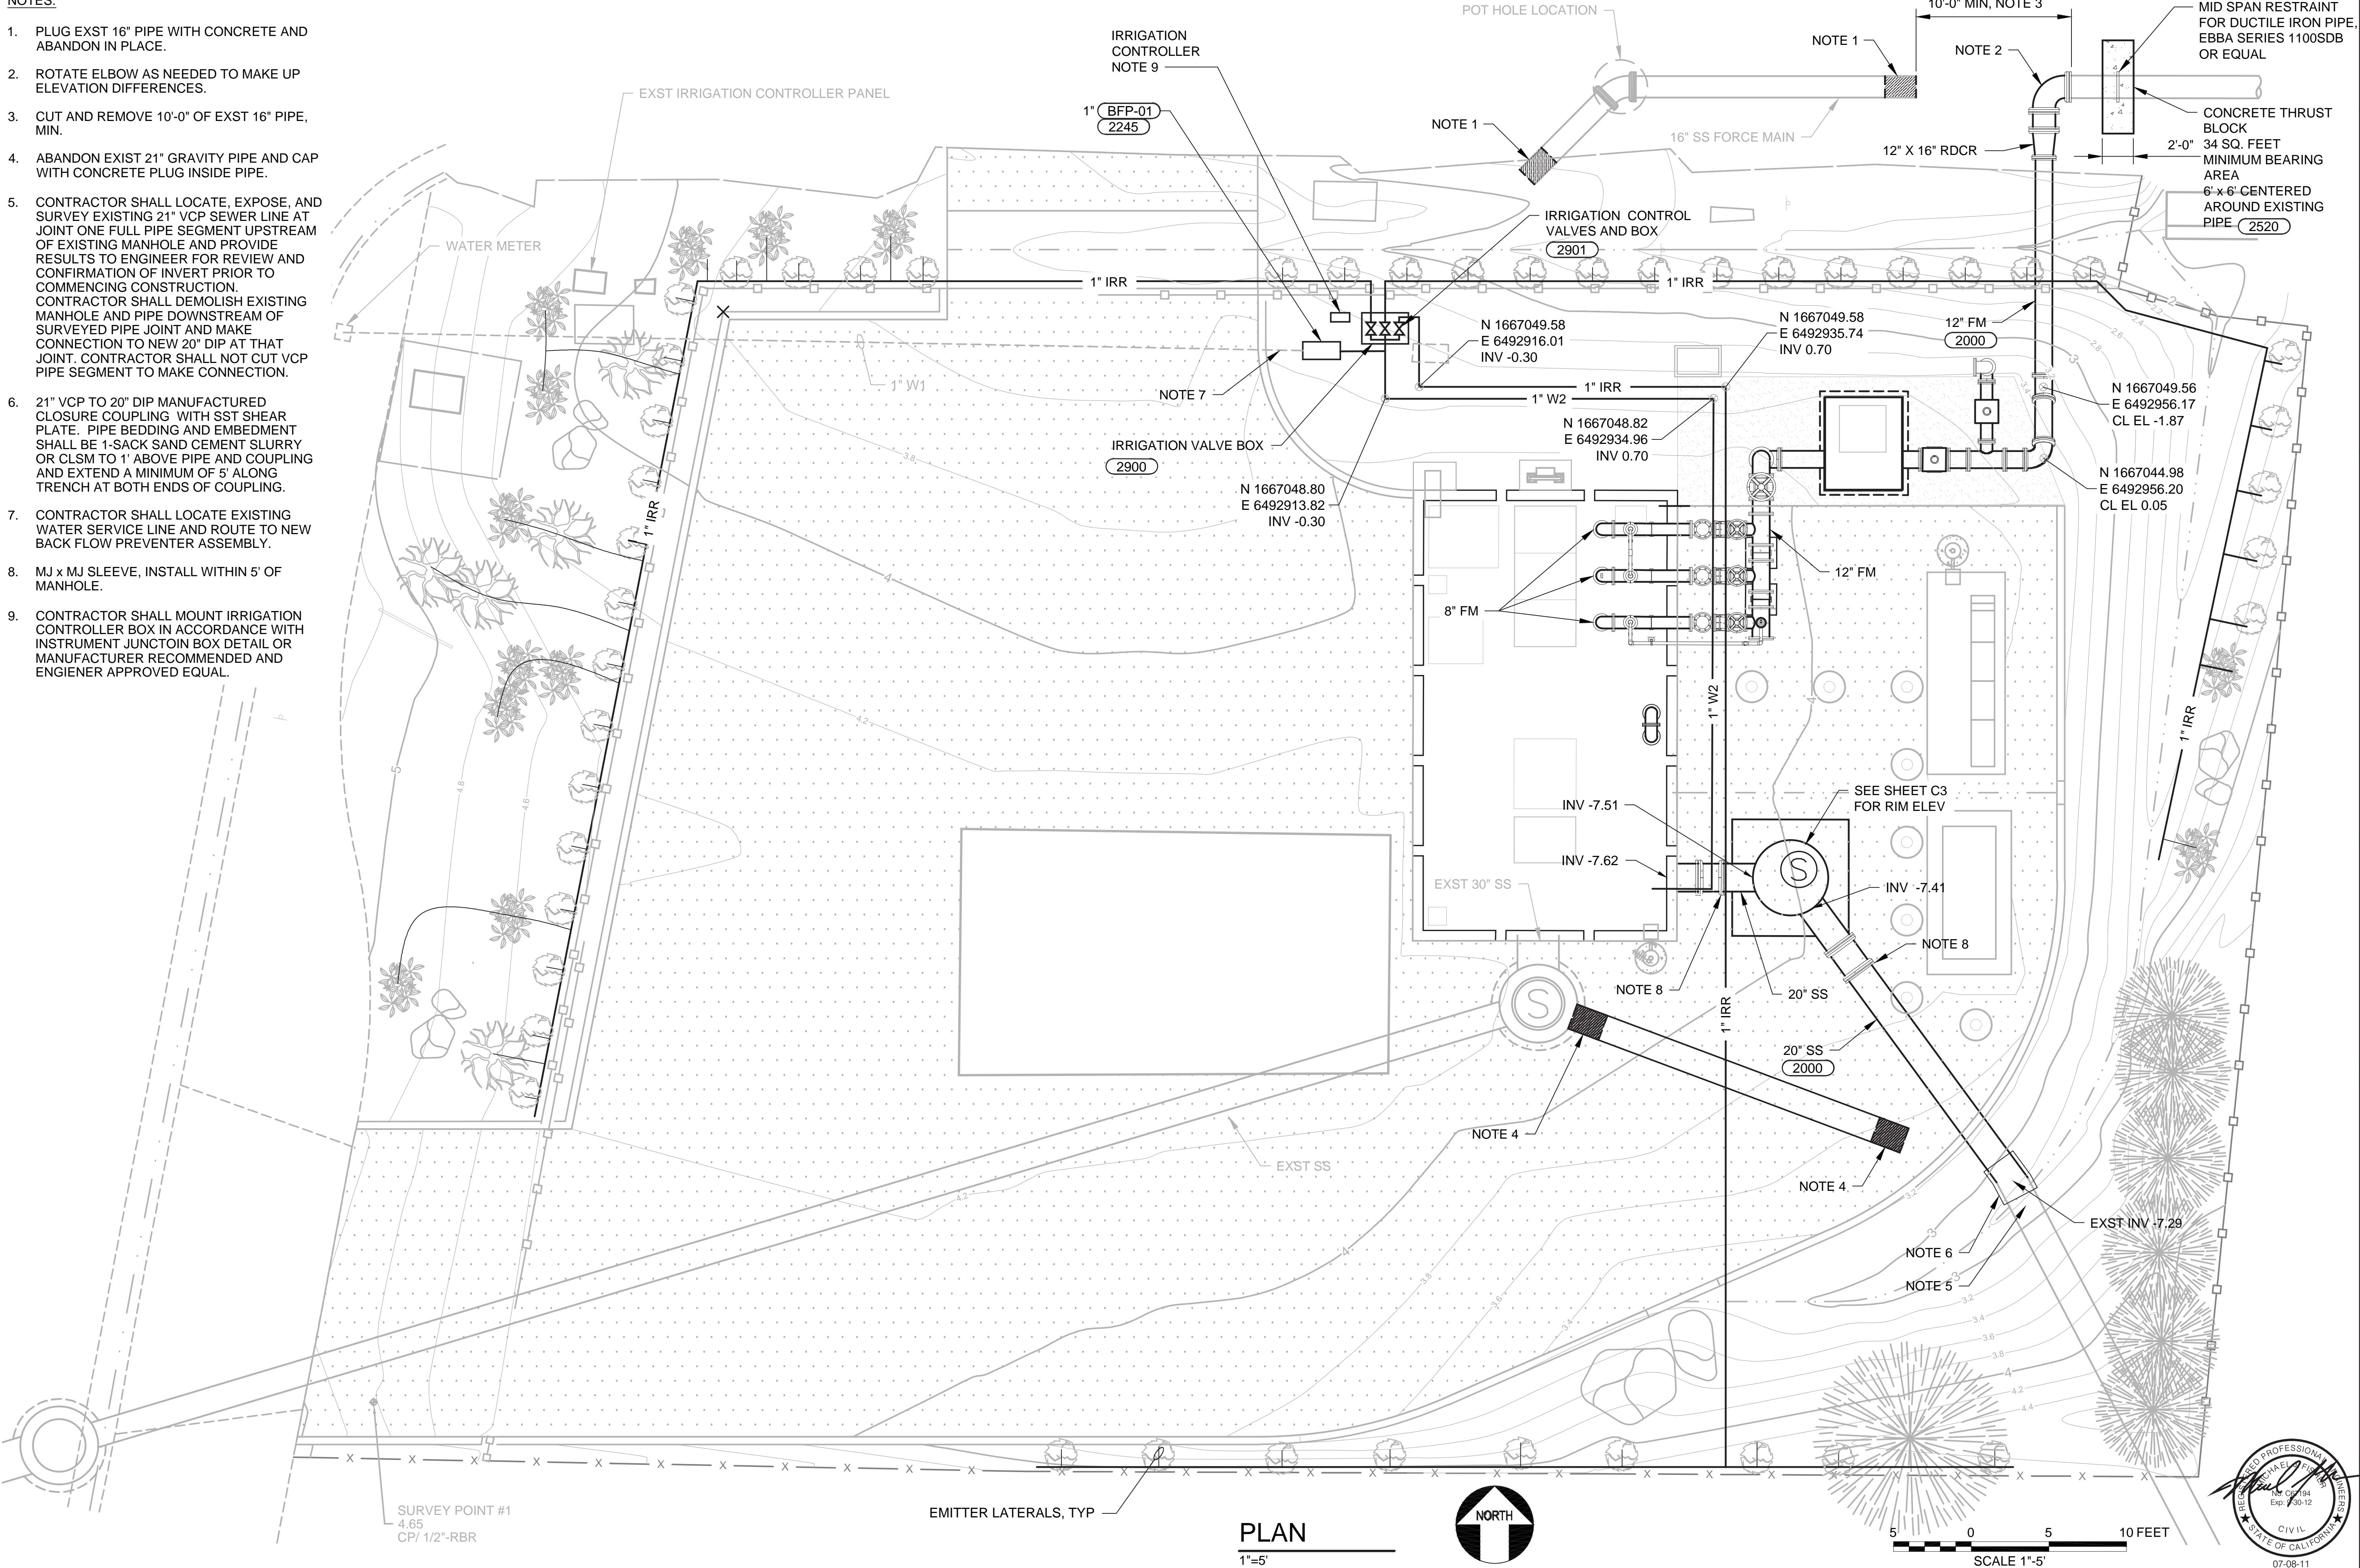



VERIFY SCALE BAR IS ONE INCH ON ORIGINAL DRAWING 0 1' IF NOT ONE INCH ON THIS SHEET, ADJUST SCALES ACCORDINGLY.	
DESIGN T. DURBIN	DRAWN M. STEELE
CHECKED J. GESELBRACHT	APPROVED M. FISHER
CITY OF ALAMEDA BAY FARM ISLAND SEWAGE LIFT STATION UPGRADE	
CIVIL YARD PIPING	
DATE JULY 2011	
PROJECT NUMBER 11-005	
DRAWING NUMBER Y-1	
SHEET NUMBER 11	

WATERWORKS
ENGINEERS
5767 Broadway #201 • Oakland, CA 94618 • 510-428-5550



T:\CAD\PROJECTS\11-005 ALAMEDA BFI\PSDRAWINGS\DELIVERABLES\1105D-5-C100.DWG


123456

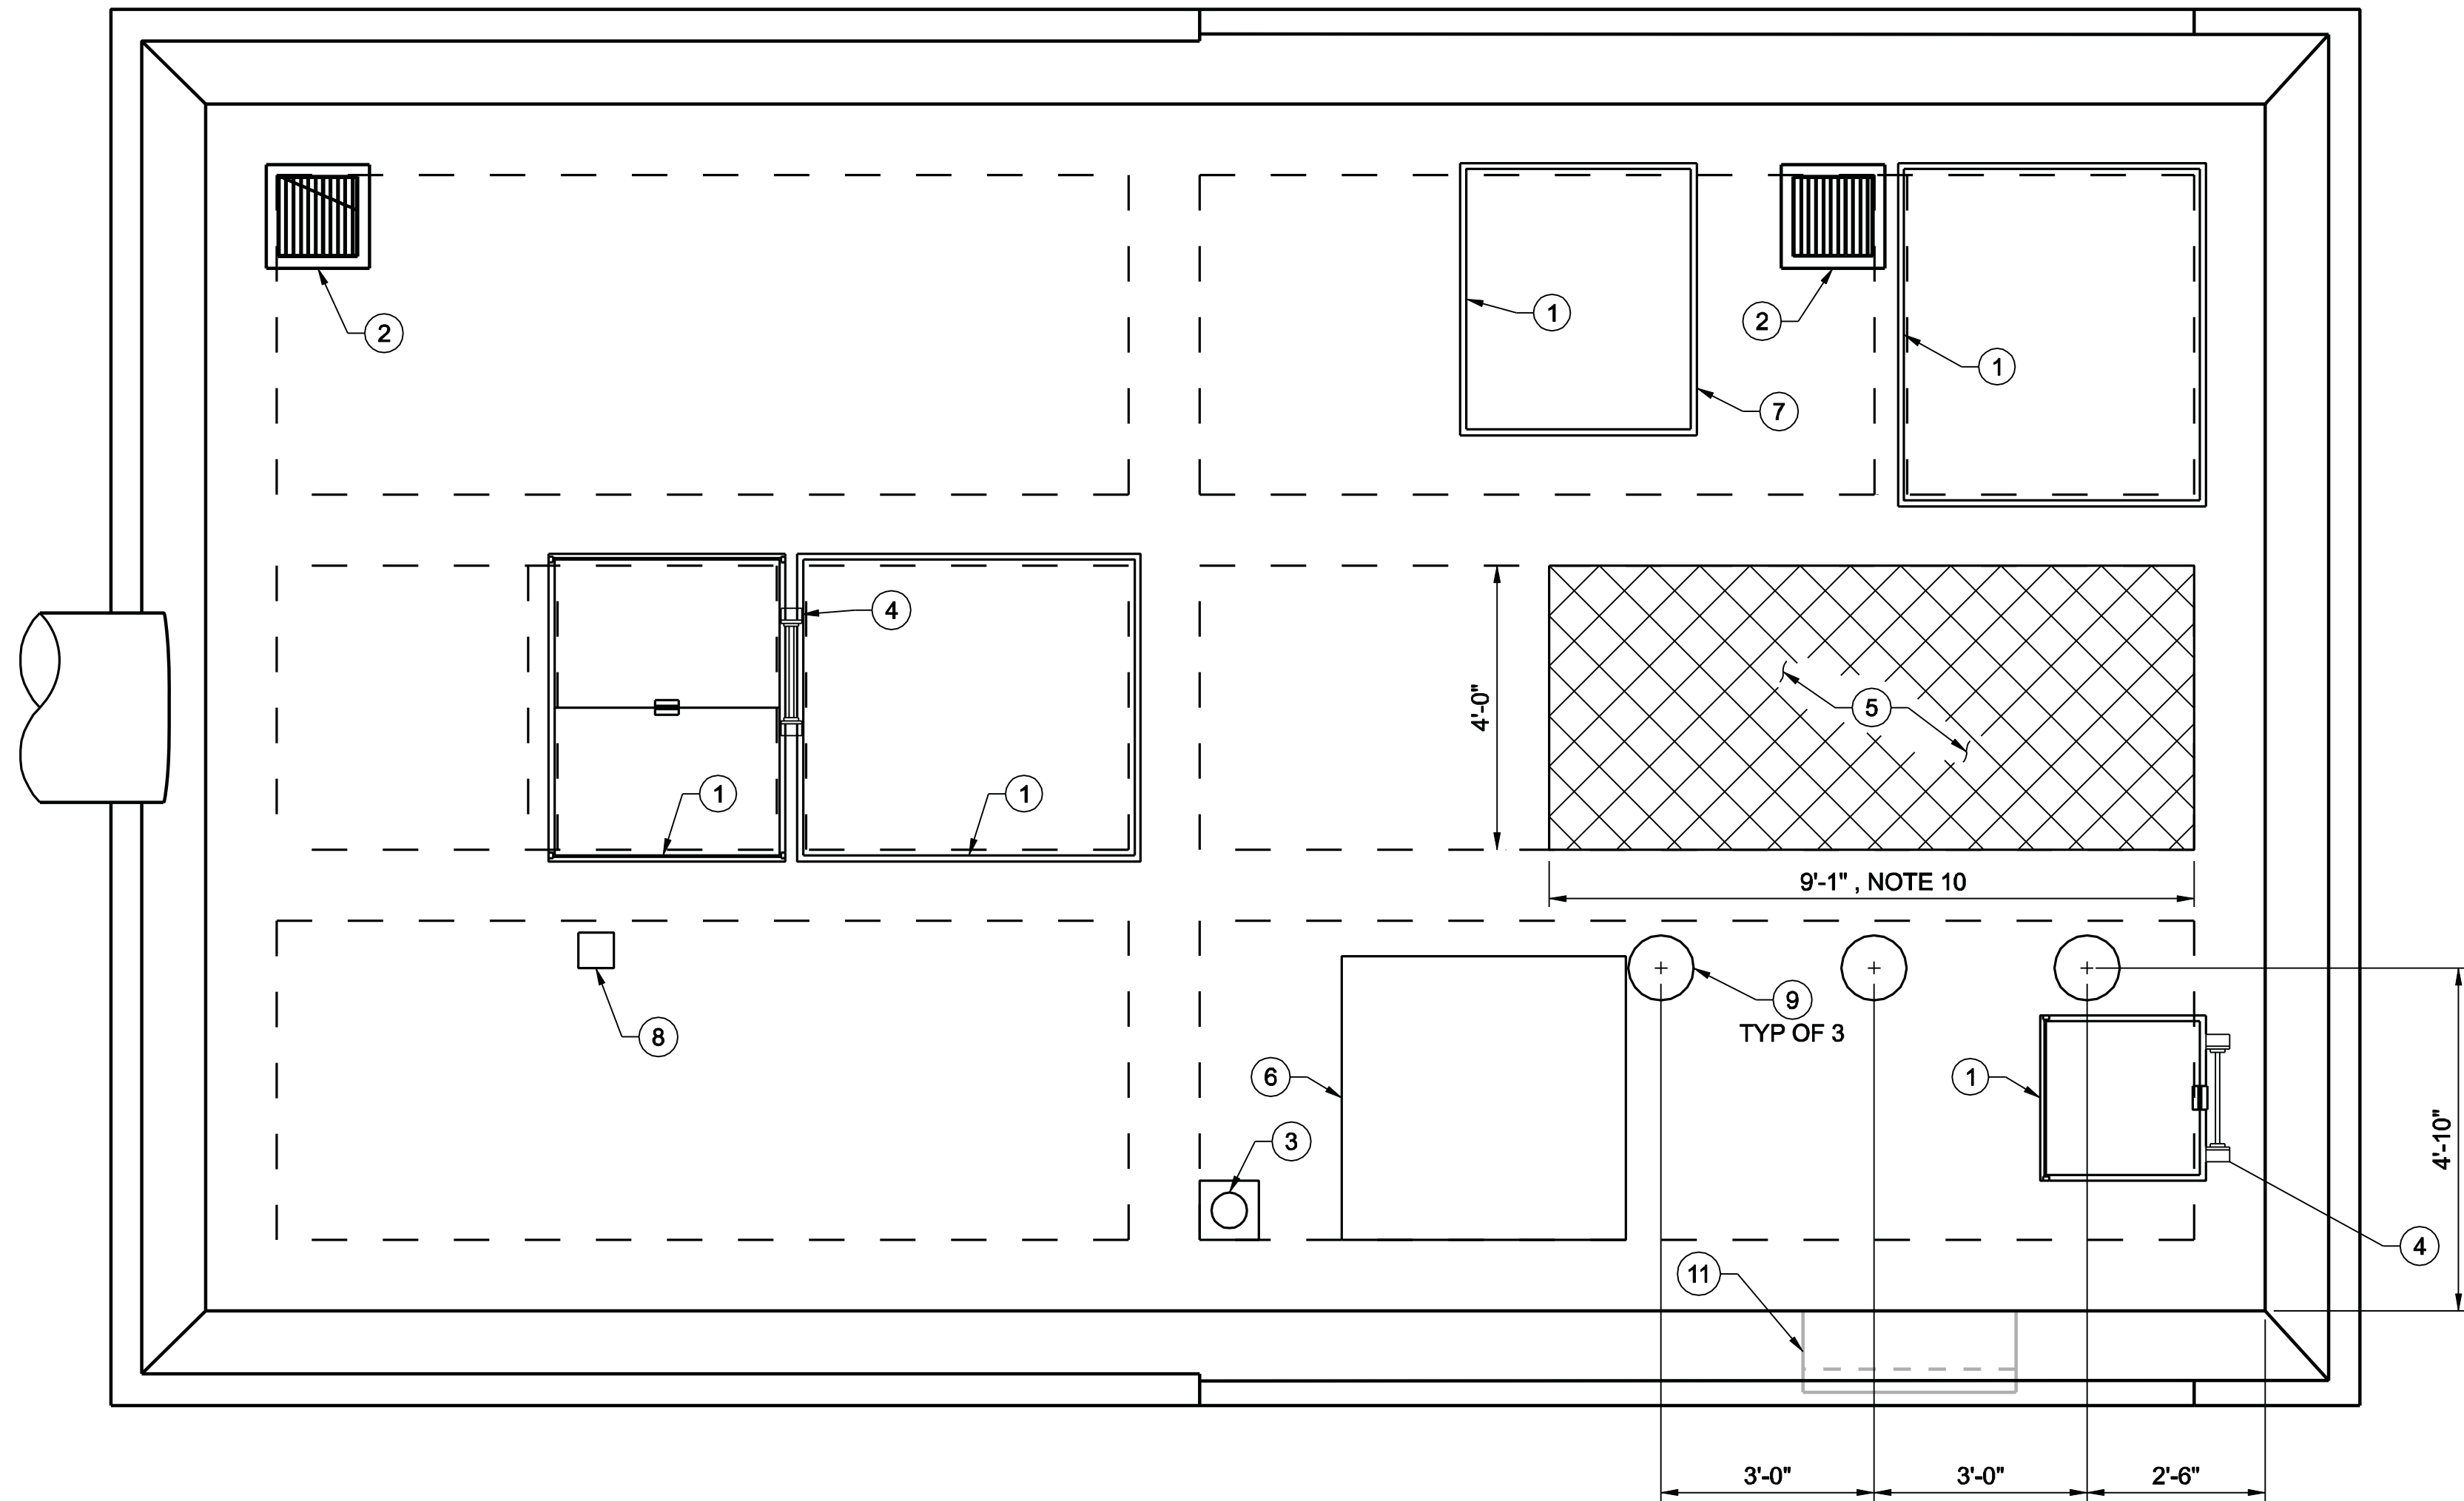

 **PLAN**
1/2"=1'-0"



- NOTES:
- DEMOLISH EXISTING HATCH COVER AND FRAME.
 - DEMOLISH EXISTING GRATING AND FRAME.
 - DEMOLISH EXISTING VENT. SAW-CUT 14" SQUARE 1-INCH DEEP AT THE TOP AND BOTTOM OF THE SLAB. DO NOT OVERCUT AT THE CORNERS. CHIP TO REMOVE THE EXISTING CONCRETE WITHIN THE SCORE LINE, WHILE PRESERVING THE EXISTING REINFORCING.
 - DEMOLISH EXISTING LADDER.
 - SAW-CUT AND DEMOLISH EXISTING CONCRETE AT NEW HATCHES. DO NOT OVERCUT AT CORNERS.
 - SAW-CUT 1-INCH DEEP AROUND THE EXISTING PATCH AT THE TOP AND BOTTOM OF SLAB. DO NOT OVERCUT AT THE CORNERS. CHIP TO REMOVE THE EXISTING CONCRETE PATCH WITHIN THE SCORE LINE, WHILE PRESERVING THE EXISTING REINFORCING.
 - SAW-CUT AROUND THE PERIMETER OF THE EXISTING OPENING TO PROVIDE A CLEAN TRANSITION FOR NEW CONCRETE PATCH. DO NOT OVERCUT AT CORNERS.
 - DEMOLISH EXISTING COVER.
 - CORE DRILL 11" DIA HOLE.
 - VERIFY LENGTH WITH STRUCTURAL DETAILS AND HATCH MANUFACTURER FRAME DIMENSIONS.
 - DEMOLISH EXISTING CONCRETE EXTENSION UNDER EXISTING CONTROL PANEL.
 - CONTRACTOR SHALL DEMOLISH ALL EXISTING BELOW GRADE EQUIPMENT, REFERENCE PHOTOS ARE FOR INFORMATION ONLY AND ARE INTENDED TO ILLUSTRATE SUBSTANTIAL EQUIPMENT FOR REMOVAL.
 - CONTRACTOR SHALL PARTICIPATE IN SITE WALK WITH CITY OF ALAMEDA OPERATIONS AND MAINTENANCE STAFF AND ENGINEER PRIOR TO COMMENCING DEMOLITION. ITEMS IDENTIFIED BY CITY DURING SITE WALK SHALL BE SALVAGED AND RETURNED TO CITY IN ACCORDANCE WITH SPECIFICATIONS.

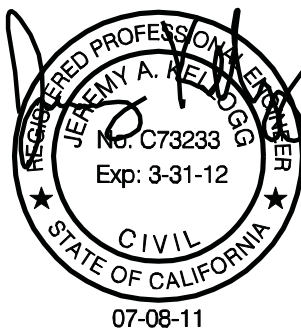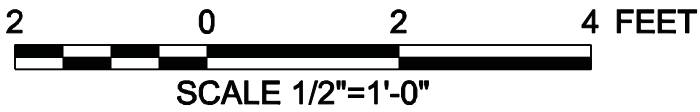

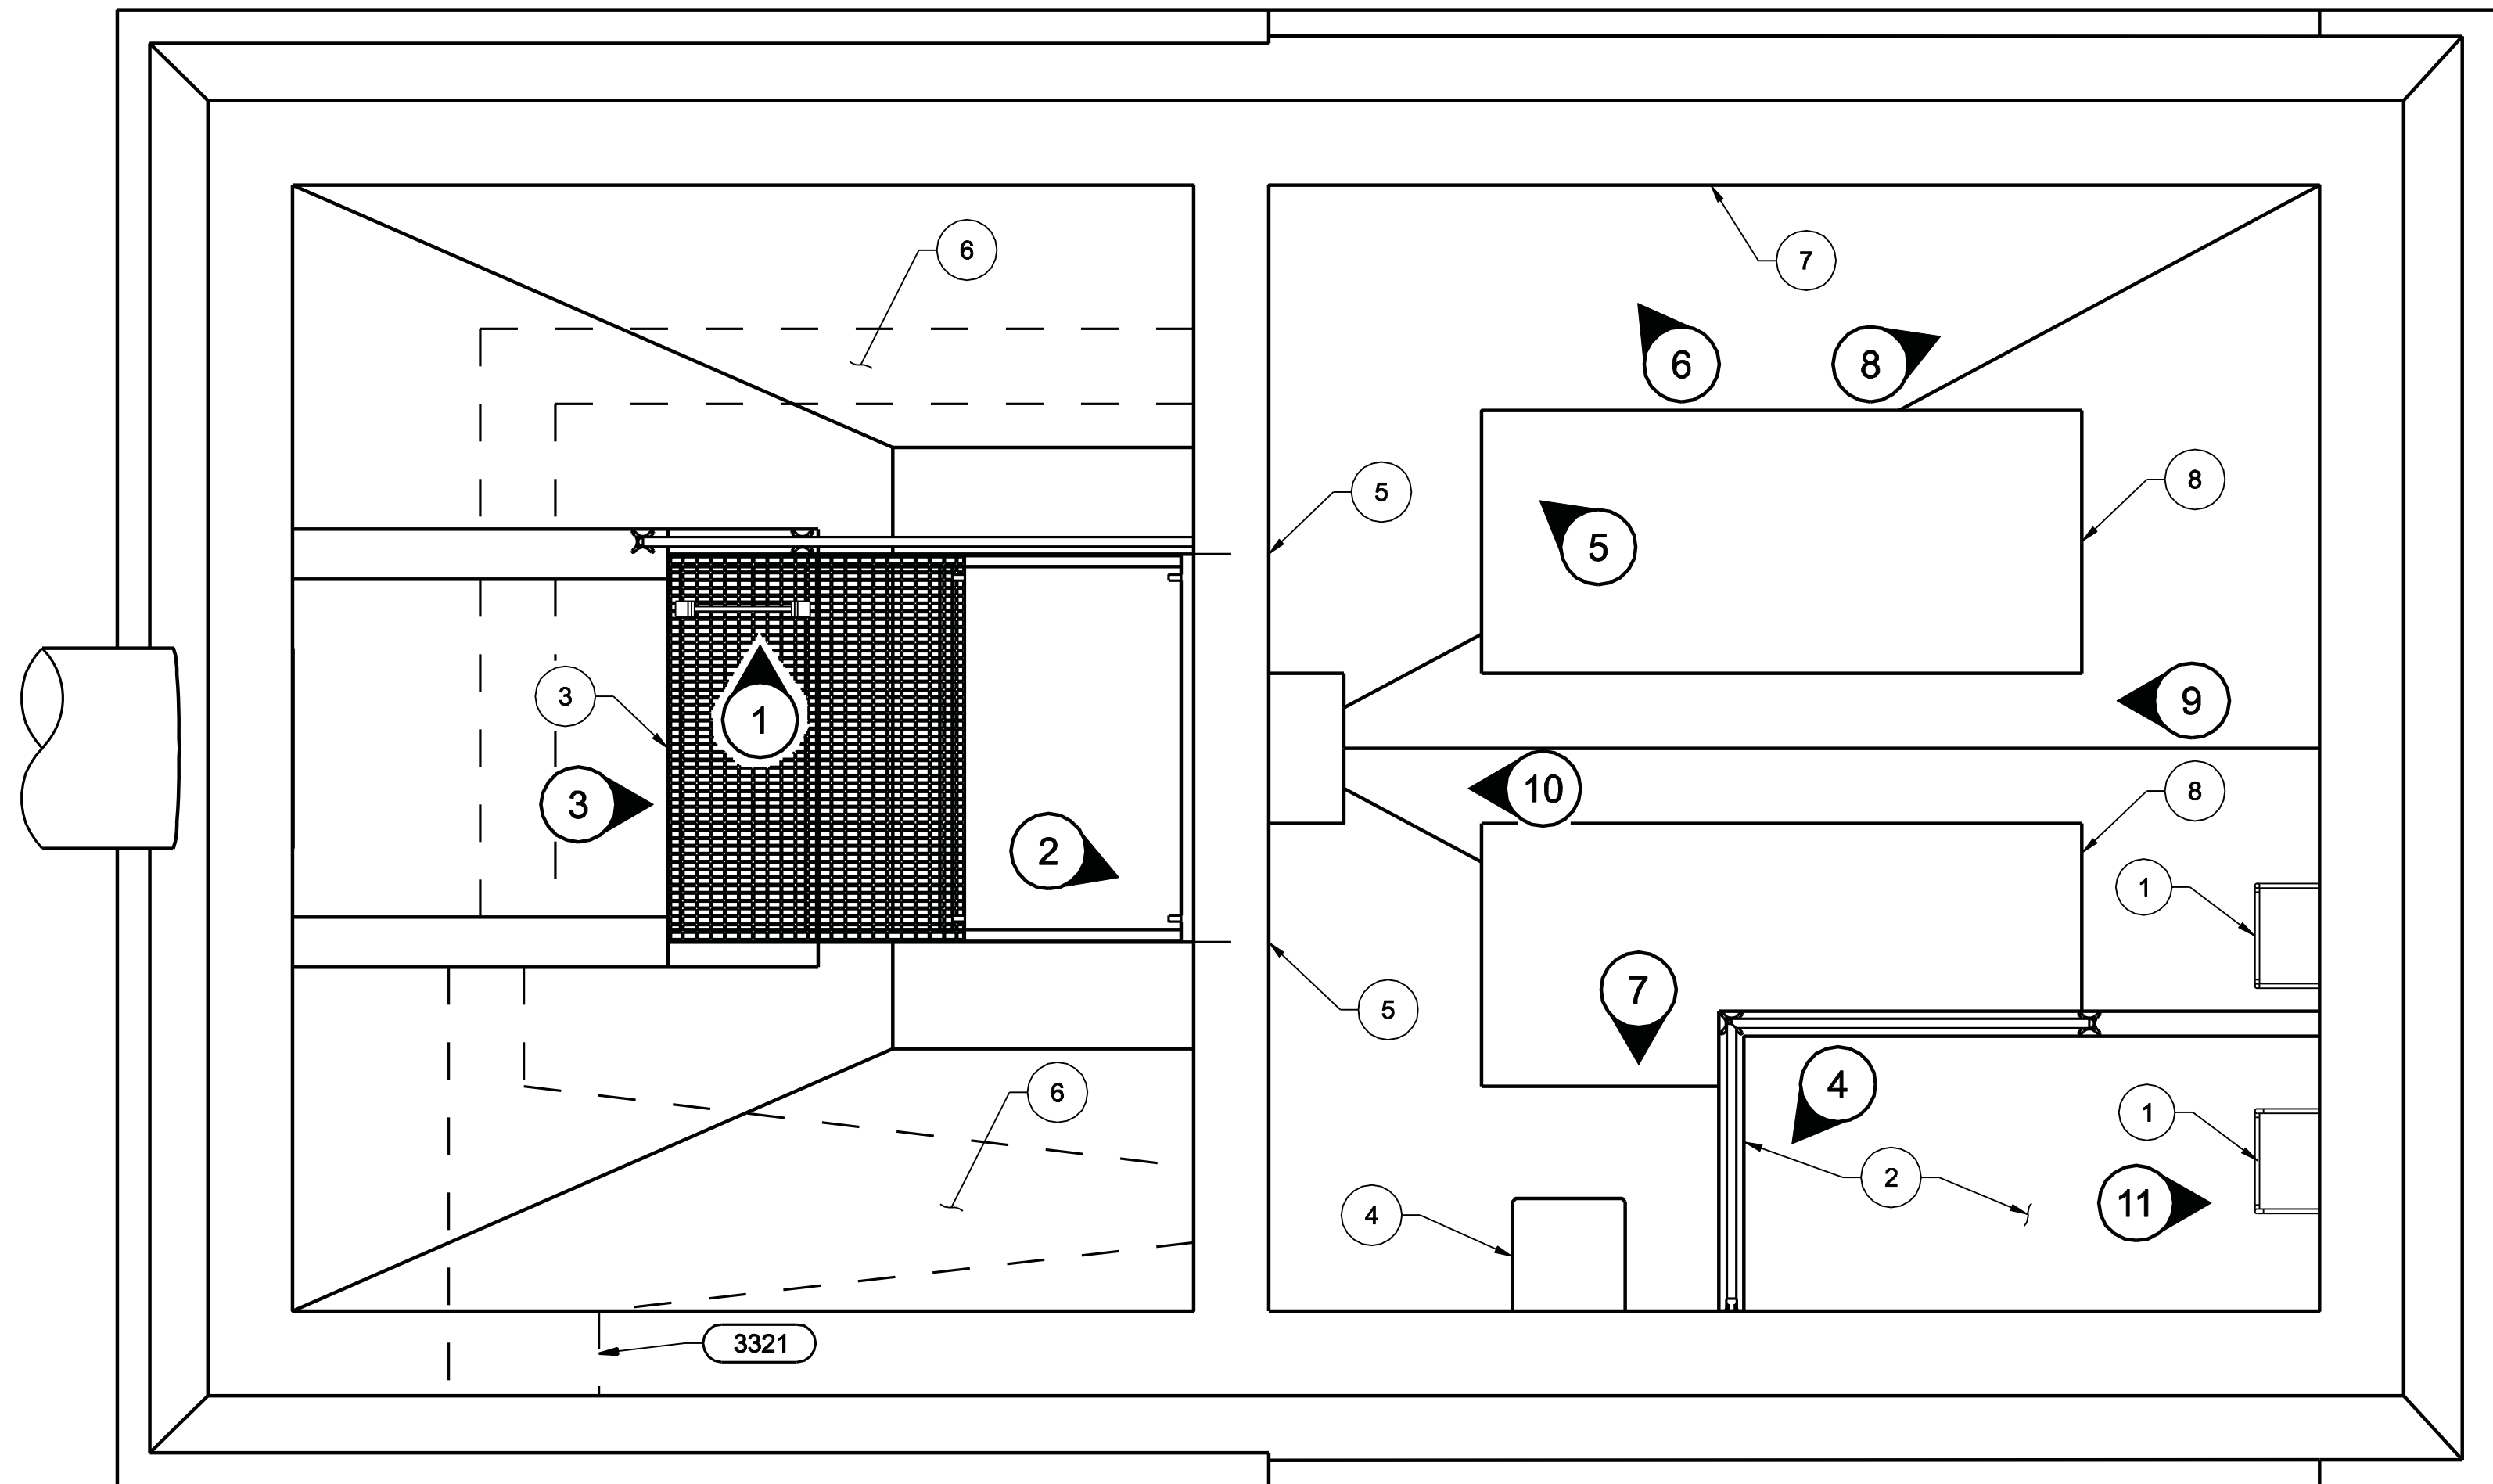

- NOTES:
1. DEMOLISH EXISTING LADDER.
 2. DEMOLISH EXISTING MEZZANINE AND GUARDRAIL. GRIND WALL SMOOTH AT MEZZANINE JOINT.
 3. DEMOLISH EXISTING GRATING SUPPORTS, AND LADDER. GRIND CONCRETE SMOOTH AT END WALL AND GRATING SUPPORT JOINT.
 4. DEMOLISH EXISTING BLOWER SUPPORT. GRIND WALL SMOOTH AT SUPPORT JOINT.
 5. SAW-CUT OPENING IN EXISTING WALL. SEE STRUCTURAL DRAWINGS FOR OPENING DIMENSIONS. DO NOT OVERCUT AT CORNERS.
 6. SAW-CUT AND DEMOLISH PORTION OF EXISTING CONCRETE FLOW CHANNEL TO 4" MINIMUM BELOW NEW FINISH SURFACE ELEVATION. COORDINATE LOCATION AND DEPTH OF SAW-CUTS WITH STRUCTURAL DRAWINGS.
 7. PRIOR TO COMMENCING DEMOLITION, COMPLETE ASBESTOS AND LEAD IN PAINT TESTING OF EXISTING PUMP STATION FACILITIES BY ACCREDITED 3RD PARTY LABORATORY AND TESTING FIRM IN ACCORDANCE WITH SPECIFICATIONS. CONDUCT ASBESTOS INSPECTION IN COMPLIANCE WITH US EPA NESHAP REQUIREMENTS FOR ASBESTOS INSPECTION OF A BUILDING STRUCTURE PRIOR TO RENOVATION OR DEMOLITION AND FOR CAL/OSHA COMPLIANCE WITH TITLE 8 1532.1 LEAD IN CONSTRUCTION REQUIREMENTS. ALL WORK SHALL BE CONDUCTED IN ACCORDANCE WITH ABATEMENT RECOMMENDATIONS FOR LEAD IN PAINT AND ASBESTOS RESULTING FROM THE INSPECTION.
 8. DEMOLISH EXISTING PUMP SUPPORTS.
 9. AT ALL SAW-CUTS NOT COVERED BY NEW CONCRETE, BURN BACK ALL EXPOSED/CUT REINFORCING BARS 1-INCH MINIMUM AND PATCH RECESS PER CONCRETE REPAIR SPECIFICATIONS.
 10. DEMOLITION PHOTOGRAPHS ARE SHOWN ON SHEETS D3 TO D5. REFERENCE PHOTOGRAPHS ARE FOR INFORMATION ONLY AND ARE INTENDED TO ILLUSTRATE SUBSTANTIAL EQUIPMENT FOR REMOVAL ONLY.
 11. DEMOLISH ALL EXISTING BELOW GRADE MECHANICAL EQUIPMENT.

PLAN
1/2"=1'-0"

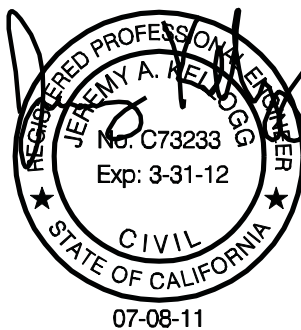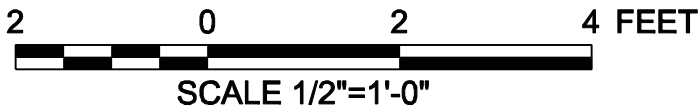

VERIFY SCALE BAR IS ONE INCH ON ORIGINAL DRAWING. 0 1" IF NOT ONE INCH ON THIS SHEET, ADJUST SCALES ACCORDINGLY.	DESIGN T. DURBIN	WATERWORKS ENGINEERS 5767 Broadway #201 • Oakland, CA 94618 • 510-423-9590	CITY OF ALAMEDA BAY FARM ISLAND PUMP STATION REHABILITATION PROJECT	DEMOLITION LOWER PLAN	DATE JULY 2011
	DRAWN J. MARTIN				PROJECT NUMBER 11-005
	CHECKED J. KELLOGG				DRAWING NUMBER D-2
	APPROVED J. GESELBRACHT				SHEET NUMBER 13



1 LADDER, PLATFORM & PUMP DEMOLITION
NTS



2 CHECK VALVE & ELBOW DEMOLITION
NTS



3 LADDER & PLATFORM DEMOLITION
NTS



4 LEVEL SWITCH, PIPING & DUCTING
NTS

DESIGN T DURBIN		VERIFIED SCALE BAR IS ONE INCH ON ORIGINAL DRAWING. 0 1" IF NOT ONE INCH ON THIS SHEET, ADJUST SCALES ACCORDINGLY.
DRAWN J MARTIN		
CHECKED M FISHER		
APPROVED J GESELBRACHT		
WATERWORKS ENGINEERS 5767 Broadway #201 • Oakland, CA 94618 • 510-423-9590		
CITY OF ALAMEDA BAY FARM ISLAND PUMP STATION REHABILITATION PROJECT		
DEMOLITION PHOTOS		
DATE JULY 2011		
PROJECT NUMBER 11-005		
DRAWING NUMBER D-3		
SHEET NUMBER 14		



5 PIPING, VALVES, PUMP & DUCTING DEMOLITION
NTS




7 HANDRAIL, PLATFORM, PIPING & DUCTING DEMOLITION
NTS



6 PIPING AND VALVE DEMOLITION
NTS



8 DUCTING & VALVE DEMOLITION
NTS

DEMOLITION		 <div>WATERWORKS ENGINEERS 5767 Broadway #201 • Oakland, CA 94618 • 510-428-9590</div>	<div>DESIGN T DURBIN</div> <div>DRAWN J MARTIN</div> <div>CHECKED M FISHER</div> <div>APPROVED J GESELBRACHT</div>	VERIFY SCALE BAR IS ONE INCH ON ORIGINAL DRAWING. 0 1" IF NOT ONE INCH ON THIS SHEET, ADJUST SCALES ACCORDINGLY.
CITY OF ALAMEDA BAY FARM ISLAND PUMP STATION REHABILITATION PROJECT				
PHOTOS				
DATE JULY 2011				
PROJECT NUMBER 11-005				
DRAWING NUMBER D-4				
SHEET NUMBER 15				



9 EQUIP PAD, PUMPS, PIPING AND VALVES DEMOLITION
NTS



10 PUMP AND PIPING DEMOLITION
NTS




11 LADDER DEMOLITION
NTS

WATERWORKS
ENGINEERS
5767 Broadway #201 • Oakland, CA 94618 • 510-428-5590





CITY OF ALAMEDA
BAY FARM ISLAND PUMP STATION
REHABILITATION PROJECT

DEMOLITION
PHOTOS

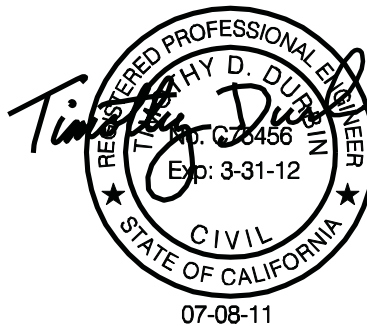

DATE
JULY 2011
PROJECT NUMBER
11-005
DRAWING NUMBER
D-5
SHEET NUMBER 16

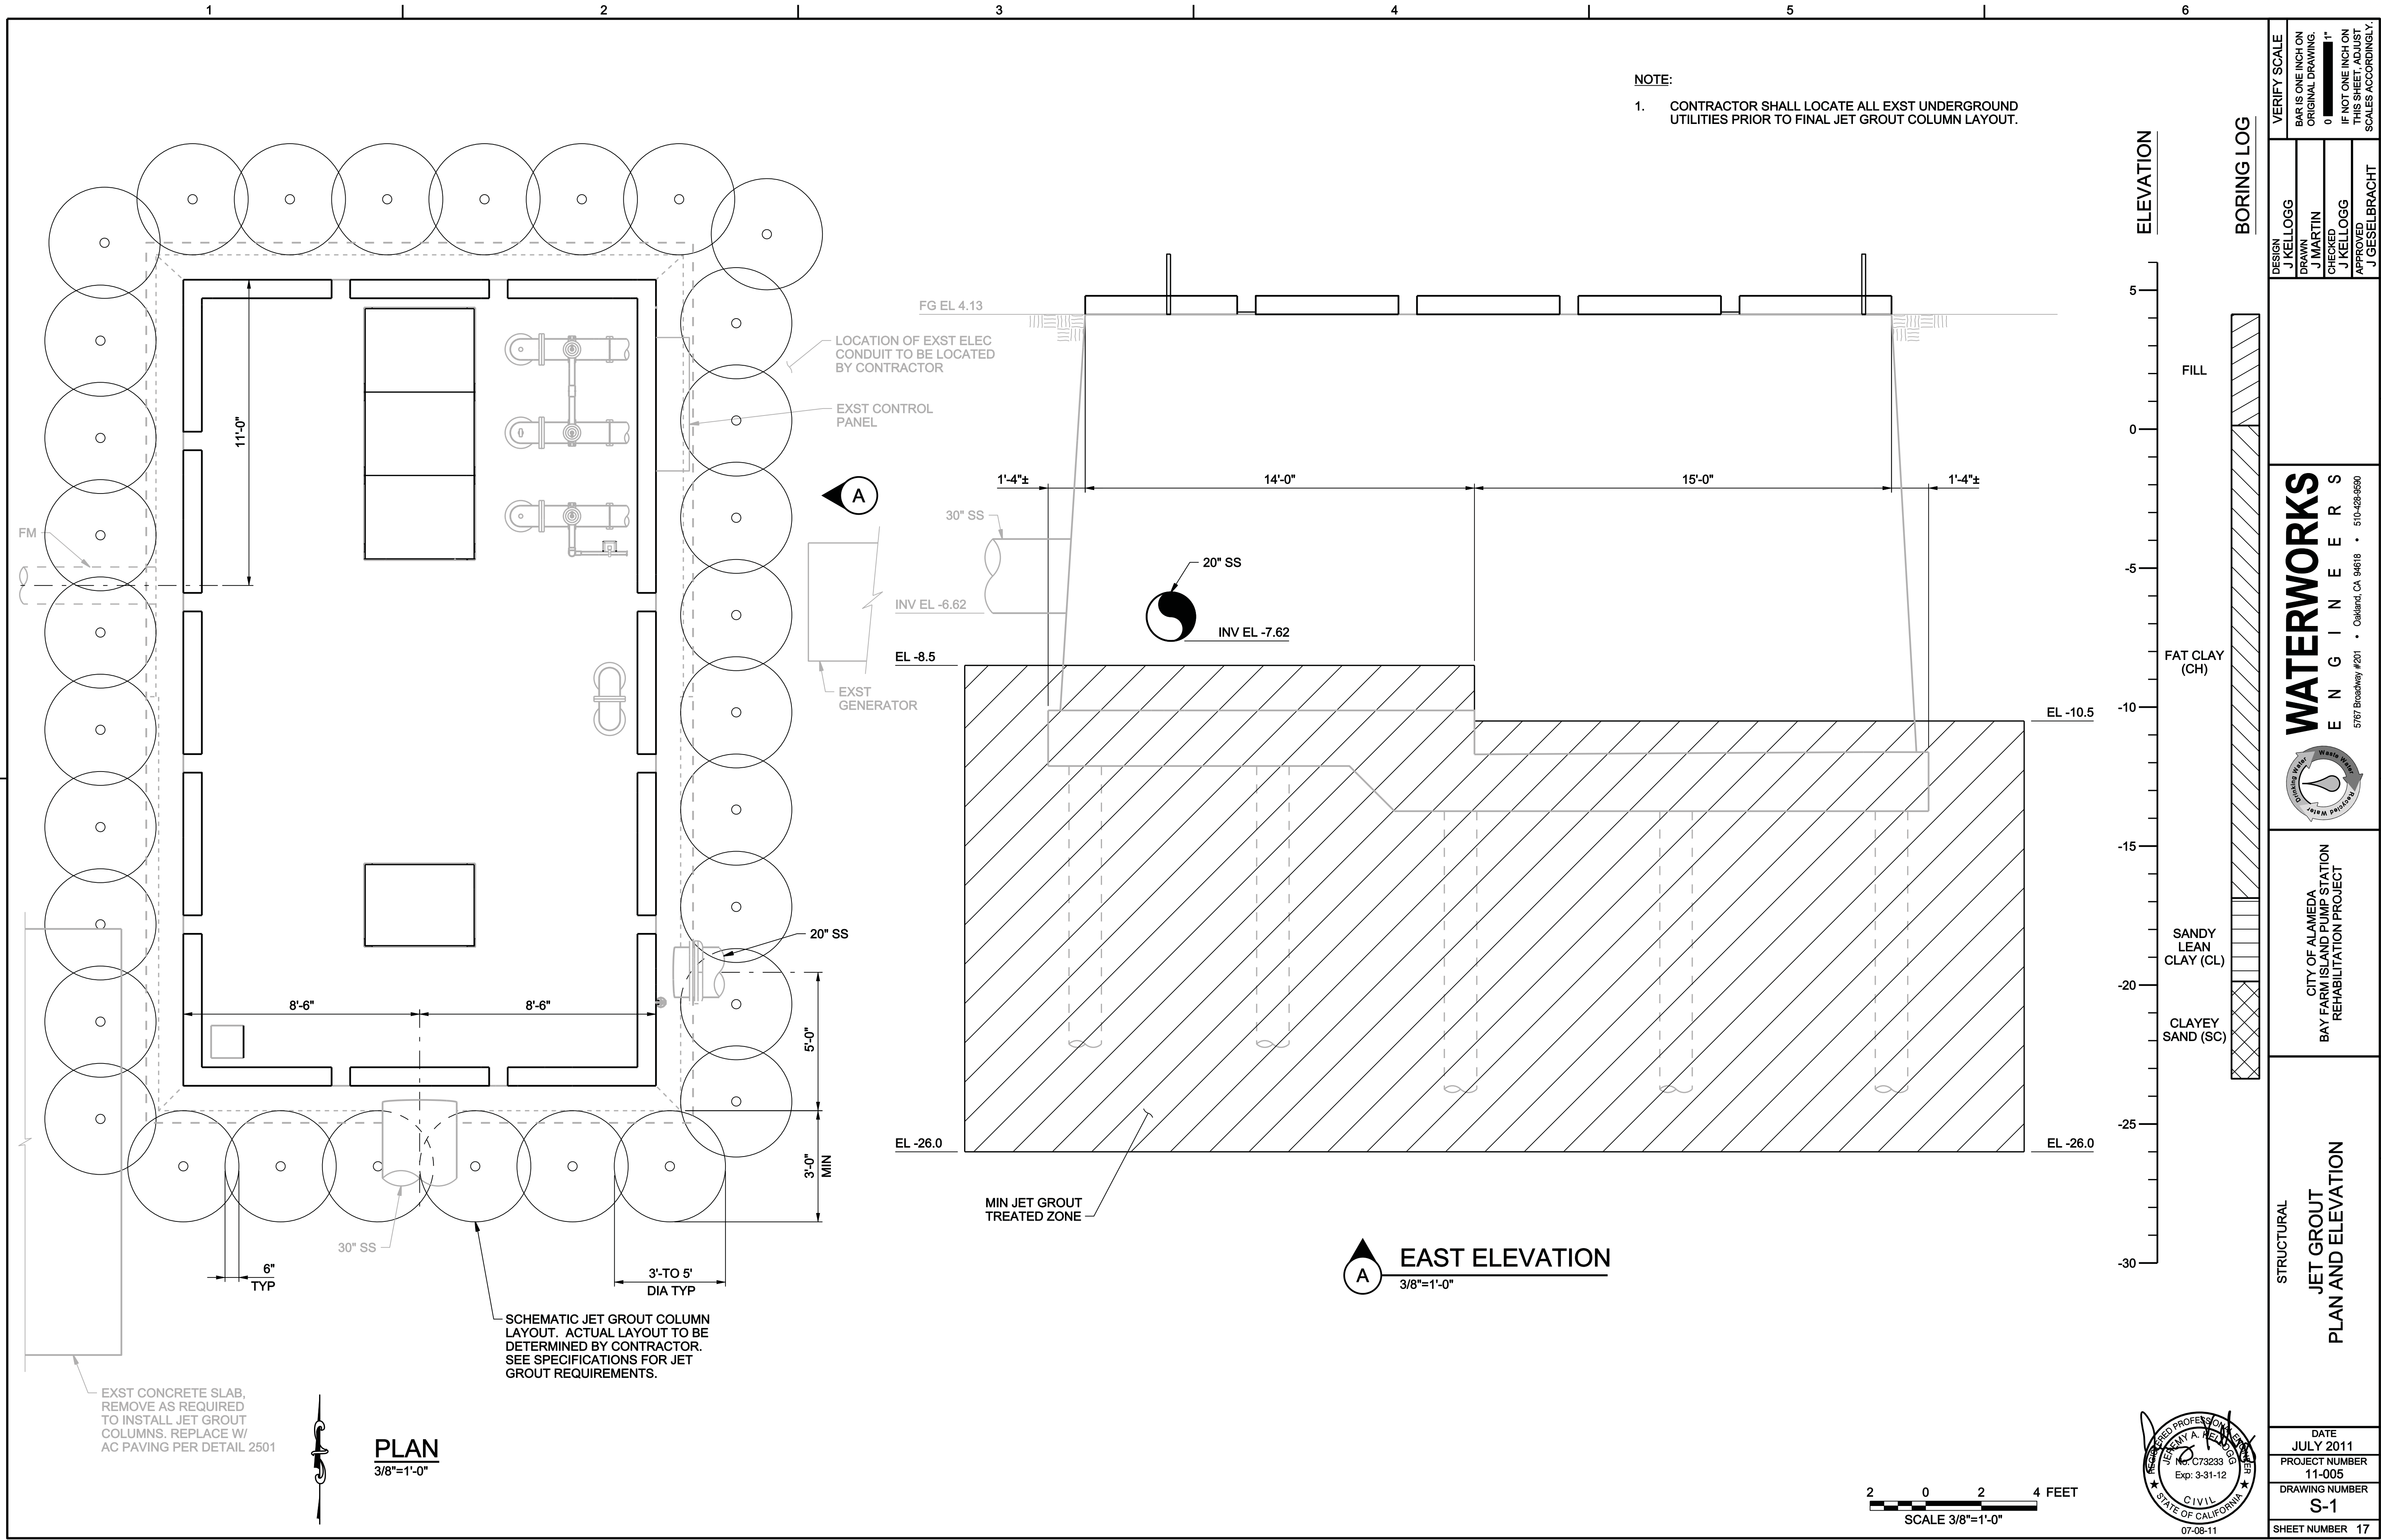

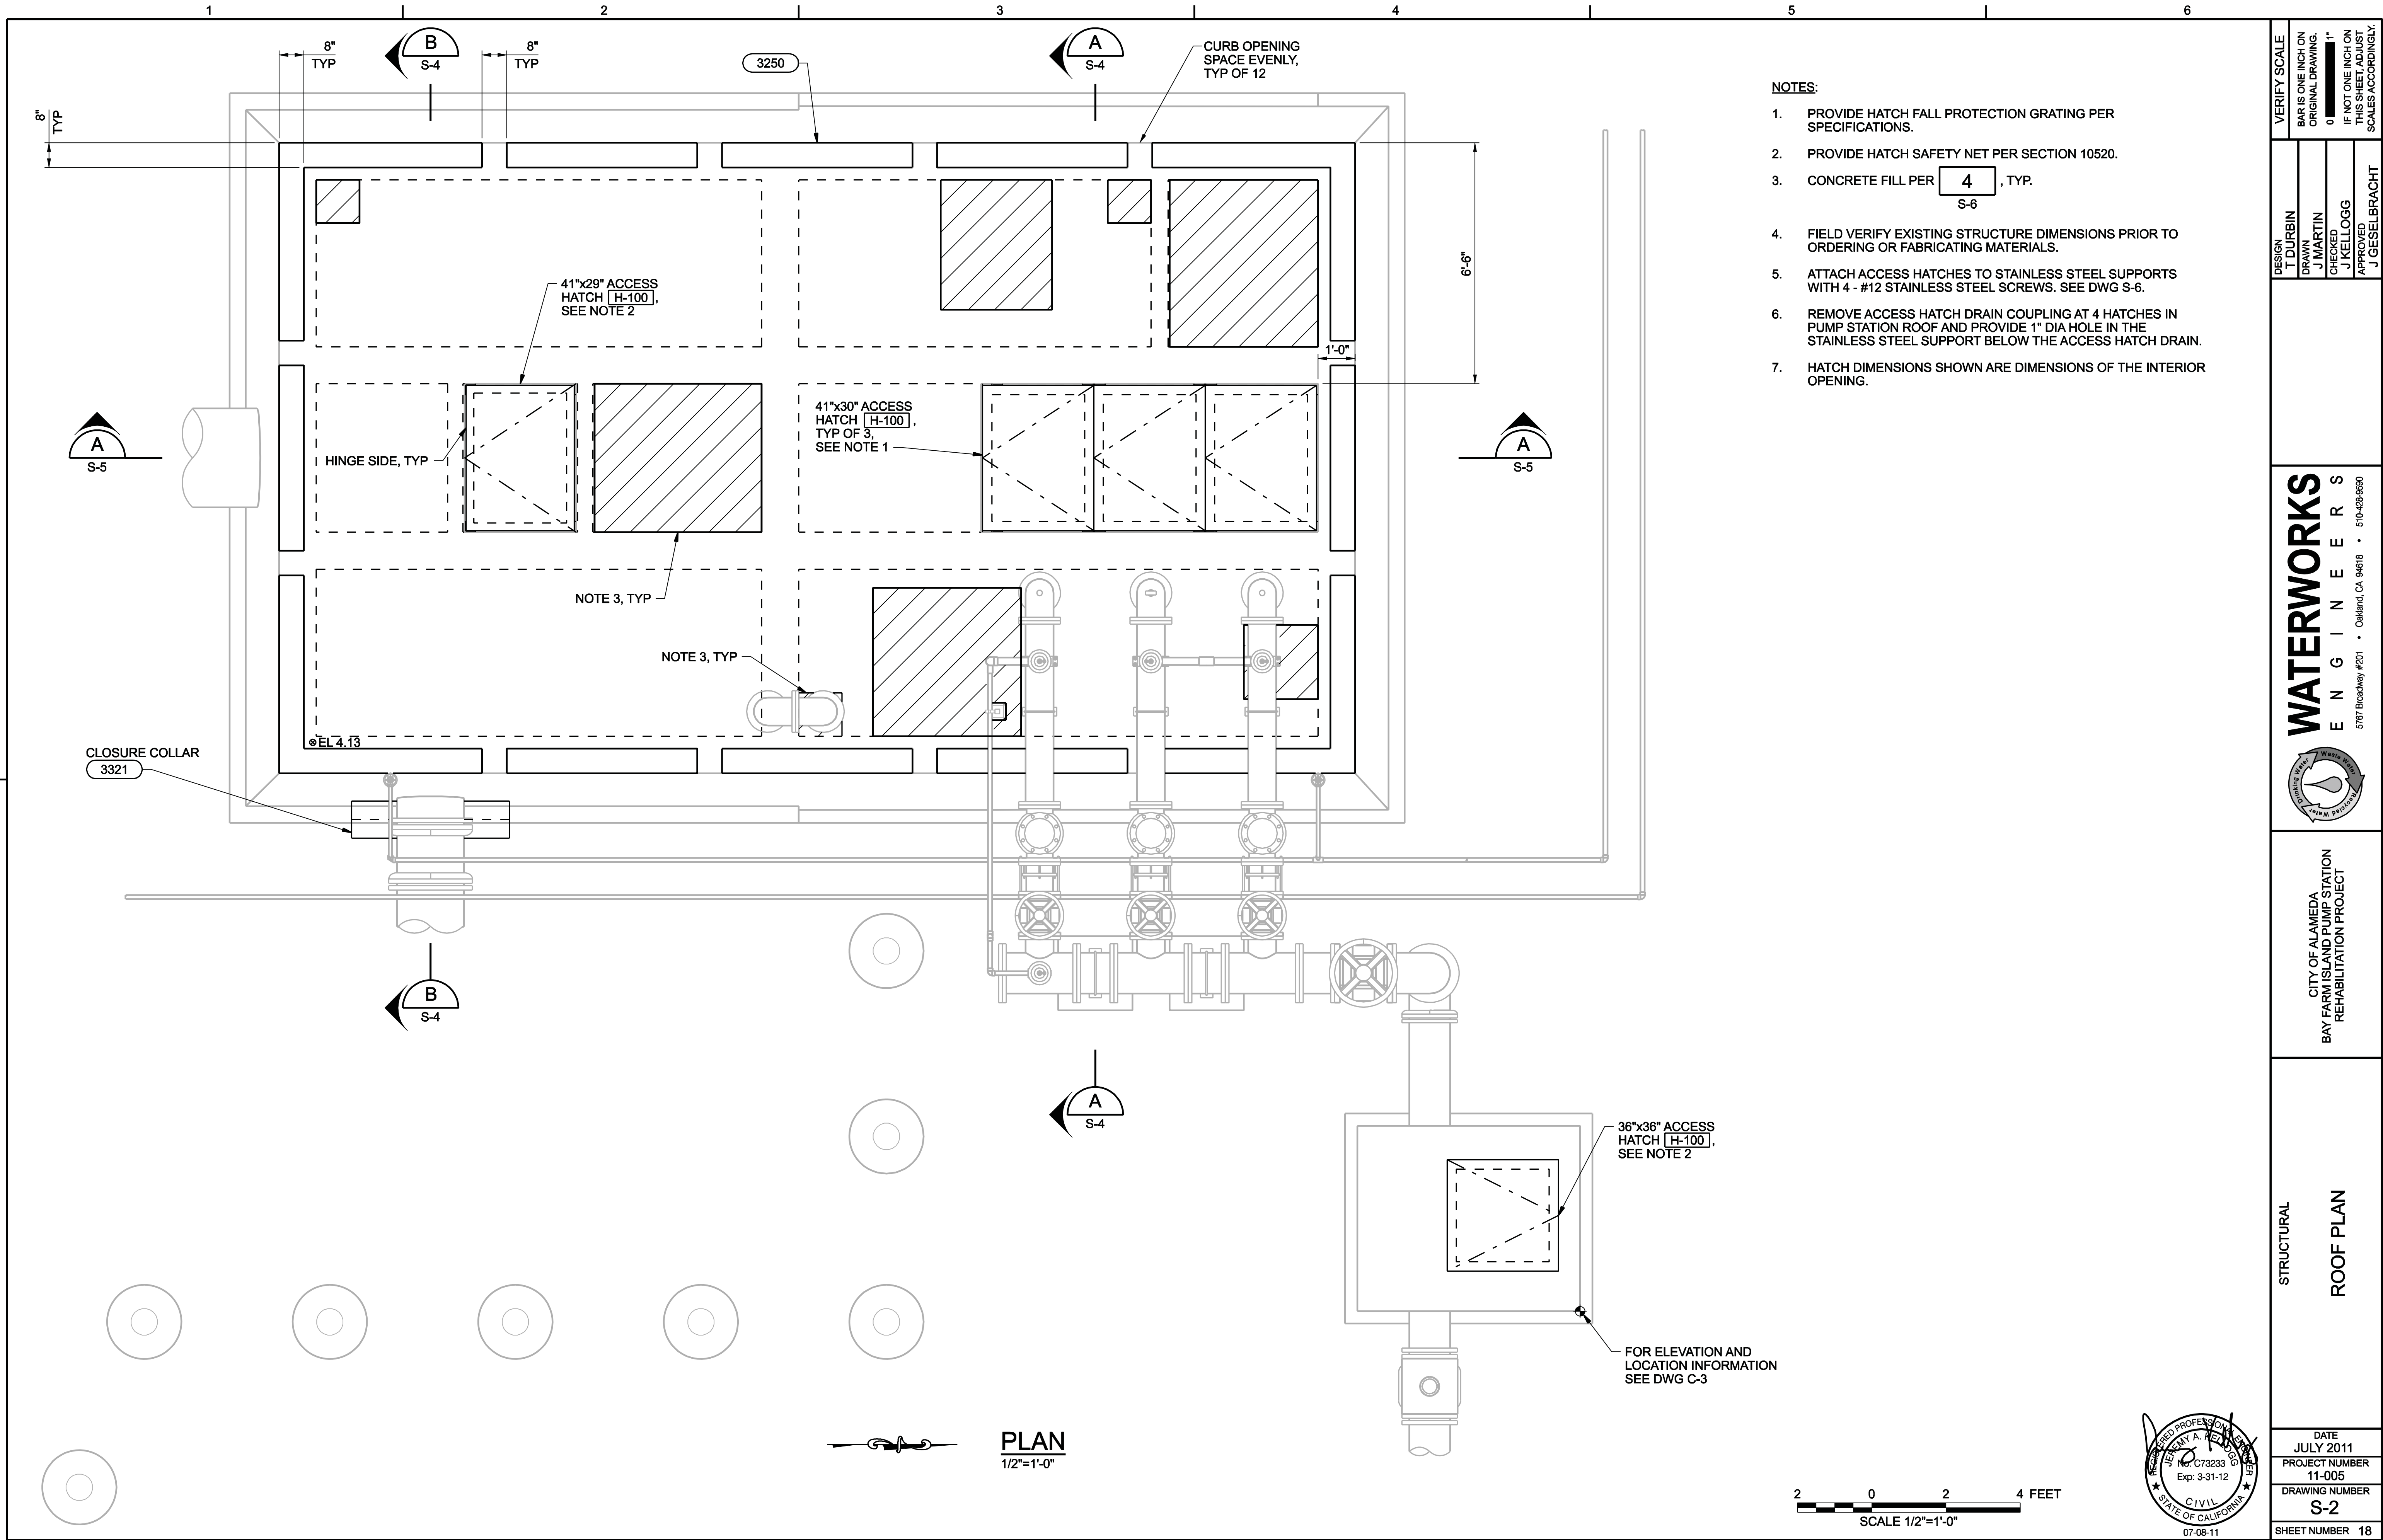

- NOTES:
1. PROVIDE HATCH FALL PROTECTION GRATING PER SPECIFICATIONS.
 2. PROVIDE HATCH SAFETY NET PER SECTION 10520.
 3. CONCRETE FILL PER **4**, TYP.
S-6
 4. FIELD VERIFY EXISTING STRUCTURE DIMENSIONS PRIOR TO ORDERING OR FABRICATING MATERIALS.
 5. ATTACH ACCESS HATCHES TO STAINLESS STEEL SUPPORTS WITH 4 - #12 STAINLESS STEEL SCREWS. SEE DWG S-6.
 6. REMOVE ACCESS HATCH DRAIN COUPLING AT 4 HATCHES IN PUMP STATION ROOF AND PROVIDE 1" DIA HOLE IN THE STAINLESS STEEL SUPPORT BELOW THE ACCESS HATCH DRAIN.
 7. HATCH DIMENSIONS SHOWN ARE DIMENSIONS OF THE INTERIOR OPENING.


WATERWORKS
ENGINEERS
5767 Broadway #201 • Oakland, CA 94618 • 510-428-6590



CITY OF ALAMEDA
BAY FARM ISLAND PUMP STATION
REHABILITATION PROJECT


STRUCTURAL
ROOF PLAN


DATE
JULY 2011
PROJECT NUMBER
11-005
DRAWING NUMBER
S-2
SHEET NUMBER
18

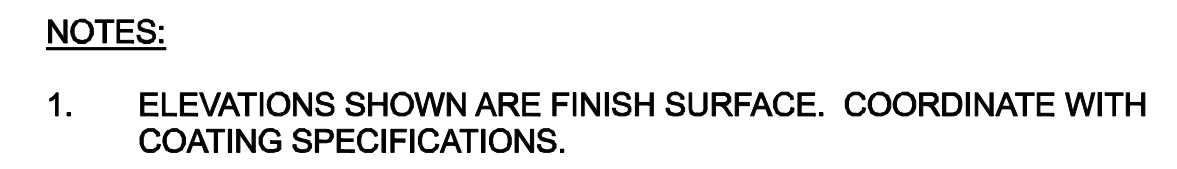












2 0 2 4 FEET

SCALE 1/2"=1'-0"

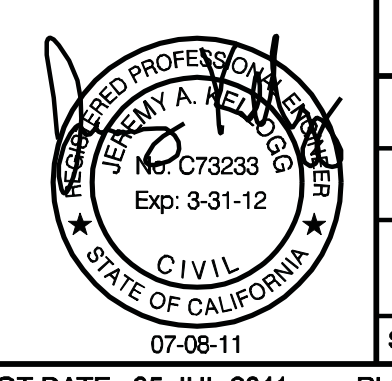


<div><div>DATE JULY 2011</div><div>PROJECT NUMBER 11-005</div><div>DRAWING NUMBER S-3</div></div> <div>SHEET NUMBER 19</div>	<div>STRUCTURAL</div> <div>LOWER PLAN</div>	<div>CITY OF ALAMEDA BAY FARM ISLAND PUMP STATION REHABILITATION PROJECT</div>	<div><div></div><div>WATERWORKS ENGINEERS 5167 Broadway #201 • Oakland, CA 94618 • 510-428-9590</div></div>		DESIGN	T DURBIN		VERIFY SCALE	BAR IS ONE INCH ON ORIGINAL DRAWING.
					DRAWN	J MARTIN		0 <div></div> 1"	
					CHECKED	J KELLOGG		IF NOT ONE INCH ON THIS SHEET, ADJUST SCALES ACCORDINGLY.	
					APPROVED				
					J GESELBRACHT	A			

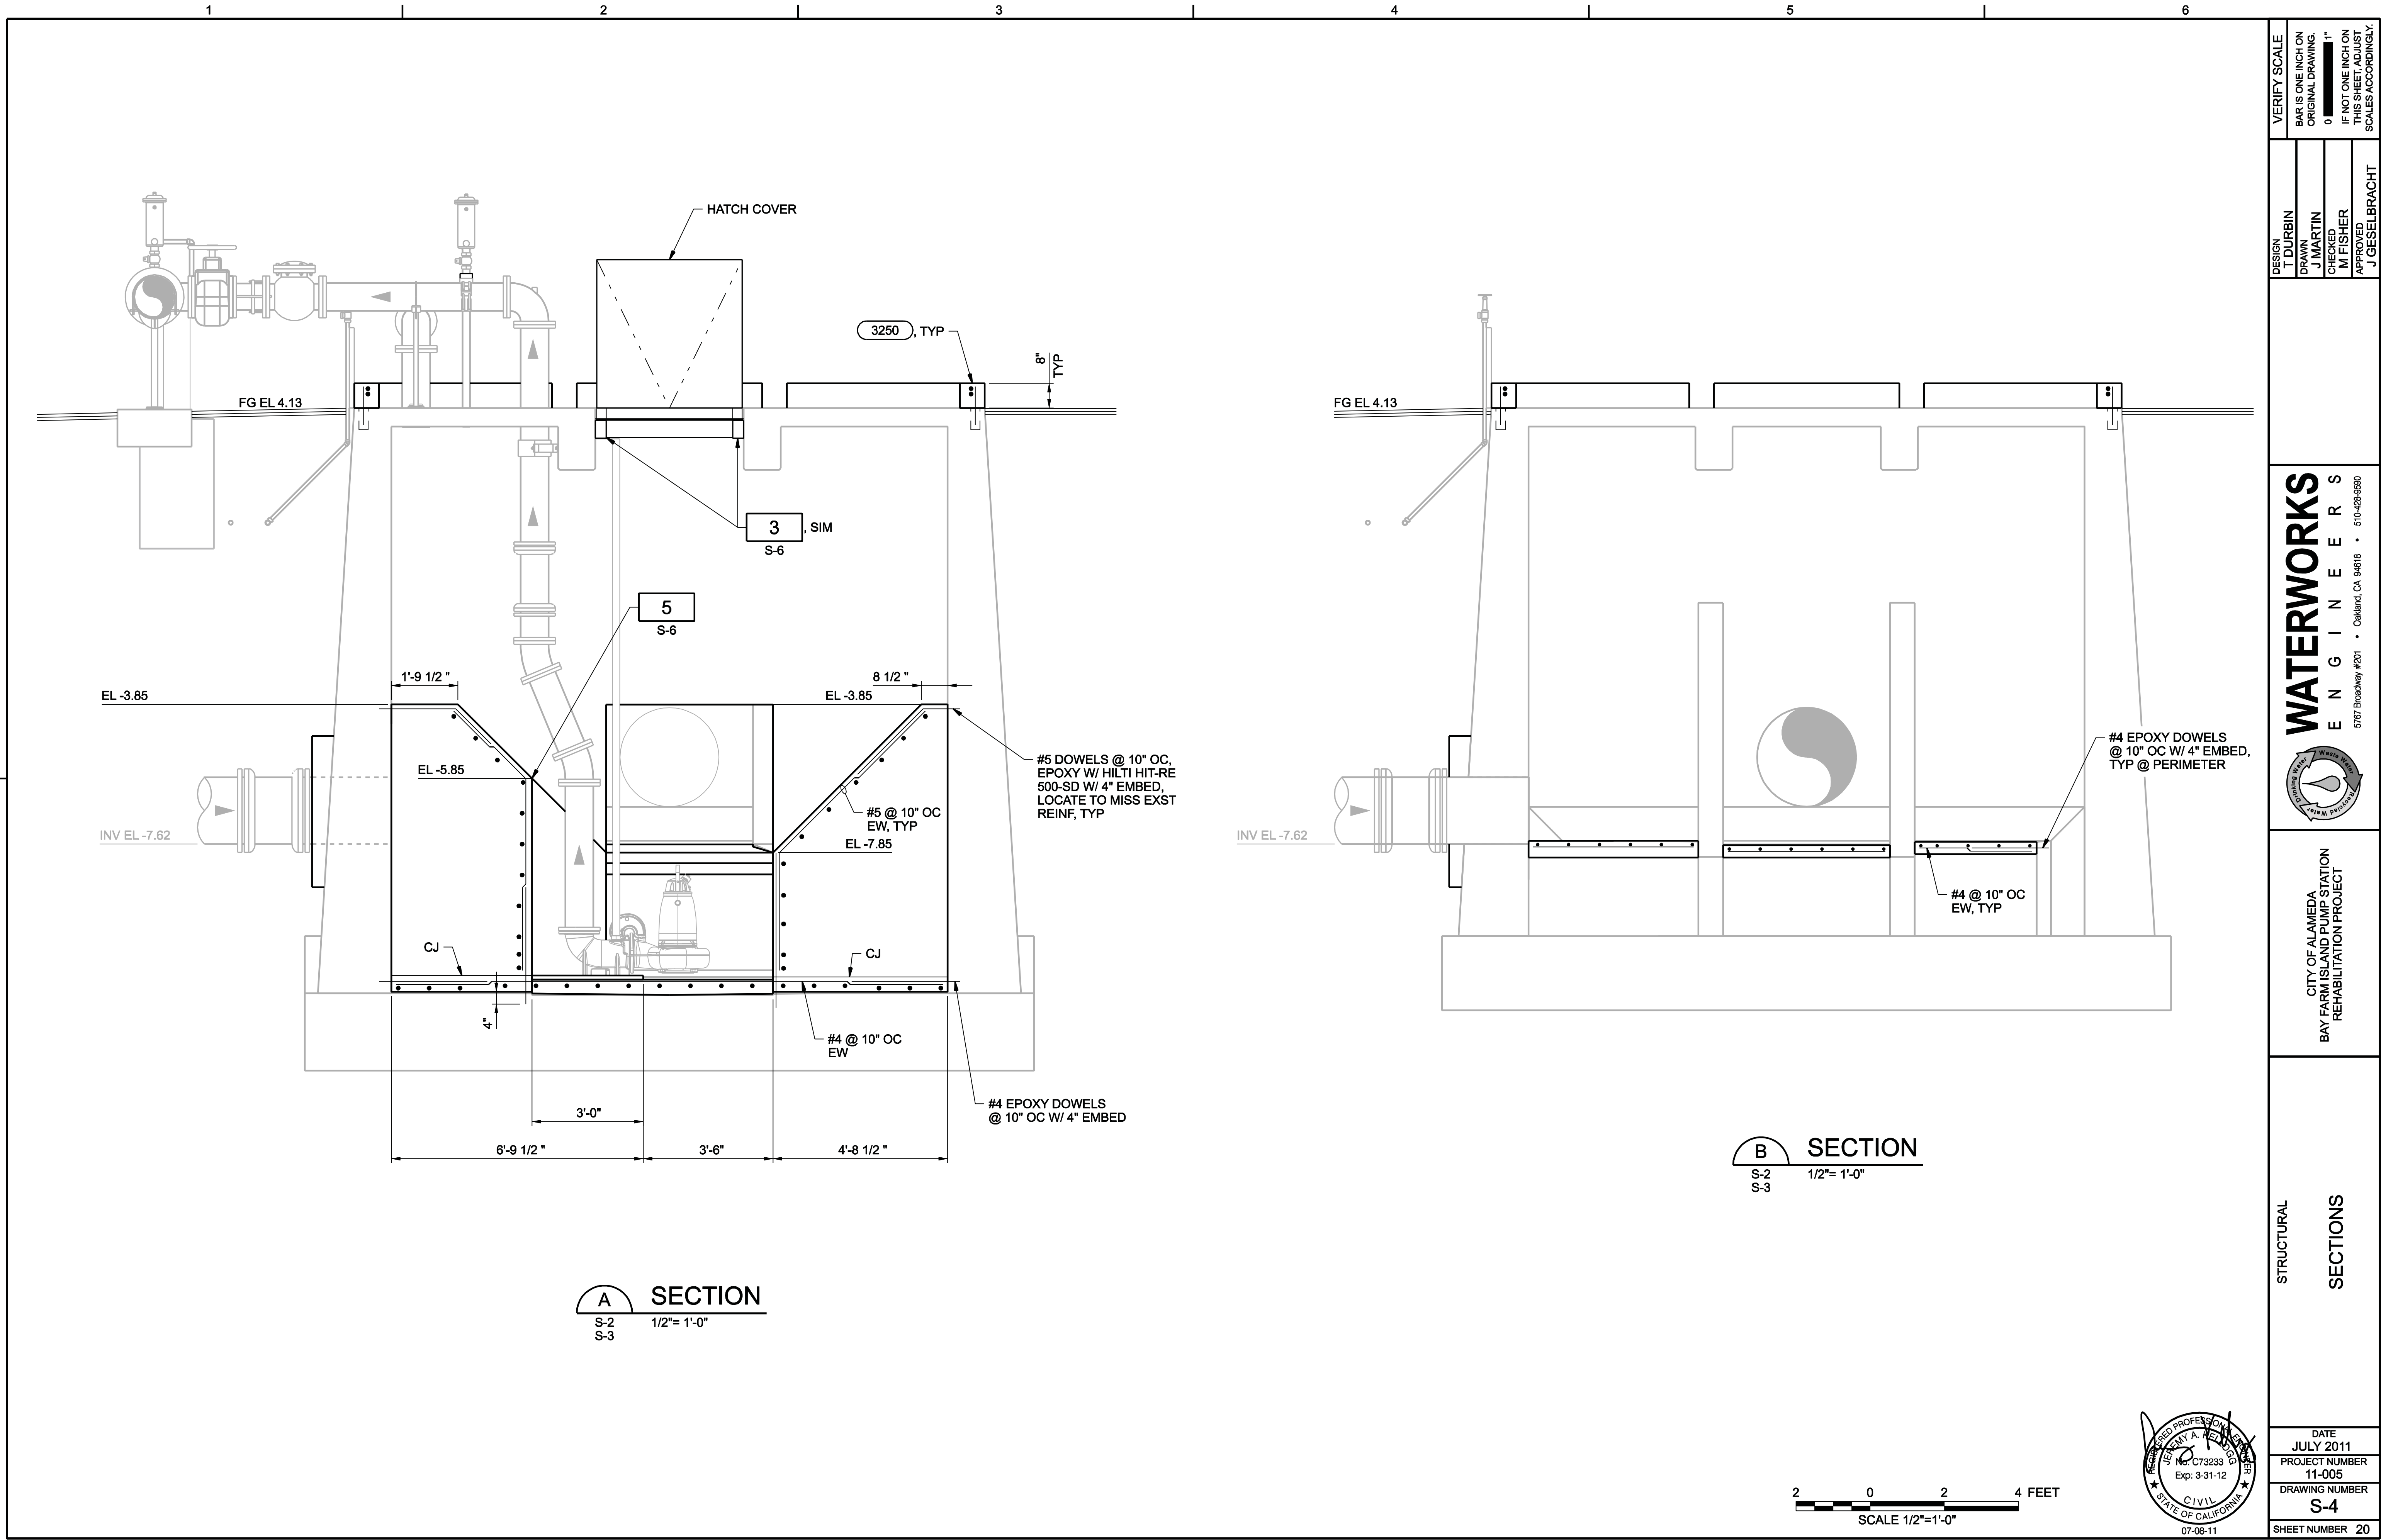


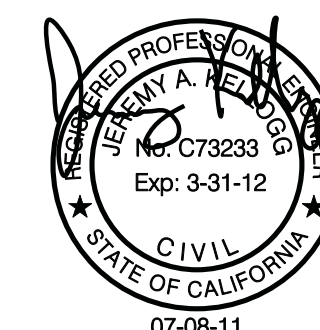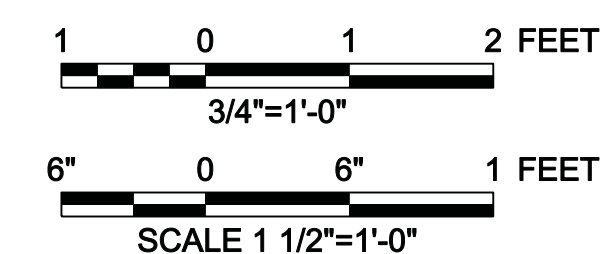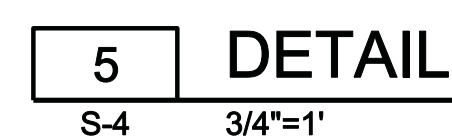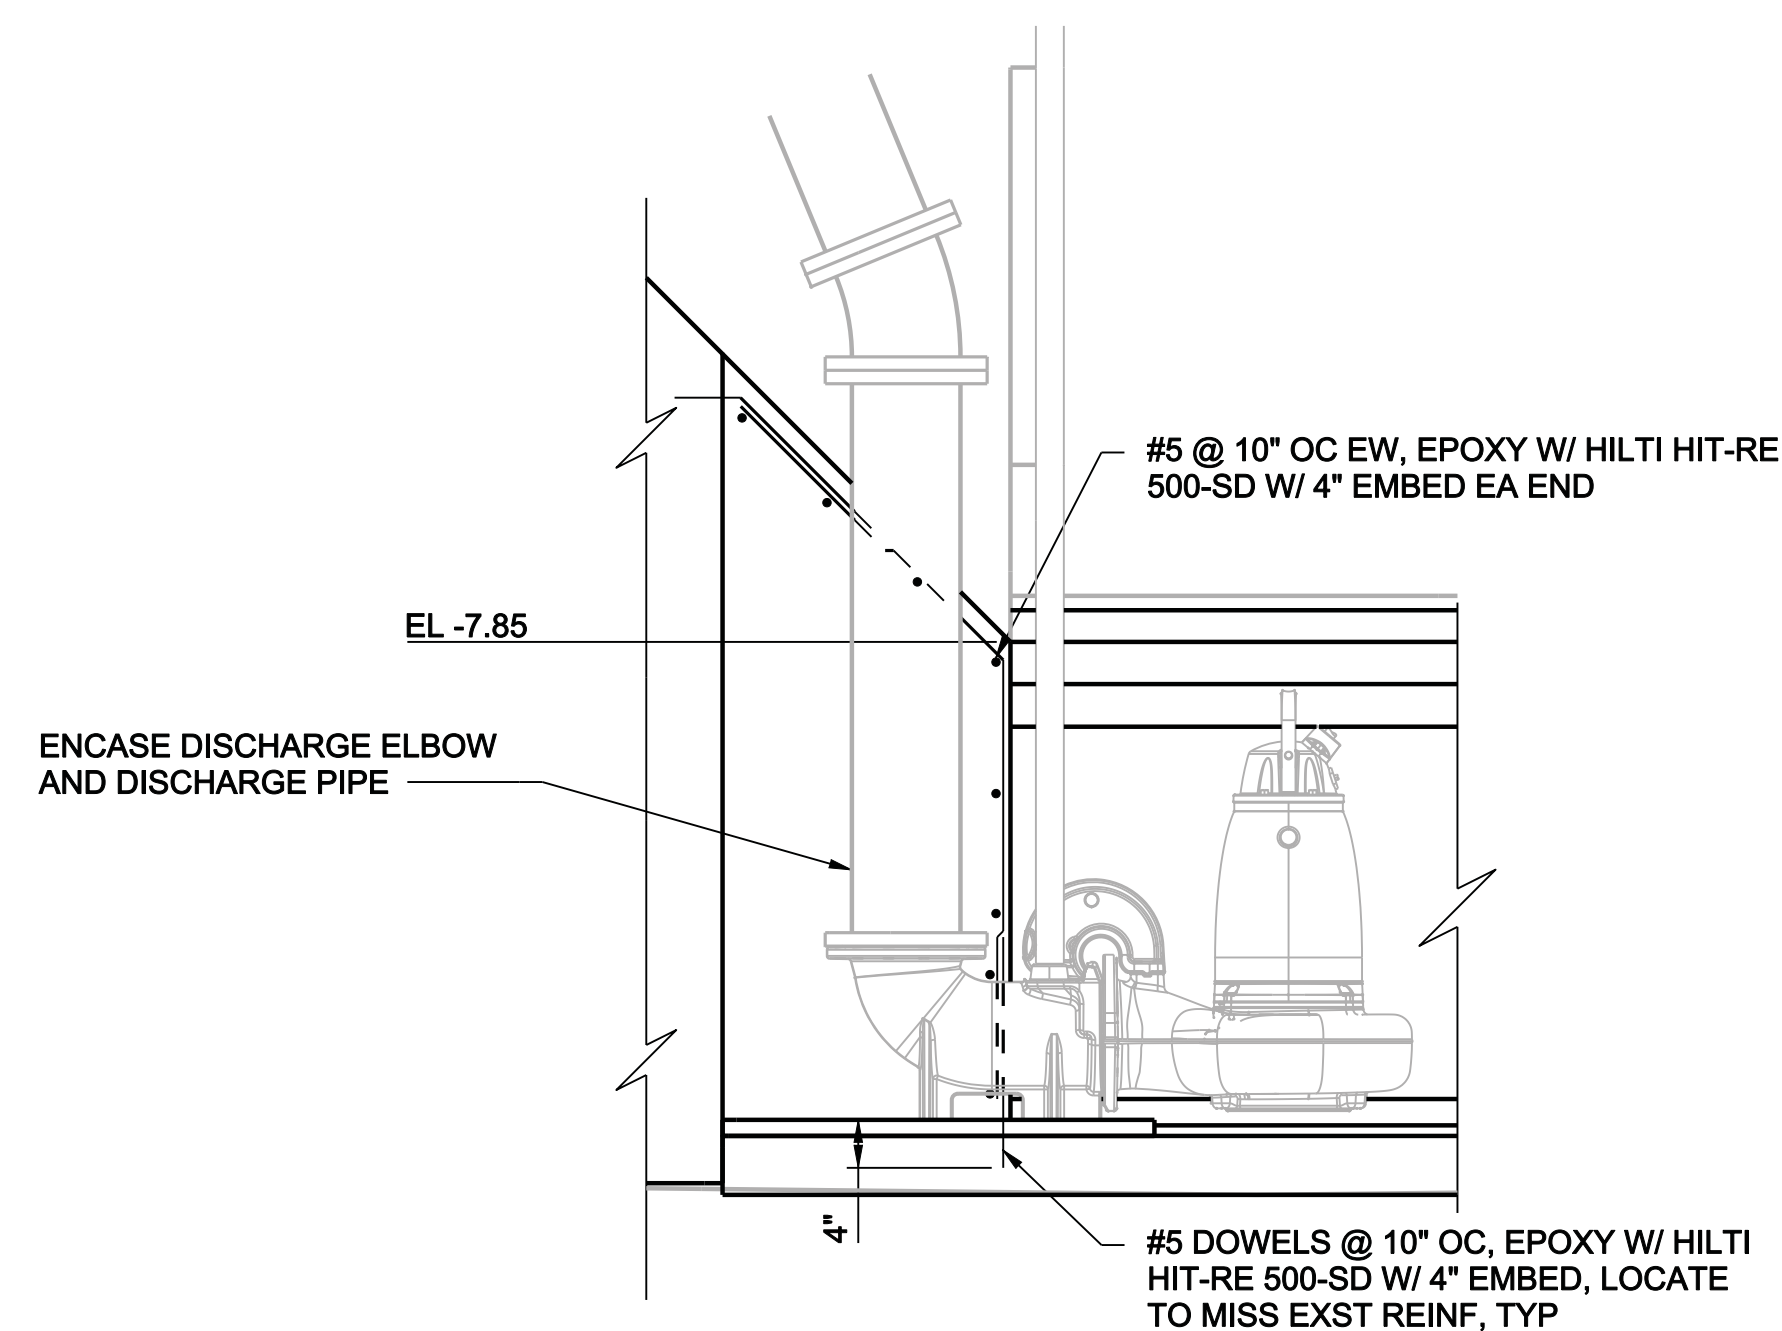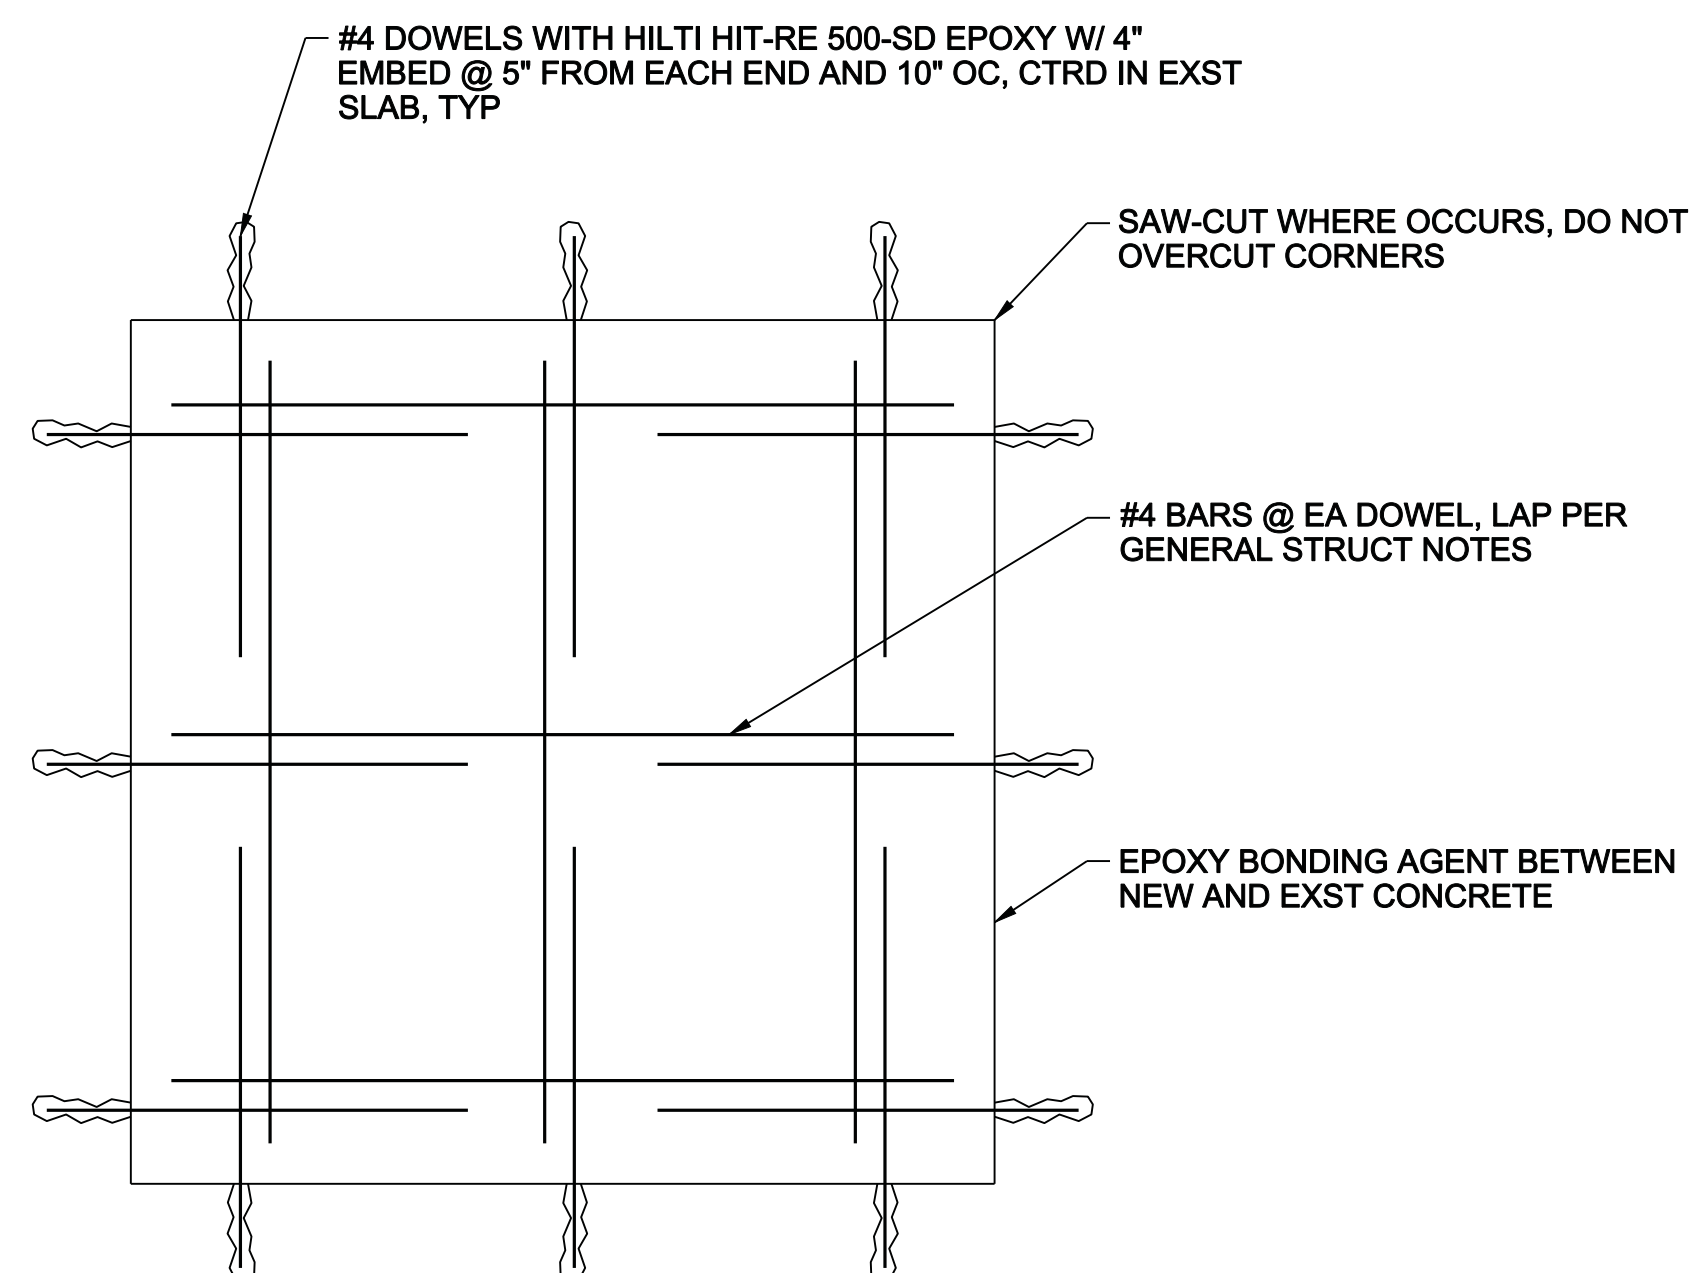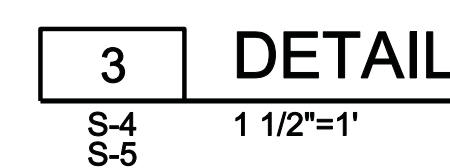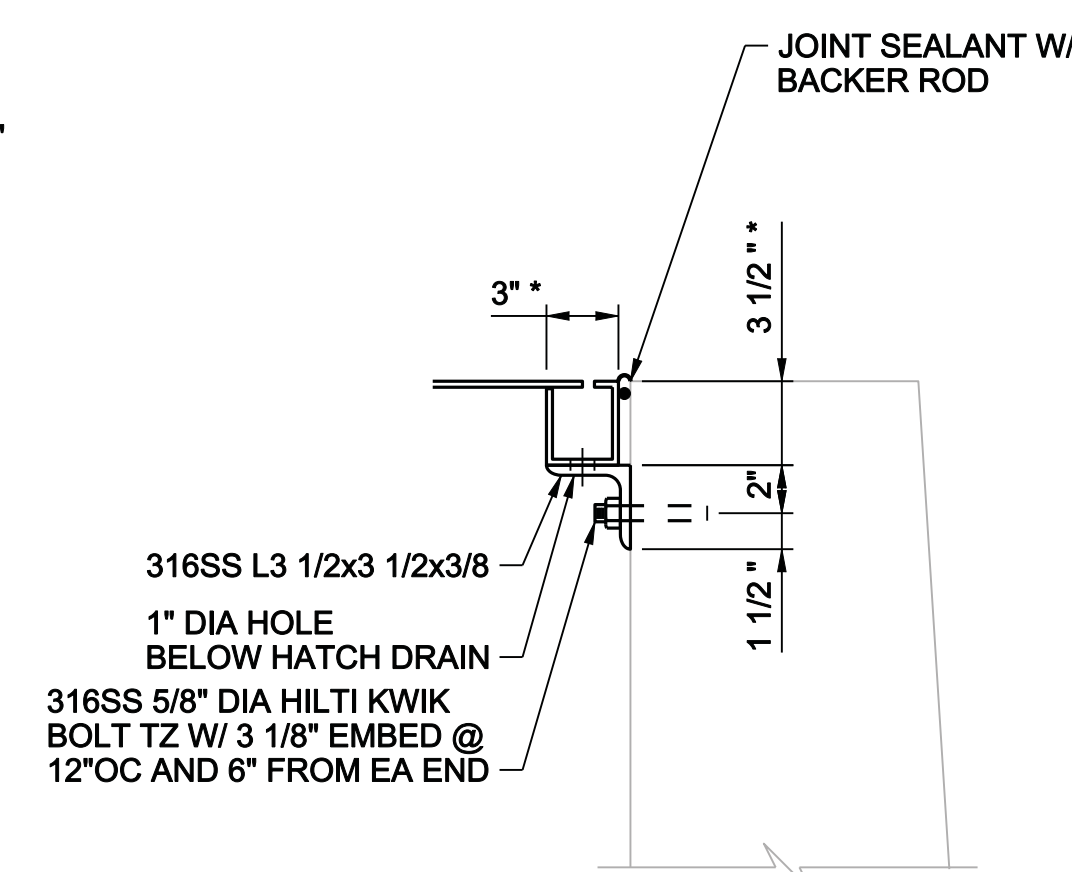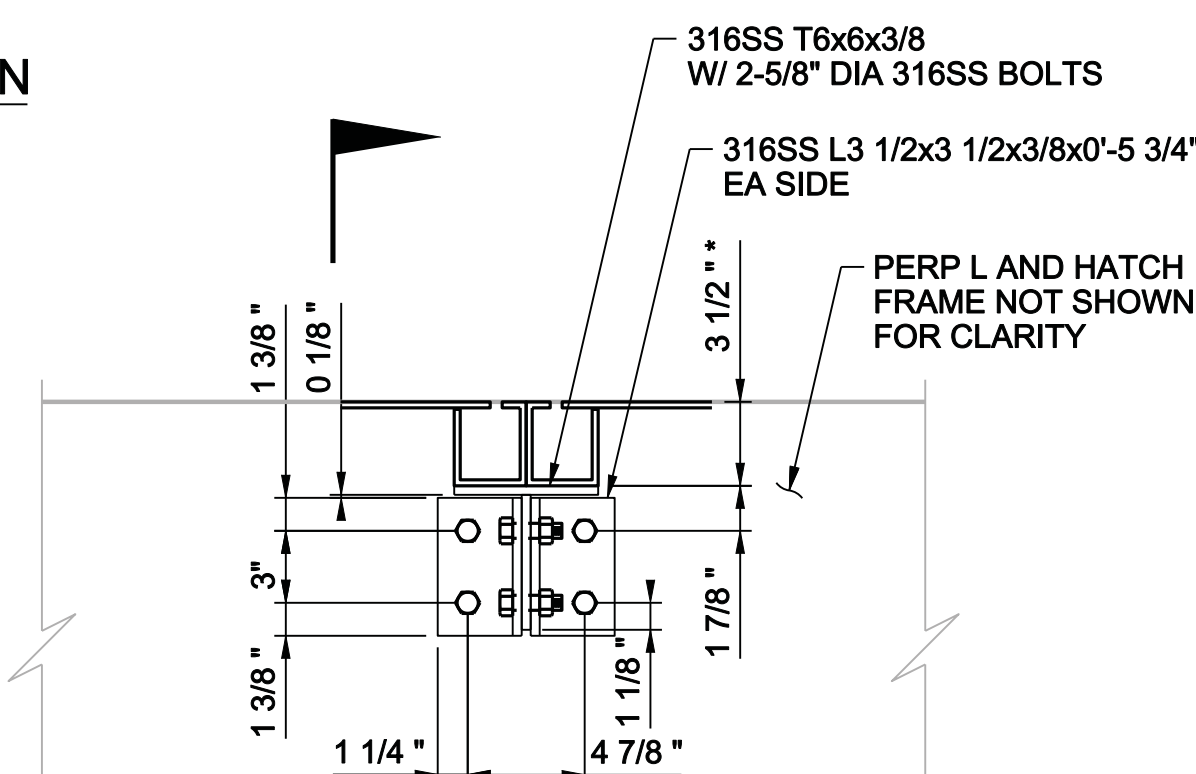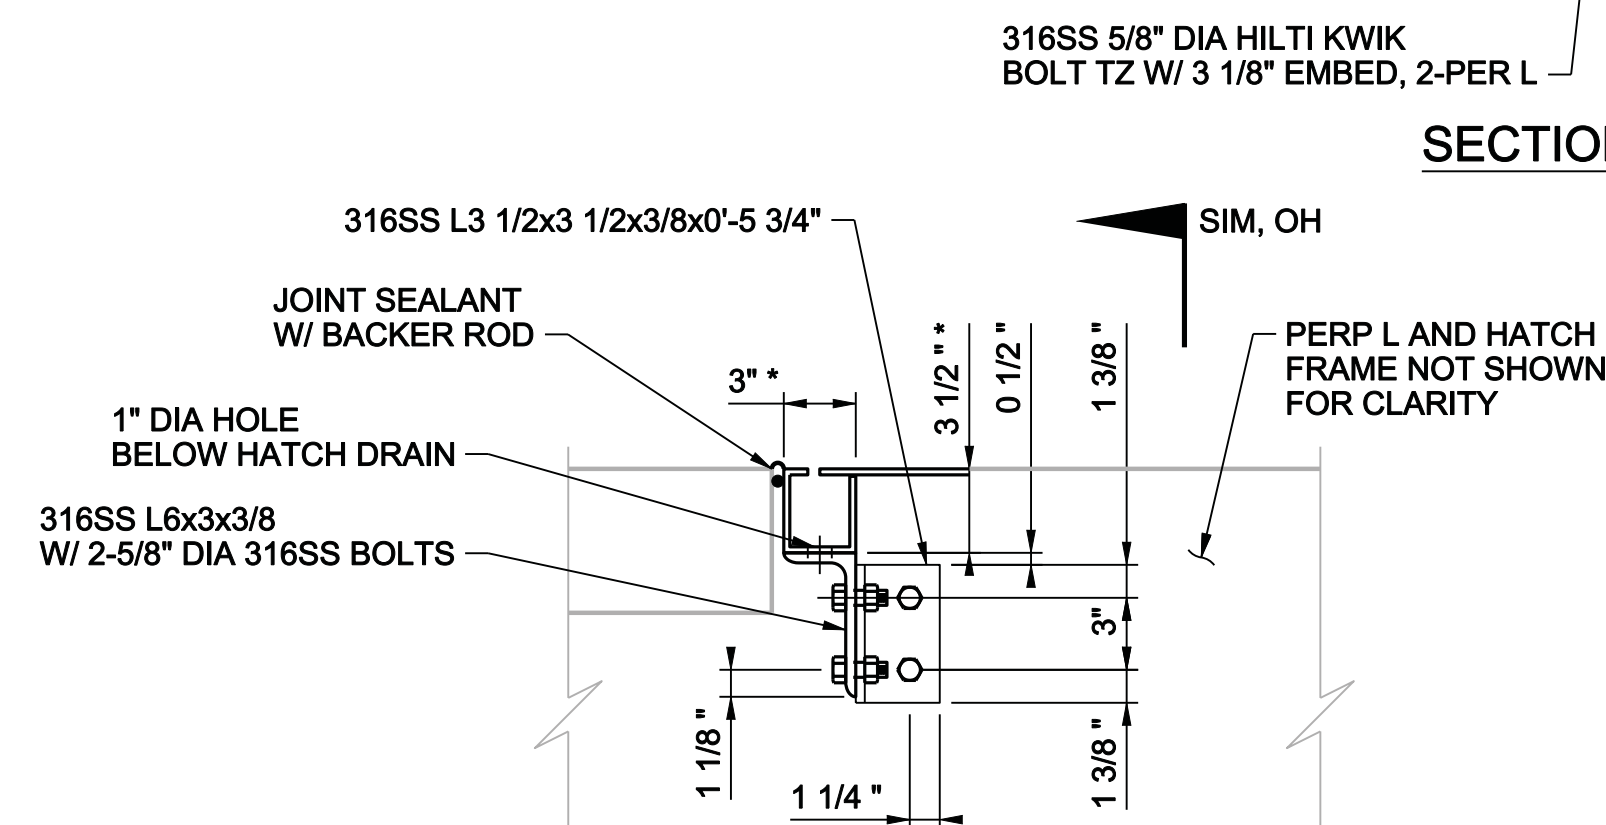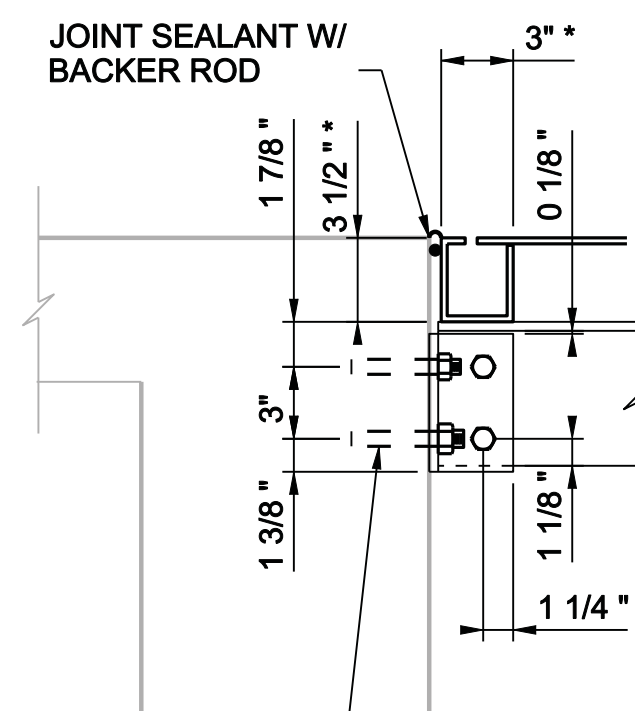


DATE JULY 2011 PROJECT NUMBER 11-005 DRAWING NUMBER S-6 SHEET NUMBER	STRUCTURAL DETAILS	 <p> CITY OF ALAMEDA BAY FARM ISLAND PUMP STATION REHABILITATION PROJECT </p> <p> 5767 Broadway #201 • Oakland, CA 94618 • 510-428-9590 </p>	<p>WATERWORKS</p> <p>E N G I N E E R S</p>	DESIGN	T DURBIN	VERIFY SCALE BAR IS ONE INCH ON ORIGINAL DRAWING. 0" = 1" IF NOT ONE INCH ON THIS SHEET, ADJUST SCALES ACCORDINGLY.
				DRAWN	J MARTIN	
				CHECKED	J MARTIN	
				APPROVED	J GESELT BRACHT	
				APPROVED	J GESELT BRACHT	

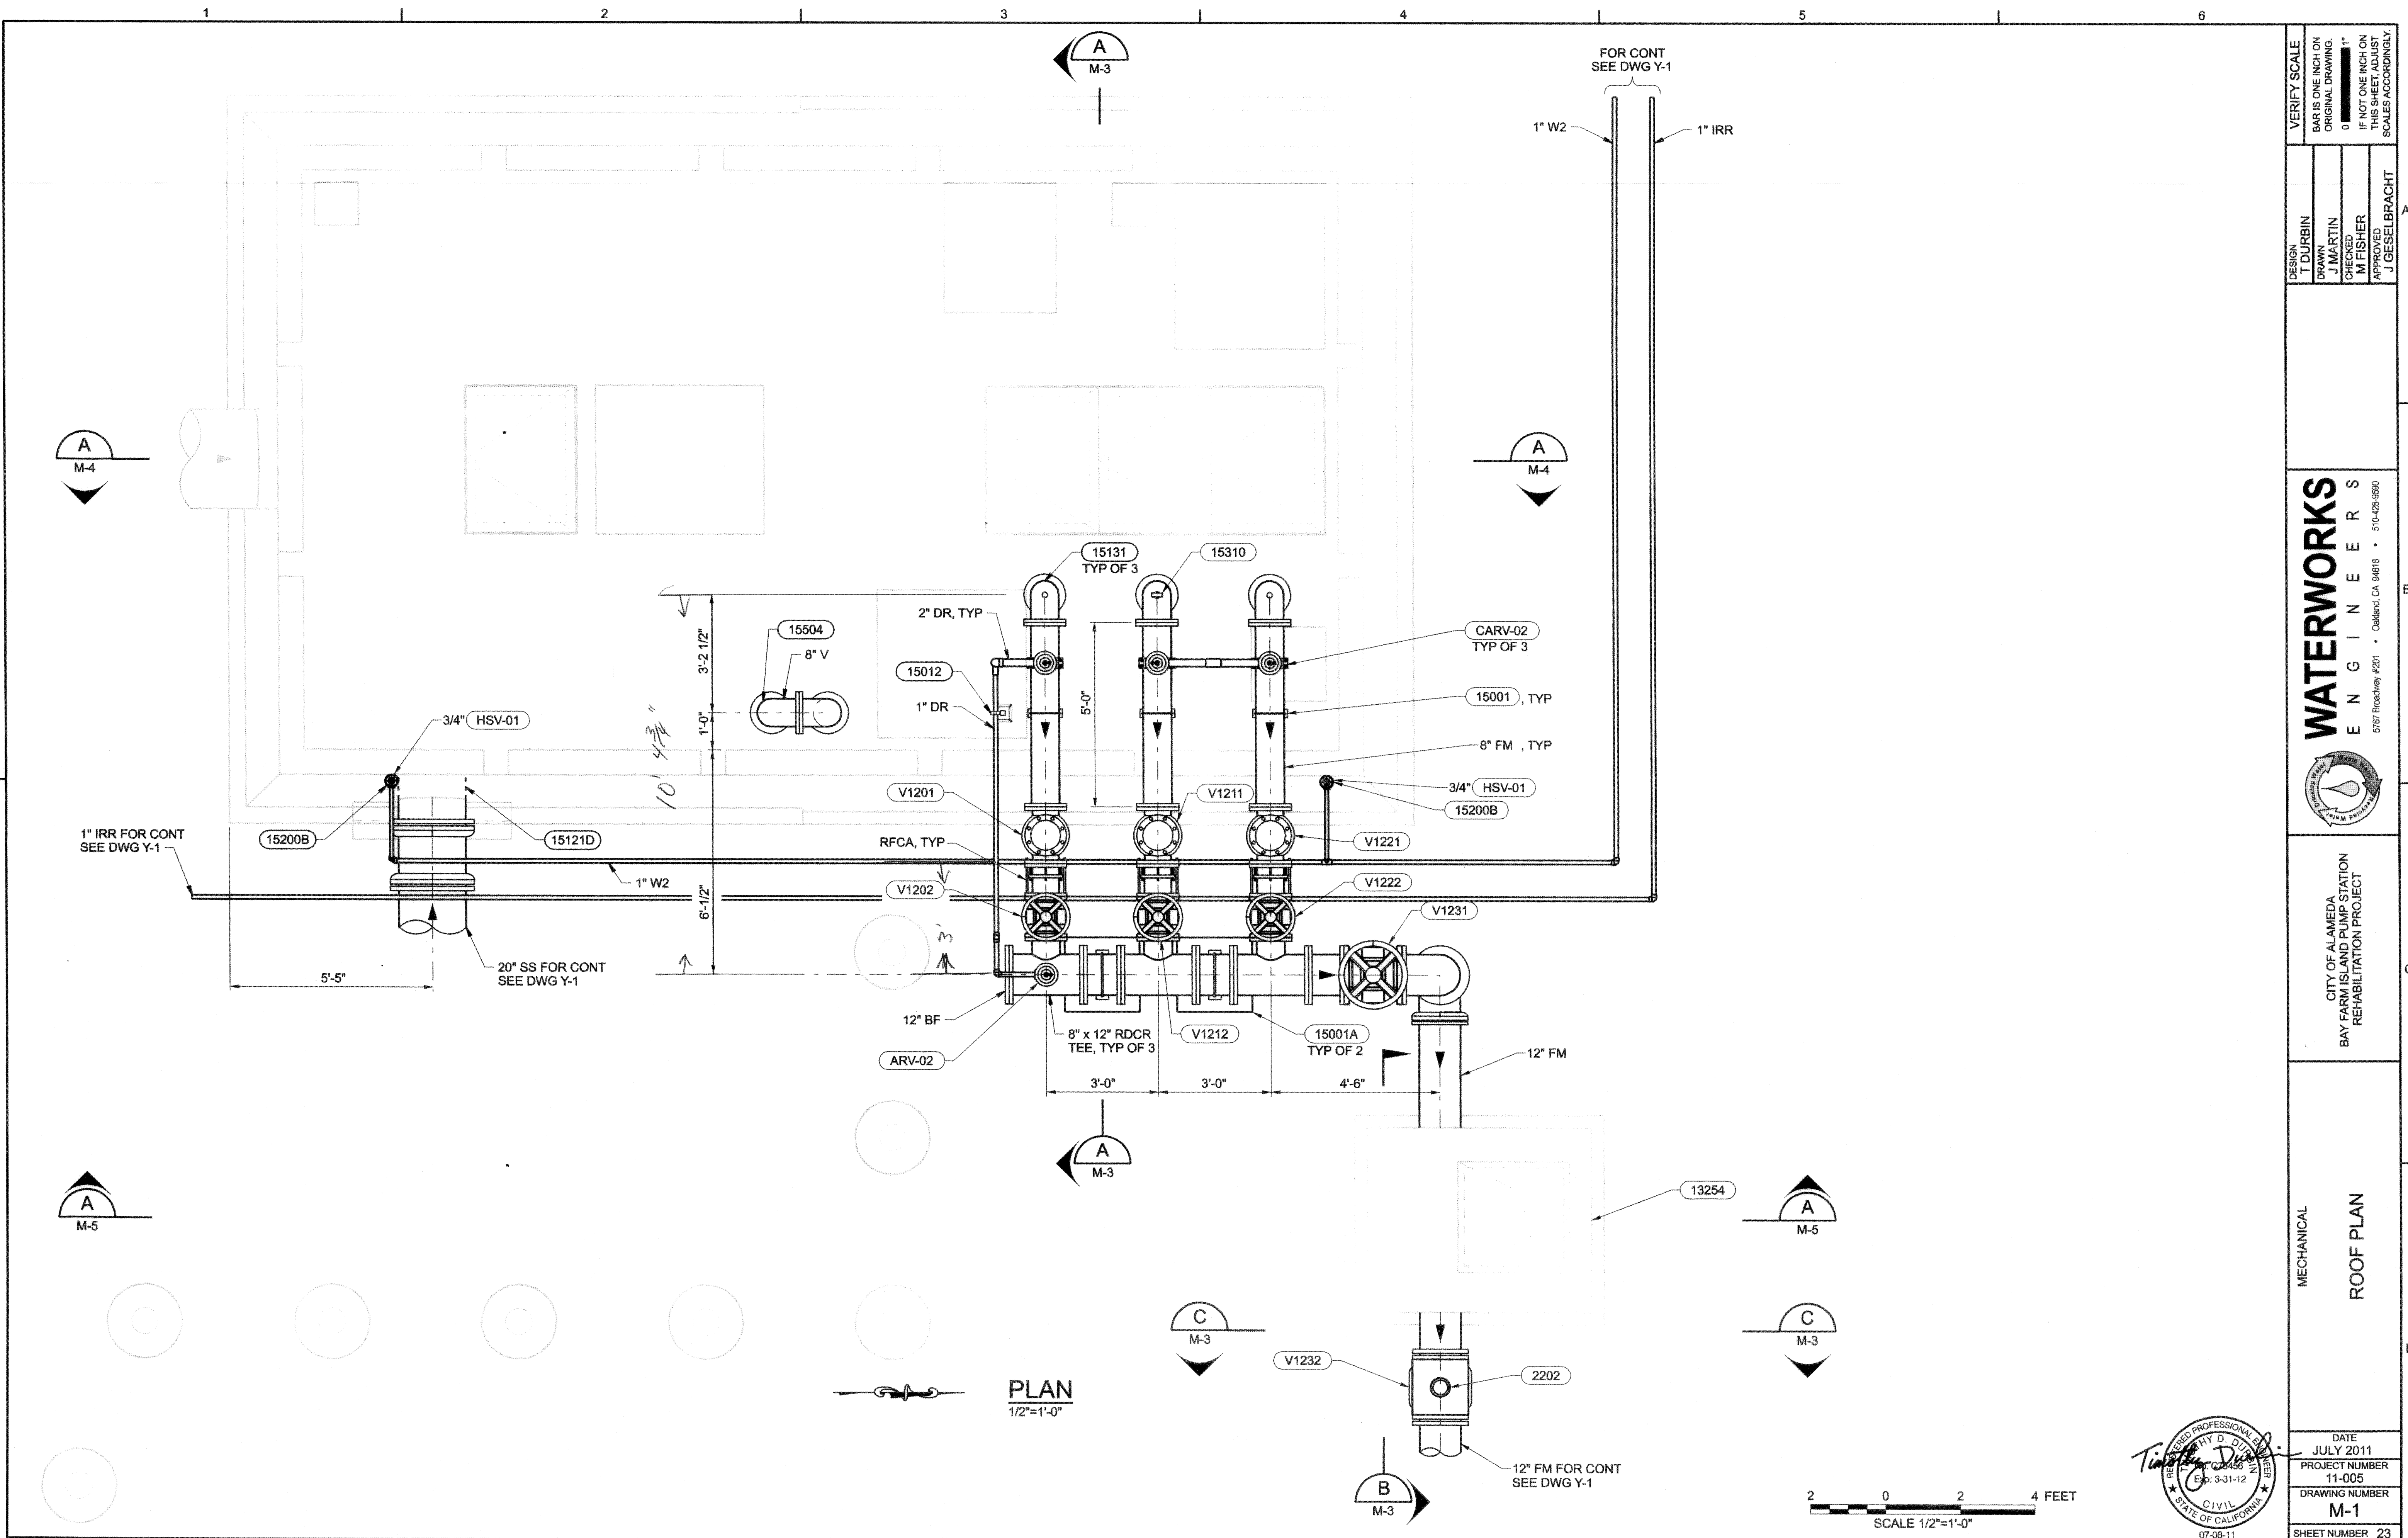


VERIFY SCALE BAR IS ONE INCH ON ORIGINAL DRAWING. 0 1' IF NOT ONE INCH ON THIS SHEET, ADJUST SCALES ACCORDINGLY.	
DESIGN T. DURBIN	DRAWN J. MARTIN
CHECKED M. FISHER	APPROVED J. GESELBRACHT
WATERWORKS ENGINEERS 5757 Broadway #201 • Oakland, CA 94618 • 510-428-9590	
CITY OF ALAMEDA BAY FARM ISLAND PUMP STATION REHABILITATION PROJECT	
MECHANICAL ROOF PLAN	DATE JULY 2011 PROJECT NUMBER 11-005 DRAWING NUMBER M-1 SHEET NUMBER 23

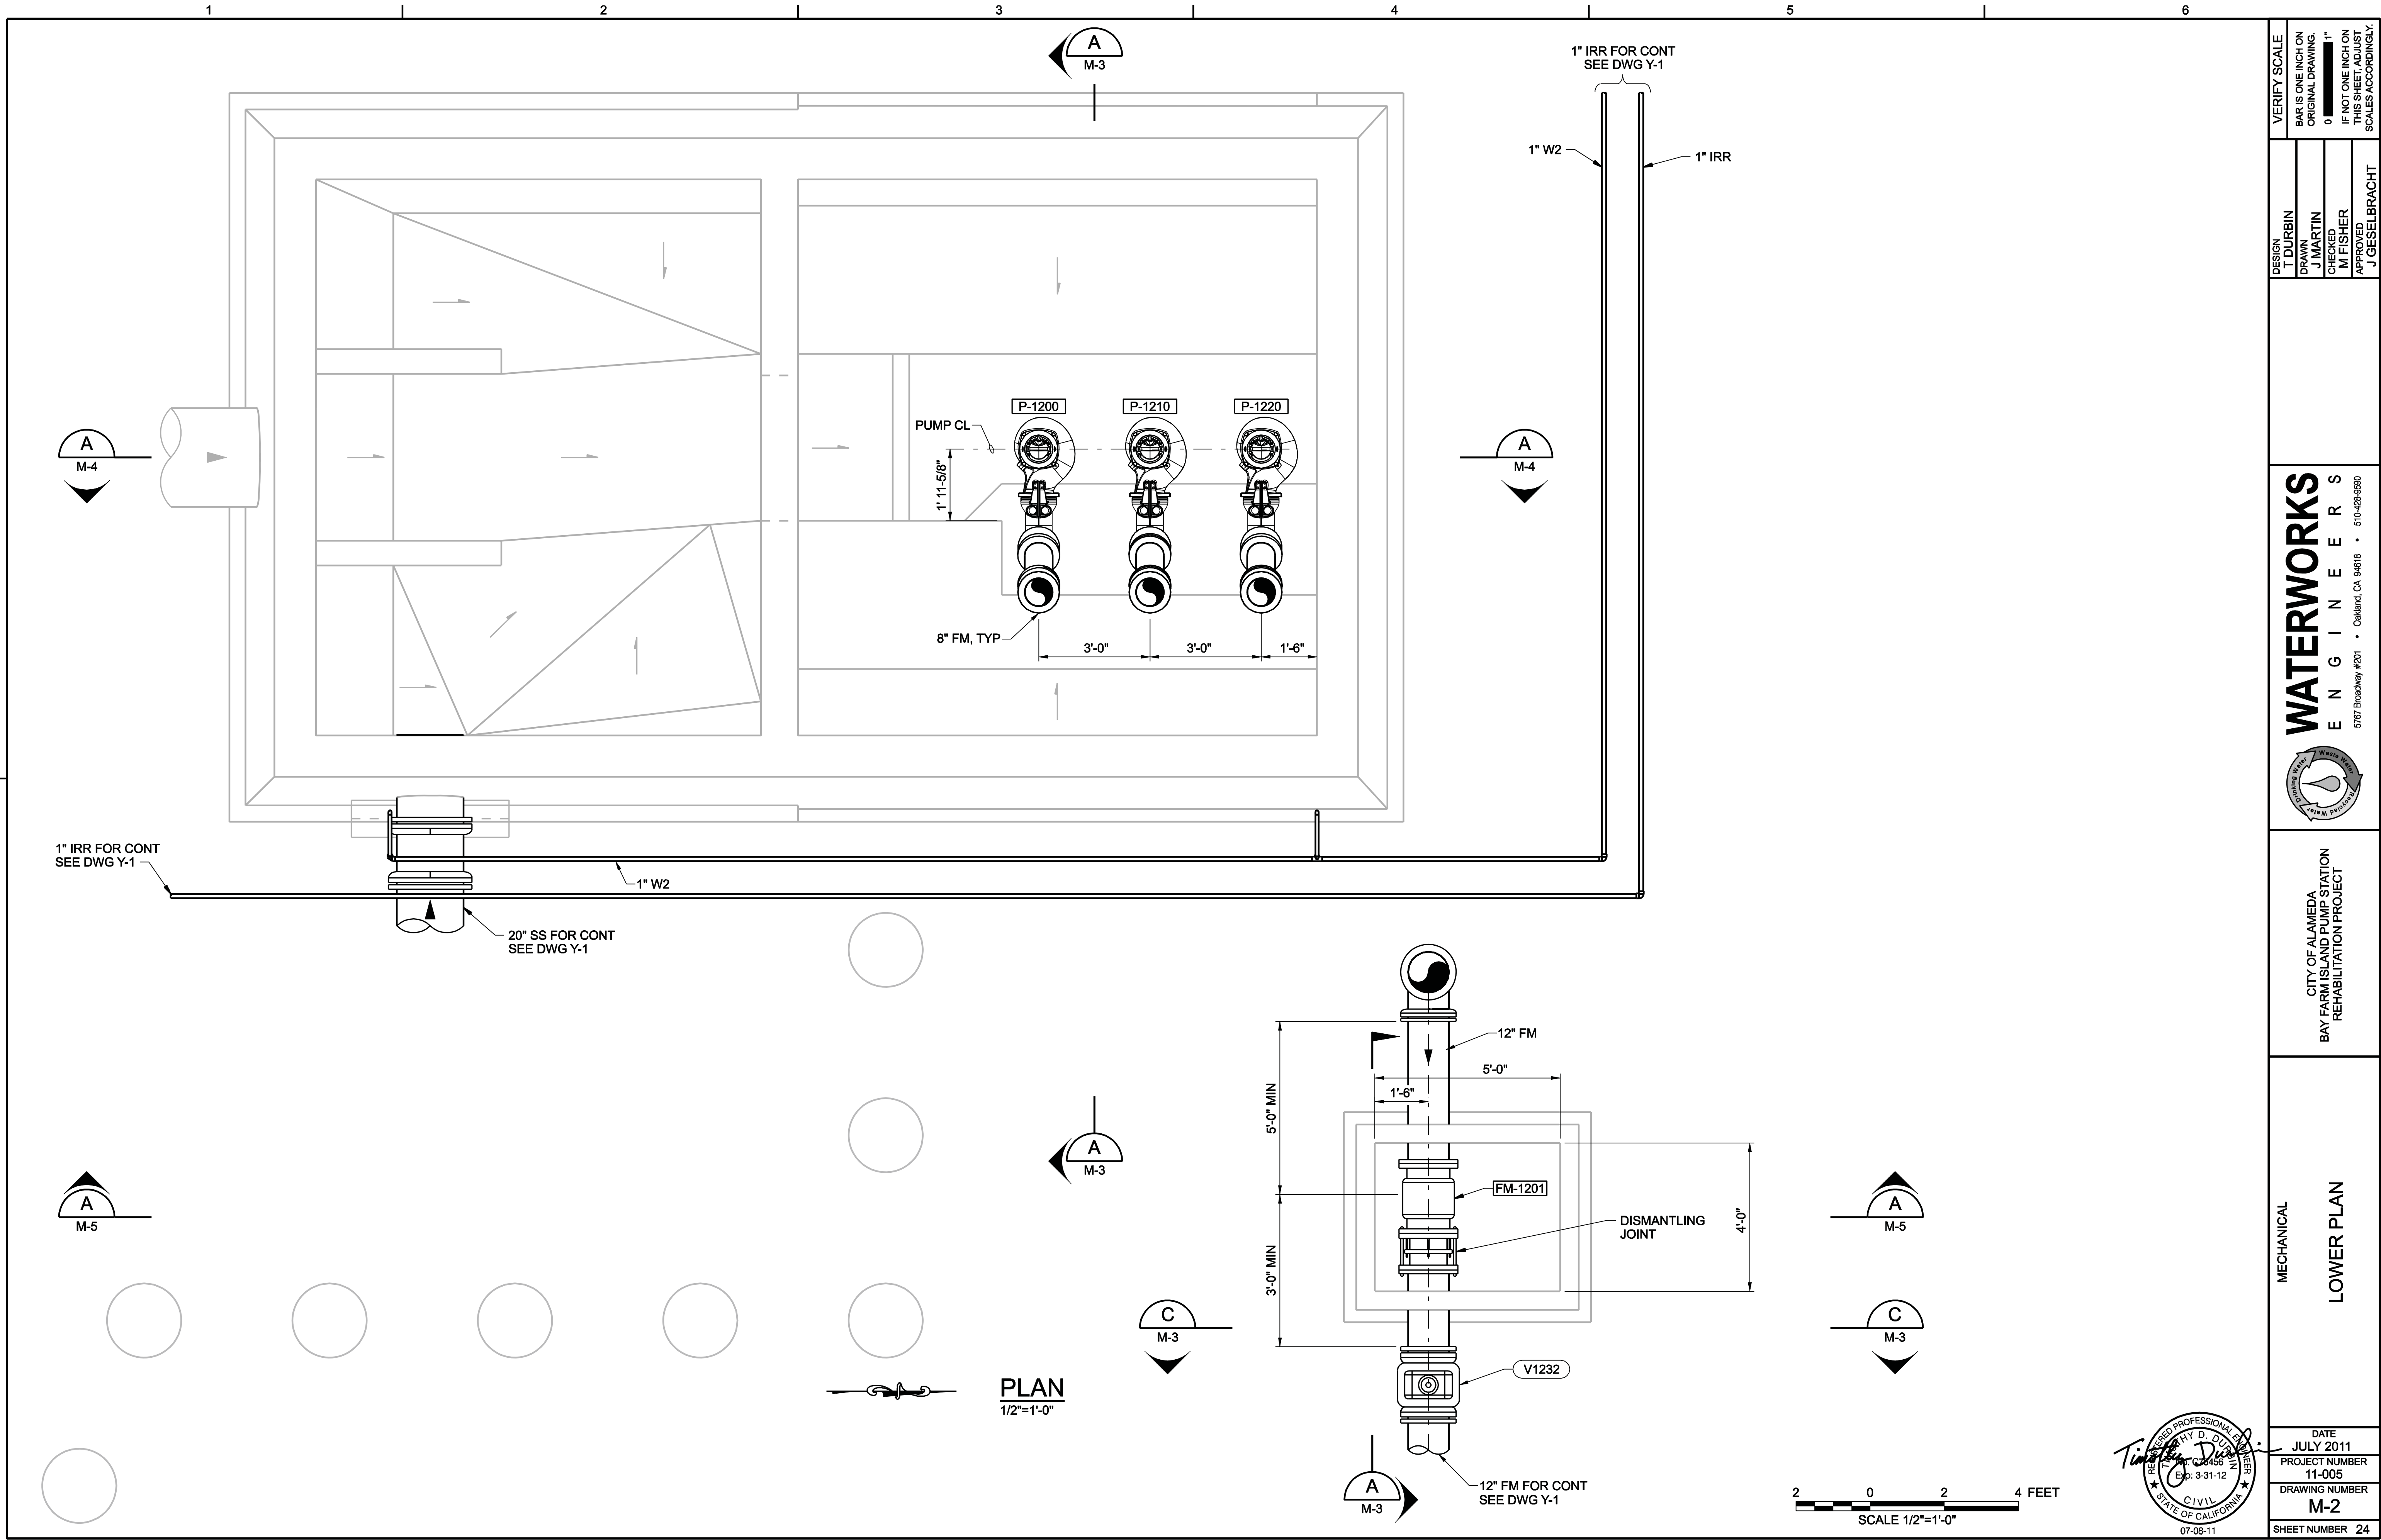


DESIGN T. DURBIN DRAWN J. MARTIN CHECKED M. FISHER APPROVED J. GESELBRACHT	VERIFY SCALE BAR IS ONE INCH ON ORIGINAL DRAWING. 0 1' IF NOT ONE INCH ON THIS SHEET, ADJUST SCALES ACCORDINGLY.	
	WATERWORKS ENGINEERS 5767 Broadway #201 • Oakland, CA 94618 • 510-428-5590	
	CITY OF ALAMEDA BAY FARM ISLAND PUMP STATION REHABILITATION PROJECT	
	MECHANICAL LOWER PLAN	
DATE JULY 2011		PROJECT NUMBER 11-005
DRAWING NUMBER M-2		SHEET NUMBER 24

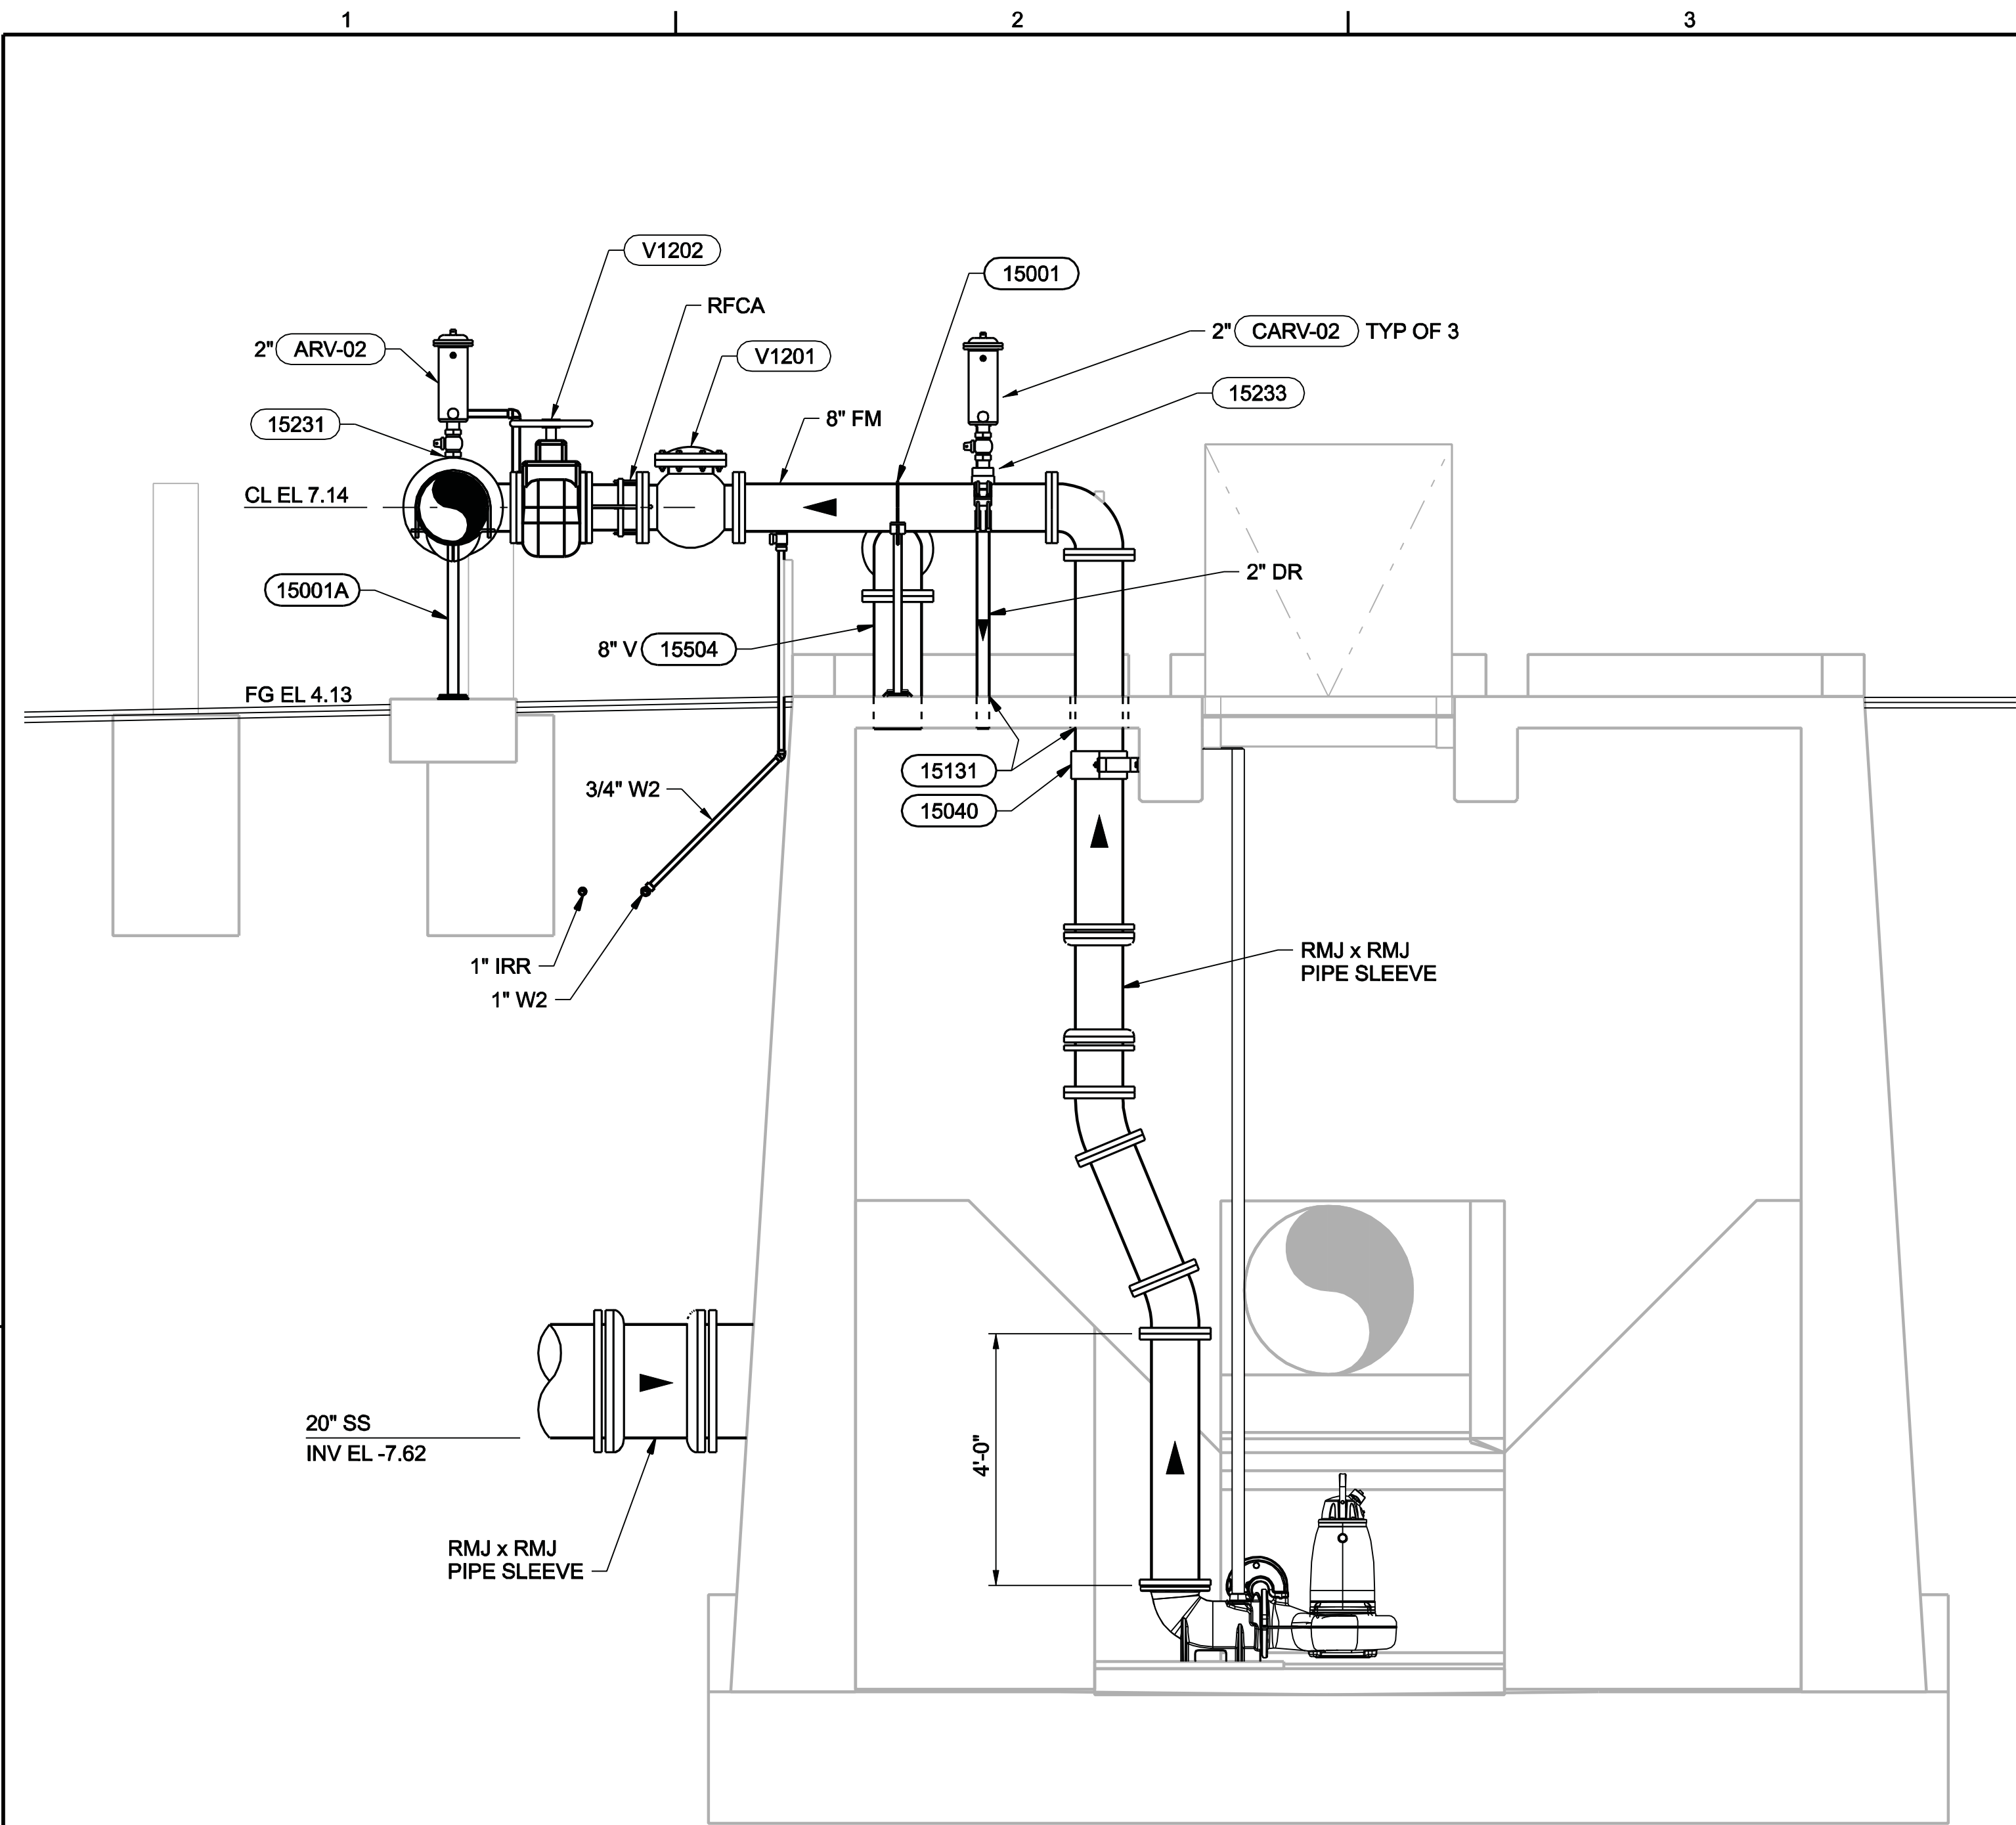



A SECTION
M-1
M-2
1/2"=1'-0"

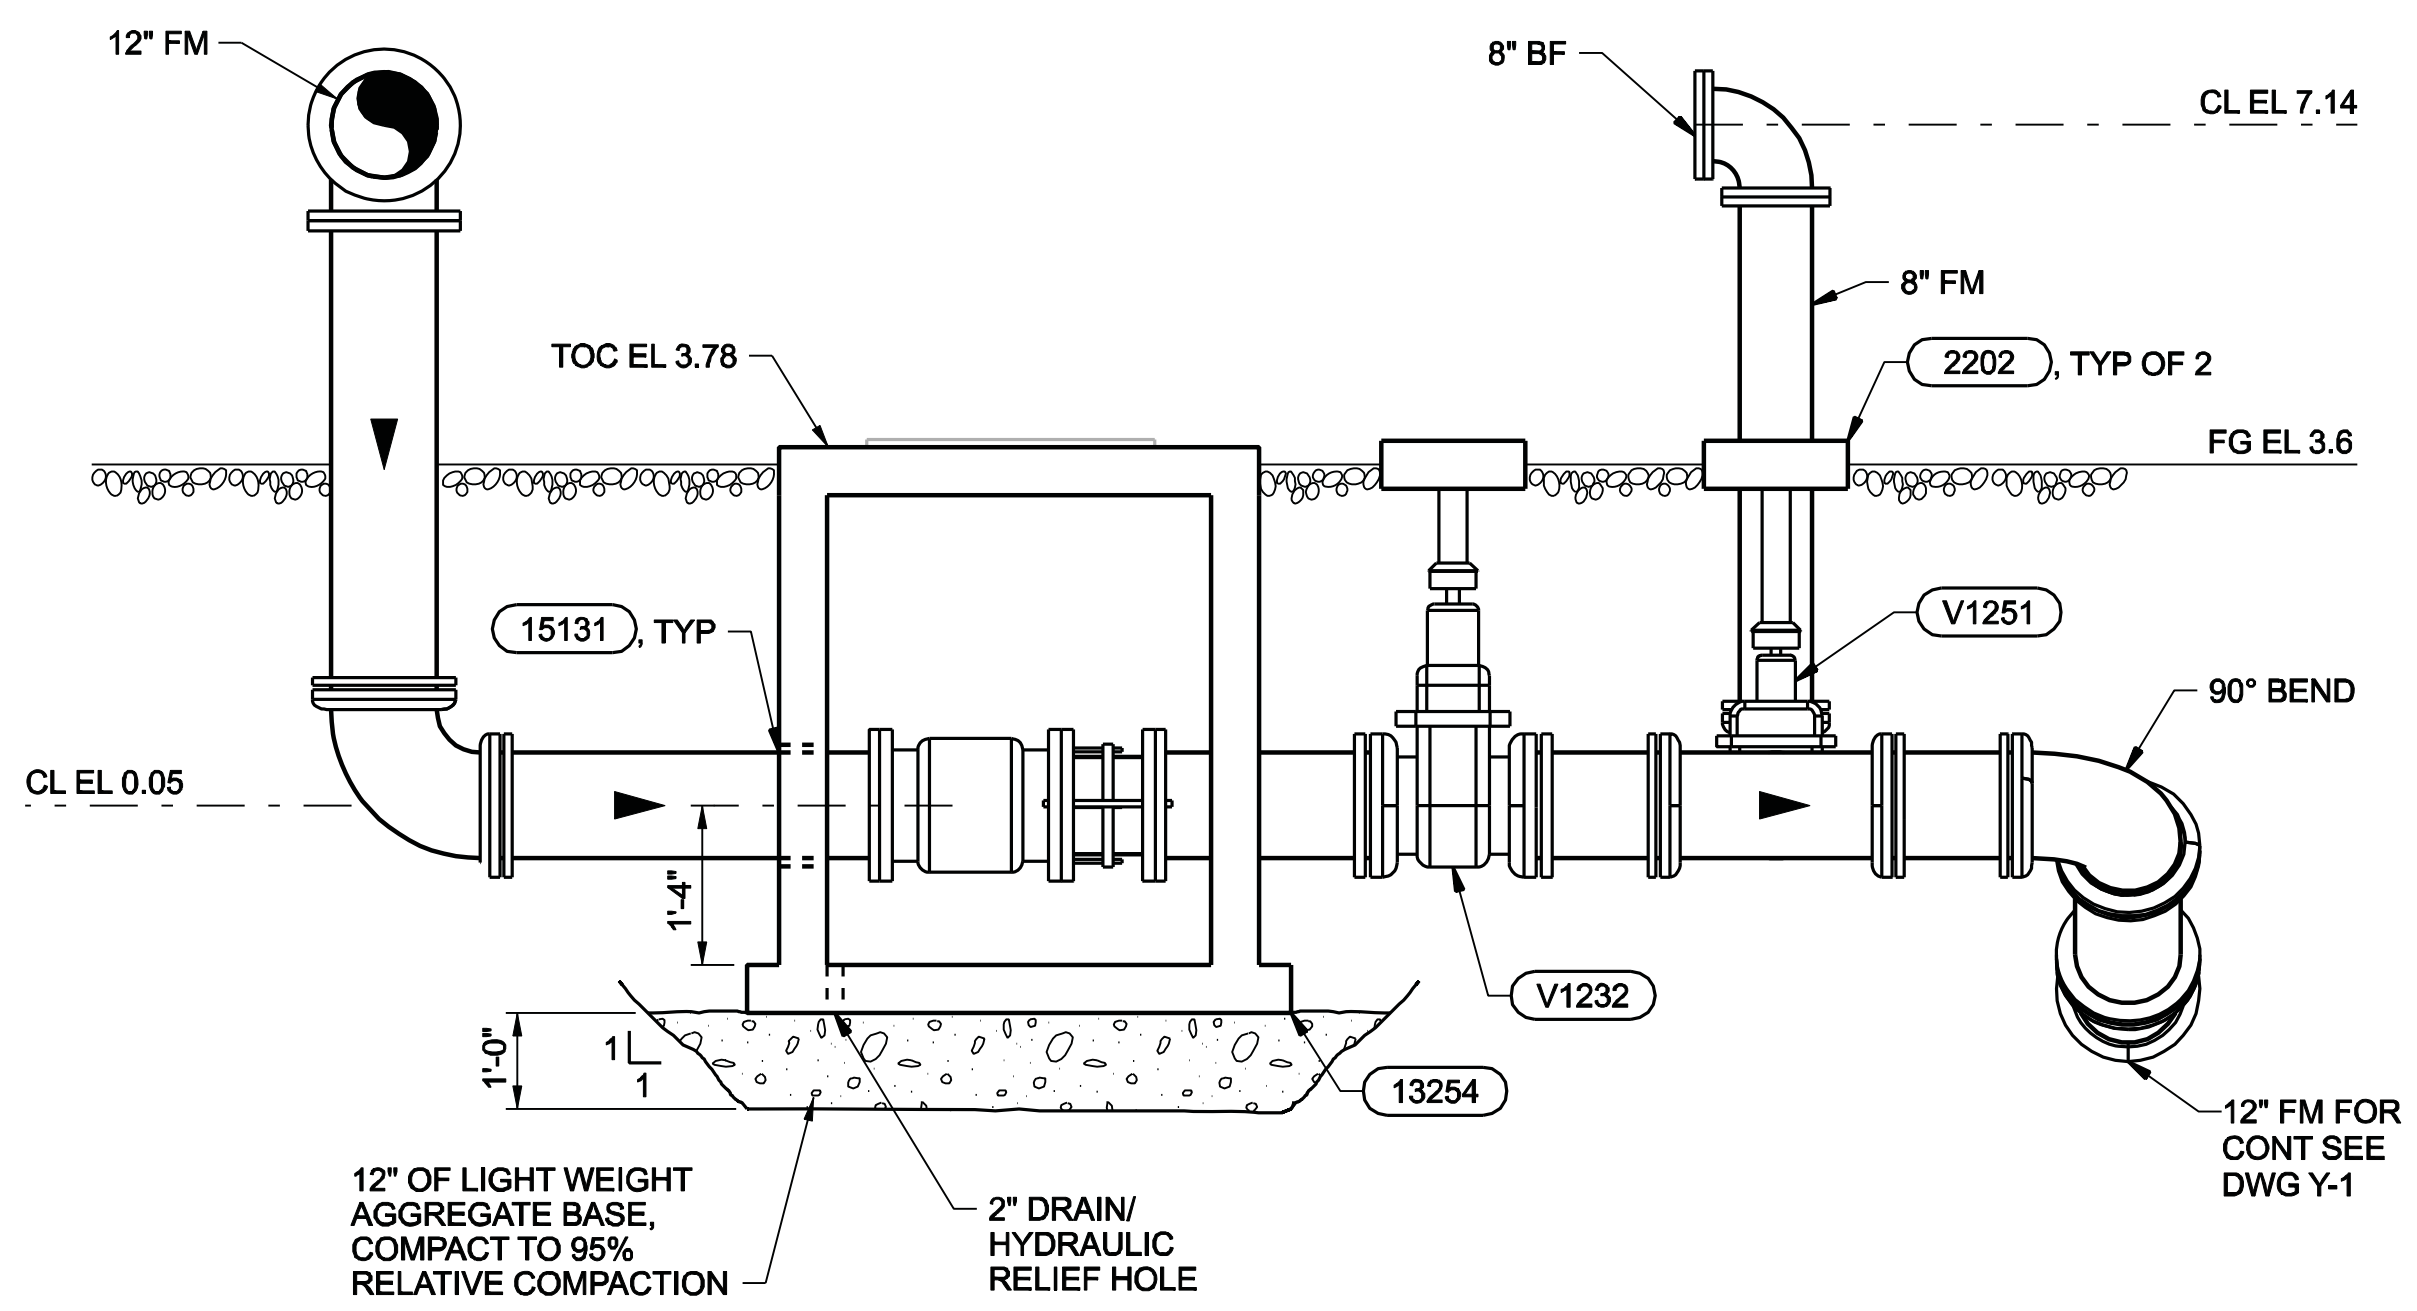


B SECTION
M-1
M-2
1/2"=1'-0"

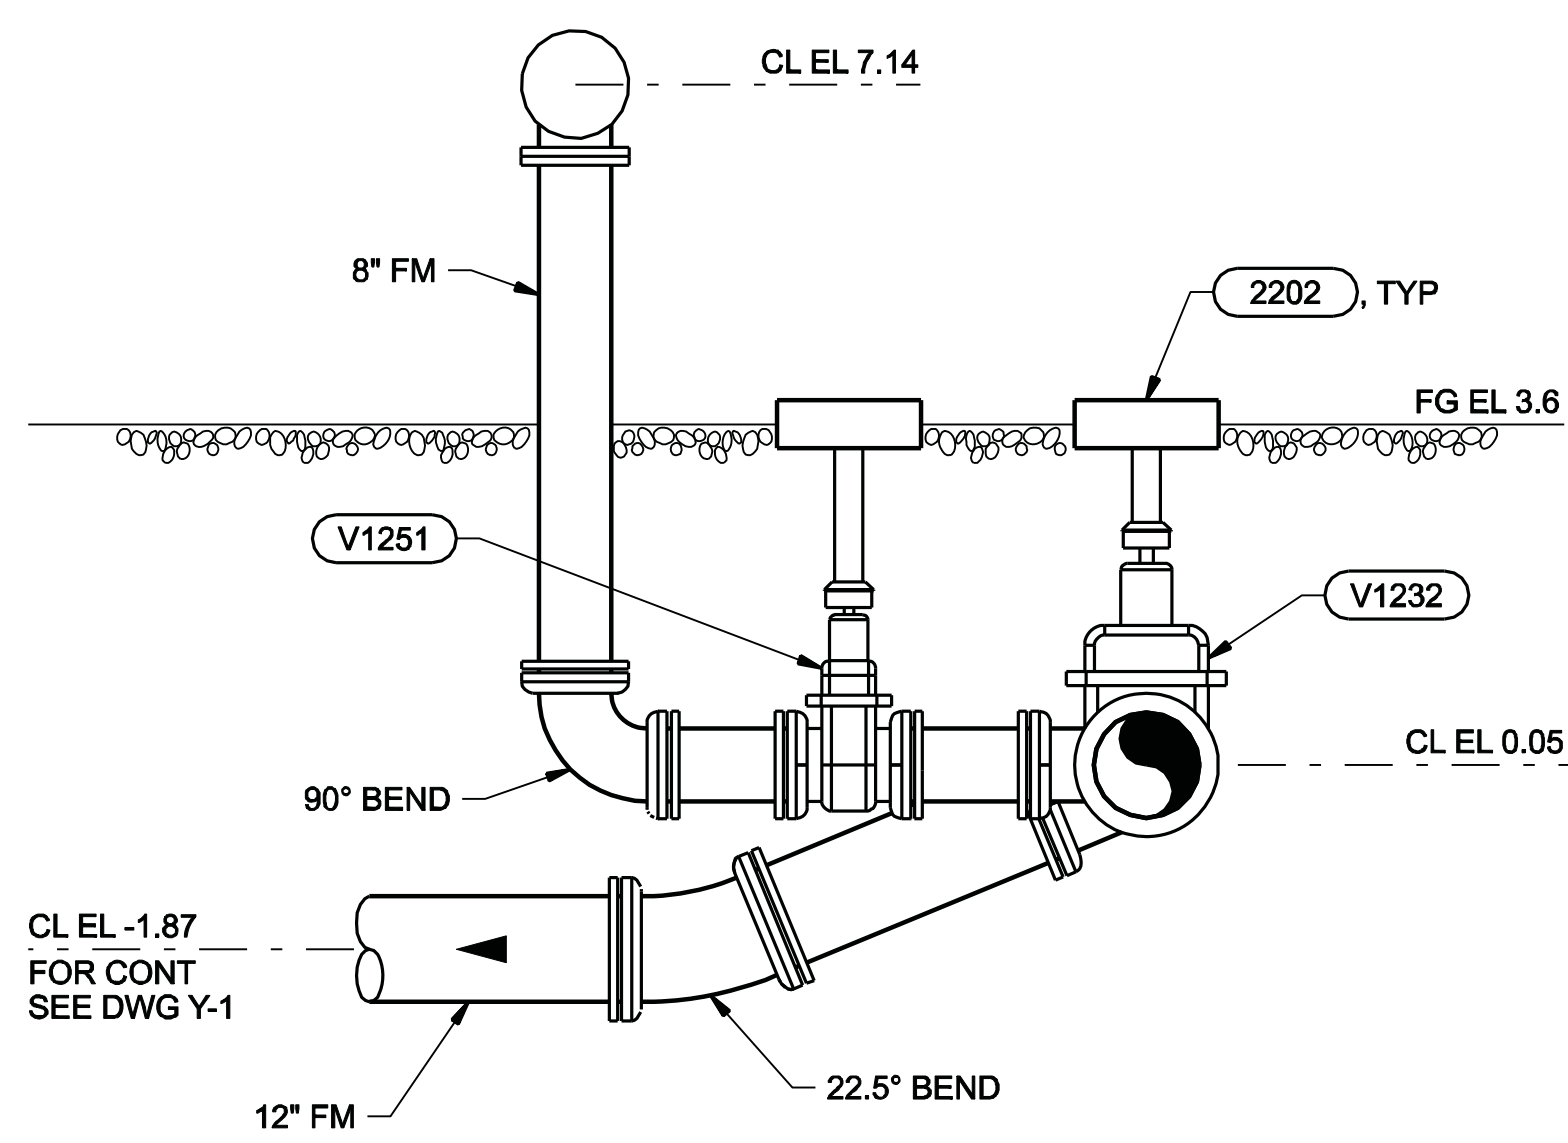


C SECTION
M-1
M-2
1/2"=1'-0"

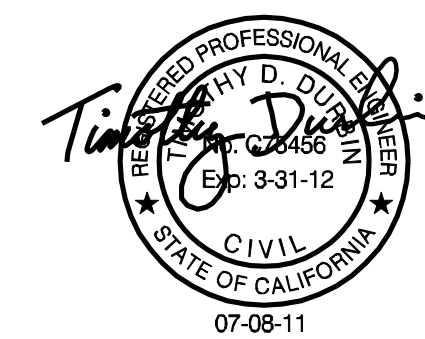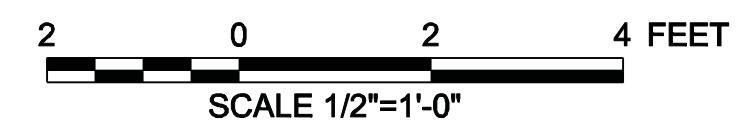

VERIFY SCALE BAR IS ONE INCH ON ORIGINAL DRAWING. 0 1' IF NOT ONE INCH ON THIS SHEET, ADJUST SCALES ACCORDINGLY.		DESIGN T. DURBIN DRAWN J. MARTIN CHECKED M. FISHER APPROVED J. GESELBRACHT	
WATERWORKS ENGINEERS 5767 Broadway #201 • Oakland, CA 94618 • 510-423-9590		CITY OF ALAMEDA BAY FARM ISLAND PUMP STATION REHABILITATION PROJECT	
MECHANICAL SECTIONS		DATE JULY 2011 PROJECT NUMBER 11-005 DRAWING NUMBER M-3 SHEET NUMBER 25	

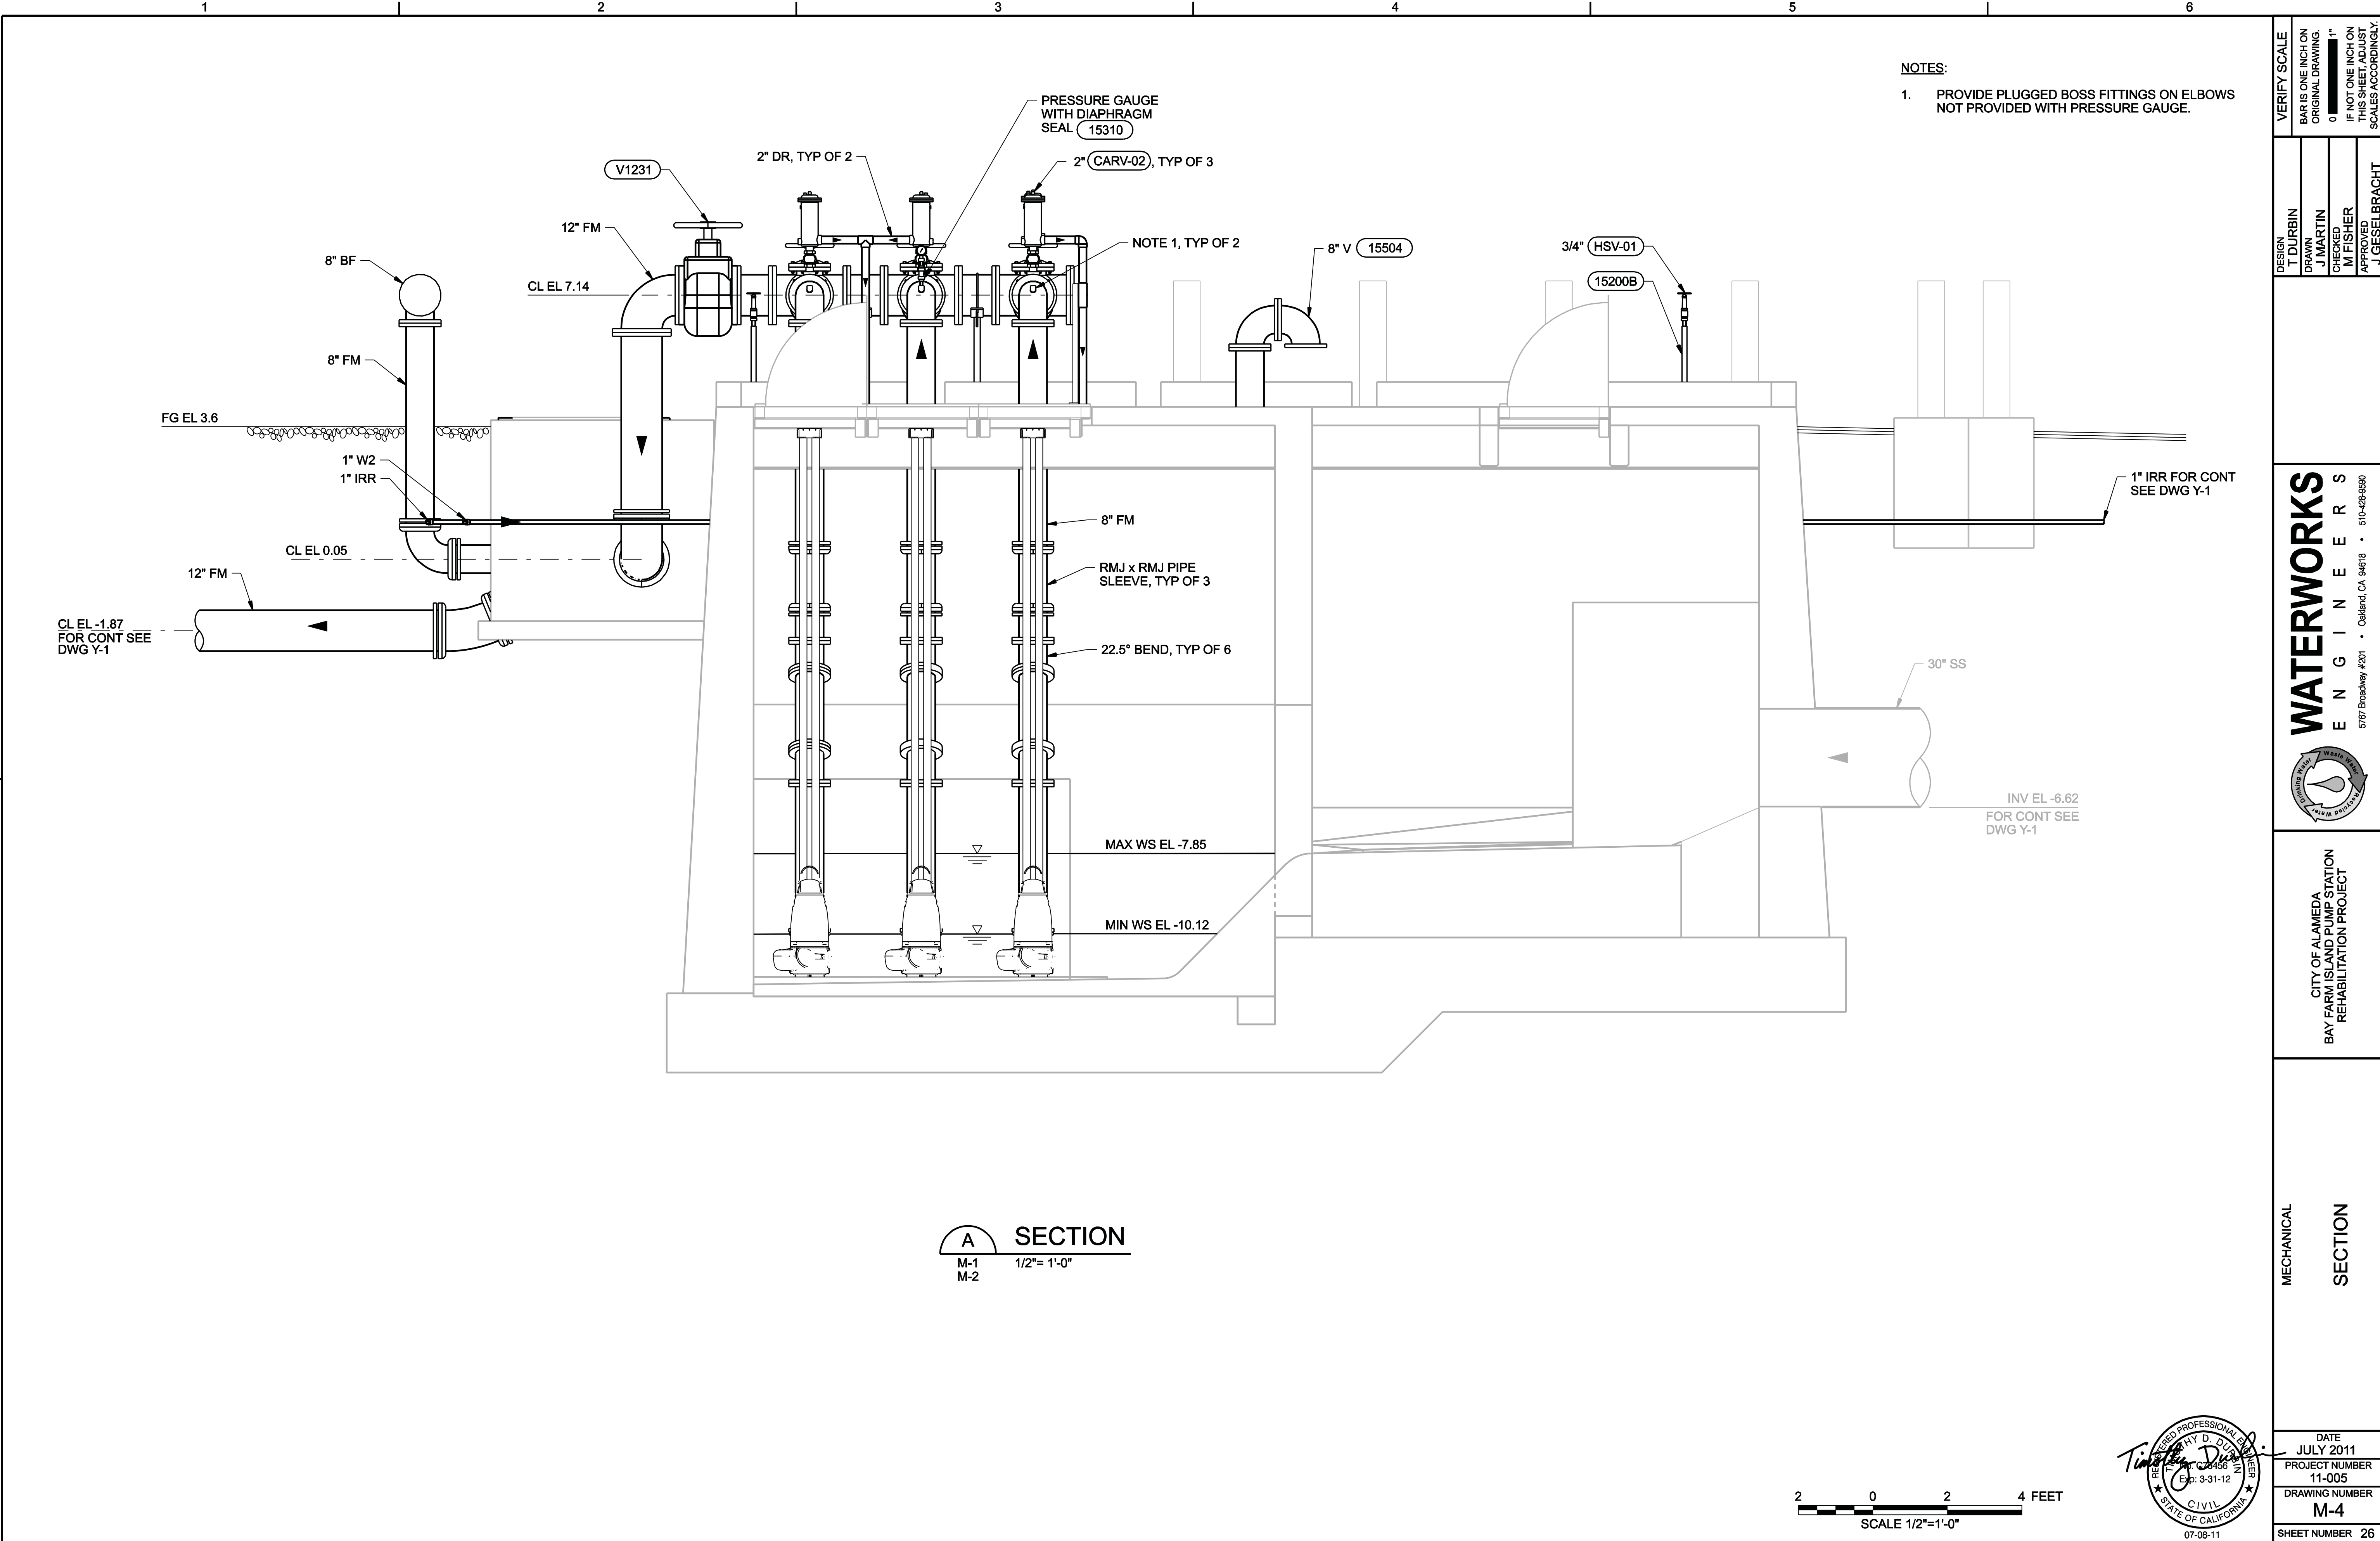

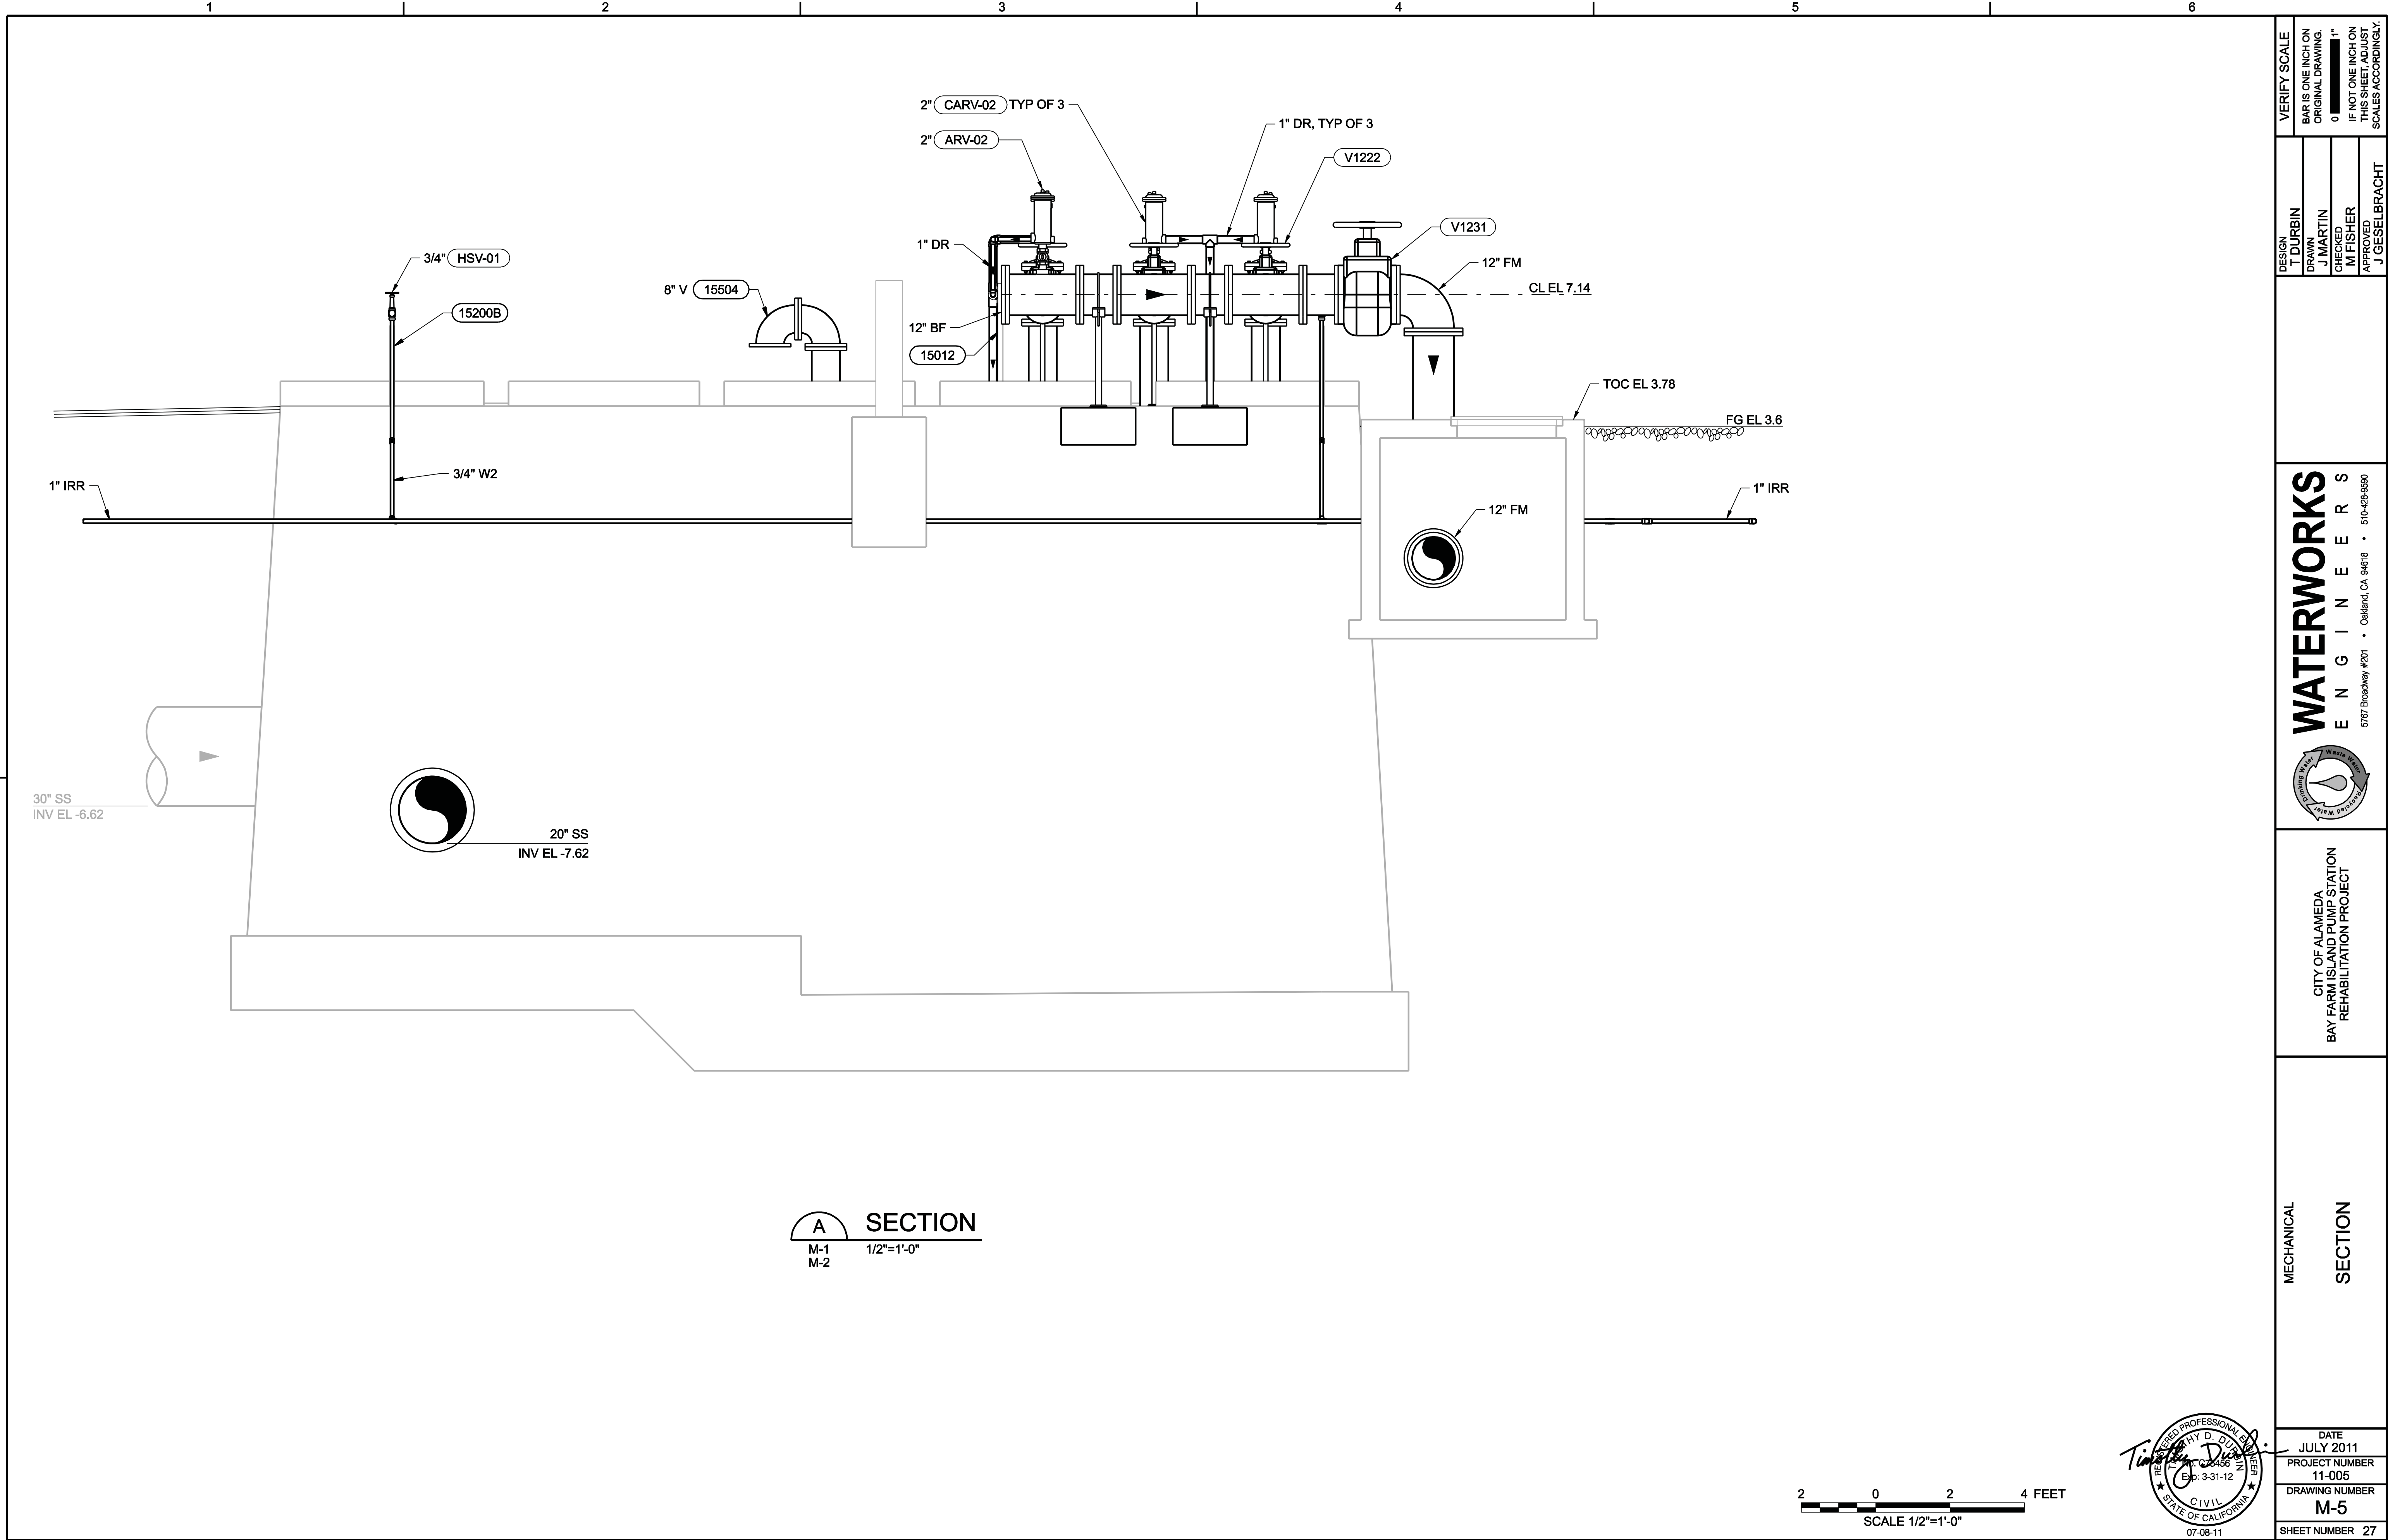

SYMBOL	DESCRIPTION	SYMBOL	DESCRIPTION	SYMBOL	DESCRIPTION	SYMBOL	DESCRIPTION
COMPONENTS		SWITCHES – PROCESS		DEVICES – RELAY		WIRING – CONNECTIONS	
	RESISTOR		FLOW SWITCH – CLOSING UPON INCREASING FLOW		CONTACTOR OR STARTER M1		PANEL OR EQUIPMENT WIRING FIELD WIRING
	POTENTIOMETER		FLOW SWITCH – OPENING UPON INCREASING FLOW		CONTROL RELAY CR1		CONDUCTORS – NOT CONNECTED
	CAPACITOR, FIXED		LEVEL SWITCH – CLOSING UPON INCREASING LEVEL		TIME DELAY RELAY TR2 – ADJUSTABLE TIME DELAY RANGE & SETTING AS SHOWN		CONDUCTORS – CONNECTED
	CAPACITOR, ADJUSTABLE		LEVEL SWITCH – OPENING UPON INCREASING LEVEL		TIME DELAY ON ENERGIZATION TIME DELAY ON DE-ENERGIZATION		GROUND
	DIODE		PRESSURE SWITCH – CLOSING UPON INCREASING PRESSURE (DECREASING VACUUM)		TIME DELAY RELAY CONTACT – ACTUATED BY RELAY CR1 COIL LOCATED ON LINE 105		PLUG AND RECEPTACLE
	DIODE, ZENER		TEMPERATURE SWITCH – CLOSING UPON INCREASING TEMPERATURE		TIME DELAY RELAY CONTACT – CONTACT CLOSING AFTER TR2 IS ENERGIZED		INCOMING LINE
	VARIATOR TRANSIENT VOLTAGE SUPPRESSOR		TEMPERATURE SWITCH – OPENING UPON INCREASING TEMPERATURE		TIME DELAY RELAY CONTACT – CONTACT CLOSING AFTER TR2 IS ENERGIZED		TERMINAL BLOCKS WITH TERMINAL NUMBER AS SHOWN
	VOLTAGE SURGE SUPPRESSOR, AC		LIMIT SWITCH – CLOSING AT SET LIMIT		TIME DELAY RELAY CONTACT – CONTACT CLOSING AFTER TR2 IS DE-ENERGIZED		TERMINAL BLOCKS WITH TERMINAL NUMBER DETERMINED BY SUBMITTAL
	METAL OXIDE VARIATOR		PROXIMITY SWITCH – CLOSING UPON DECREASING DISTANCE		TIME DELAY RELAY CONTACT – CONTACT CLOSING AFTER TR2 IS DE-ENERGIZED		SHIELDED CABLE
DEVICES – MISCELLANEOUS			PROXIMITY SWITCH – OPENING UPON DECREASING DISTANCE		SOLENOID COIL	PLAN – SYMBOLS	
	AUDIBLE ALARM		TORQUE SWITCH – CLOSING UPON INCREASING TORQUE				CONDUIT, EXPOSED
	BATTERY		TORQUE SWITCH – OPENING UPON INCREASING TORQUE				CONDUIT, IN SLAB OR BELOW GRADE
	HEATER						CONDUIT, CONCEALED IN WALL OR CEILING
	3 PHASE MOTOR ? = MOTOR HP						CONDUIT STUBBED OUT & CAPPED
	3 PHASE MOTOR						CONDUIT BENDS TOWARD OBSERVER
	SINGLE PHASE MOTOR						CONDUIT BENDS AWAY FROM OBSERVER
	TRANSFORMER SIZE AND VOLTAGE AS SHOWN						CONDUIT ENDS
	UTILITY POWER METER						FLEXIBLE CONDUIT CONNECTION FROM J-BOX TO EQUIPMENT
SWITCHES – OPERATOR		DEVICES – FRONT PANEL		DEVICES – PROTECTIVE			CONDUIT CHANGE IN ELEVATION
	TOGGLE OR DISCONNECT SWITCH		INDICATING LIGHT, LETTER "X" INDICATES COLOR: R=RED G=GREEN, A=AMBER, W=WHITE Y=YELLOW, B=BLUE		CIRCUIT BREAKER, WITH AMPS OR POLES AS SHOWN OR NOTED PROVIDE TRIP UNIT AS SHOWN MCP – MOTOR CIRCUIT PROTECTOR TM – THERMAL MAGNETIC LSIG – LONG, SHORT, INST, GFI MCS – MOLDED CASE SWITCH, NO TRIP		BARE COPPER GROUND WIRE
	PUSHBUTTON – NORMALLY OPEN, MOMENTARY ACTION		INDICATING LIGHT, PUSH TO TEST		THERMAL OVERLOAD CONTACT		GROUND CONNECTION BOLTED TYPE
	PUSHBUTTON – NORMALLY CLOSED, MOMENTARY ACTION		AMP METER		THERMAL OVERLOAD ELEMENT		GROUND CONNECTION EXOTHERMIC WELD TYPE
	PUSHBUTTON, MECHANICALLY INTERLOCKED, DOUBLE CIRCUIT – NORMALLY CLOSED AND NORMALLY OPEN, MAINTAINED ACTION		VOLT METER		FUSE WITH BLOWN FUSE INDICATING LIGHT		DISCONNECT SWITCH
	SELECTOR SWITCH, 3 POSITION – CONTACT STATUS SHOWN EXISTS AT POSITION OF H-HAND, O-OFF, OR A-AUTO		ELAPSED TIME METER		FUSE		FIELD MOUNTED DEVICE
	SELECTOR SWITCH, 2 POSITION – CONTACT STATUS SHOWN EXISTS AT POSITION AS SHOWN		MULTI-POSITION SWITCH WHERE LETTER "X" IS FUNCTION: A=AMP, V=VOLT		KIRKEY-KEY INTERLOCK		SPECIAL RECEPTACLE
					DISCONNECT SWITCH, WITH POLES AS SHOWN OR NOTED PROVIDE AMP RATING OR HP RATING AS SHOWN		TELEPHONE/DATA RECEPTACLE 2 PORT TA568A, 2 CAT 6 CABLES

MISCELLANEOUS ABBREVIATIONS			
&	AND	MTR	MOTOR
⊕	AT	MUX	MULTIPLEXER
A	AMBER, AMPERES	MV	MERCURY VAPOR, MEDIUM VOLTAGE
AC	ALTERNATING CURRENT	N	NEUTRAL
ACK	ACKNOWLEDGE	NC	NORMALLY CLOSED
AFF	ABOVE FINISHED FLOOR	NHC	NORMALLY HELD CLOSED
AH	AMP HOUR	NHO	NORMALLY HELD OPEN
AI	ANALOG INPUT	NIC	NOT IN CONTRACT
AIC	AMP INTERRUPTING CAPACITY SYMMETRICAL	NL	NIGHT LIGHT
AM	AMP METER	NO	NORMALLY OPEN
AO	ANALOG OUTPUT	NTS	NOT TO SCALE
AWG	AMERICAN WIRE GAUGE	(N)	NEW
ATS	AUTOMATIC TRANSFER SWITCH	OC	ON CENTER
BATT	BATTERY	OI	OPERATOR INTERFACE
(B)	PROVIDED BY OWNER – INSTALLED BY CONTRACTOR	OL	OVERLOAD
BFC	BELOW FINISHED CEILING	ORP	OXIDATION REDUCTION POTENTIAL
BOD	BIOCHEMICAL OXYGEN DEMAND	P	POLE
BPF	BAND PASS FILTER	PB	PUSHBUTTON
BYP	BYPASS	PBX	PULL BOX
C	CONDUIT	PF	POWER FACTOR
CAP	CAPACITOR	PFR	POWER FAIL RELAY
CB	CIRCUIT BREAKER	PH	HYDROGEN ION CONCENTRATION
CKT	CIRCUIT	PLC	PROGRAMMABLE LOGIC CONTROLLER
COAX	COAXIAL CABLE	PM	POWER MONITOR
COMM	COMMUNICATION	PNL	PANEL
CR	CONTROL RELAY	POT	POTENTIOMETER
CT	CURRENT TRANSFORMER	PRESS	PRESSURE
CS	CONSTANT SPEED	PR	PAIR, TWISTED AND SHIELDED
CU	COPPER	PRI	PRIMARY
DC	DIRECT CURRENT	PROVIDE	FURNISH, INSTALL, AND CONNECT
DET	DETAIL	PS	PRESSURE SWITCH
DI	DIGITAL INPUT	PT	POTENTIAL TRANSFORMER
DISC	DISCONNECT	PTT	PUSH TO TEST
DO	DIGITAL OUTPUT	PVC	POLYVINYLCHLORIDE
DPDT	DOUBLE POLE DOUBLE THROW	PWR	POWER
DWG	DRAWING	REF	REFERENCE
E-DTL	ELECTRICAL DRAWING DETAIL	RFI	RADIO FREQUENCY INTERFERENCE
ELEV	ELEVATION	RMS	ROOT MEAN SQUARE
EOL	ELECTRONIC OVERLOAD RELAY	RTD	RESISTANCE TEMPERATURE DETECTOR
ETM	ELAPSED TIME METER	RST	RESET
ESW	ETHERNET SWITCH	RVAT	REDUCE VOLTAGE AUTO TRANSFORMER
(E)	EXISTING	RTU	REMOTE TERMINAL UNIT
FCS	FIELD CONTROL STATION	(R)	REWIRE, RELOCATE, REVISE, REUSE
FLA	FULL LOAD AMPS	SCH	SCHEDULE
FLEX	FLEXIBLE LIQUID TIGHT CONDUIT	SEC	SECONDARY, SECOND
FRP	FIBERGLASS REINFORCED PLASTIC	SECS	SECONDS
FS	FULL SPEED	SEL	SELECTOR
FVNR	FULL VOLTAGE NON-REVERSING	SFA	SERVICE FACTOR AMPS
FVR	FULL VOLTAGE REVERSING	SPEC	SPECIFICATION
FWD	FORWARD	SS	STAINLESS STEEL
(F)	FUTURE	SSRC	STAINLESS STEEL RIGID CONDUIT
GALV	GALVANIZED	SSS	SOLID STATE STARTER
GFI	GROUND FAULT INTERRUPTER	STT	START
GND	GROUND	STP	STOP
GRS	GALVANIZED RIGID STEEL CONDUIT	SV	SOLENOID VALVE
GRS-PVC	PVC COATED GRS CONDUIT	SW	SWITCH
HI	HIGH	SWBD	SWITCHBOARD
HIM	HUMAN INTERFACE MODULE	SYMM	SYMMETRICAL
HOA	HAND OFF AUTO	TB	TERMINAL BLOCK
HP	HORSE POWER	TC	TIME CLOCK
HPS	HIGH PRESSURE SODIUM	TDOD	TIME DELAY ON DE-ENERGIZATION
HS	HAND SWITCH	TDOE	TIME DELAY ON ENERGIZATION
HTR	HEATER	TELCO	TELEPHONE COMPANY
HZ	HERTZ	TM	THERMAL MAGNETIC
HZD	HAZARD	TEMP	TEMPERATURE
I	INTERLOCK	TR	TIME DELAY RELAY
I-DTL	INSTRUMENTATION DRAWING DETAIL	TRIAD	TWISTED AND SHIELDED 3 CONDUCTOR
I/O	INPUT/OUTPUT	TS	TEMPERATURE SWITCH
INST	INSTANTANEOUS	TSPR	TWISTED AND SHIELDED PAIR
ISB	INTRINSICALLY SAFE BARRIER	TVSS	TRANSIENT VOLTAGE SURGE SUPPRESSOR
ISR	INTRINSICALLY SAFE RELAY	TYP	TYPICAL
J	JUNCTION BOX	UG	UNDERGROUND
K	KILO, PREFIX	ULH	ULTRA LOW HARMONIC
LA	LIGHTNING ARRESTOR	UON	UNLESS OTHERWISE NOTED
LC	LIGHTING CONTACTOR	UPS	UNINTERRUPTIBLE POWER SUPPLY
LEL	LOWER EXPLOSION LIMIT	V	VOLTAGE
LO	LOW	VA	VOLT AMPS
LOS	LOCK OUT STOP	VAR	VOLT AMPS REACTIVE
LR	LATCHING RELAY	VFD	VARIABLE FREQUENCY DRIVE
LS	LIMIT SWITCH	VLV	VALVE
M	MOTOR CONTACTOR	VM	VOLTMETER
MAG	MAGNETIC FLOWMETER	VMR	VOLTAGE MONITOR RELAY
MAX	MAXIMUM	VR	VOLTAGE RELAY
MCM	THOUSAND CIRCULAR MILS	W	WATTS
MCP	MOTOR CIRCUIT PROTECTOR	WP	WEATHER PROOF, NEMA 3R
MCS	MOLDED CASE SWITCH	WTP	WATER TREATMENT PLANT
MH	MANHOLE	WWTP	WASTE WATER TREATMENT PLANT
MIN	MINIMUM, MINUTE	XFMR	TRANSFORMER
MODEM	MODEM	Z	IMPEDANCE
MOV	MOTOR OPERATED VALVE	ZS	LIMIT SWITCH

WATERWORKS

CITY OF ALAMEDA
BAY FARM ISLAND PUMP STATION
REHABILITATION PROJECT

ELECTRICAL
SYMBOLS AND ABBREVIATIONS

DATE
JULY 2011
PROJECT NUMBER
11-005
DRAWING NUMBER
E01
SHEET NUMBER 28

FRISCH ENGINEERING, INC.
CONSULTING ELECTRICAL ENGINEERS
110 BLUE RAINE RD, SUITE 101
FOLSOM, CA 95630
PH 916 353 1025
FX 916 353 1028
FILE: 11020-E01.DWG DATE: JUL 07, 2011 TIME: 12:57:22PM



P&ID SYMBOLS							
SYMBOL	DESCRIPTION	SYMBOL	DESCRIPTION	SYMBOL	DESCRIPTION	SYMBOL	DESCRIPTION
ISA SYMBOLS		VALVES		PUMPS		MISCELLANEOUS MECHANICAL ITEMS	
	FIELD MOUNTED INSTRUMENT		GATE VALVE		CENTRIFUGAL PUMP OR BLOWER		PIPE REDUCER
	INSTRUMENT MOUNTED ON DOOR OF LOCAL PANEL, OPERATOR ACCESSIBLE		CHECK VALVE		SUBMERSIBLE SEWAGE PUMP		RUPTURE DISC
	INSTRUMENT MOUNTED ON DOOR OF FIELD PANEL, OPERATOR ACCESSIBLE		PLUG VALVE		VERTICAL TURBINE PUMP OR WELL PUMP		PRESSURE OR VACUUM RELIEF VALVE
	INSTRUMENT MOUNTED WITHIN PANEL, OPERATOR INACCESSIBLE		BALL VALVE		DIAPHRAGM SEAL		ANNUALR SEAL
	INSTRUMENT MOUNTED WITHIN FIELD PANEL, OPERATOR INACCESSIBLE		BUTTERFLY VALVE		SUBMERSIBLE WELL PUMP		MIXER
	OPERATION PERFORMED WITH LOGIC OR HARDWIRED DEVICES		ANGLE VALVE		GEAR PUMP		FILTER
	ASSOCIATED MOTOR CONTROL ELEMENTARY IF APPLICABLE		NEEDLE VALVE		POSITIVE DISPLACEMENT PUMP OR BLOWER		VENT W/CAP OR SCREEN
	VISUAL DISPLAY OF PLC ANALOG REGISTER SCALE TO UNITS AS SHOWN		RELIEF VALVE		DIAPHRAGM PUMP		FLEXIBLE HOSE OR TUBING
	VISUAL DISPLAY OF PLC ANALOG ALARM REGISTER		DIAPHRAGM VALVE		PERISTALTIC PUMP		SPRAY NOZZLE SYSTEM
	VISUAL DISPLAY OF PLC DIGITAL REGISTER		3-WAY VALVE		MOTOR		EXPANSION JOINT
	VISUAL DISPLAY OF PLC DIGITAL ALARM REGISTER		FLOW CONTROL VALVE	SENSORS			STATIC MIXER
	TAG DESCRIPTION		SOLENOID VALVE (2-WAY) (S → M FOR MOTORIZED VALVE)		ORIFICE PLATE		EJECTOR / EDUCTOR
	PLC I/O TAG		SOLENOID VALVE (3-WAY) (S → M FOR MOTORIZED VALVE)		MAGNETIC FLOWMETER		HOSE COUPLING
	PLC DIGITAL INPUT		SOLENOID VALVE (4-WAY) (S → M FOR MOTORIZED VALVE)		DENSITY METER		PULSATION DAMPENR
	PLC DIGITAL OUTPUT		PNEUMATIC DIAPHRAGM CONTROL VALVE		ULTRASONIC FLOWMETER		OMNI ANTENNA NON-DIRECTIONAL
	ANALOG INPUT		PRESSURE SUSTAINING VALVE		TURBINE OR PROPELLER METER		YAGI ANTENNA DIRECTIONAL
	ANALOG OUTPUT		PRESSURE REGULATING VALVE		VENTURI TUBE		
	AUDIBLE ALARM (BUZZER OR HORN)		MULTIFUNCTION VALVE		THERMAL DISPERSION FLOWMETER OR SWITCH		
	LAMP INDICATION COLOR DENOTED BY "X" RED, BLU, GRN, WHT, AMBER		SLUICE GATE (SG) OR SLIDE GATE (SLG)		ULTRASONIC LEVEL TRANSMITTER (FLOW IF OVER FLUME OR WEIR)		
	CONTINUATION TAG FROM ONE AREA TO ANOTHER AREA OF DIFFERENT DRAWINGS "a" TAG IDENTIFIER TO POINT ON DRAWING NUMBER XXXX.		AIR RELIEF VALVE (ARV)		CONDUCTANCE TYPE LEVEL ELEMENTS		
	CONTINUED ON DWG I-X		FLOAT VALVE		RADAR TYPE LEVEL TRANSMITTER		
LINE TYPES			BACKFLOW PREVENTER		GUIDED OPTION		
	PRIMARY PROCESS LINE		CALIBRATION VALVE		CAPACITANCE TYPE LEVEL TRANSMITTER		
	SECONDARY PROCESS LINE		CALIBRATION COLUMN				
	ELECTRICAL SIGNAL LINE (DIGITAL OR ANALOG)		ROTAMETER				
	SOFTWARE OR DATA LINK		UNION				
	BOUNDARY OF EQUIPMENT PACKAGE SYSTEM	ACTUATORS					
	COMMUNICATION CONNECTION		MOTORIZED SOLENOID				
			PNEUMATIC OPERATOR S- SOLENOID - OPEN/CLOSE A- POSITIONER - MODULATING				

P&ID ABBREVIATIONS					
INSTRUMENTATION SYMBOLS			SUCCEEDING LETTERS		
FIRST LETTER	MEASURED OR INITIATING VARIABLE	MODIFIER	READOUT PASSIVE FUNCTION	OUTPUT FUNCTION	MODIFIER
A	ANALYSIS		ALARM		
B	BURNER, COMBUSTION		USER'S CHOICE	USER'S CHOICE	USER'S CHOICE
C	CONDUCTIVITY			CONTROLLER	
D	DENSITY	DIFFERENTIAL			
E	VOLTAGE		SENSOR, PRIMARY ELEMENT		
F	FLOW	RATIO			
G	GENERAL		GLASS VIEWING DEVICE		
H	HAND				HIGH, OPENED
I	CURRENT		INDICATING, INDICATOR		
J	POWER	SCAN			
K	TIME, TIME SCHEDULED	TIME RATE OF CHANGE		CONTROL STATION	
L	LEVEL		LIGHT		LOW, CLOSED
M	MOISTURE	MOMENTARY			MIDDLE
N	STATUS		STATUS	USER'S CHOICE	USER'S CHOICE
O	OPERATOR		ORIFICE, RESTRICTION		
P	PRESSURE, VACUUM		POINT (TEST) CONNECTION		
Q	QUANTITY	INTEGRATE, TOTALIZE			
R	RESET		RECORD		
S	SPEED, FREQUENCY	SAFETY		SWITCH	
T	TEMPERATURE			TRANSMITTER	TEST
U	MULTIVARIABLE		MULTIFUNCTION	MULTIFUNCTION	MULTIFUNCTION
V	VIBRATION			VAVE, DAMPER, LOUVER	
W	WEIGHT		WELL		
X	SWITCH	X AXIS	UNCLASSIFIED	UNCLASSIFIED	UNCLASSIFIED
Y	EVENT, STATE OF PRESENCE	Y AXIS		RELAY, COMPUTER, CONVERTER	
Z	POSITION, DIMENSION	Z AXIS		DRIVER, ACTUATOR, UNCLASSIFIED FINAL CONTROL ELEMENT	

P&ID ABBREVIATIONS			
SWITCH IDENTIFIER			
F/R	FORWARD/REVERSE	S/D	SHUTDOWN
HOA	HAND-OFF-AUTO	SEL	SELECTOR
HOR	HAND-OFF-REMOTE	S/S	START / STOP
LOS	LOCK OUT STOP	%	PERCENT ADJUSTMENT
MOA	MANUAL-OFF-AUTO		
OCA	OPEN-CLOSE-AUTO		
O/C	OPEN / CLOSE		
O/O	ON / OFF		
O/R	OVERRIDE		

VERIFY SCALE
BAR IS ONE INCH ON
ORIGINAL DRAWING.
0 1"
IF NOT ONE INCH ON
THIS SHEET, ADJUST
SCALES ACCORDINGLY.

DESIGN
S PENNER
DRAWN
N CONANT
CHECKED
T FRISCH
APPROVED
M FISHER

WATERWORKS
ENGINEERS


CITY OF ALAMEDA
BAY FARM ISLAND PUMP STATION
REHABILITATION PROJECT

INSTRUMENTATION
SYMBOLS AND ABBREVIATIONS


DATE
JULY 2011
PROJECT NUMBER
11-005
DRAWING NUMBER
E02
SHEET NUMBER 29

FRISCH ENGINEERING, INC.
CONSULTING ELECTRICAL ENGINEERS
110 BLUE RAVINE RD, SUITE 101
FOLSOM, CA 95630
PH 916 353 1025
FX 916 353 1028
FILE: 11020-E02.DWG DATE: JUL 07, 2011 TIME: 12:57:28PM


REGISTERED PROFESSIONAL ENGINEER
THOMAS P. FRISCH
No. E15761
Exp. 09-30-12
ELECTRICAL
STATE OF CALIFORNIA

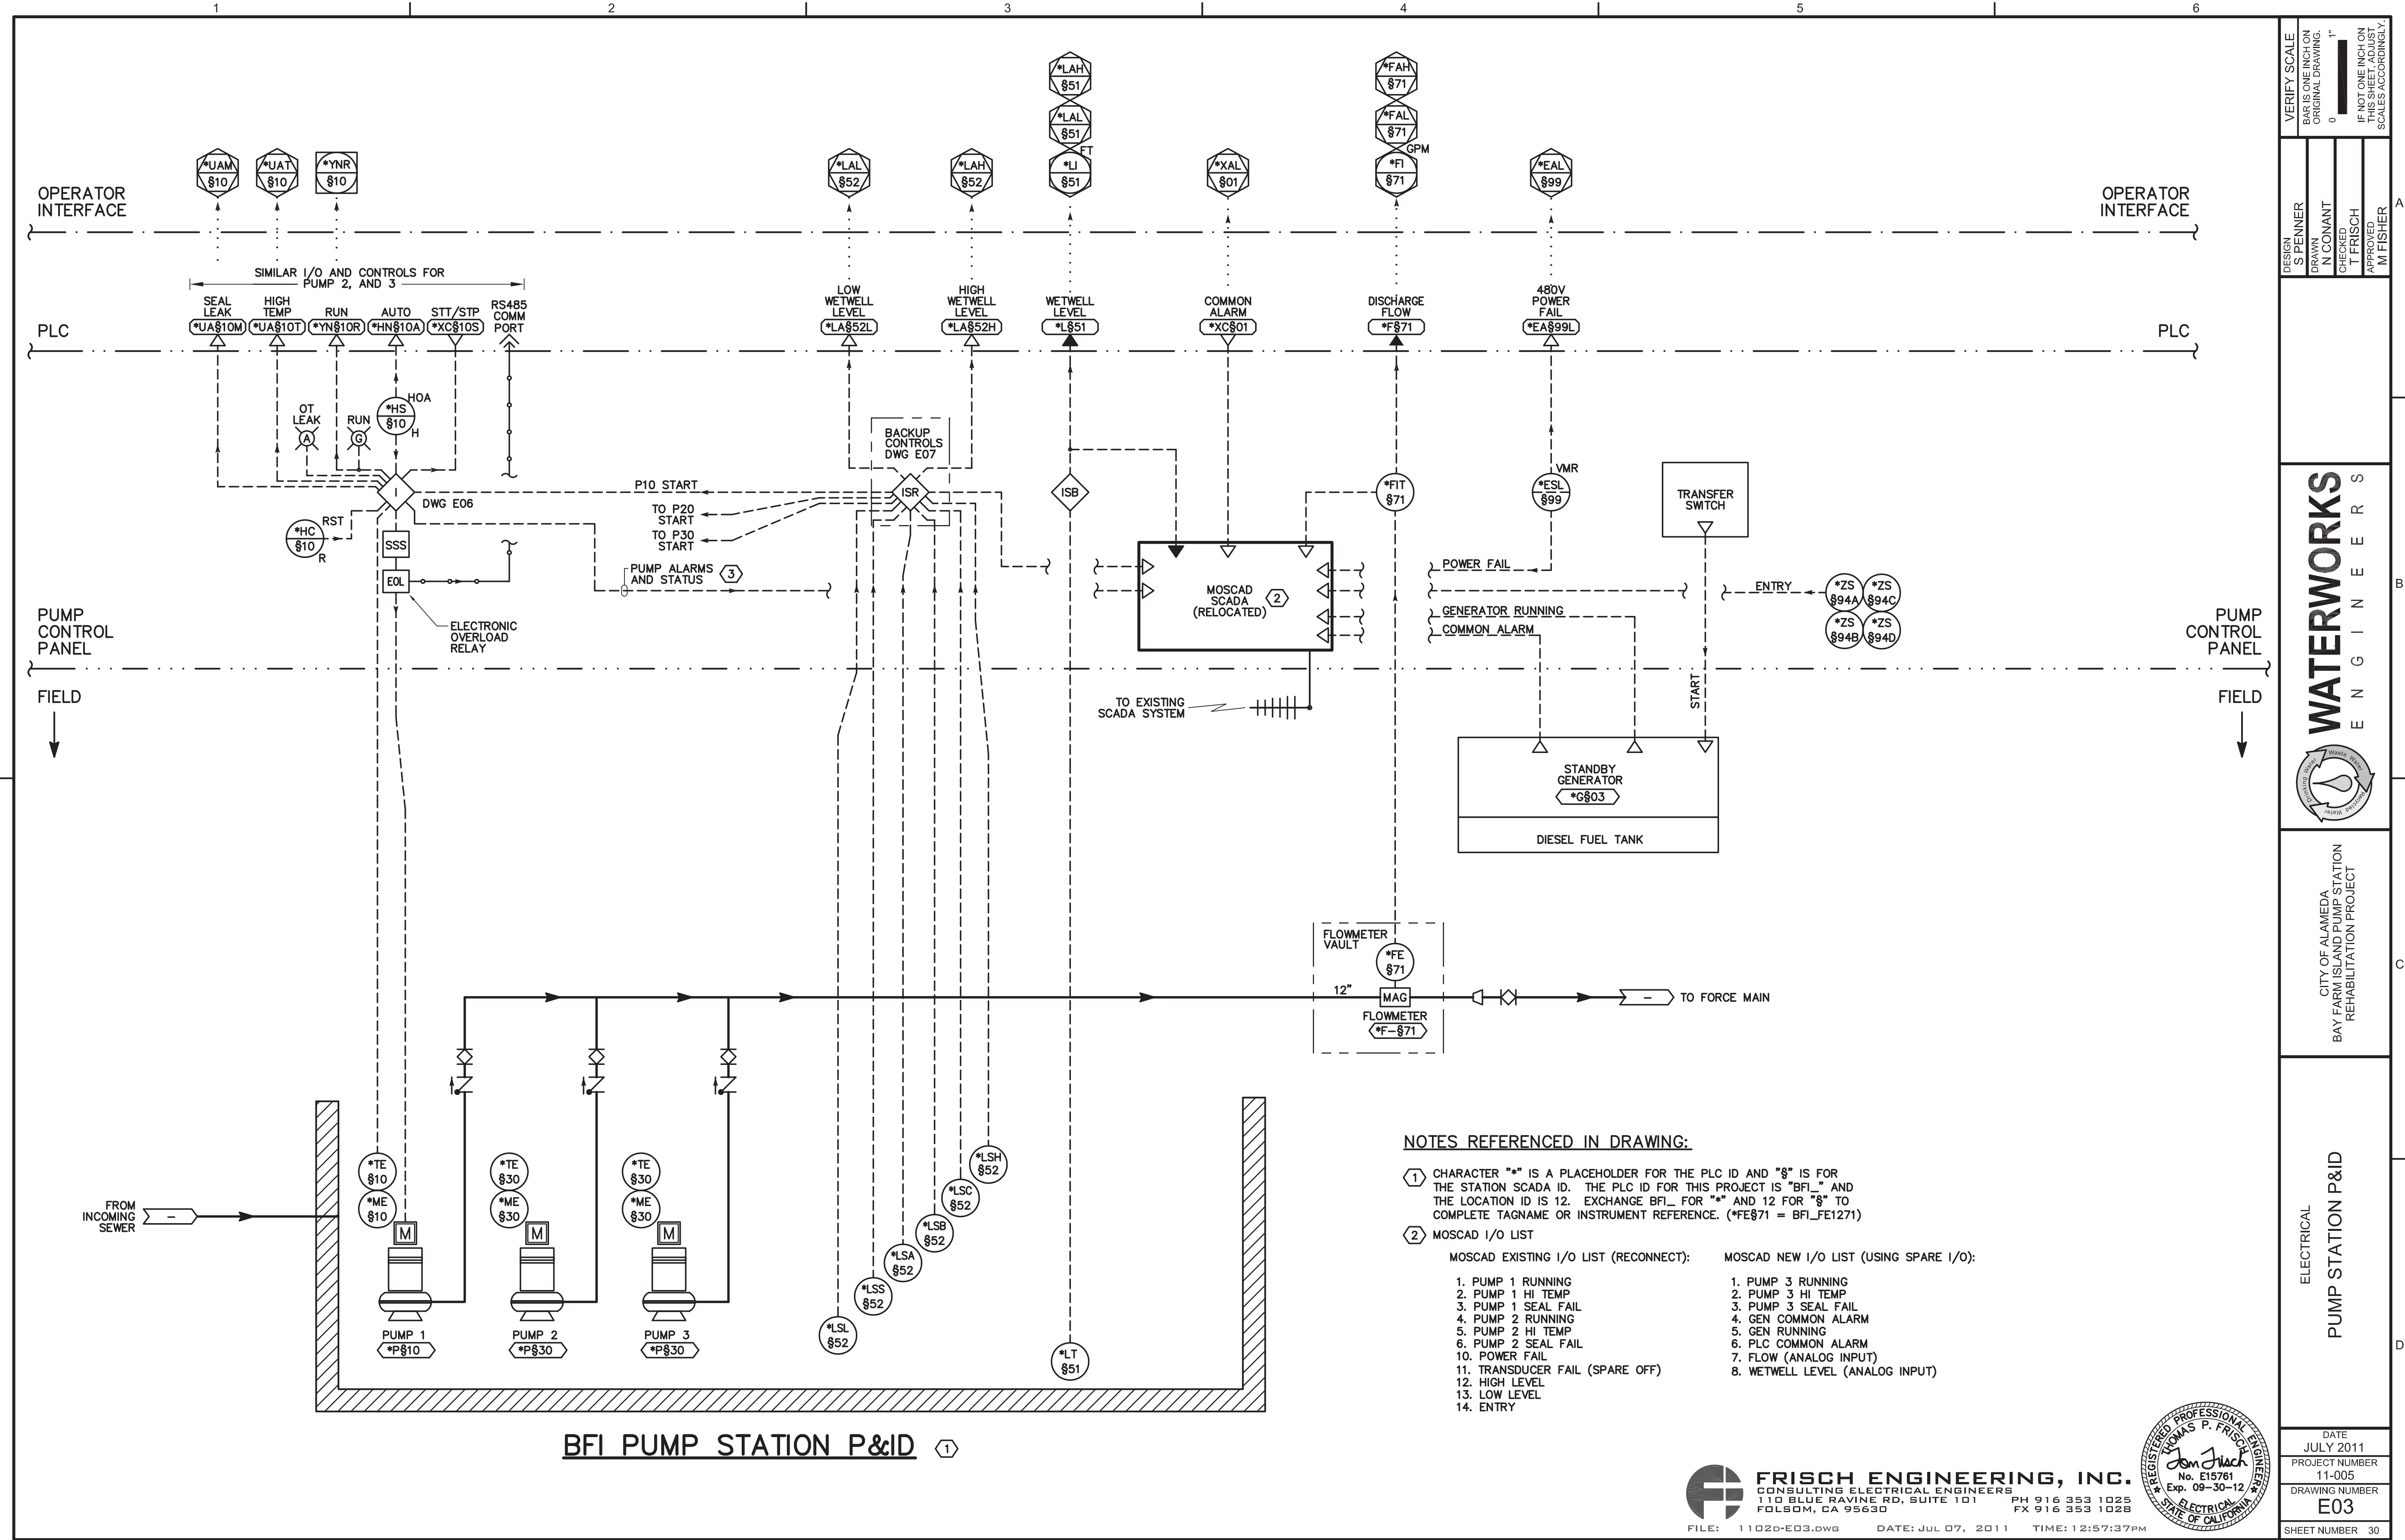

LOAD CALCULATIONS									
LOAD DESCRIPTION	CONNECTED LOAD			DEMAND LOAD			GENERATOR LOAD		
	LOAD	QTY	TOTAL	LOAD	QTY	TOTAL	LOAD	QTY	TOTAL
20 HP SEWAGE PUMP	26.00	A 3	64848.0 VA	26.00	A 2	43232.0 VA	26.00	A 3	64848.0 VA
7.5 KVA PANELBOARD TRANSFORMER	6.13	A 1	5100.0 VA	6.13	A 1	5100.0 VA	6.13	A 1	5100.0 VA
TOTAL LOAD =	84.13	A	69948.0 VA	58.13	A	48332.0 VA	84.13	A	69948.0 VA
LOAD CORRECTION FACTORS									
LARGEST MOTOR LOAD x 25%:							GENERATOR SIZE		
20 HP HP => 0.25 x 21616.0 VA	=	6.50	A	5404.0	VA	6.50	A	5404.0	VA
80% BREAKER DERATING =	TOTAL x 0.25 =	22.66	A	18838.0	VA	16.16	A	13434.0	VA
FOR CONTINUOUS LOADS NEC 210-20							SIZE = 80 KW		
SERVICE SIZE (MIN) = 113.29 A 94190.0VA							100 KVA		
UTILITY SERVICE SIZE REQUIRED = 200 AMP							AMPERAGE = 120 A		
480V, 3 PHASE, 4 WIRE							UTILIZATION % = 70 %		
							MAX VOLT DIP % = 15 %		

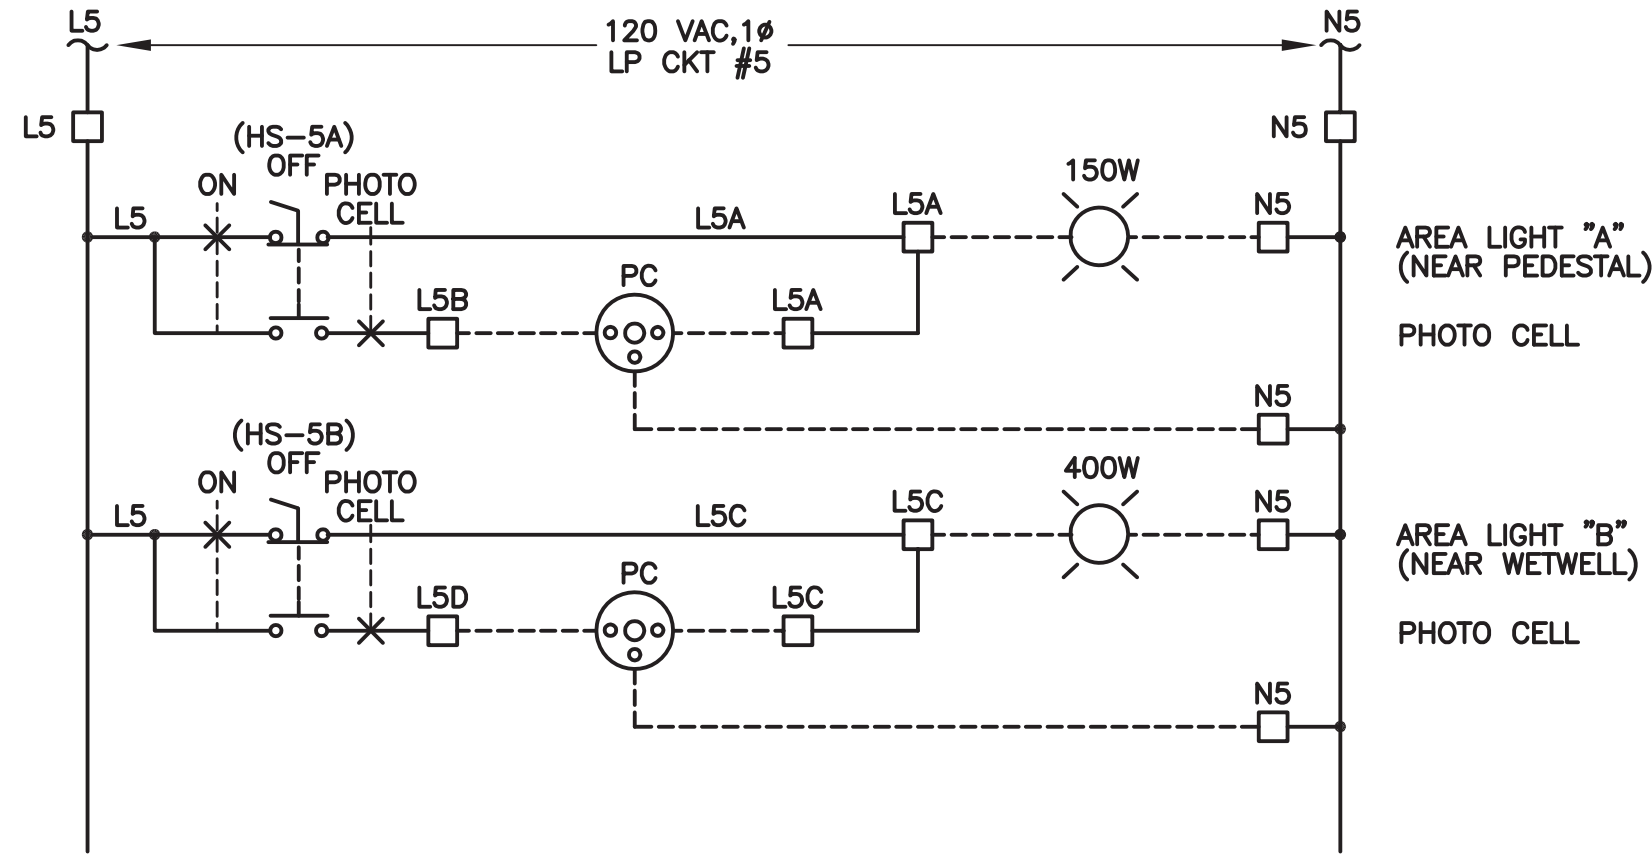


AREA LIGHTING WIRING DIAGRAM

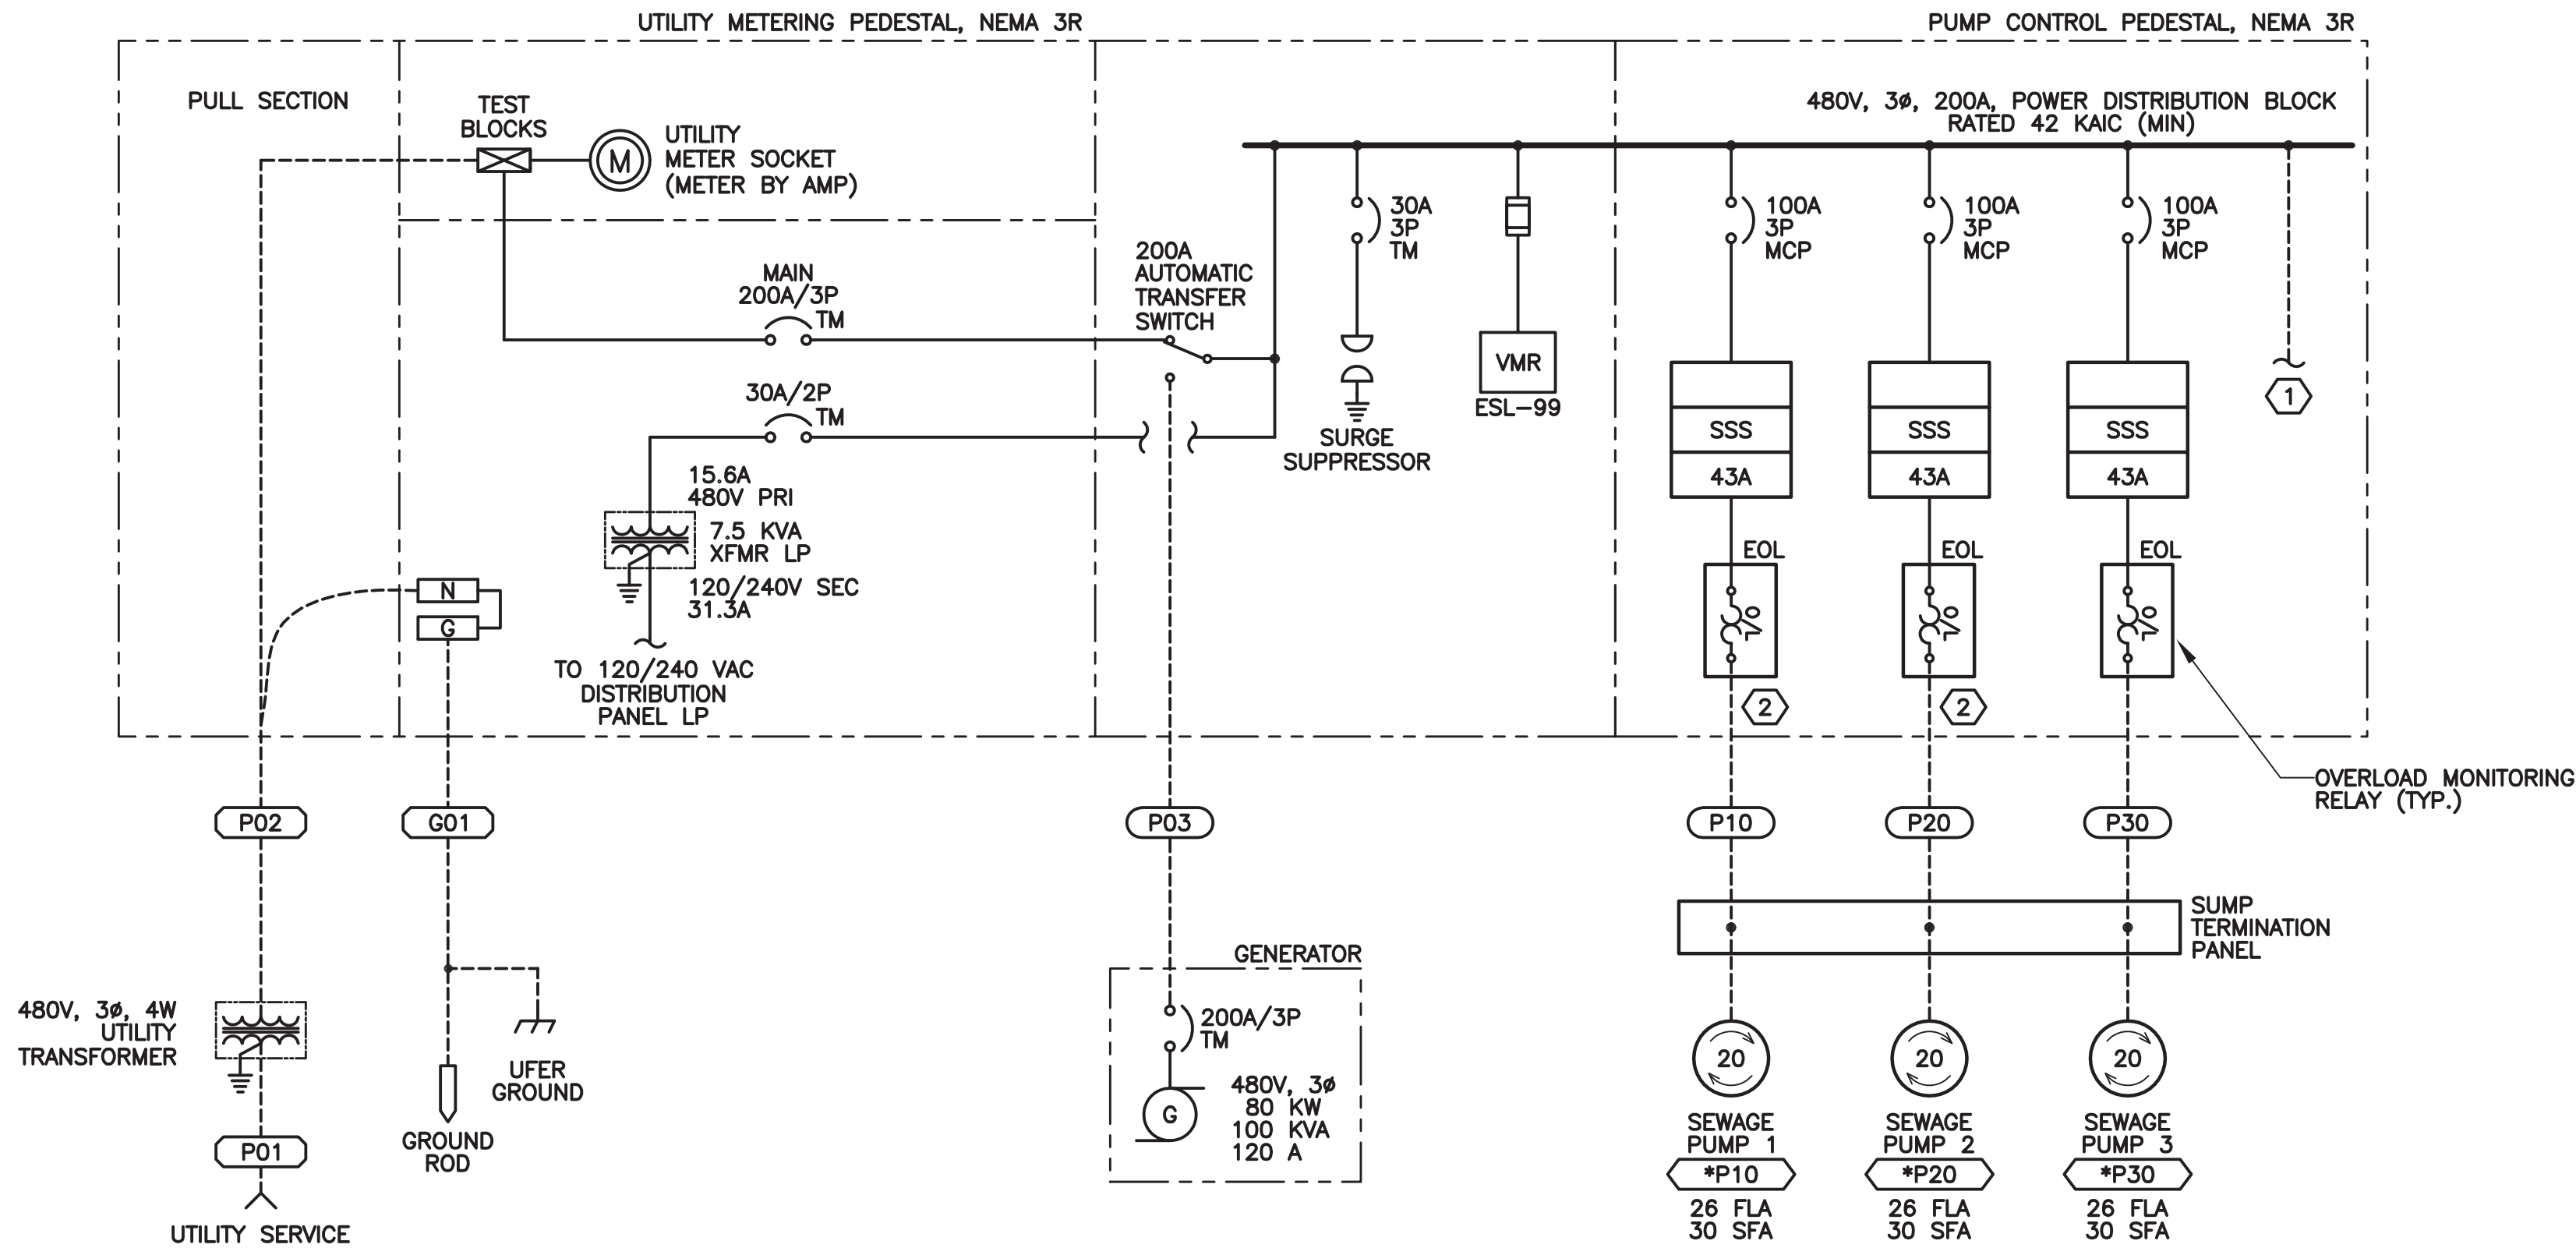

ONE-LINE DIAGRAM


DRAWING REFERENCED NOTES:

- 1 AVAILABLE (3-PHASE) CONNECTION POINT FOR TEMPORARY BYPASS PUMPING SYSTEM. SEE SPECIFICATIONS FOR PROJECT CONSTRAINTS.
- 2 TEMPORARY PUMPS MAY BE OPERATED FROM NEW CONTROL PANEL UTILIZING MOTOR STARTERS AND BACKUP FLOAT CONTROL SYSTEM. CONFIGURE MOTOR CONTROLS FOR BYPASS AND PERMANENT PUMPS.

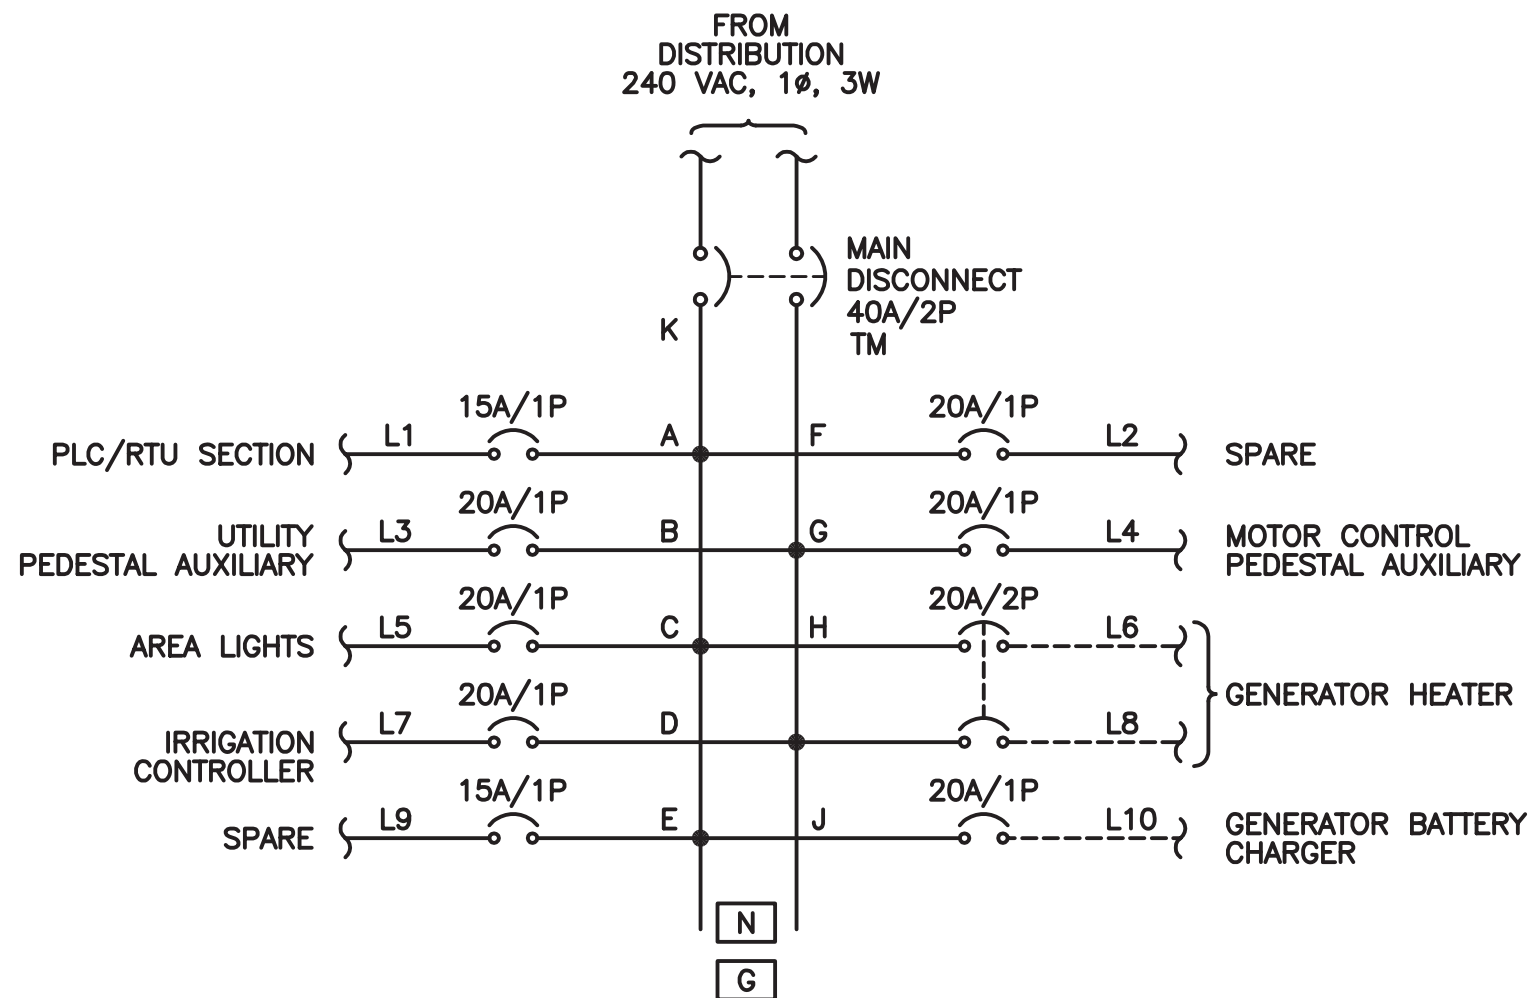


PANELBOARD "LP"

120/240 VAC DISTRIBUTION DIAGRAM
NEUTRALS NOT SHOWN

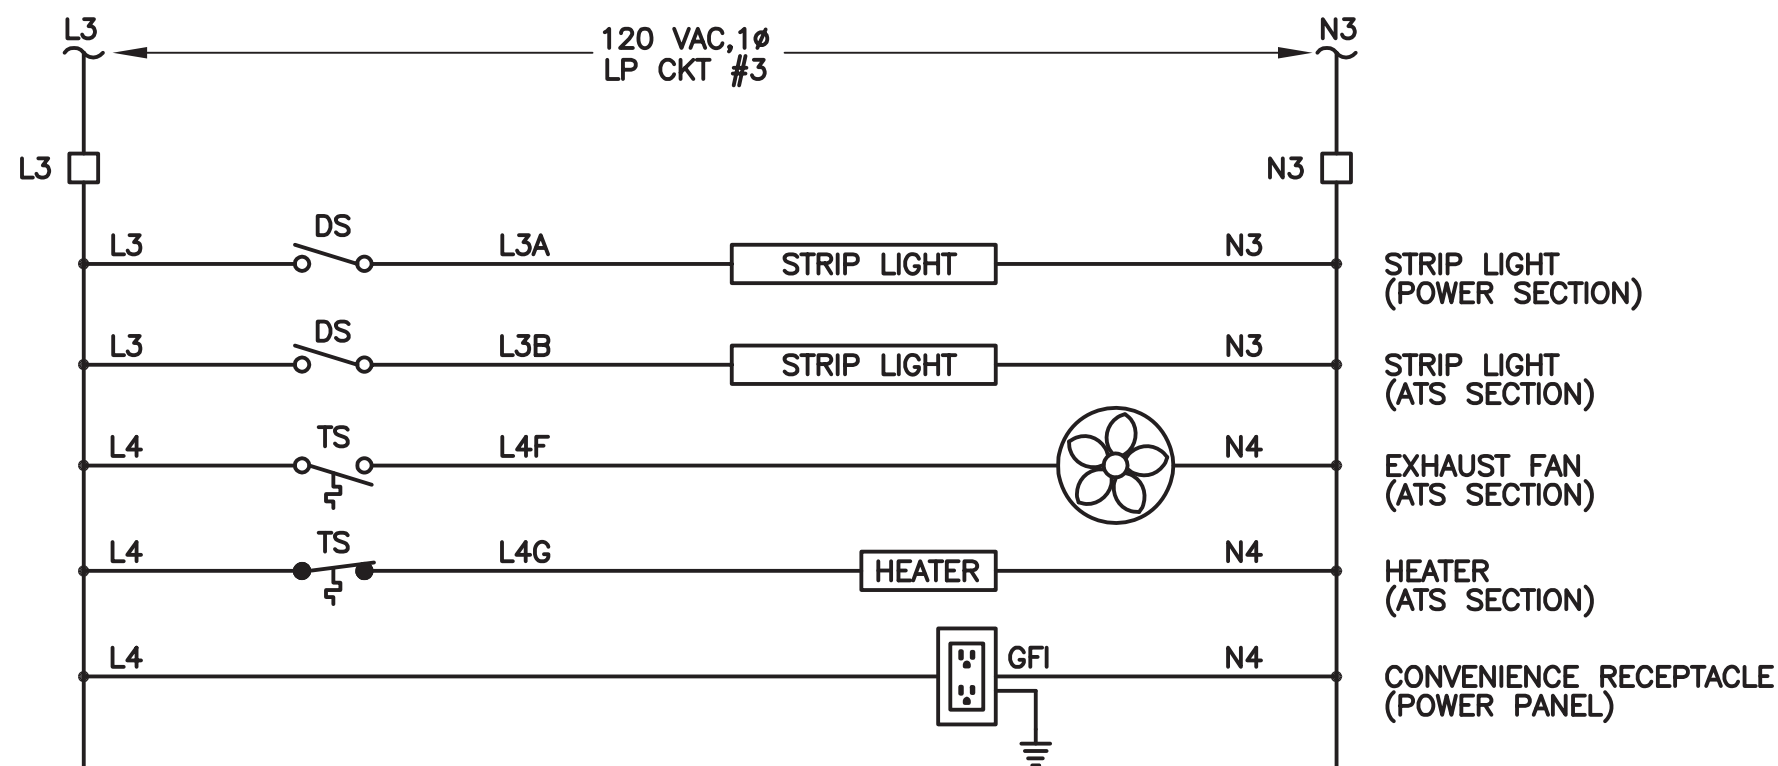

UTILITY PEDESTAL AUXILIARY

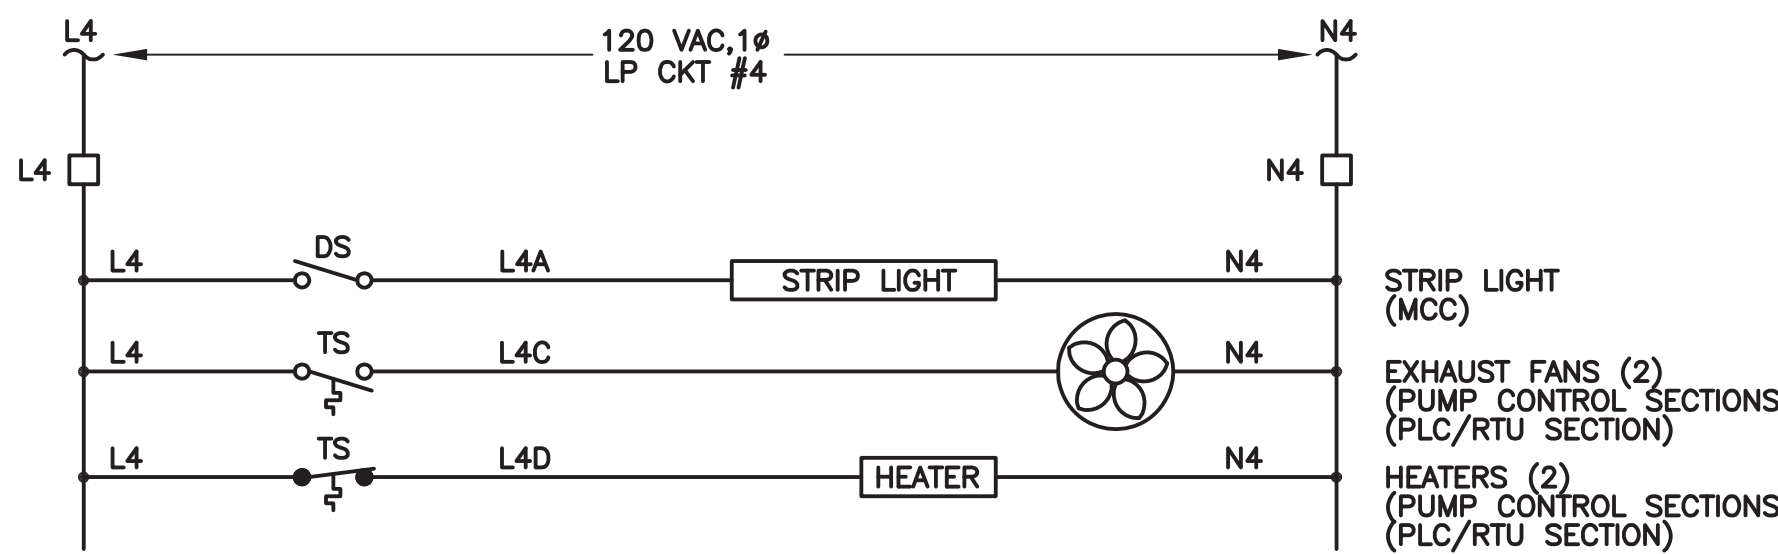


MOTOR CONTROL PEDESTAL AUXILIARY



FRISCH ENGINEERING, INC.
CONSULTING ELECTRICAL ENGINEERS
110 BLUE RAVINE RD, SUITE 101
FOLSOM, CA 95630
PH 916 353 1025
FX 916 353 1028

FILE: 11020-EO4.dwg DATE: JUL 07, 2011 TIME: 12:57:41 PM

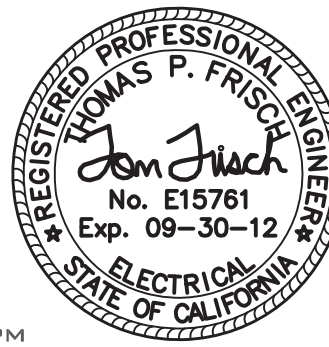

WATERWORKS
ENGINEERS

CITY OF ALAMEDA
BAY FARM ISLAND PUMP STATION
REHABILITATION PROJECT

ELECTRICAL
ONE-LINE DIAGRAM
AND AUXILIARY WIRING DIAGRAMS


DATE
JULY 2011
PROJECT NUMBER
11-005
DRAWING NUMBER
E04
SHEET NUMBER 31

DRAWING REFERENCED NOTES:

- 1 ITEMS DRAWN IN DASHED LINES ARE TO BE LOCATED BEHIND DEADFRONT DOORS
OUTER DOORS ARE NOT SHOWN ON FRONT VIEWS FOR ELEVATION CLARITY
- 2 PROVIDE METER AND UTILITY ENTRANCE PER ALAMEDA MUNICIPAL POWER REQUIREMENTS.

PEDESTAL FABRICATION METHODS

- NEMA 3R WEATHER-PROOF FOR OUTDOOR INSTALLATION.
- OUTER DOORS SHALL BE SEALED WITH RUBBERIZED FOAM GASKET.
- EXTERIOR FABRICATED FROM GALVANIZED SHEET STEEL.
- 12 GAUGE EXTERIOR AND 14 GAUGE INTERIOR.
- ALL SEAMS SHALL HAVE CONTINUOUS WELD GROUND SMOOTH.
- OUTER DOORS TO BE PADLOCKABLE WITH HEAVY DUTY 3 POINT LATCHES.
- DOOR HINGES AND PINS SHALL BE 316 STAINLESS STEEL.
- NO SCREWS, RIVETS, OR BOLTS SHALL PROTRUDE EXTERNALLY.
- INTERNAL SCREWS, RIVETS, BOLTS, AND NUTS SHALL BE STAINLESS STEEL.
- POWER METERING SHALL PER USERC AND SERVING UTILITY'S REQUIREMENTS.
- PAINT APPLICATION SHALL BE AS FOLLOWS:
 - TWO STAGE CHEMICAL BATH CLEANING.
 - ELECTROSTATICALLY APPLIED POWDER COAT PAINT FINISH.
 - OVEN CURED FOR TWO HOURS.
 - INTERIOR DEADFRONT DOOR COLOR: WHITE.
 - EXTERIOR COLOR SHALL BE AUTUMN WHITE
- PHENOLIC SCREW MOUNTED NAMEPLATES SHALL BE PROVIDED FOR ALL OUTER DOOR SECTIONS AND DEVICES ON DEADFRONT.
- FABRICATION AND WIRING SHALL CONFORM TO UL, NEC AND NEMA STANDARDS.
- ALL WIRING SHALL BE LABELLED ON BOTH ENDS OF WIRE.
- AS-BUILT WIRING DIAGRAMS SHALL BE SHIPPED WITH PANEL.
- PROVIDE DRAWING POCKET ON INSIDE OF CONTROL PANEL DOOR.
- UPS SHELF SHALL BE 14 GA WELDED STEEL BOLTED TO BACKPAN.

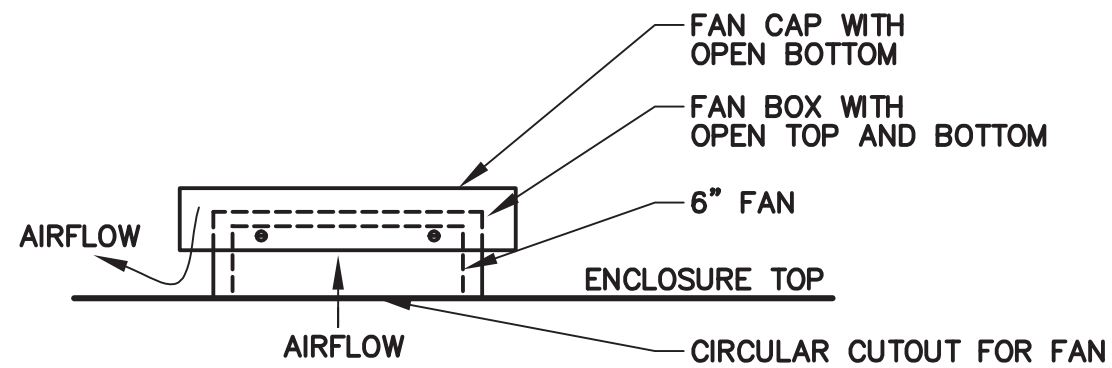


- NOTES: 1. FAN CAP AND BOX SHALL BE CONSTRUCTED FROM 14GA GALVANIZED STEEL AND PAINTED WITH CONTROL PANEL.
2. PROVIDE CIRCULAR CUTOUT IN TOP OF ENCLOSURE. SEAL FAN BOX TO ENCLOSURE WITH SILICONE SEALANT.

EXHAUST FAN DETAIL

NOT TO SCALE


NAMEPLATE SCHEDULE

KEY	LINE 1	ENGRAVING	LINE 2	LETTER HEIGHT
A	PLC/RTU SECTION	DISCONNECT		3/16"
B	UTILITY	AUXILIARY		3/16"
C	AREA LIGHT			3/16"
D	IRRIGATION	CONTROLLER		3/16"
E	SPARE BREAKER			3/16"
F	SPARE BREAKER			3/16"
G	MOTOR CONTROLS	AUXILIARY		3/16"
H	GENERATOR	HEATER		3/16"
J	GENERATOR	BATTERY CHARGER		3/16"
K	TRANSFORMER	DISCONNECT		3/16"
L	PANELBOARD	MAIN		3/16"
M	MAIN	DISCONNECT		3/16"
N	GENERATOR	DISCONNECT		3/16"
Q	PUMP 1	DISCONNECT		3/16"
R	PUMP 2	DISCONNECT		3/16"
S	PUMP 3	DISCONNECT		3/16"
T	RTU SECTION	SECTION		3/16"
V	PUMP CONTROL	SECTION		3/16"
W	AUTOMATIC TRANSFER	SWITCH SECTION		3/16"
X	UTILITY	METERING		3/16"
Y	PEDESTAL AREA LIGHT	ON OFF PHOTO CELL		3/16"
Z	WET WELL AREA LIGHT	ON OFF PHOTO CELL		3/16"

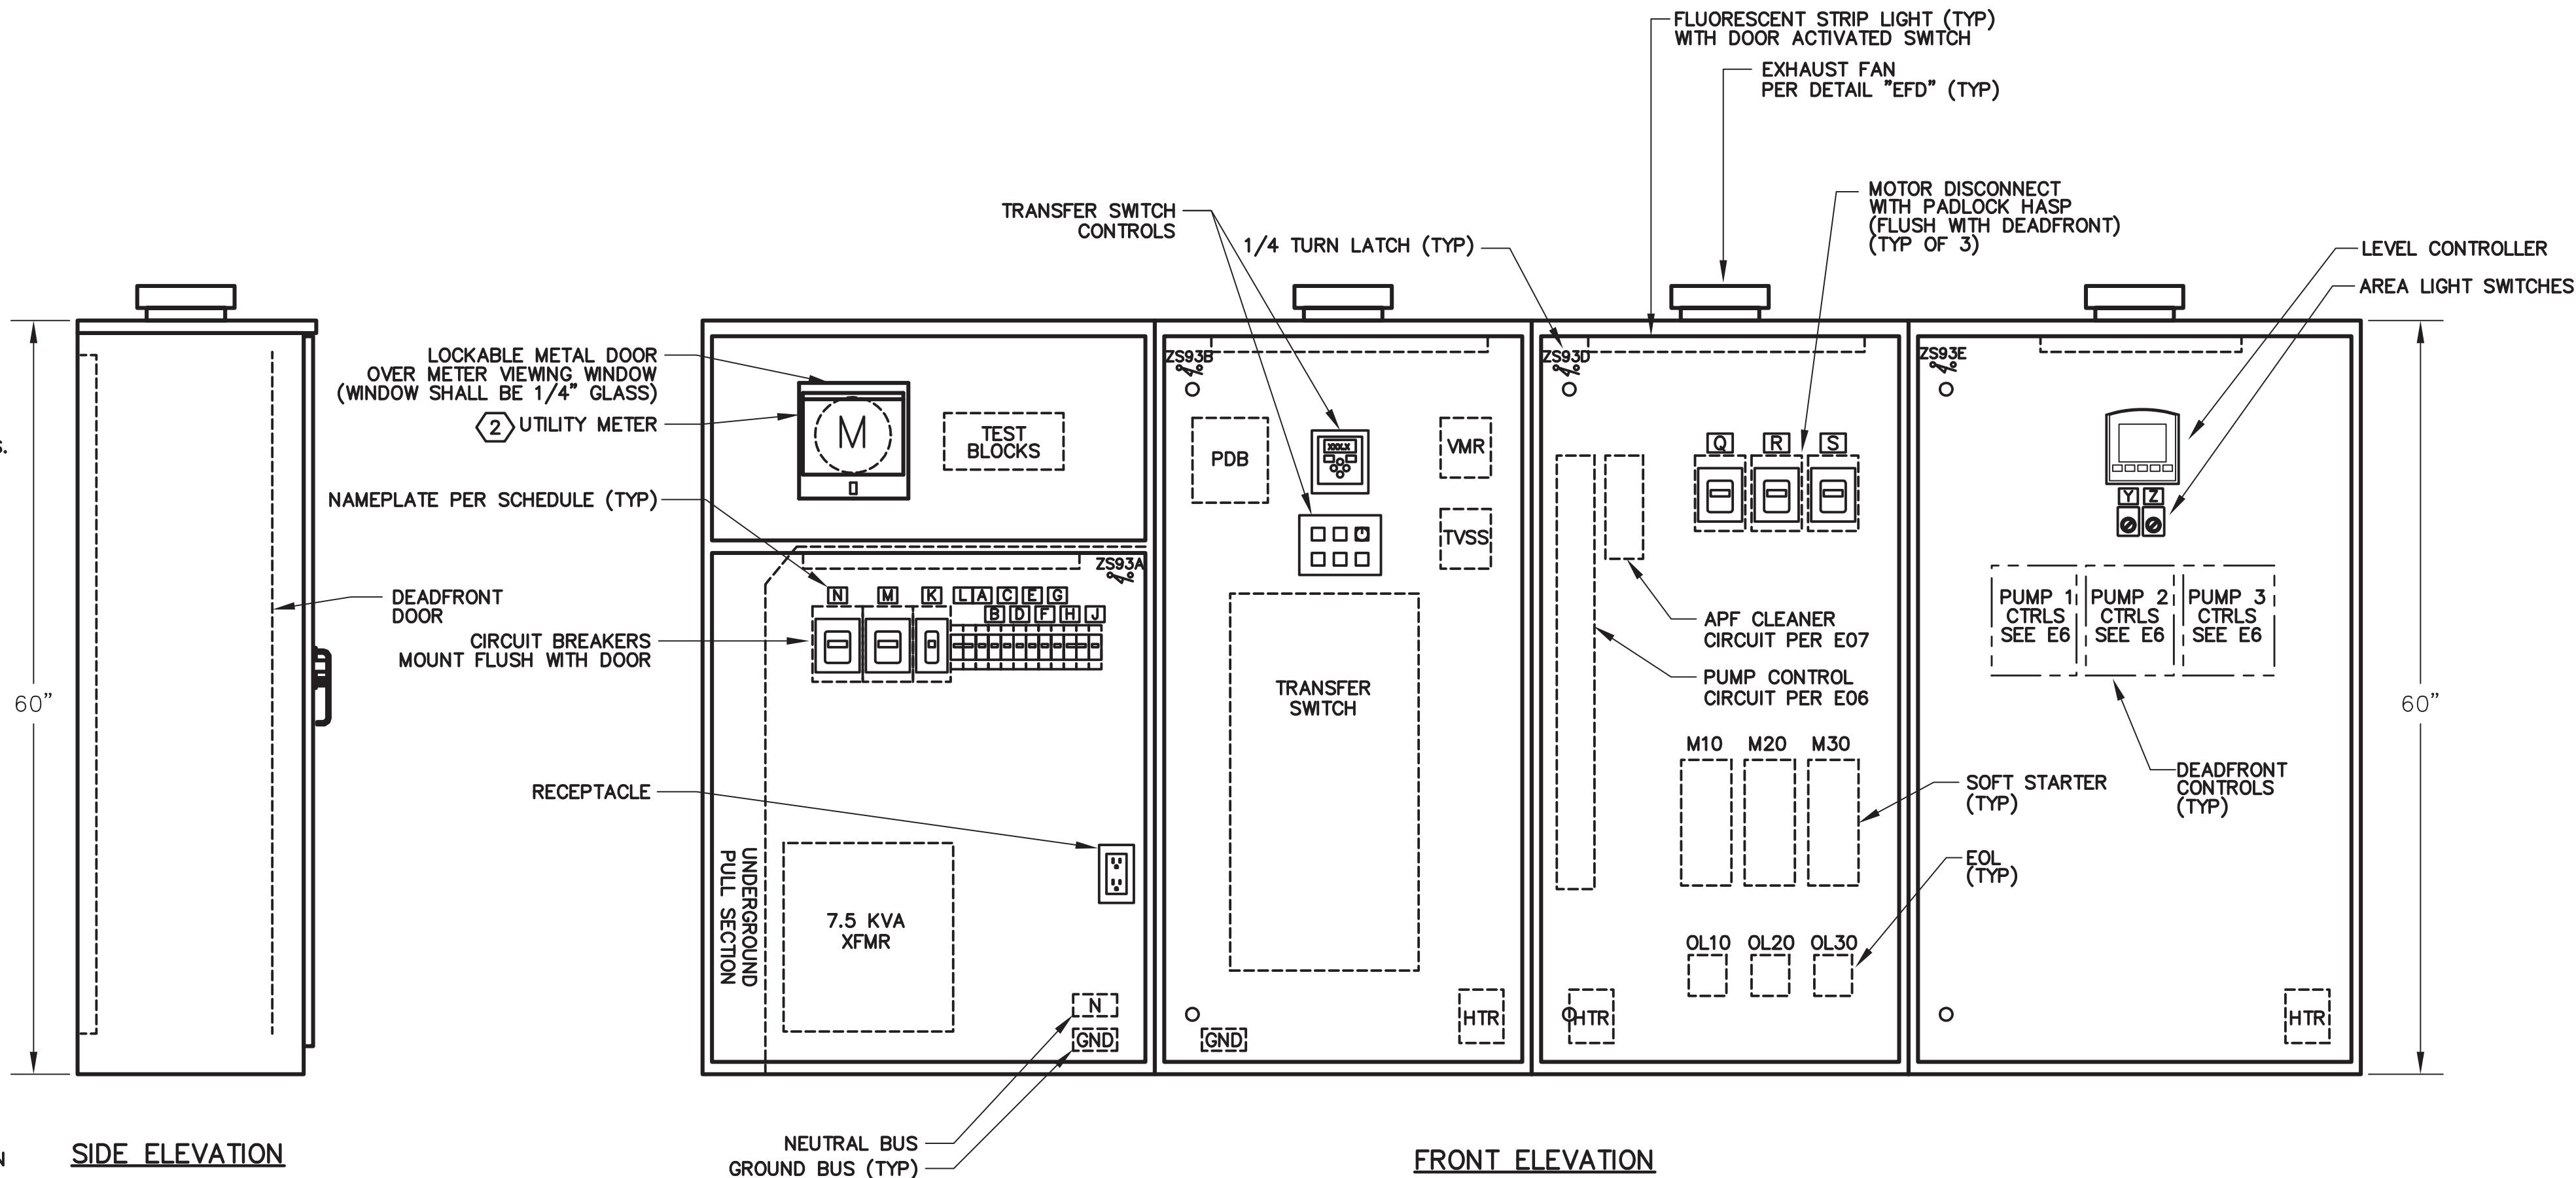


FRONT ELEVATION
OUTER DOORS REMOVED FOR CLARITY

PEDESTAL ELEVATION 1

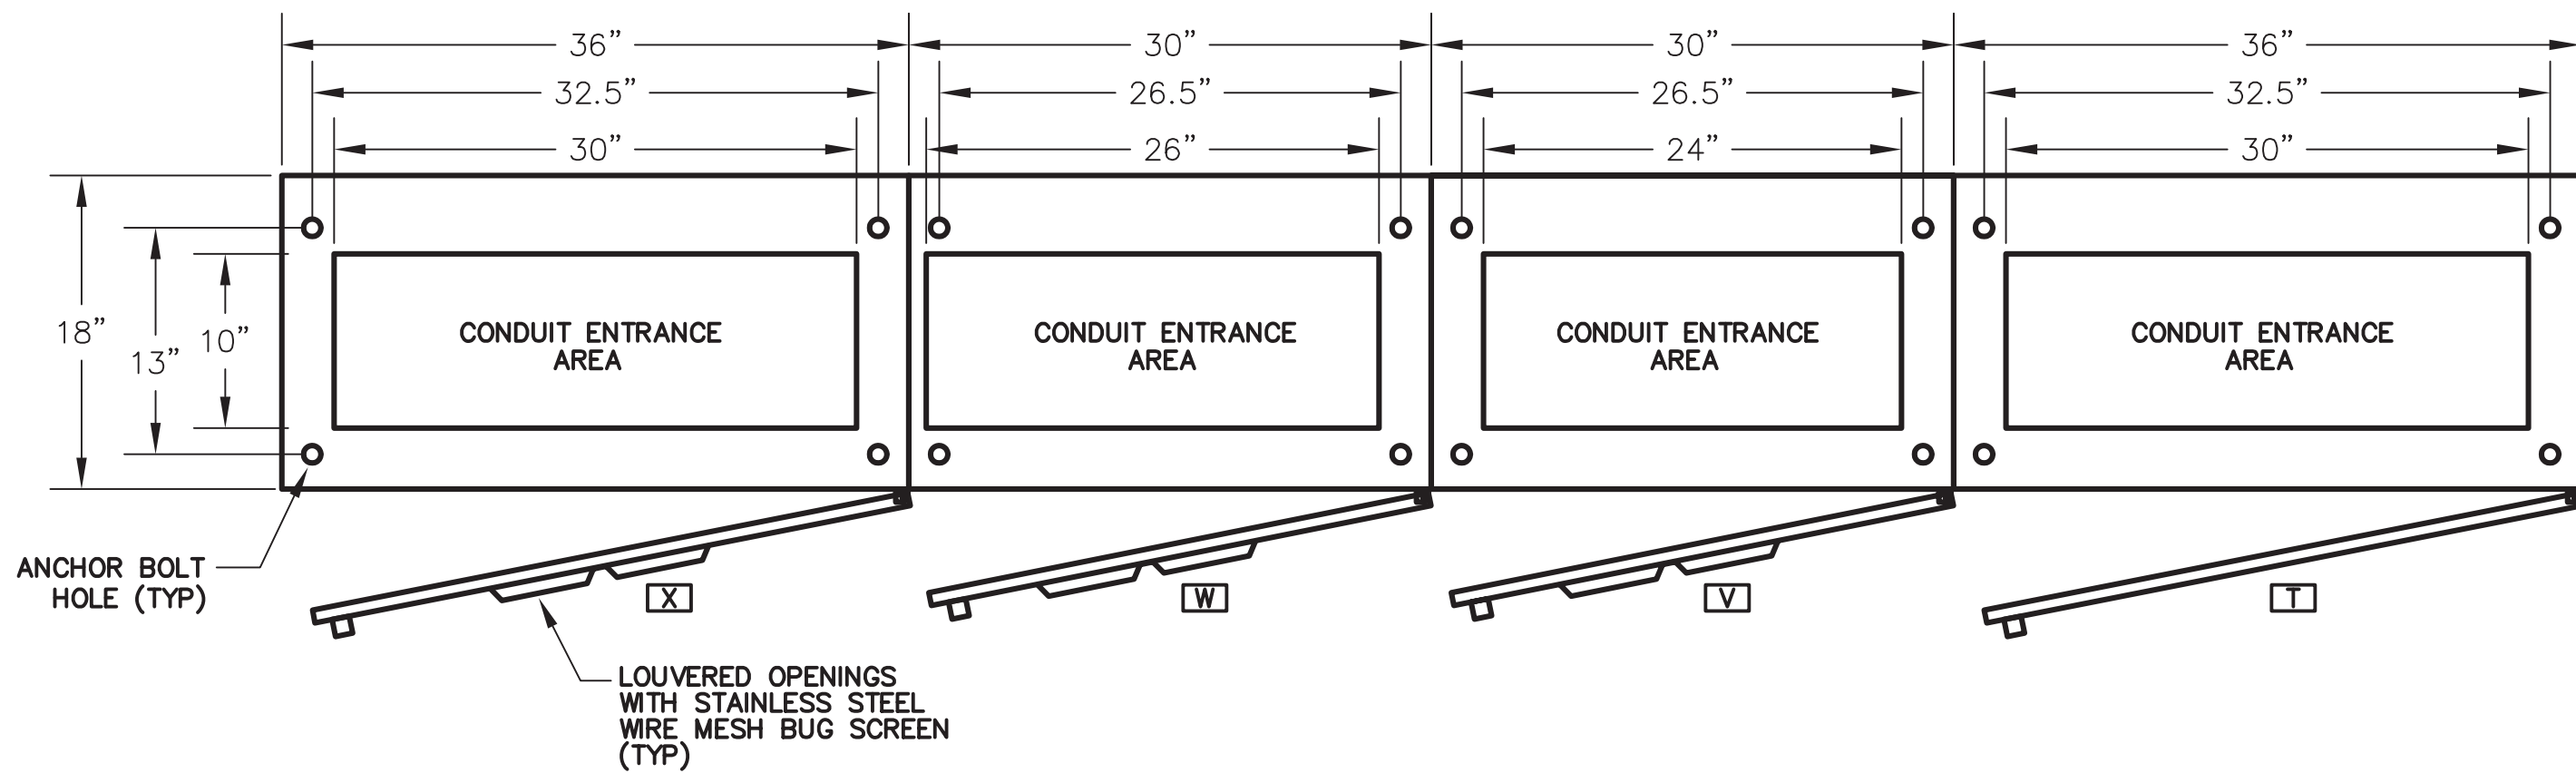

TOP VIEW
PEDESTAL BASE PLAN

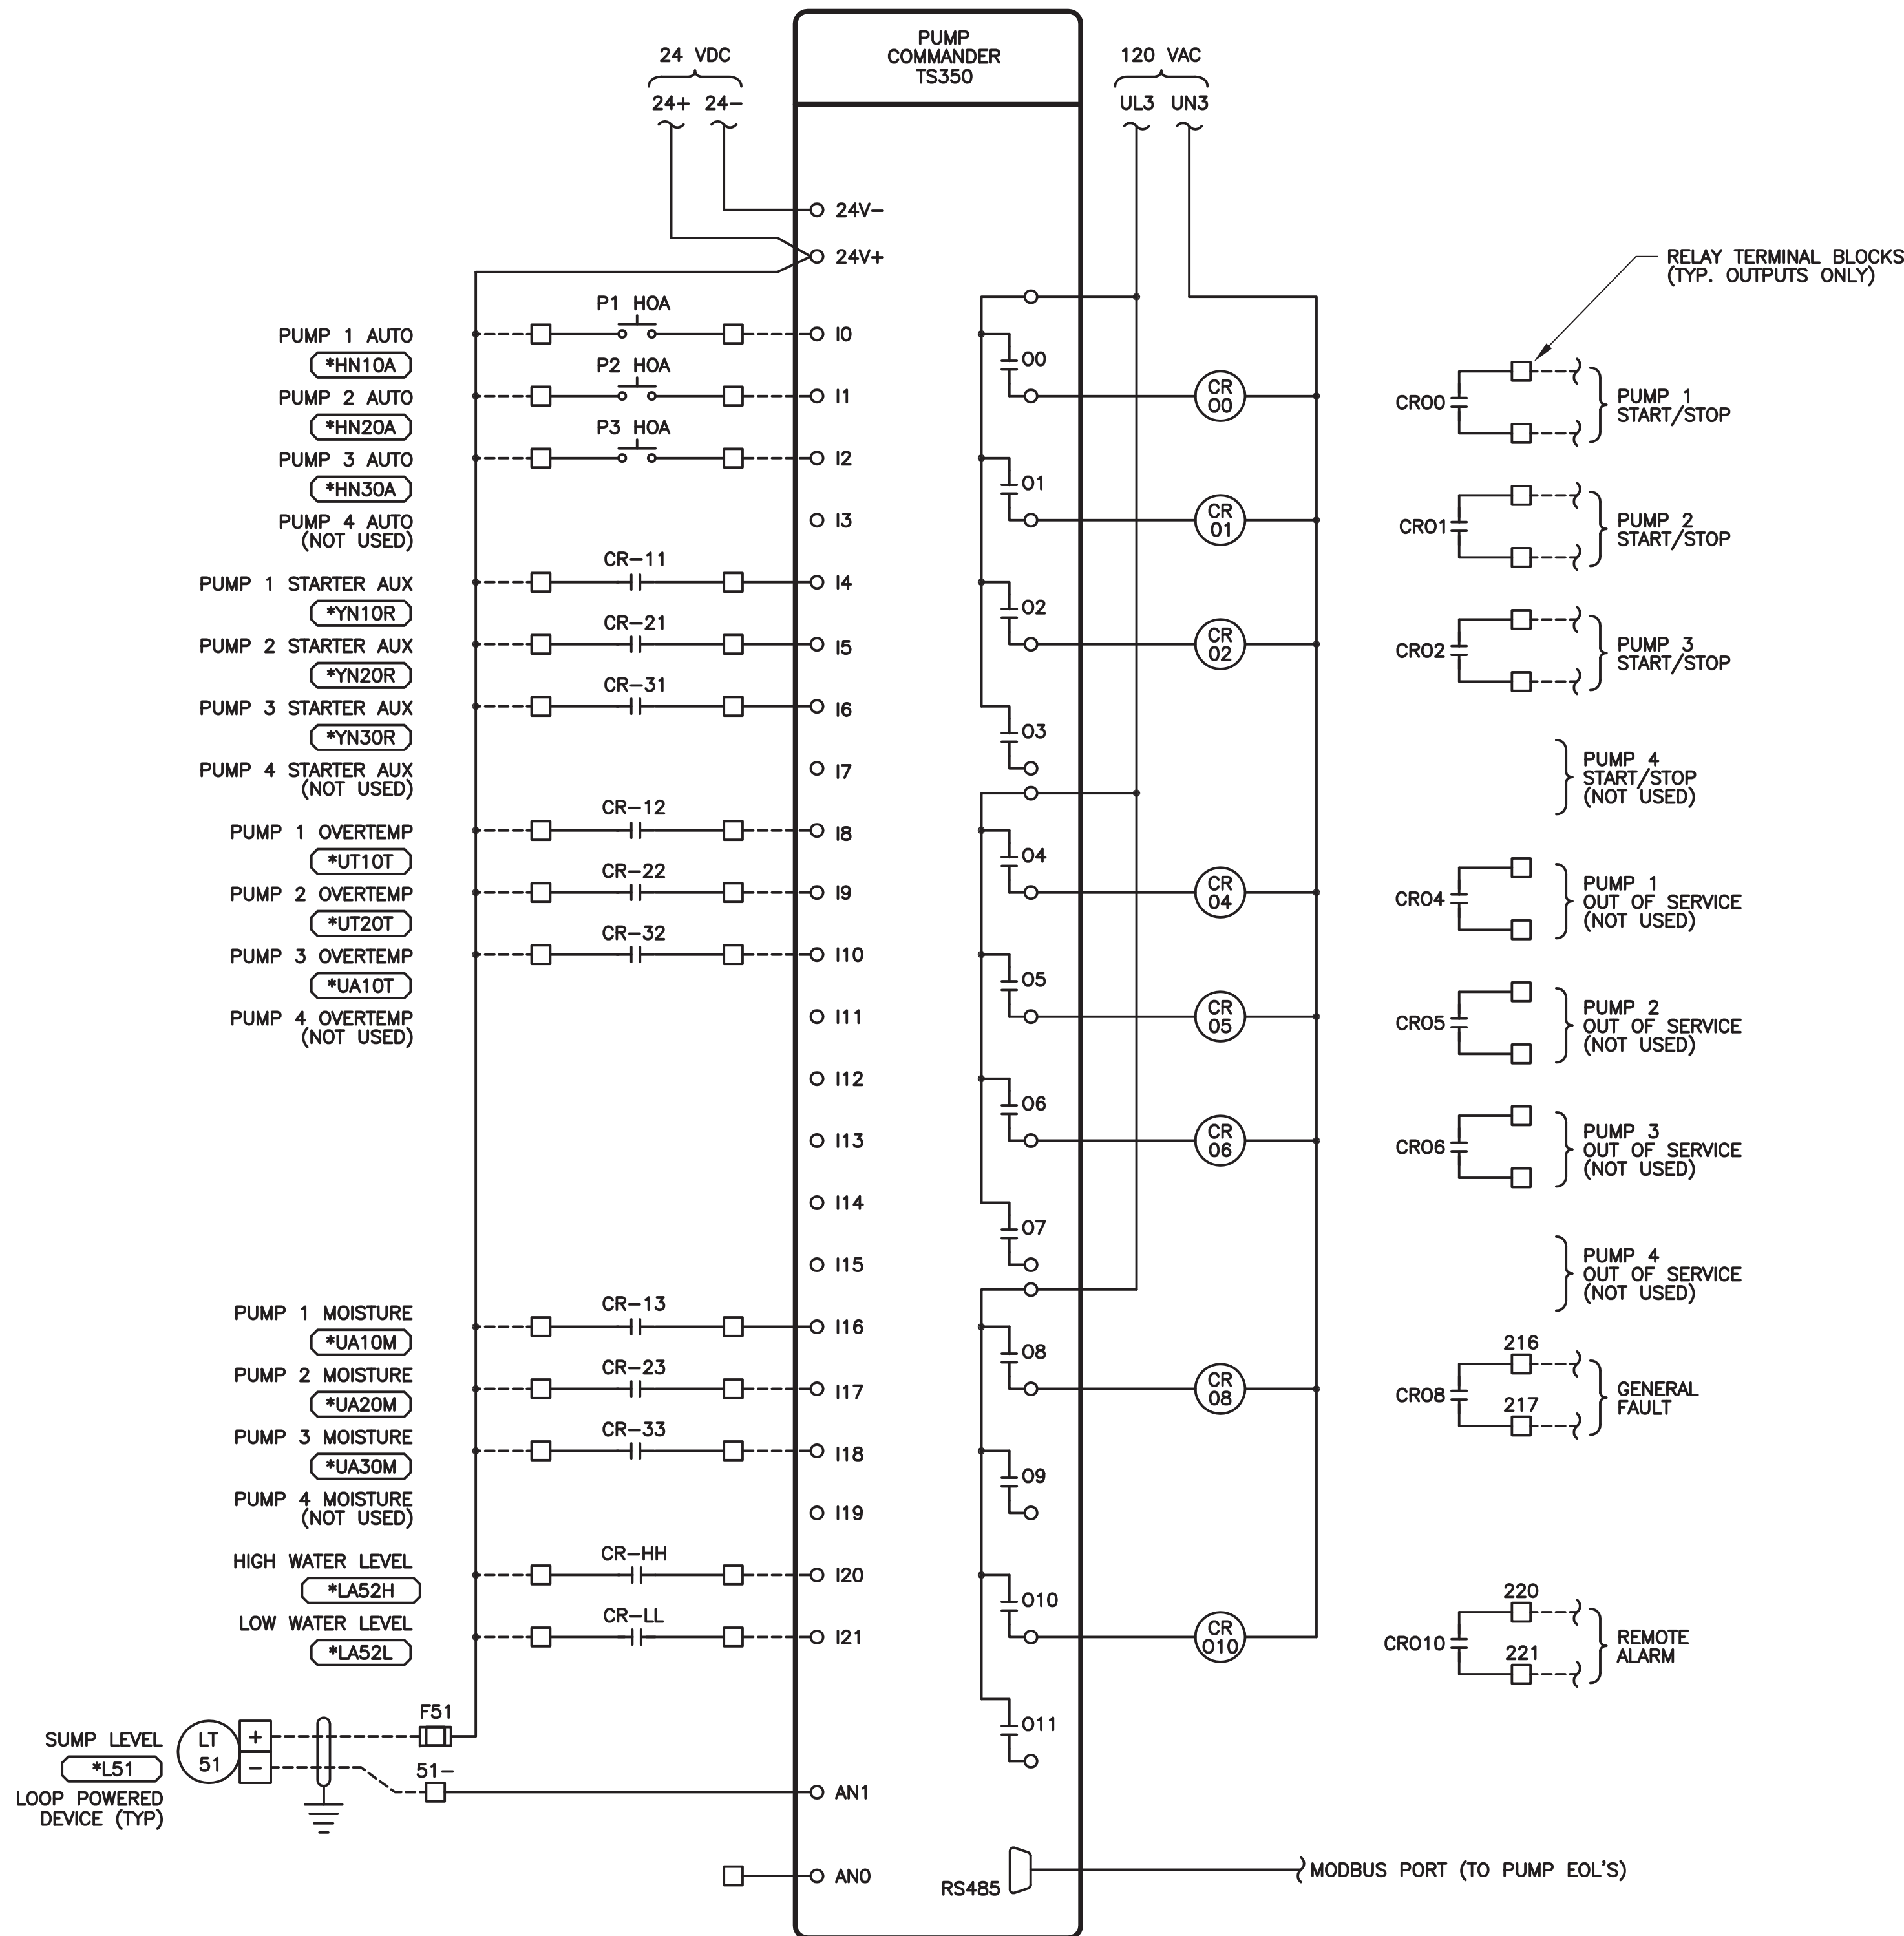

PLC I/O WIRING DIAGRAMS

WATERWORKS
ENGINEERS



CITY OF ALAMEDA
BAY FARM ISLAND PUMP STATION
REHABILITATION PROJECT

ELECTRICAL
PLC WIRING DIAGRAM


VERIFY SCALE
BAR IS ONE INCH ON
ORIGINAL DRAWING.
0 1"
IF NOT ONE INCH ON
THIS SHEET, ADJUST
SCALES ACCORDINGLY.


DESIGN
S PENNER
DRAWN
N CONANT
CHECKED
T FRISCH
APPROVED
M FISHER

DATE
JULY 2011
PROJECT NUMBER
11-005
DRAWING NUMBER
E08
SHEET NUMBER 35



FRISCH ENGINEERING, INC.
CONSULTING ELECTRICAL ENGINEERS
110 BLUE RAVINE RD, SUITE 101
FOLSOM, CA 95630
PH 916 353 1025
FX 916 353 1028

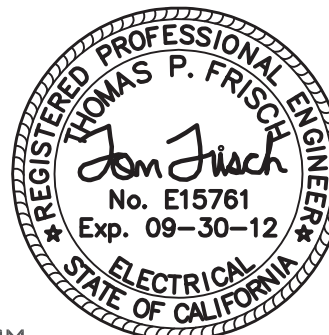

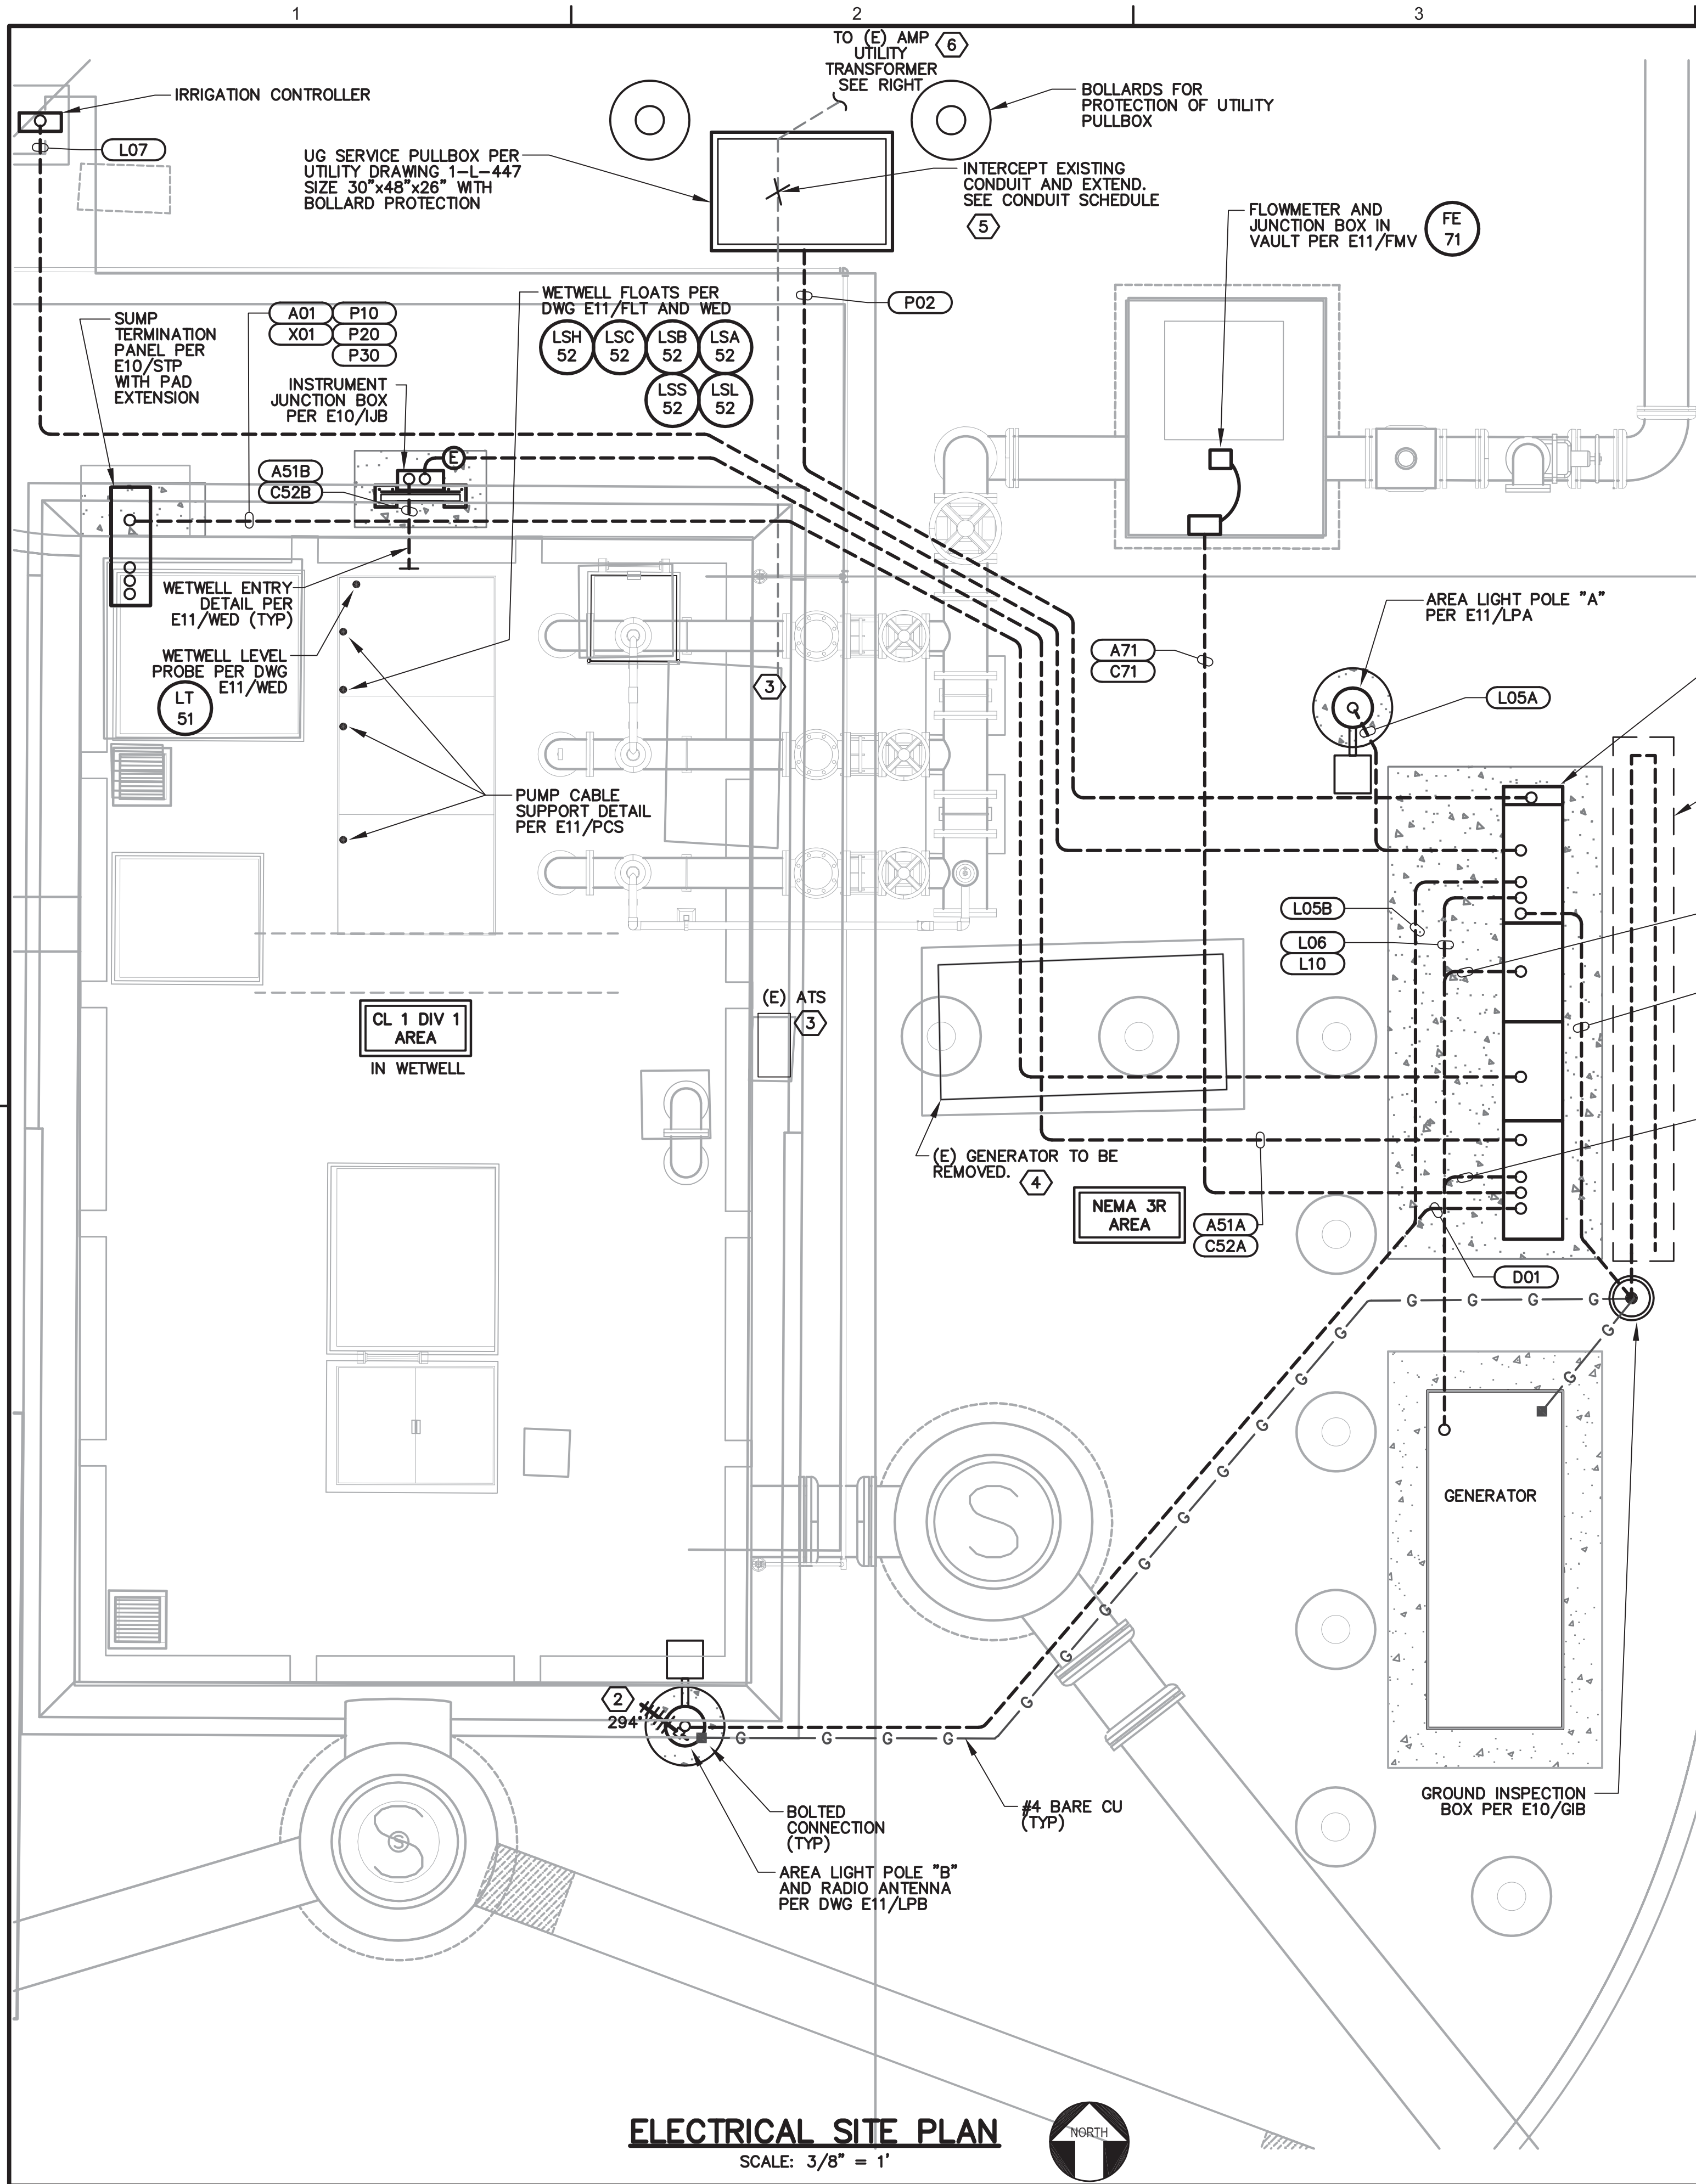

UTILITY SITE PLAN

SCALE: 1" = 30'

ELECTRICAL PLAN NOTES

- UTILITY PRIMARY AND SECONDARY CONDUITS, PULL BOXES SHALL BE INSTALLED PER POWER UTILITY ENGINEERED DRAWINGS AND STANDARDS.
- ASSUME 50 FT OF ADDITIONAL UNDERGROUND RUN BEYOND DRAWING FOR UTILITY CONNECTIONS. CONNECTION POINT SHALL BE AS DETERMINED BY UTILITY COMPANY.
- REPAIR SURFACE TO PREVIOUS CONDITION FOR ALL UNDERGROUND CONDUIT ROUTES. GROUT, CAULK, AND PAINT ANY PENETRATIONS INTO STRUCTURES FOR WATERTIGHT SEAL.
- INSTALL NON-UTILITY CONDUITS PER DRAWING DETAILS AND SPECIFICATIONS SECTION 16110.
- SITEPLAN ACCURATE FOR ELECTRICAL WORK ONLY. COORDINATE ALL WORK WITH CIVIL PLANS.
- EXPOSED CONDUIT TRANSITIONS SHALL BE PER EXPOSED CONDUIT TRANSITION DETAIL E10/ECT.
- INSTALL ALL UNDERGROUND NON-UTILITY CONDUITS PER E10/LVC.
- USE STAINLESS STEEL EXPANSION WEDGE ANCHORS OR EPOXY ANCHORS AS NECESSARY FOR EQUIPMENT MOUNTING.
- FITTINGS, CONDULETS, BOXES AND COVERS SHALL MATCH DUTY OF ADJACENT PIPE, SEE SPECIFICATIONS 16110.
- SEE ELECTRICAL SYMBOLS AND ABBREVIATIONS DRAWING FOR SYMBOL DEFINITION.
- STUB UP CONDUITS BENEATH GENERATOR FRAME PER MANUFACTURER RECOMMENDATIONS. USE FLEXIBLE CONDUIT FOR TRANSITION BETWEEN EXPOSED CONDUIT TRANSITION AND ELECTRICAL CONNECTION BOX AND GENERATOR CONTROL PANEL.

DRAWING REFERENCED NOTES:

- UFER GROUND SHALL CONSIST OF 25 FT OF #2 WIRE CENTERED IN 6"H X 9"W X 13'L CONCRETE STRIP. LOCATE STRIP AT 36" NOMINAL DEPTH WITH NATIVE BACKFILL ONLY. NO SAND AND NO ROCKS. LOOP CONDUCTOR TO FIT WITHIN CONCRETE STRIP. MAINTAIN 3" MINIMUM COVER OVER ALL PORTIONS OF CONDUCTOR.
- RELOCATE EXISTING ANTENNA AND MOUNT ON NEW POLE UTILIZING NEW HARDWARE. ANTENNA TRAJECTORY SHOWN IS MEASURED CW FROM MAGNETIC NORTH.
- REMOVE EXISTING CONTROL PANEL, AREA LIGHT, ATS, WIRE, AND CONDUIT. CUT CONDUIT FLUSH WITH CONCRETE WET WELL, CAP AND/OR FILL WITH CONCRETE. REMOVE AND RELOCATE EXISTING MOSCAD SYSTEM TO NEW CONTROL PANEL. DELIVER OLD CONTROL PANEL TO CITY YARD UPON REMOVAL.
- REMOVE EXISTING GENERATOR, WIRE, AND CONDUIT. DELIVER GENERATOR TO CITY YARD UPON REMOVAL.
- INTERCEPT EXISTING UTILITY FEED CONDUIT AND TEE SPLICE NEW PEDESTAL IN PARALLEL WITH EXISTING CONTROL PANEL DURING CONSTRUCTION. COORDINATE WITH UTILITY FOR SHUTDOWN AND CONNECTION. REMOVE SPLICE WITH EXISTING CONTROL PANEL AFTER TESTING IS COMPLETE.
- FURNISH SUFFICIENT CONDUCTOR TO REACH UTILITY TRANSFORMER (L-952) ACROSS STREET AND LEAVE CONDUCTOR IN PULLBOX FOR CONNECTION BY UTILITY. DISTANCE FROM PULLBOX TO TRANSFORMER IS 120 FT.

CONDUIT & WIRE ROUTING SCHEDULE												
REV	CONDUIT DETAILS			TO	QTY	SIZE	TYPE	POWER WIRE	CONTROL WIRE	GROUND	NOTES	
	TAG NO.	FROM	SIZE					QTY	SIZE			QTY
	A01	PEDESTAL		SUMP TERMINATION PANEL	1	1-1/2"	PVC-40	-	-	3 #16 TSPR	#12	
	A51A	PEDESTAL		INSTRUMENT JUNCTION BOX	1	1"	PVC-40	-	-	1 #16 TSPR	#12	
	A51B	INSTRUMENT JUNCTION BOX		WET WELL LT-51	1	1"	PVC-40	-	-	1 MFG CABLE	-	
	A71	PEDESTAL		FLOWMETER	1	1"	PVC-40	-	-	1 MFG CABLE	#8	
	C03	PEDESTAL		GENERATOR	1	3/4"	PVC-40	-	-	8 #14	#14	COIL SPARE CONDUCTORS
	C04	PEDESTAL		GENERATOR	1	3/4"	PVC-40	-	-	8 #14	#14	COIL SPARE CONDUCTORS
	C52A	PEDESTAL		INSTRUMENT JUNCTION BOX	1	1"	PVC-40	-	-	12 #14	#12	
	C52B	INSTRUMENT JUNCTION BOX		WET WELL FLOAT SWITCHES	1	2"	PVC-40	-	-	6 MFG CABLE	-	FLOATS
	C71	PEDESTAL		FLOWMETER	1	3/4"	PVC-40	-	-	6 #14	#12	
	D01	PEDESTAL		ANTENNA	1	2"	PVC-40	-	-	1 ANTENNA CABLE	-	
	G01	PEDESTAL		GROUND INSPECTION BOX	1	1"	PVC-40	-	-	-	#2	
	P02	UTILITY TRANSFORMER		PEDESTAL	1	3"	PVC-40	3 #3/0	-	-	#6	VIA PULLBOX
	P03	GENERATOR		PEDESTAL	1	3"	PVC-40	3 #3/0	-	-	#6	+ #1 NEUTRAL
	P10	PEDESTAL		SEWAGE PUMP 1	1	1-1/2"	PVC-40	3 #8	6 #14	#8	#8	VIA SUMP TERMINATION PANEL
	P20	PEDESTAL		SEWAGE PUMP 2	1	1-1/2"	PVC-40	3 #8	6 #14	#8	#8	VIA SUMP TERMINATION PANEL
	P30	PEDESTAL		SEWAGE PUMP 3	1	1-1/2"	PVC-40	3 #8	6 #14	#8	#8	VIA SUMP TERMINATION PANEL
	L05A	PEDESTAL		AREA POLE LIGHT A	1	3/4"	PVC-40	-	-	5 #12	#12	
	L05B	PEDESTAL		AREA POLE LIGHT B	1	3/4"	PVC-40	-	-	5 #12	#12	
	L06	PEDESTAL		GENERATOR HEATER	1	3/4"	PVC-40	3 #12	-	-	#12	
	L07	PEDESTAL		IRRIGATION CONTROLLER	1	3/4"	PVC-40	2 #12	-	-	#12	
	L10	PEDESTAL		GENERATOR BATT CHGR	1	3/4"	PVC-40	2 #12	-	-	#12	
	X01	PEDESTAL		SUMP TERMINATION PANEL	1	1"	PVC-40	-	-	-	-	PULL ROPE

NOTES PERTAINING TO CONDUIT SCHEDULE:

- CONDUIT TYPE IS TYPICAL FOR UNDERGROUND HORIZONTAL PORTIONS OF RUN. IF ENTIRE RUN OF CONDUIT IS EXPOSED, THEN TYPE IS AS SHOWN.
- SEE EXPOSED TRANSITION DETAIL OR EQUIPMENT SPECIFIC DETAIL FOR ABOVE GROUND OR EXPOSED PORTIONS OF RUN.
- FITTINGS, CONDULETS, BOXES AND COVERS SHALL MATCH DUTY OF ADJACENT PIPE, SEE SPECIFICATIONS 16110.

FRISCH ENGINEERING, INC.

CONSULTING ELECTRICAL ENGINEERS

110 BLUE RAVINE RD, SUITE 101

FOLSOM, CA 95630

PH 916 353 1025

FX 916 353 1028

FILE: 11020-E09.DWG

DATE: JUL 07, 2011

TIME: 12:58:00PM

DATE

JULY 2011

PROJECT NUMBER

11-005

DRAWING NUMBER

E09

SHEET NUMBER

36

REGISTERED PROFESSIONAL ENGINEER


THOMAS P. FRISCH

No. E15761

Exp. 09-30-12


ELECTRICAL

STATE OF CALIFORNIA

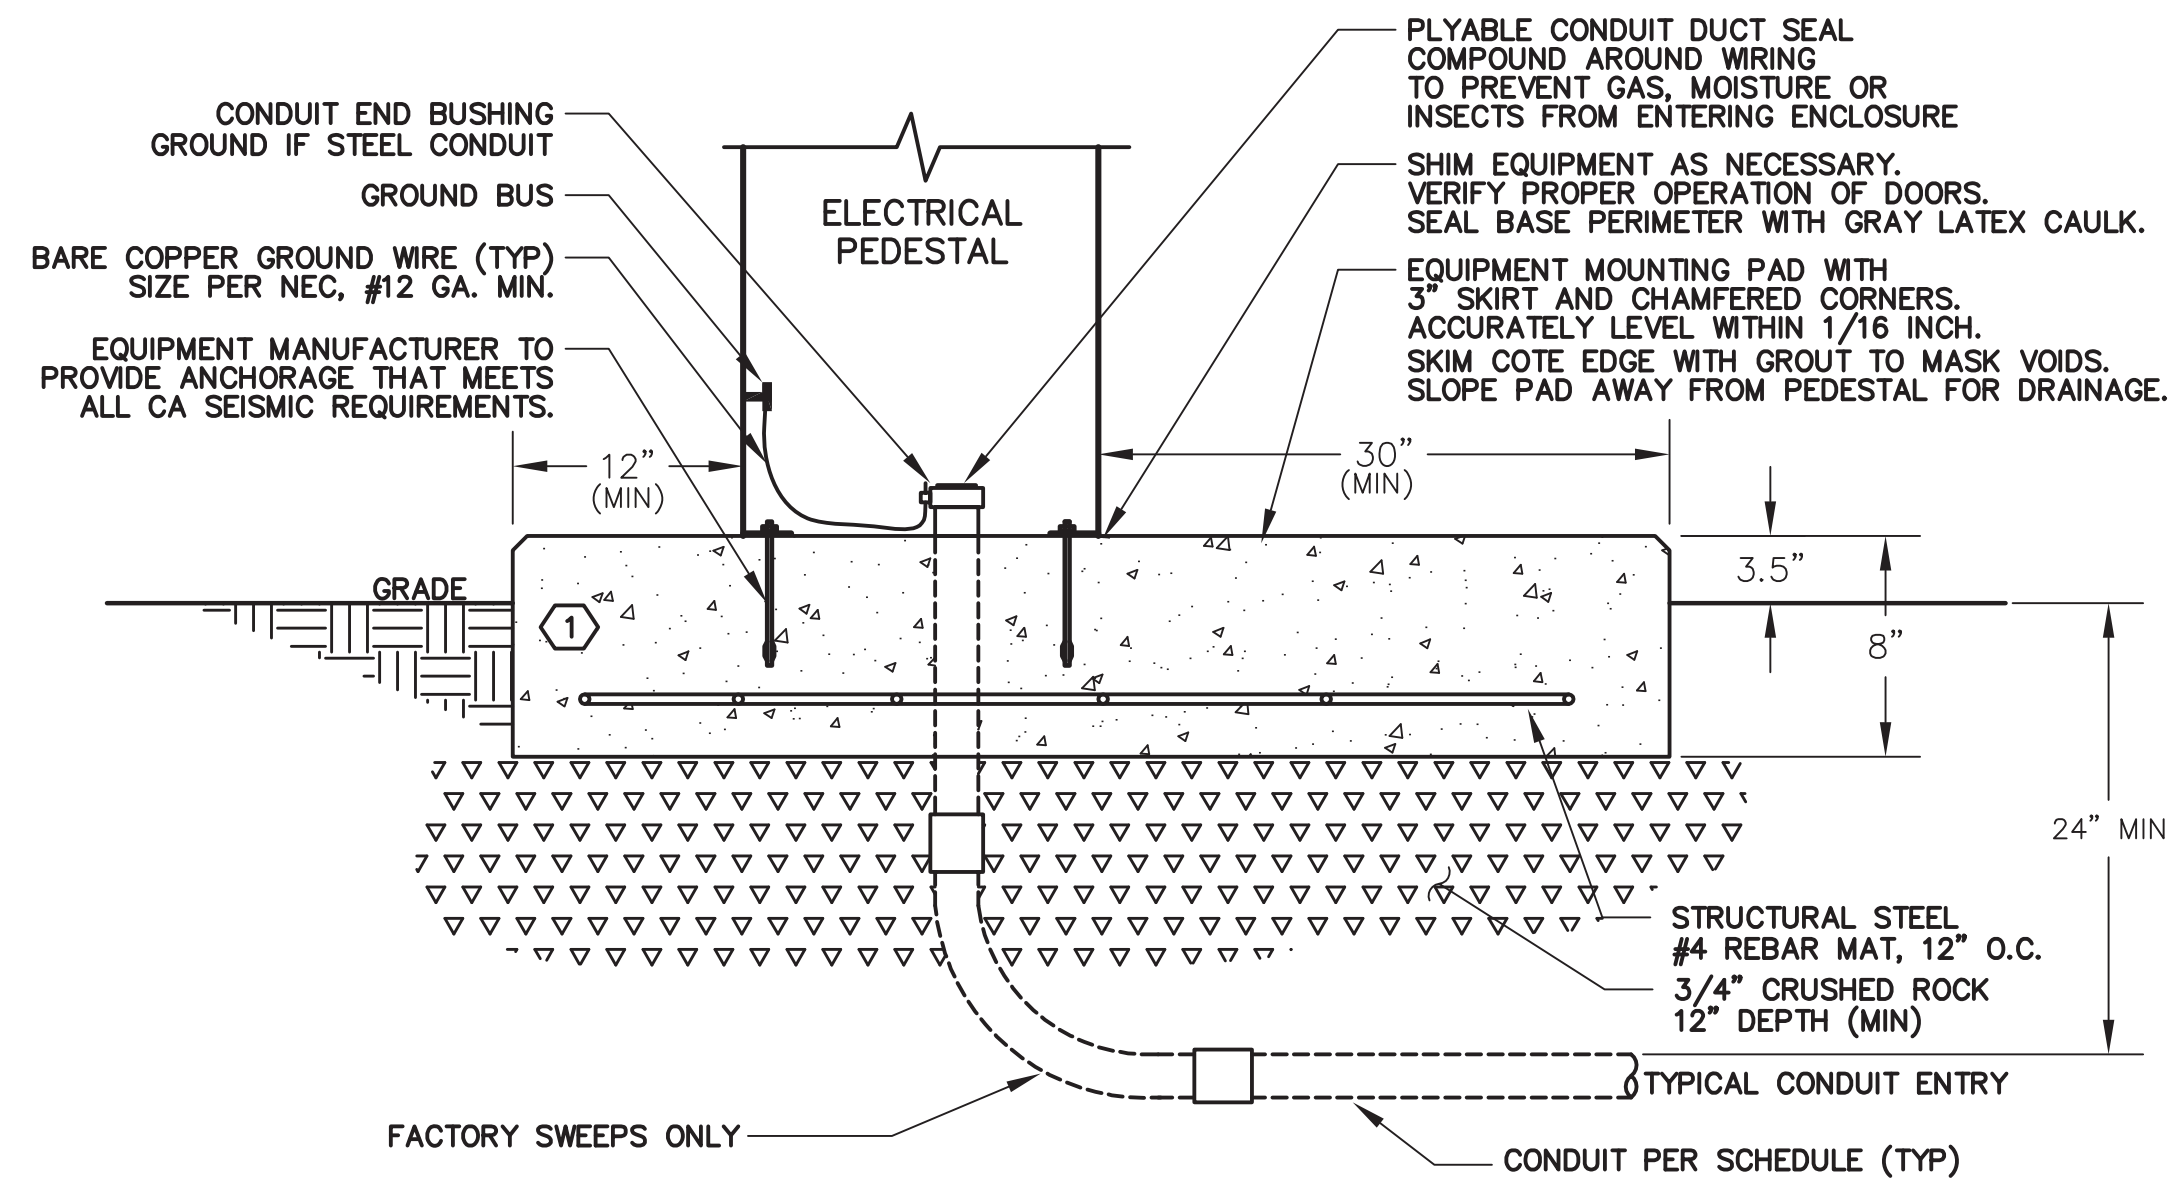


PED
—
NOT TO SCALE

PEDESTAL CONCRETE PAD DETAIL

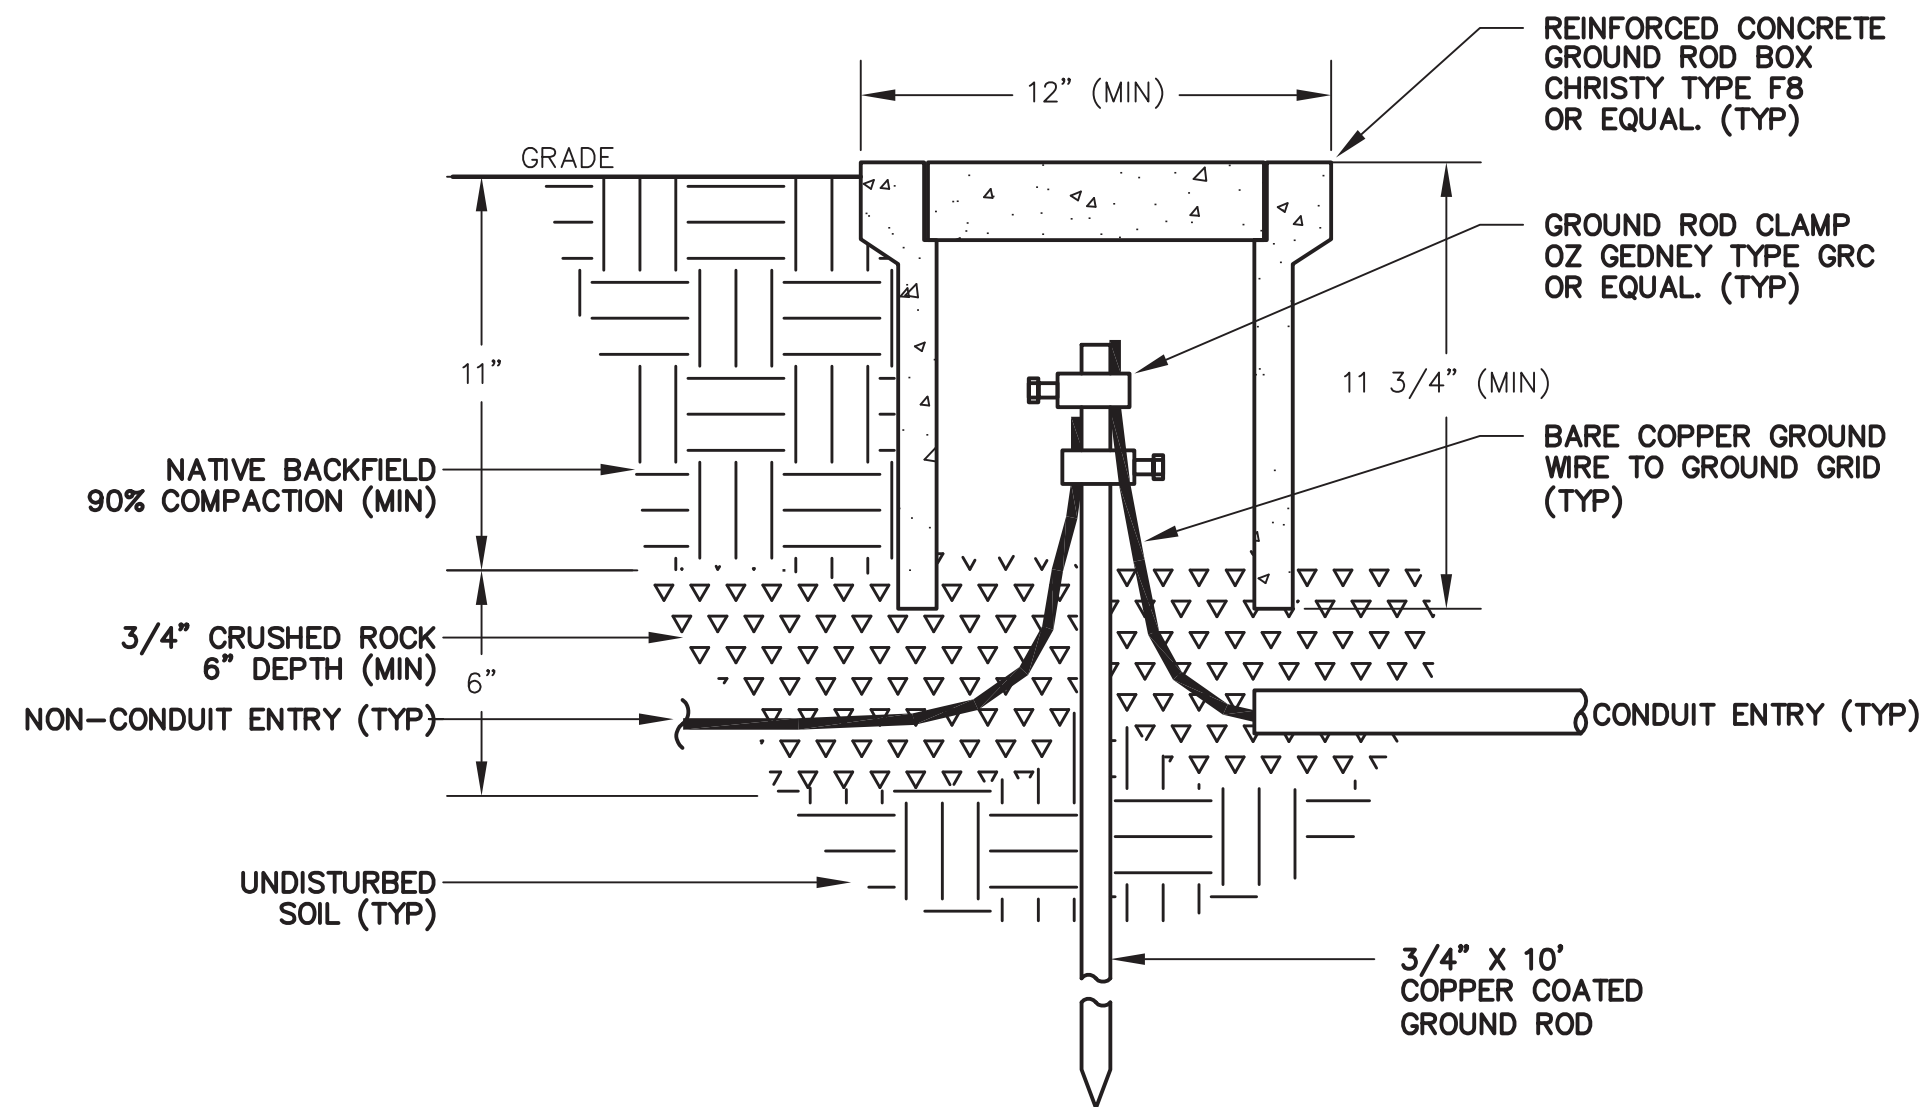

GIB
—
NOT TO SCALE


GROUND INSPECTION BOX DETAIL

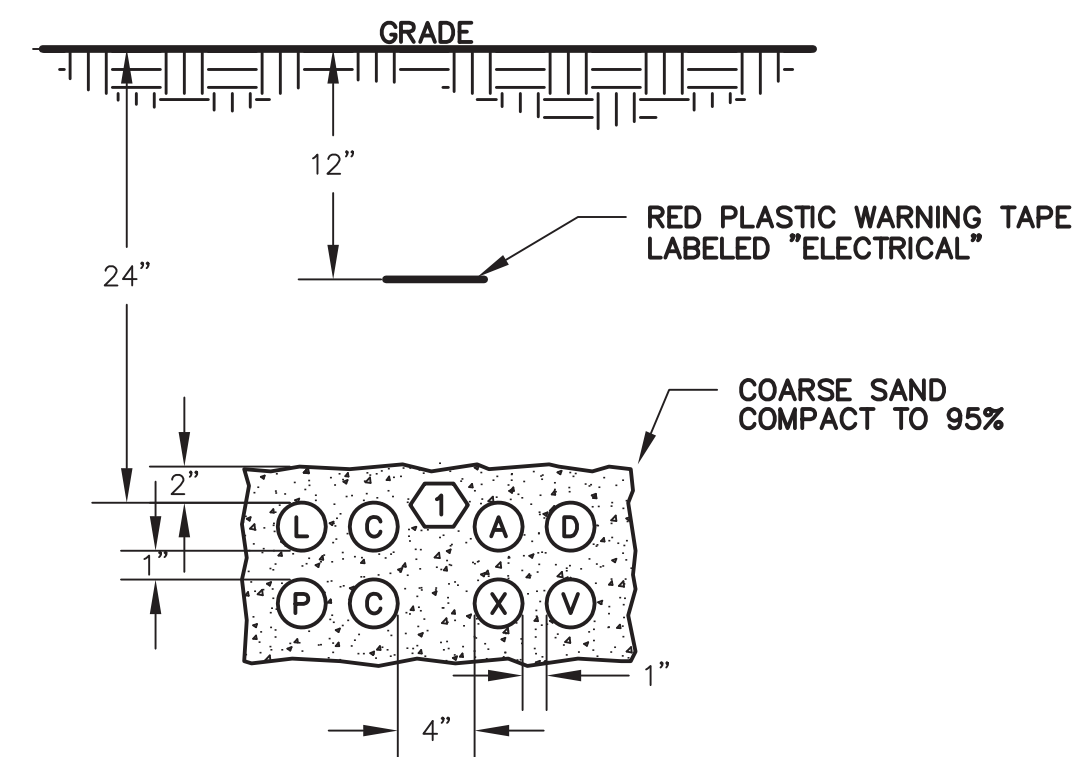

LVC
—
NOT TO SCALE


LOW VOLTAGE NON-DUCT BANK SECTION

- NOTES:
- 1 NUMBER OF CONDUITS PER PLANS AND SCHEDULE. MAXIMUM DEPTH OF TRENCH SHALL BE 42". DESIGN TRENCH DESIGN AND INSTALL TRENCH TO MAINTAIN 6" VERTICAL CLEARANCE AND 12" HORIZONTAL CLEARANCE FROM PIPES.
 - 2 P, L, OR C DESIGNATION FOR POWER OR CONTROL CONDUITS.
 - 3 A, D, V, OR X DESIGNATION FOR COMMUNICATION (TELEPHONE, DATA, VIDEO, OR INSTRUMENTATION) CONDUITS.
 - 4 USE CONDUIT SPACERS TO SUPPORT CONDUITS AND MAINTAIN SPACING (3" INTERVALS)

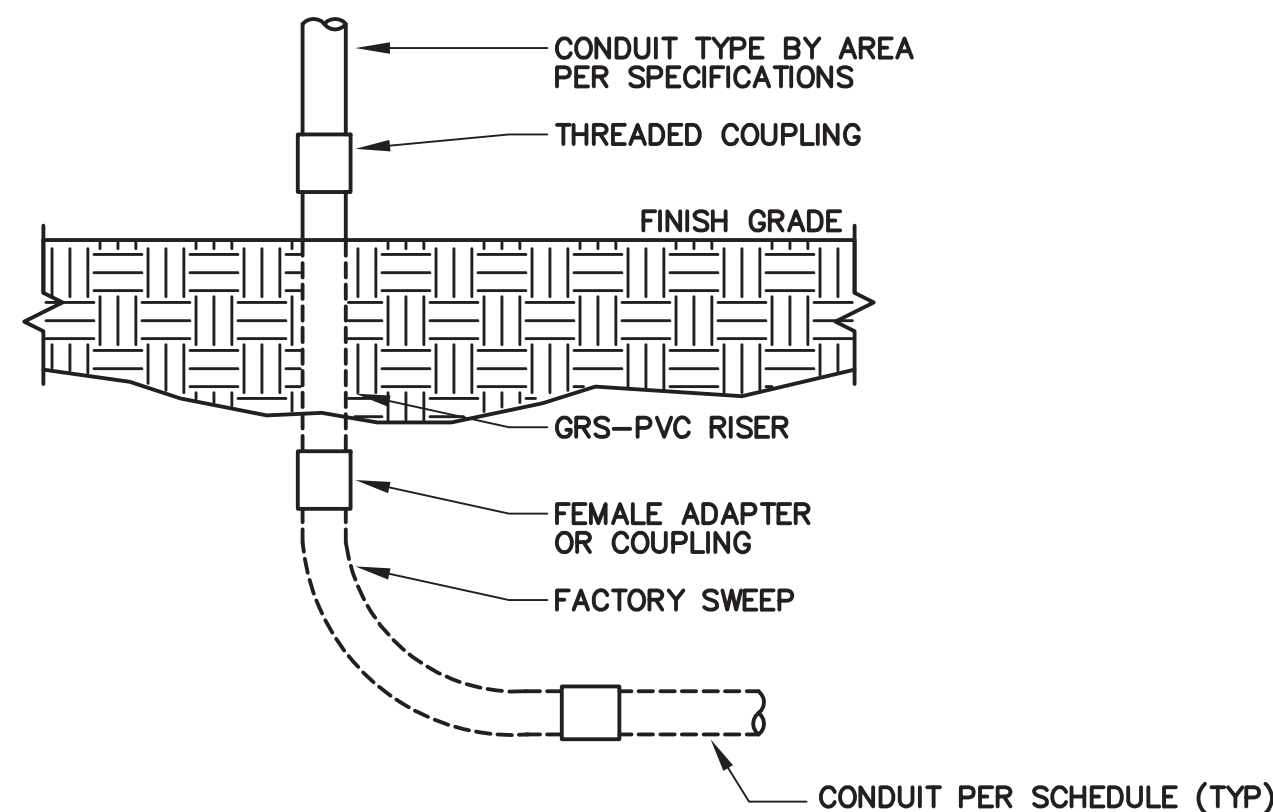

ECT
—
NOT TO SCALE

EXPOSED CONDUIT TRANSITION DETAIL

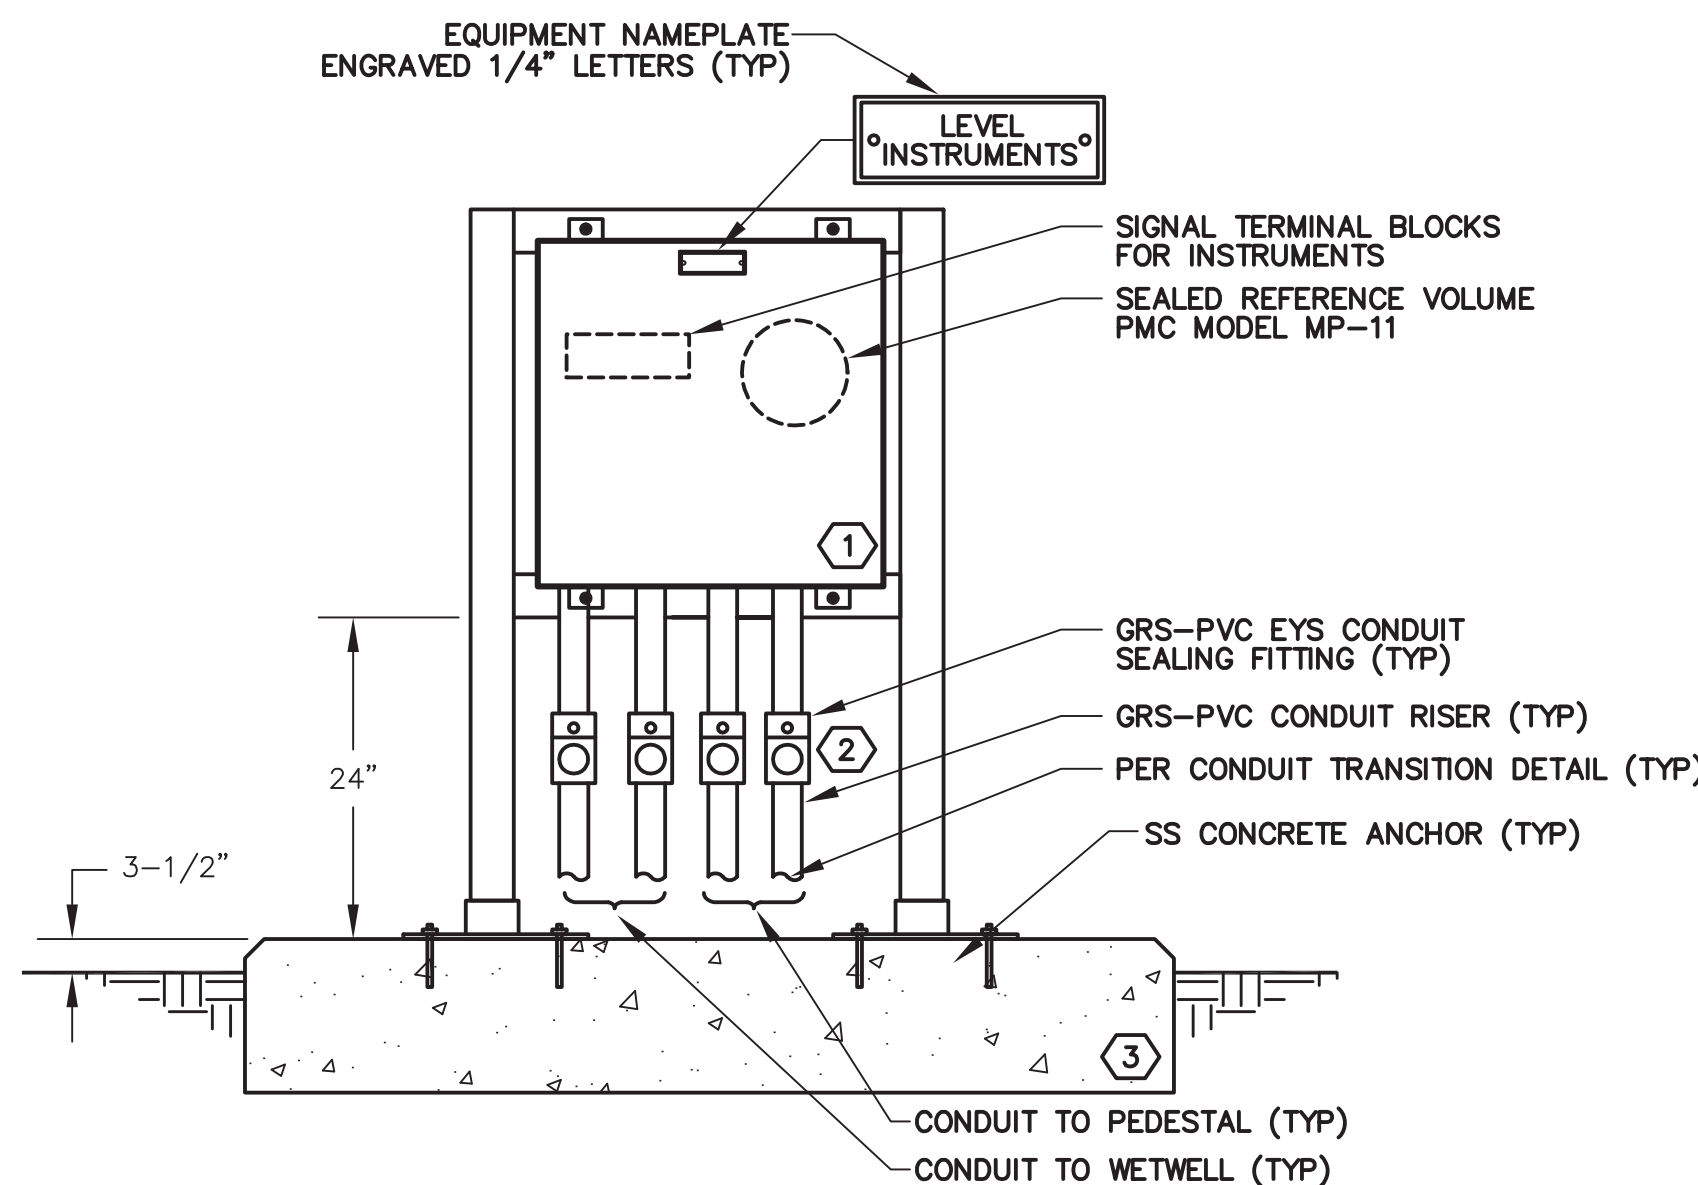


IJB
—
NOT TO SCALE

ELEVATION VIEW
DOOR OF JUNCTION BOX REMOVED FOR CLARITY

INSTRUMENT JUNCTION BOX DETAIL

- NOTES:
- 1 14"H X 16"W X 8"D, NEMA 4X STAINLESS STEEL JUNCTION BOX. JUNCTION BOX SHALL BE HOFFMAN CHNFS OR EQUAL. PROVIDE BACKPAN AND PADLOCK HASP. MOUNT BOX ON STAINLESS STEEL UNISTRUT SUPPORT. USE ALL STAINLESS STEEL HARDWARE.
 - 2 FILL EYS WITH "CHICO" TO PEDESTAL ONLY. OTHERS SHALL BE FILLED WITH "DUCT SEAL". CONDUIT BEHIND EYS SHALL BE GRS-PVC FOR 2 FT. (MIN) WITH GRS-PVC FACTORY SWEEPS.
 - 3 2' X 3' X 6" CONCRETE PAD WITH CHAMFERED CORNERS.

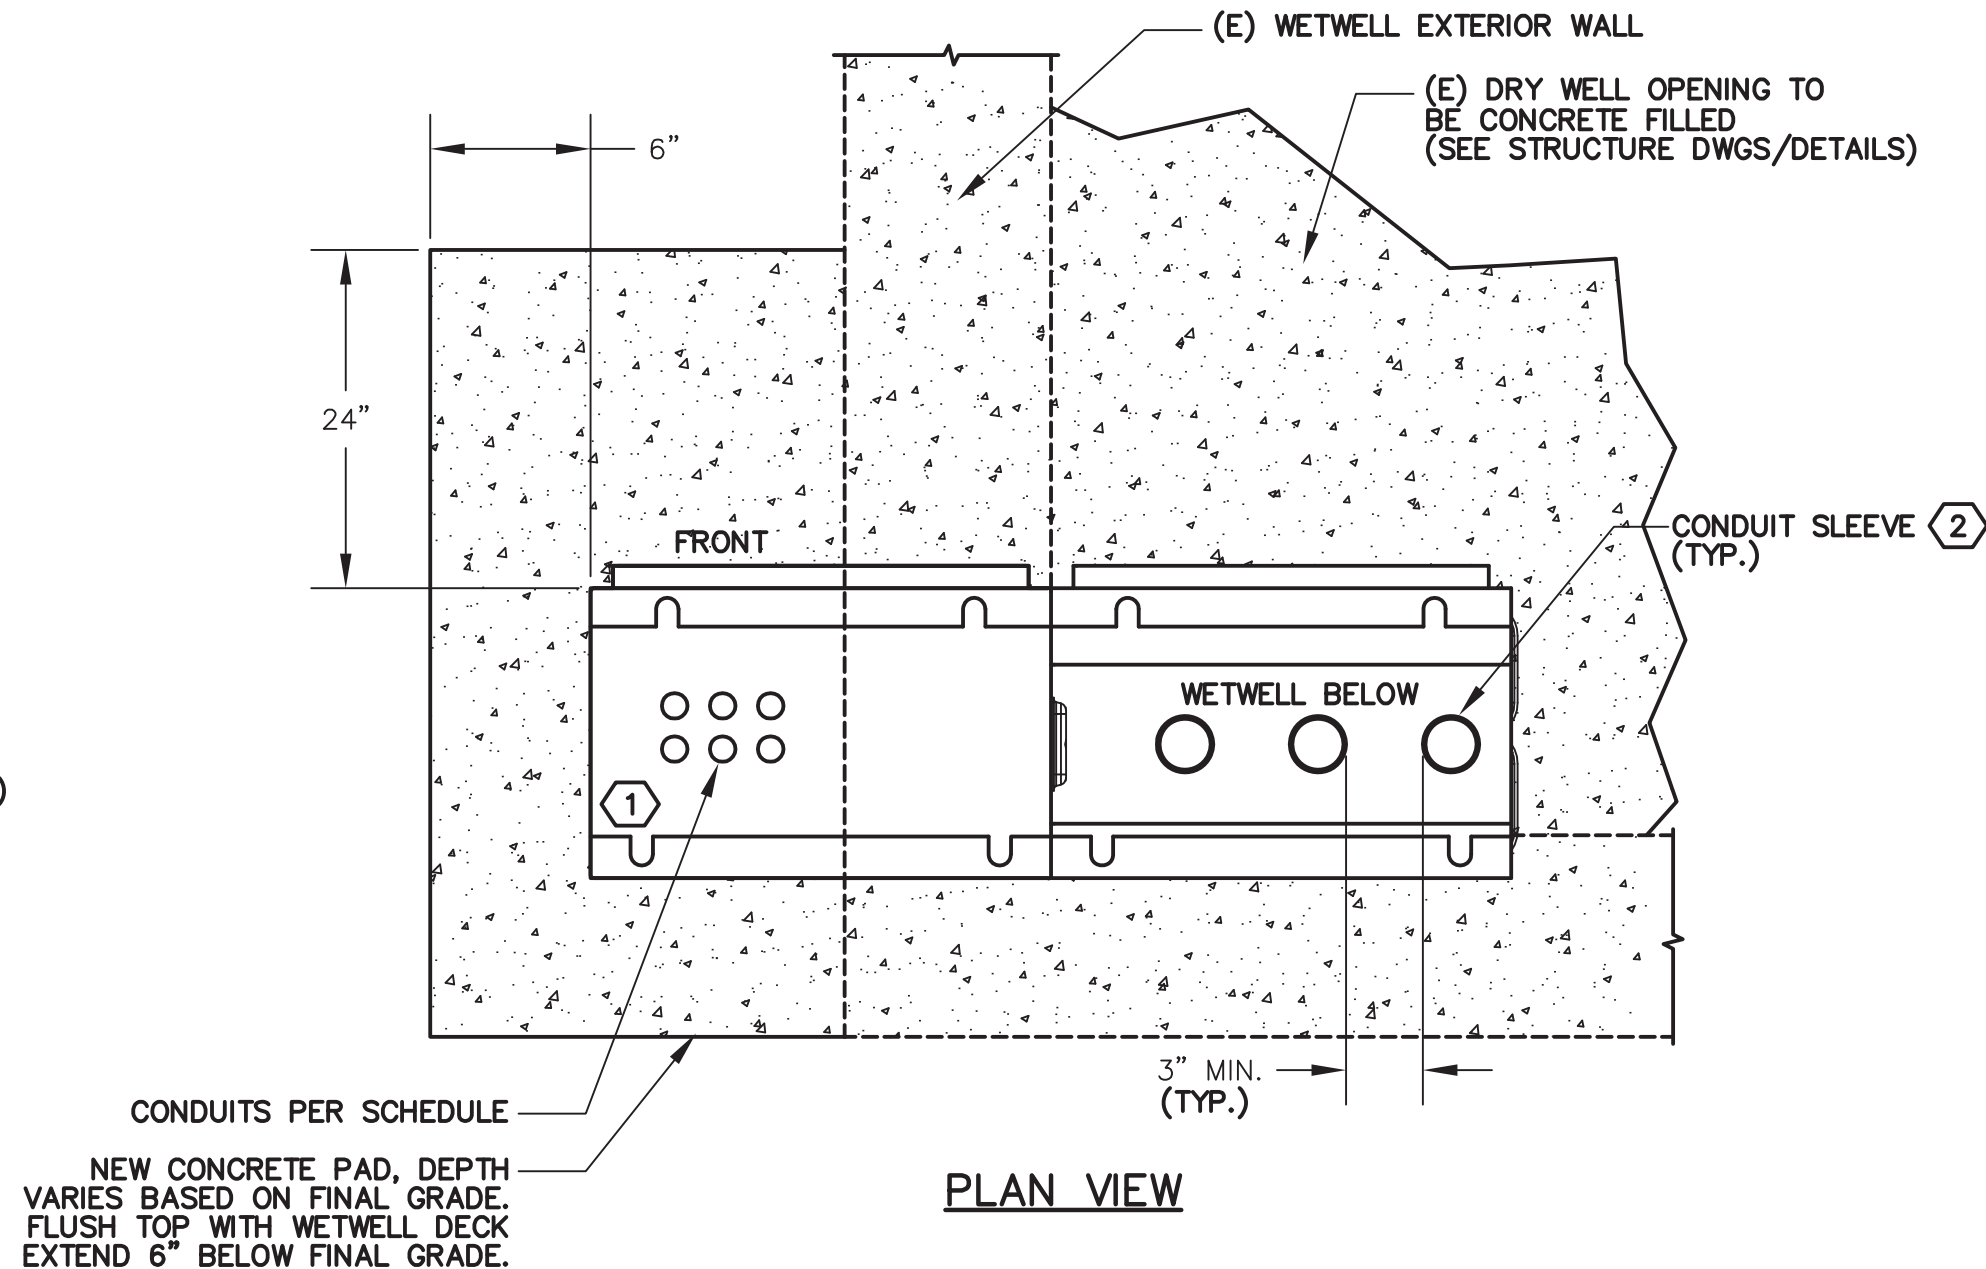






STP
—
NOT TO SCALE

SUMP TERMINATION PANEL DETAIL





- NOTES:
- 1 ORIENT PANEL SO THAT CONDUIT AND SLEEVES EXTEND WITHIN PANEL AS SHOWN. PROVIDE NEMA 3RX, STAINLESS STEEL SUMP TERMINATION PANEL, TESCO CONTROLS, INC. No. S-3630STP OR EQUAL.
 - 2 INSTALL 2" CONDUIT SLEEVE WITH FLUSH BELL ENDS IN CONCRETE DURING POUR. SLEEVE SHALL BE PERPENDICULAR TO WET WELL DECK. EXTEND MOTOR LEADS THROUGH SLEEVES, COIL EXCESS CABLE AND ZIP TIE LOOPS TO KEEP FROM FALLING BACK. SEE ALSO DETAIL E11/PCS.
 - 3 PANEL SHALL BE MOUNTED, SEALED, ETC. SIMILAR TO DETAIL E10/PED.





FLOAT SWITCH	DESCRIPTION	ELEVATION
LSH	HIGH LEVEL ALARM	-7.26
LSC	LAG LAG PUMP START	-7.62
LSB	LAG PUMP START	-7.85
LSA	LEAD PUMP START	-8.35
LSS	ALL PUMPS OFF	-10.12
LSL	LOW LEVEL ALARM	-10.87

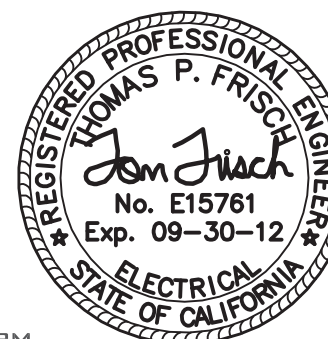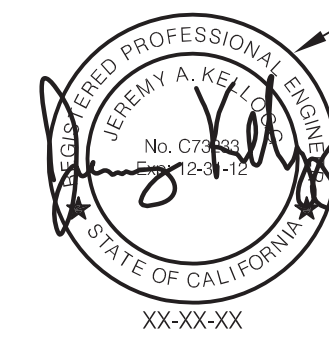
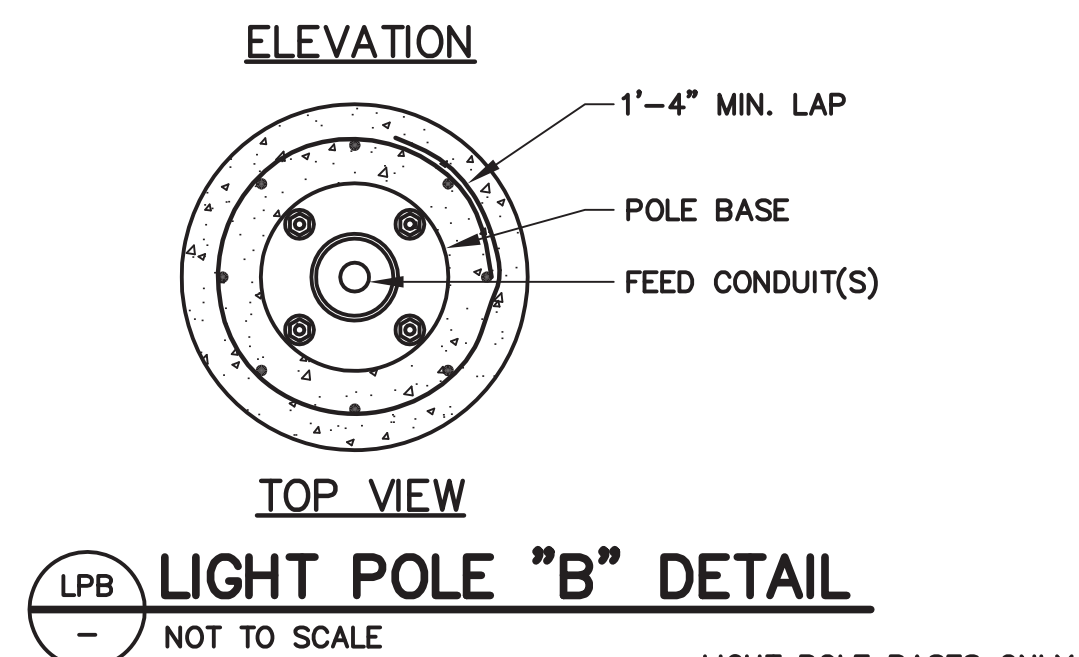
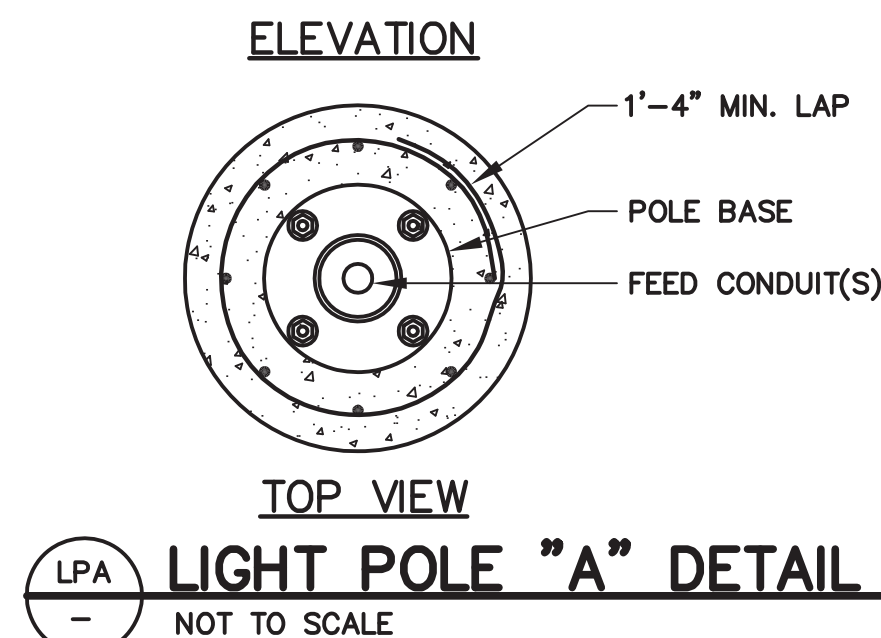
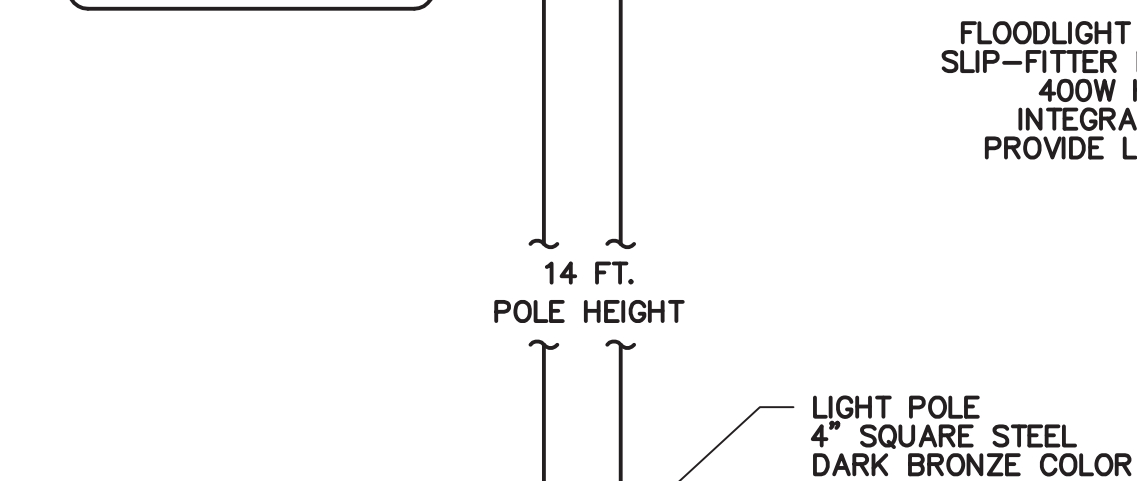


NOTES: 1 CUSTOM MANUFACTURED J-HOOK ASSEMBLY CONSISTING OF STAINLESS STEEL PLATE WITH STAINLESS STEEL J-HOOKS WELDED TO PLATE. PROVIDE ONE HOOK PER WETWELL CABLE.

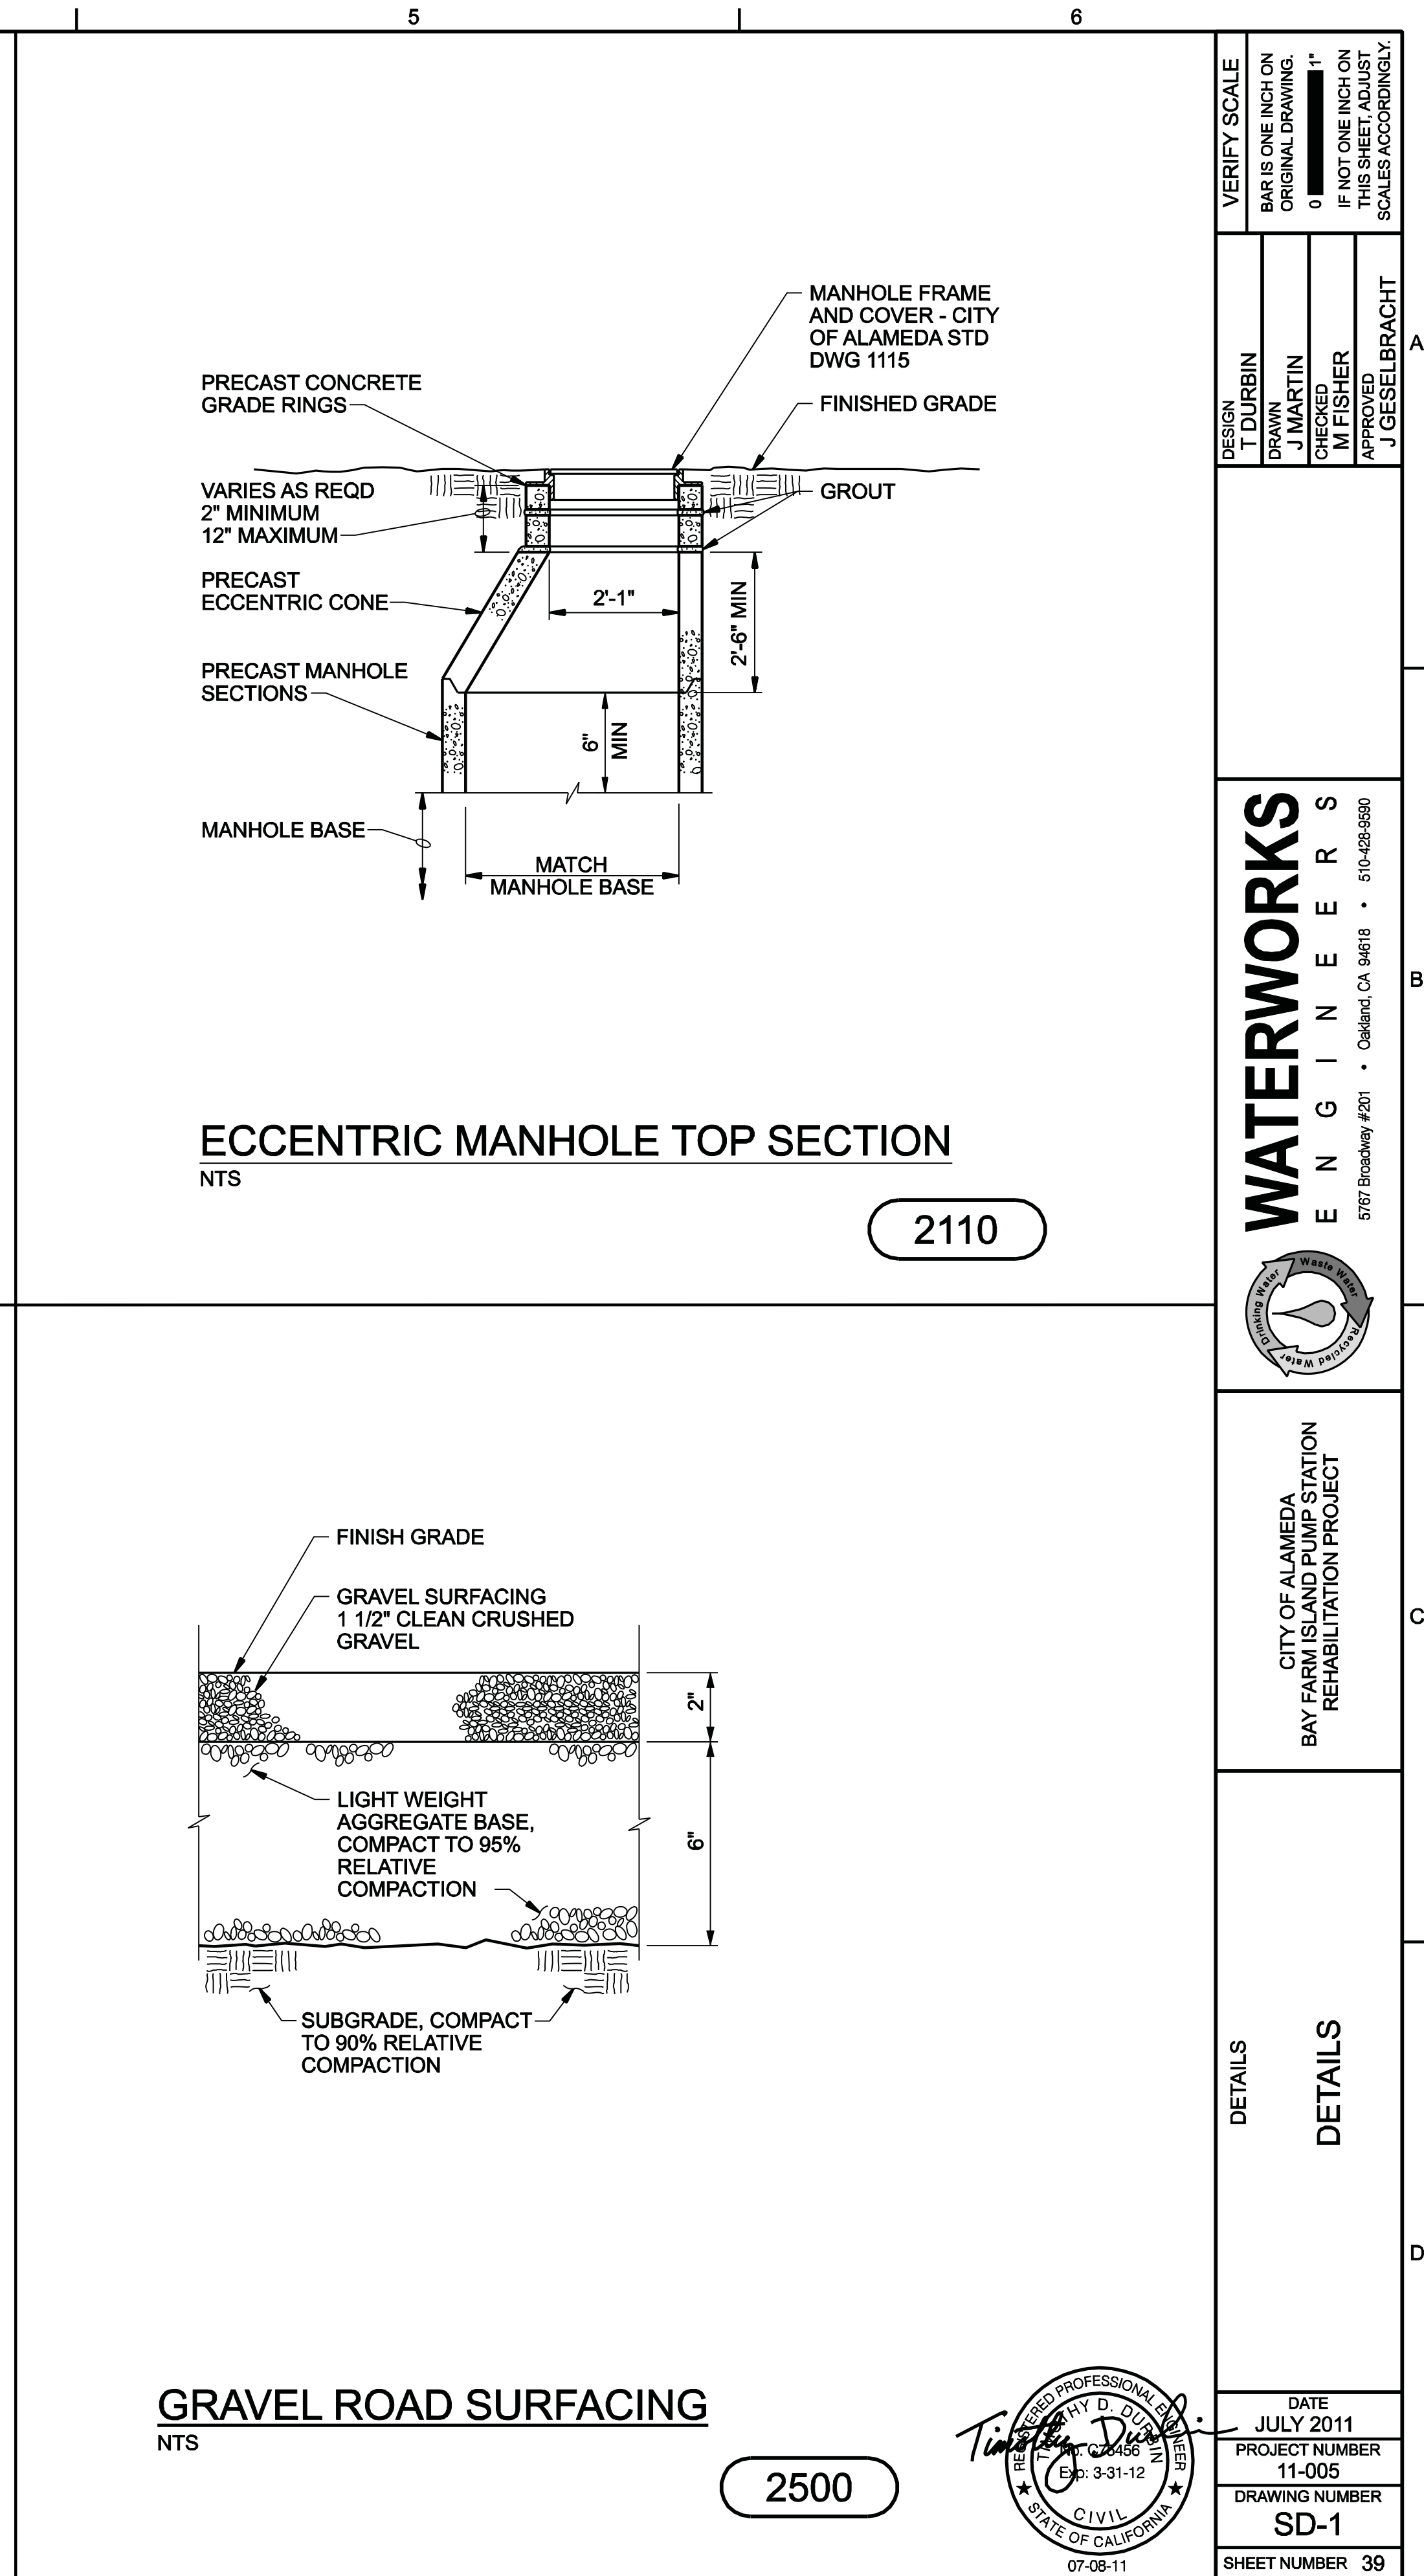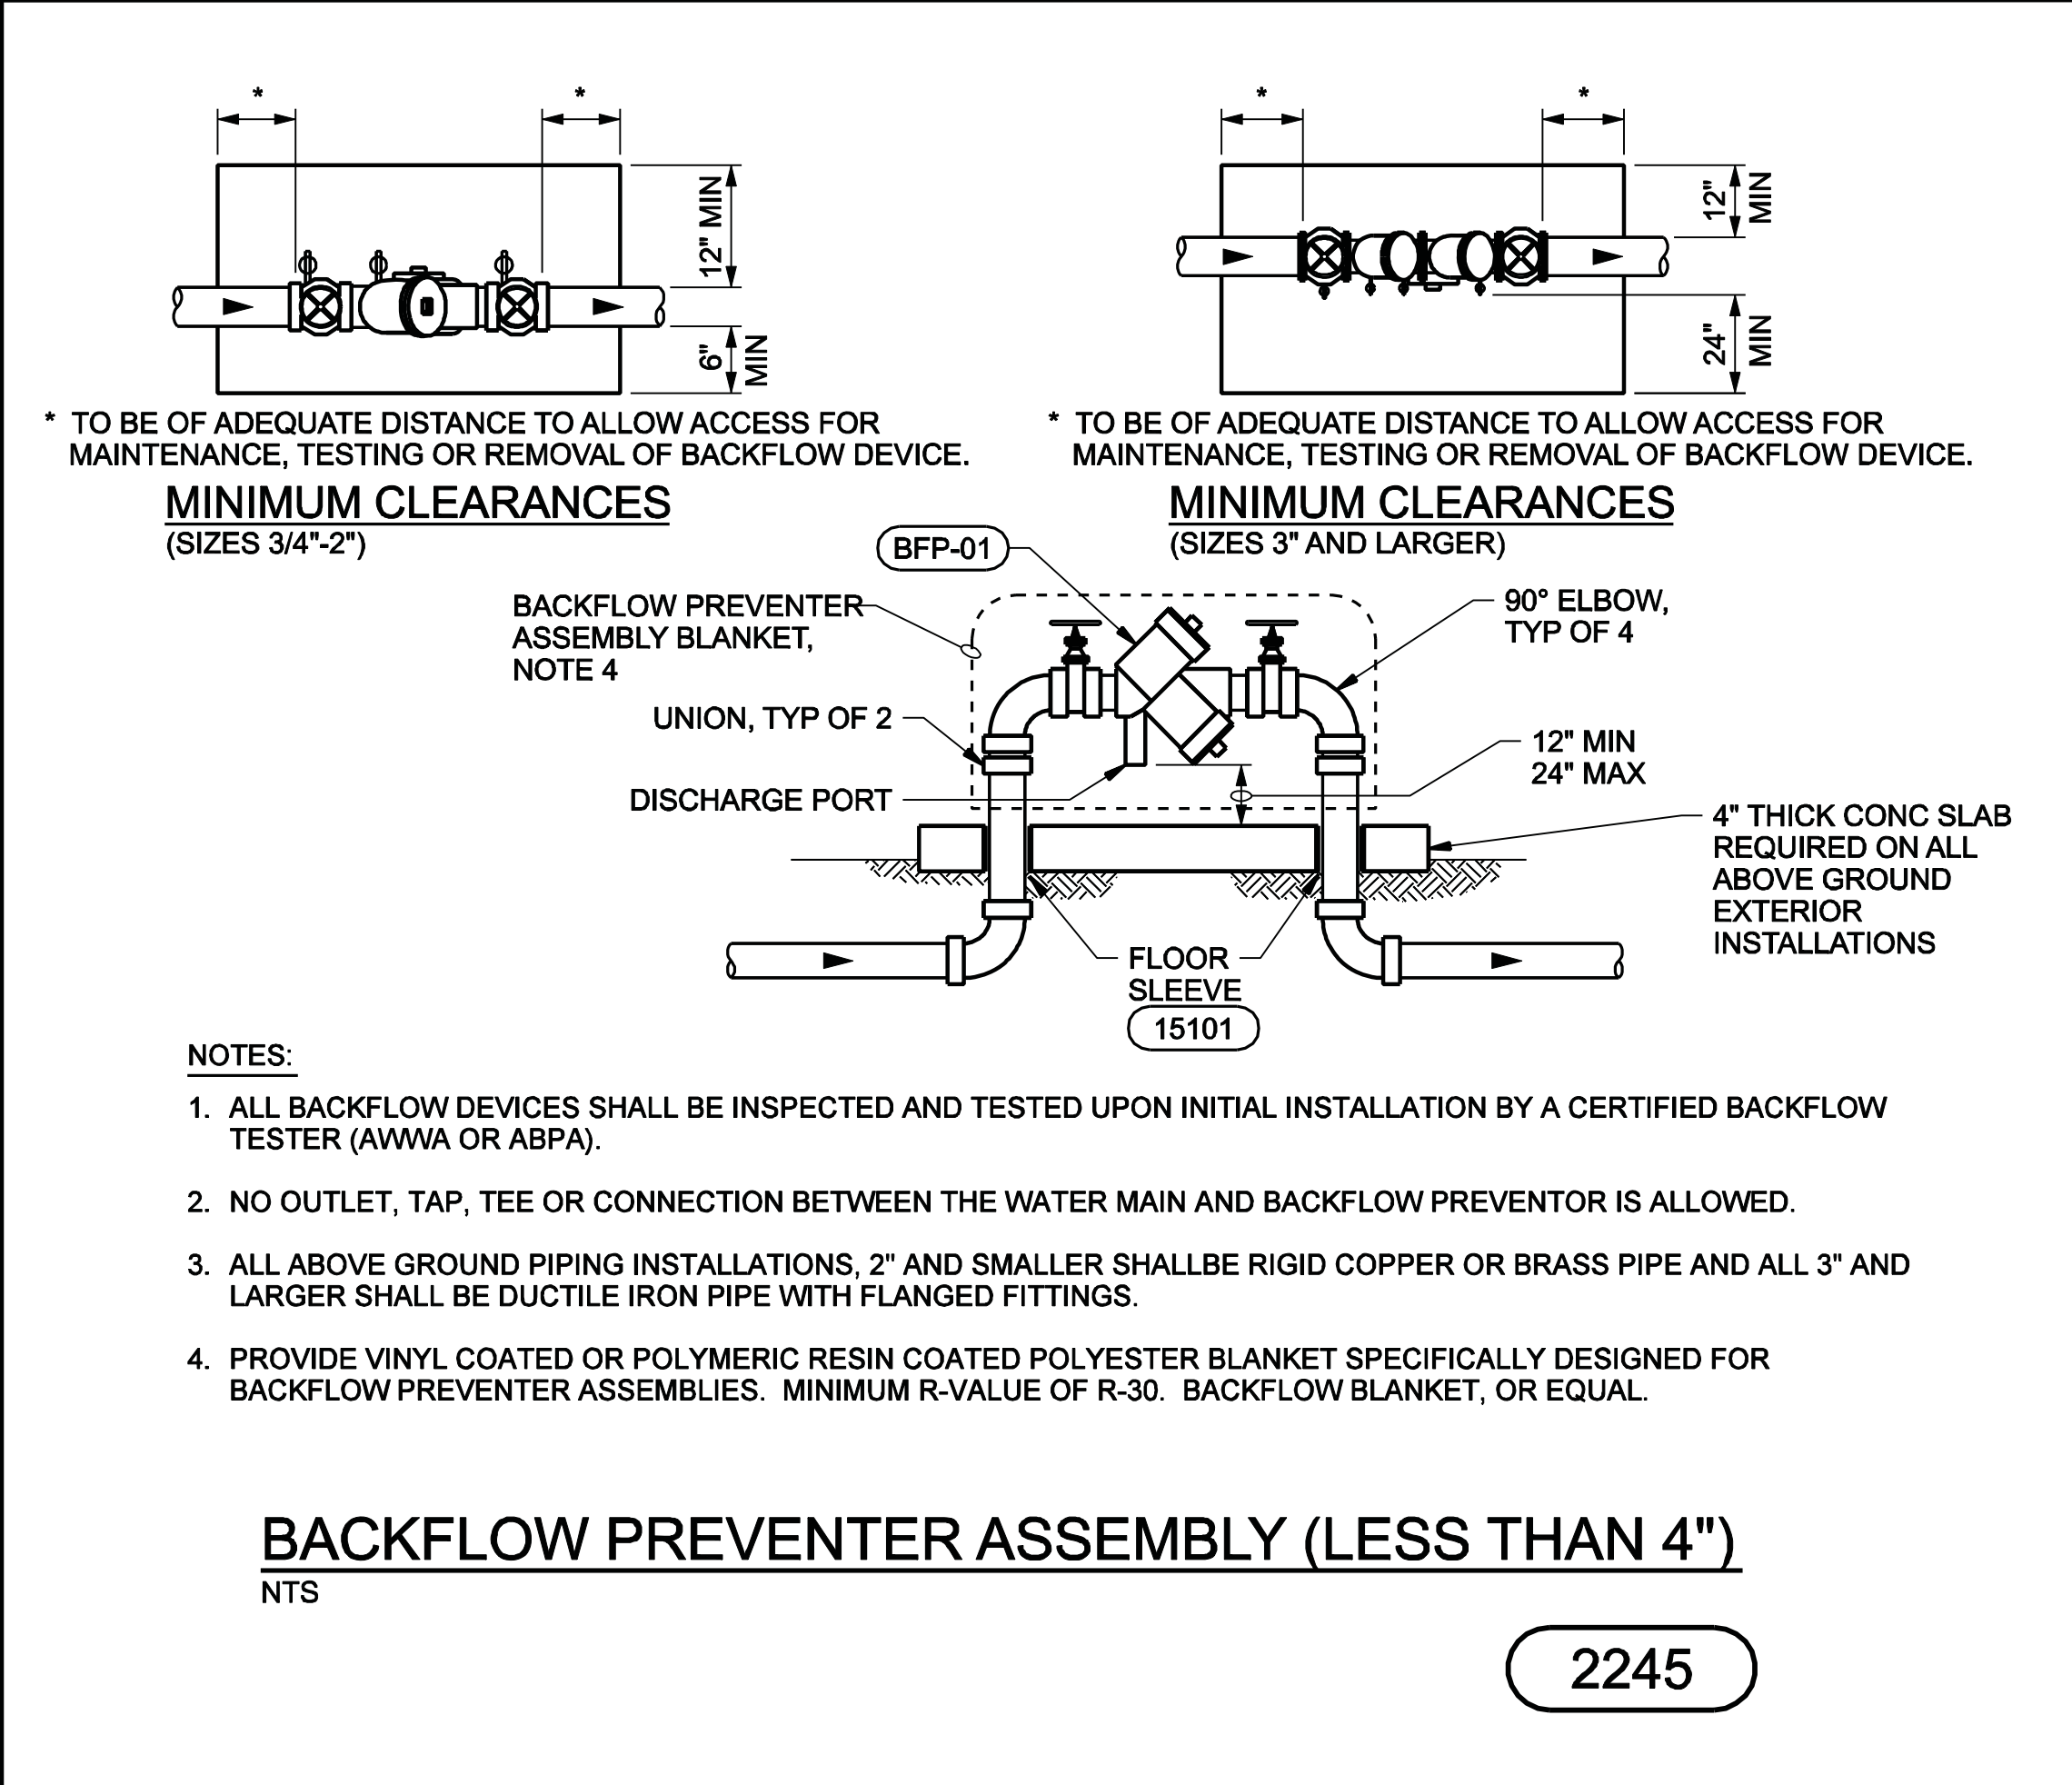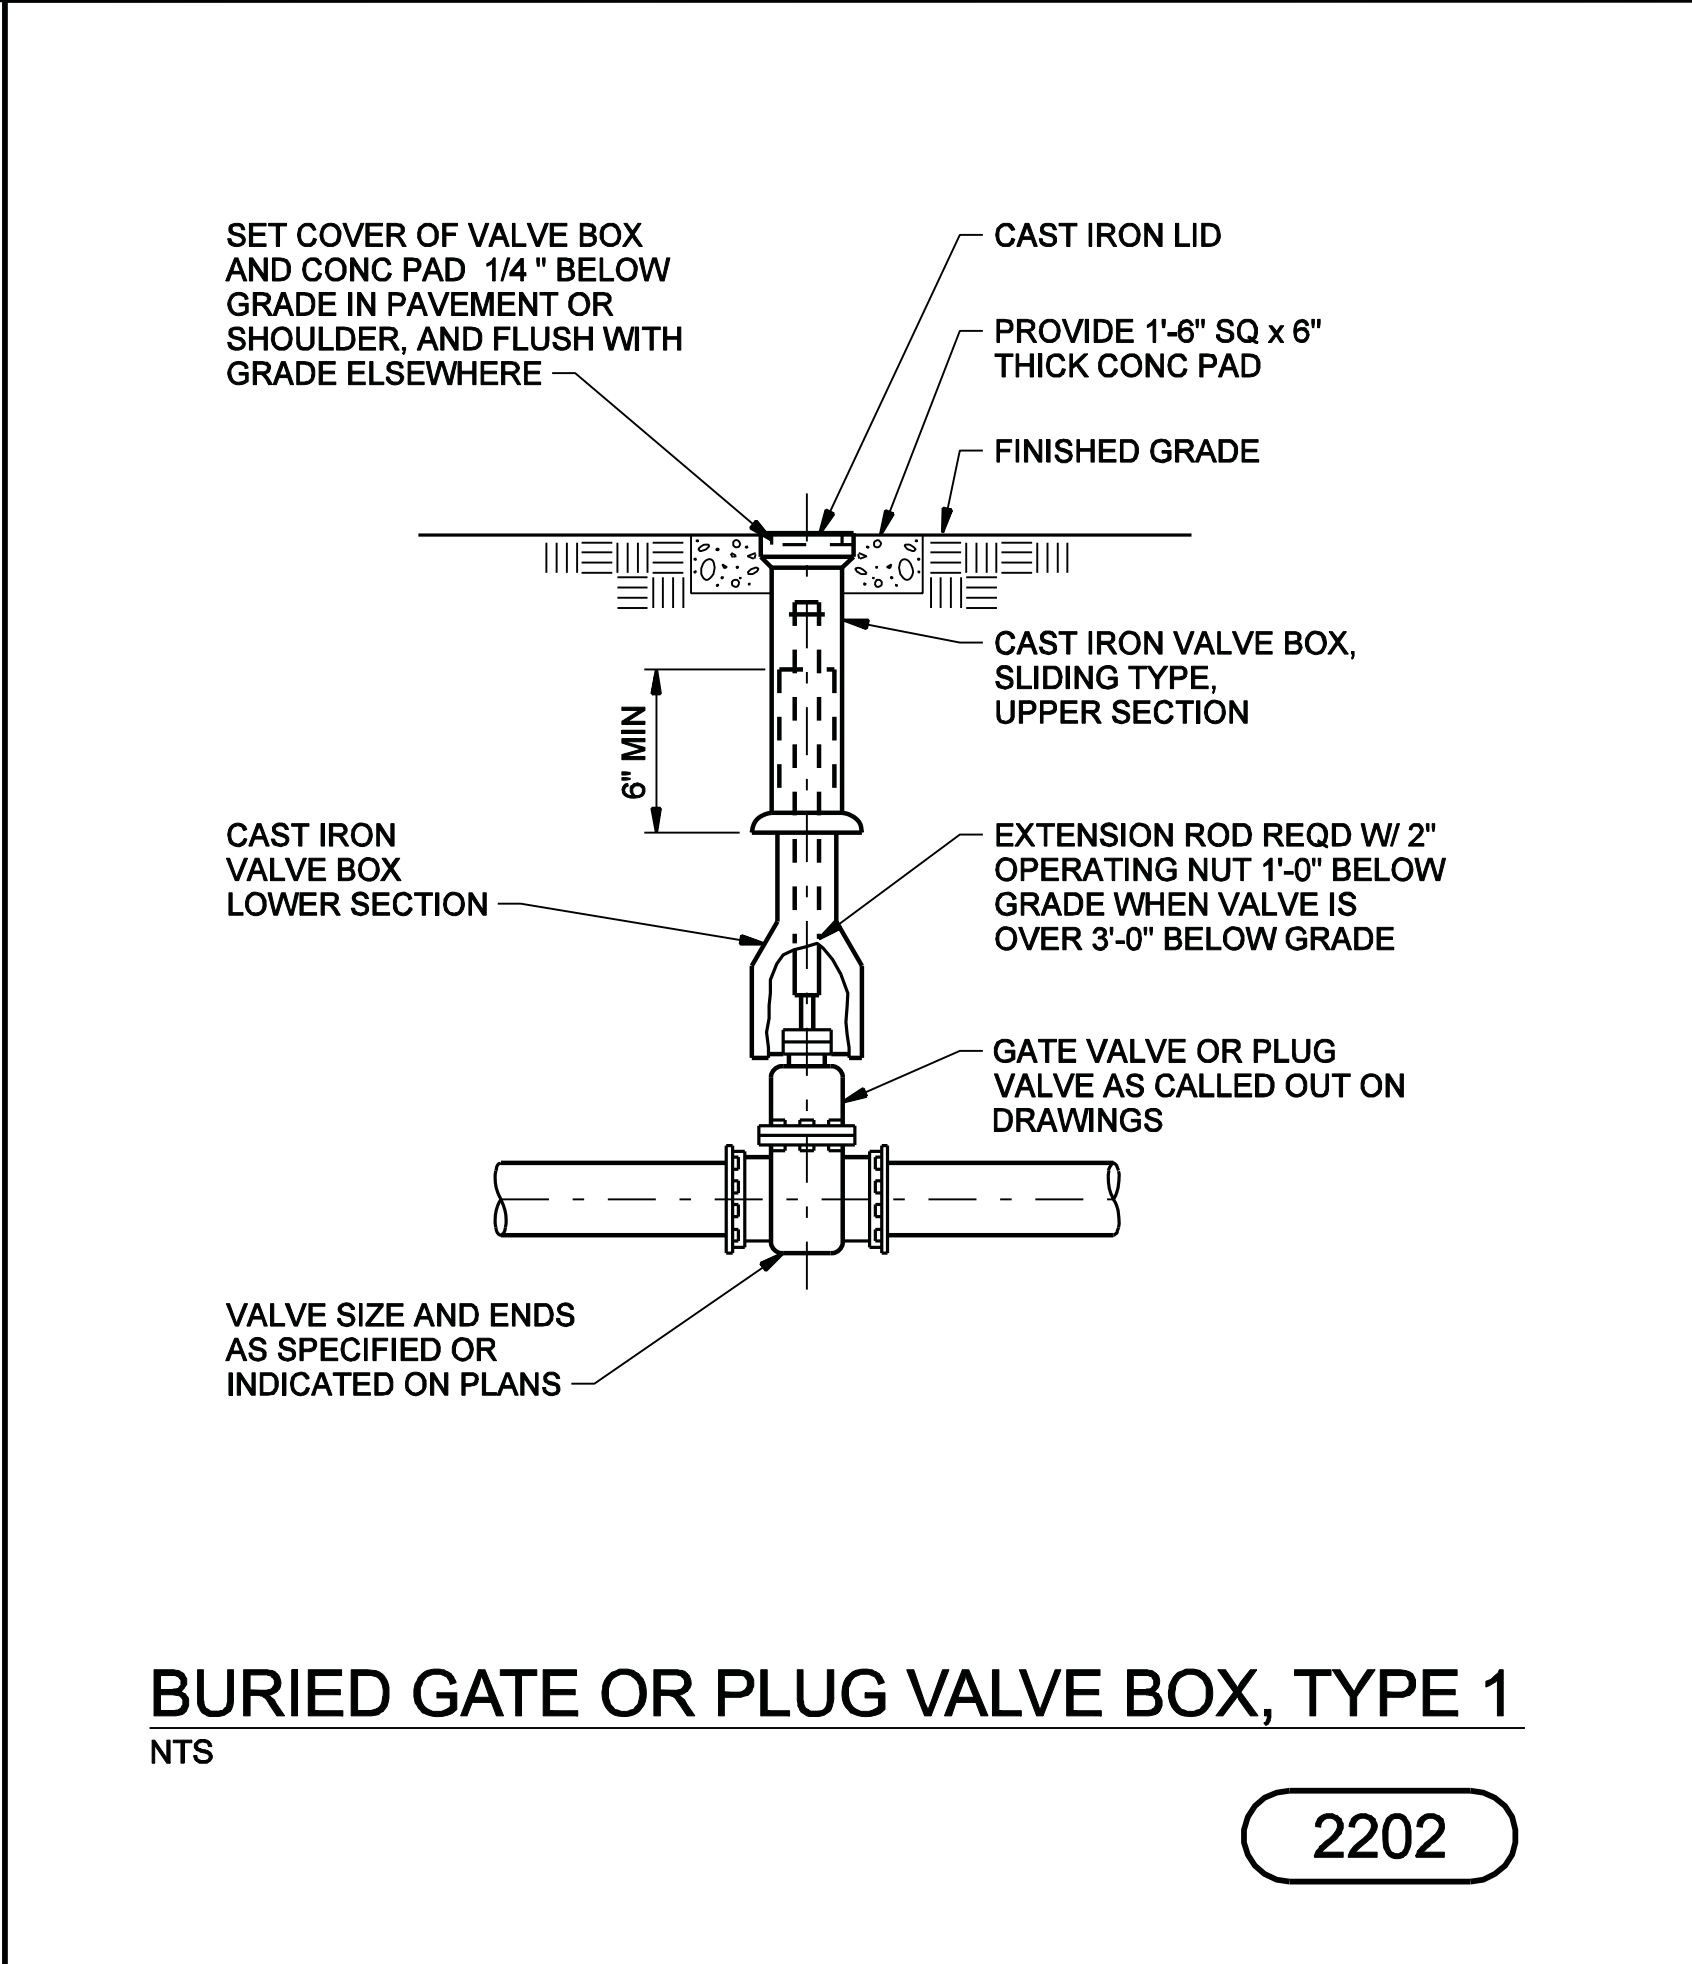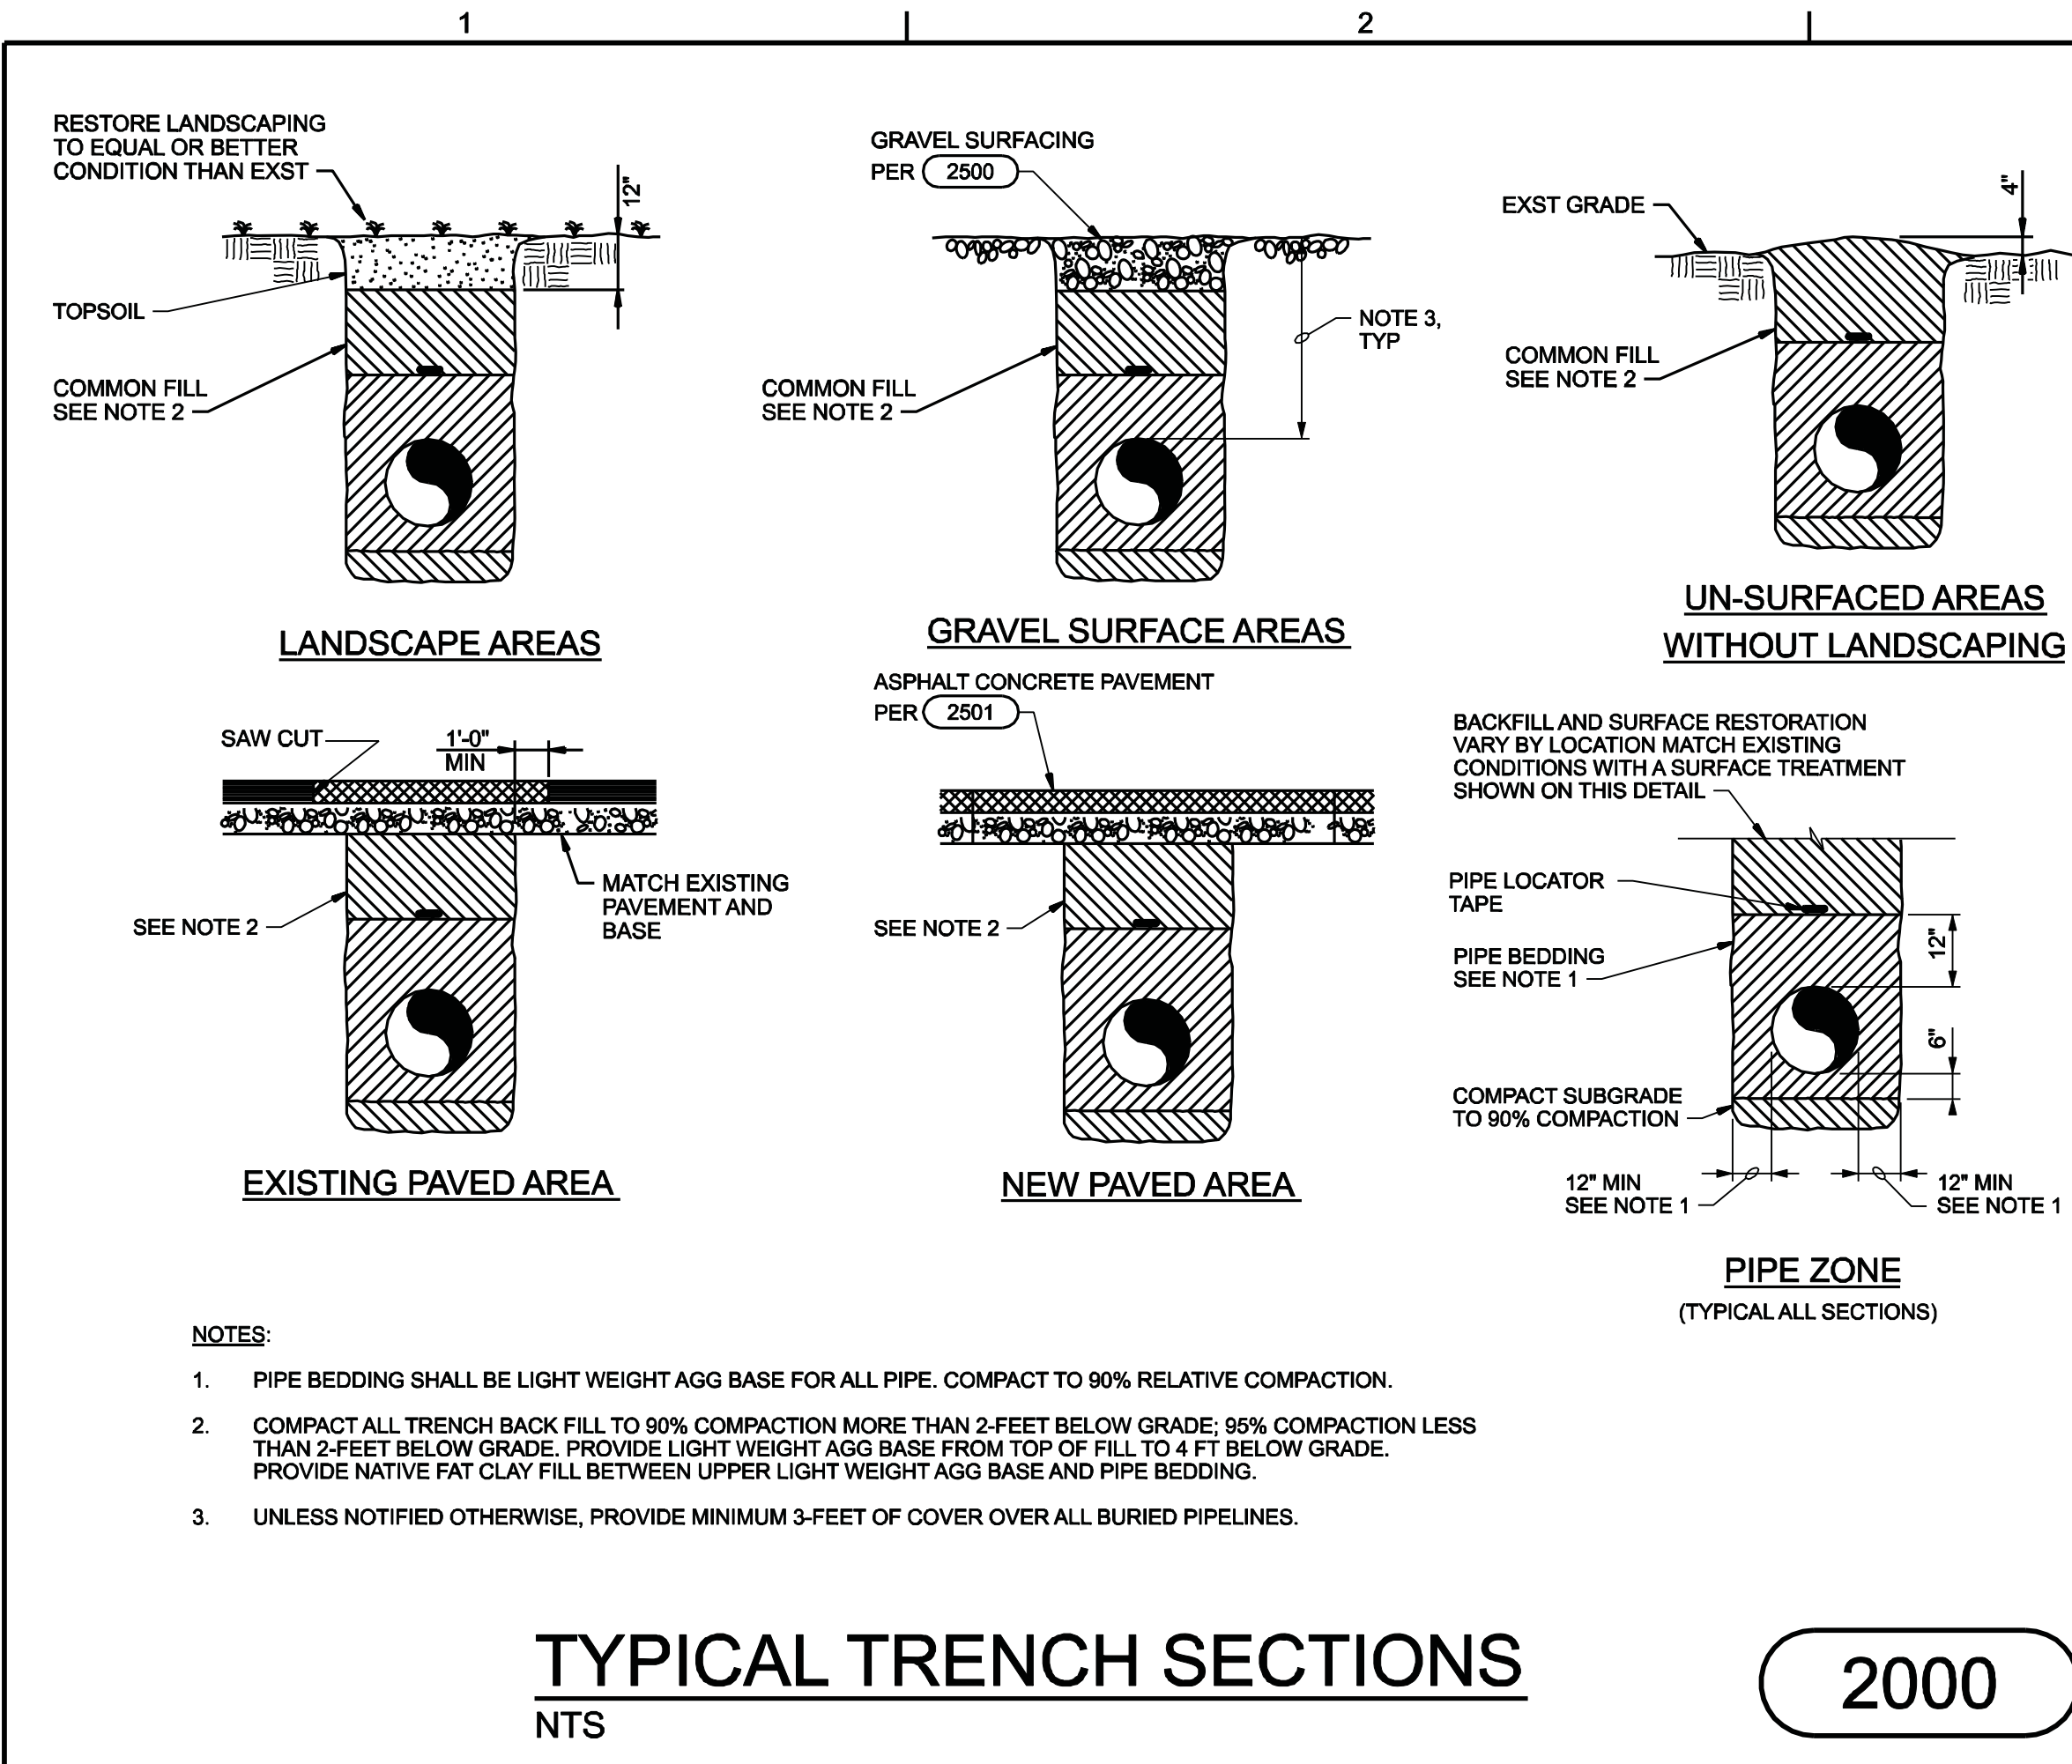

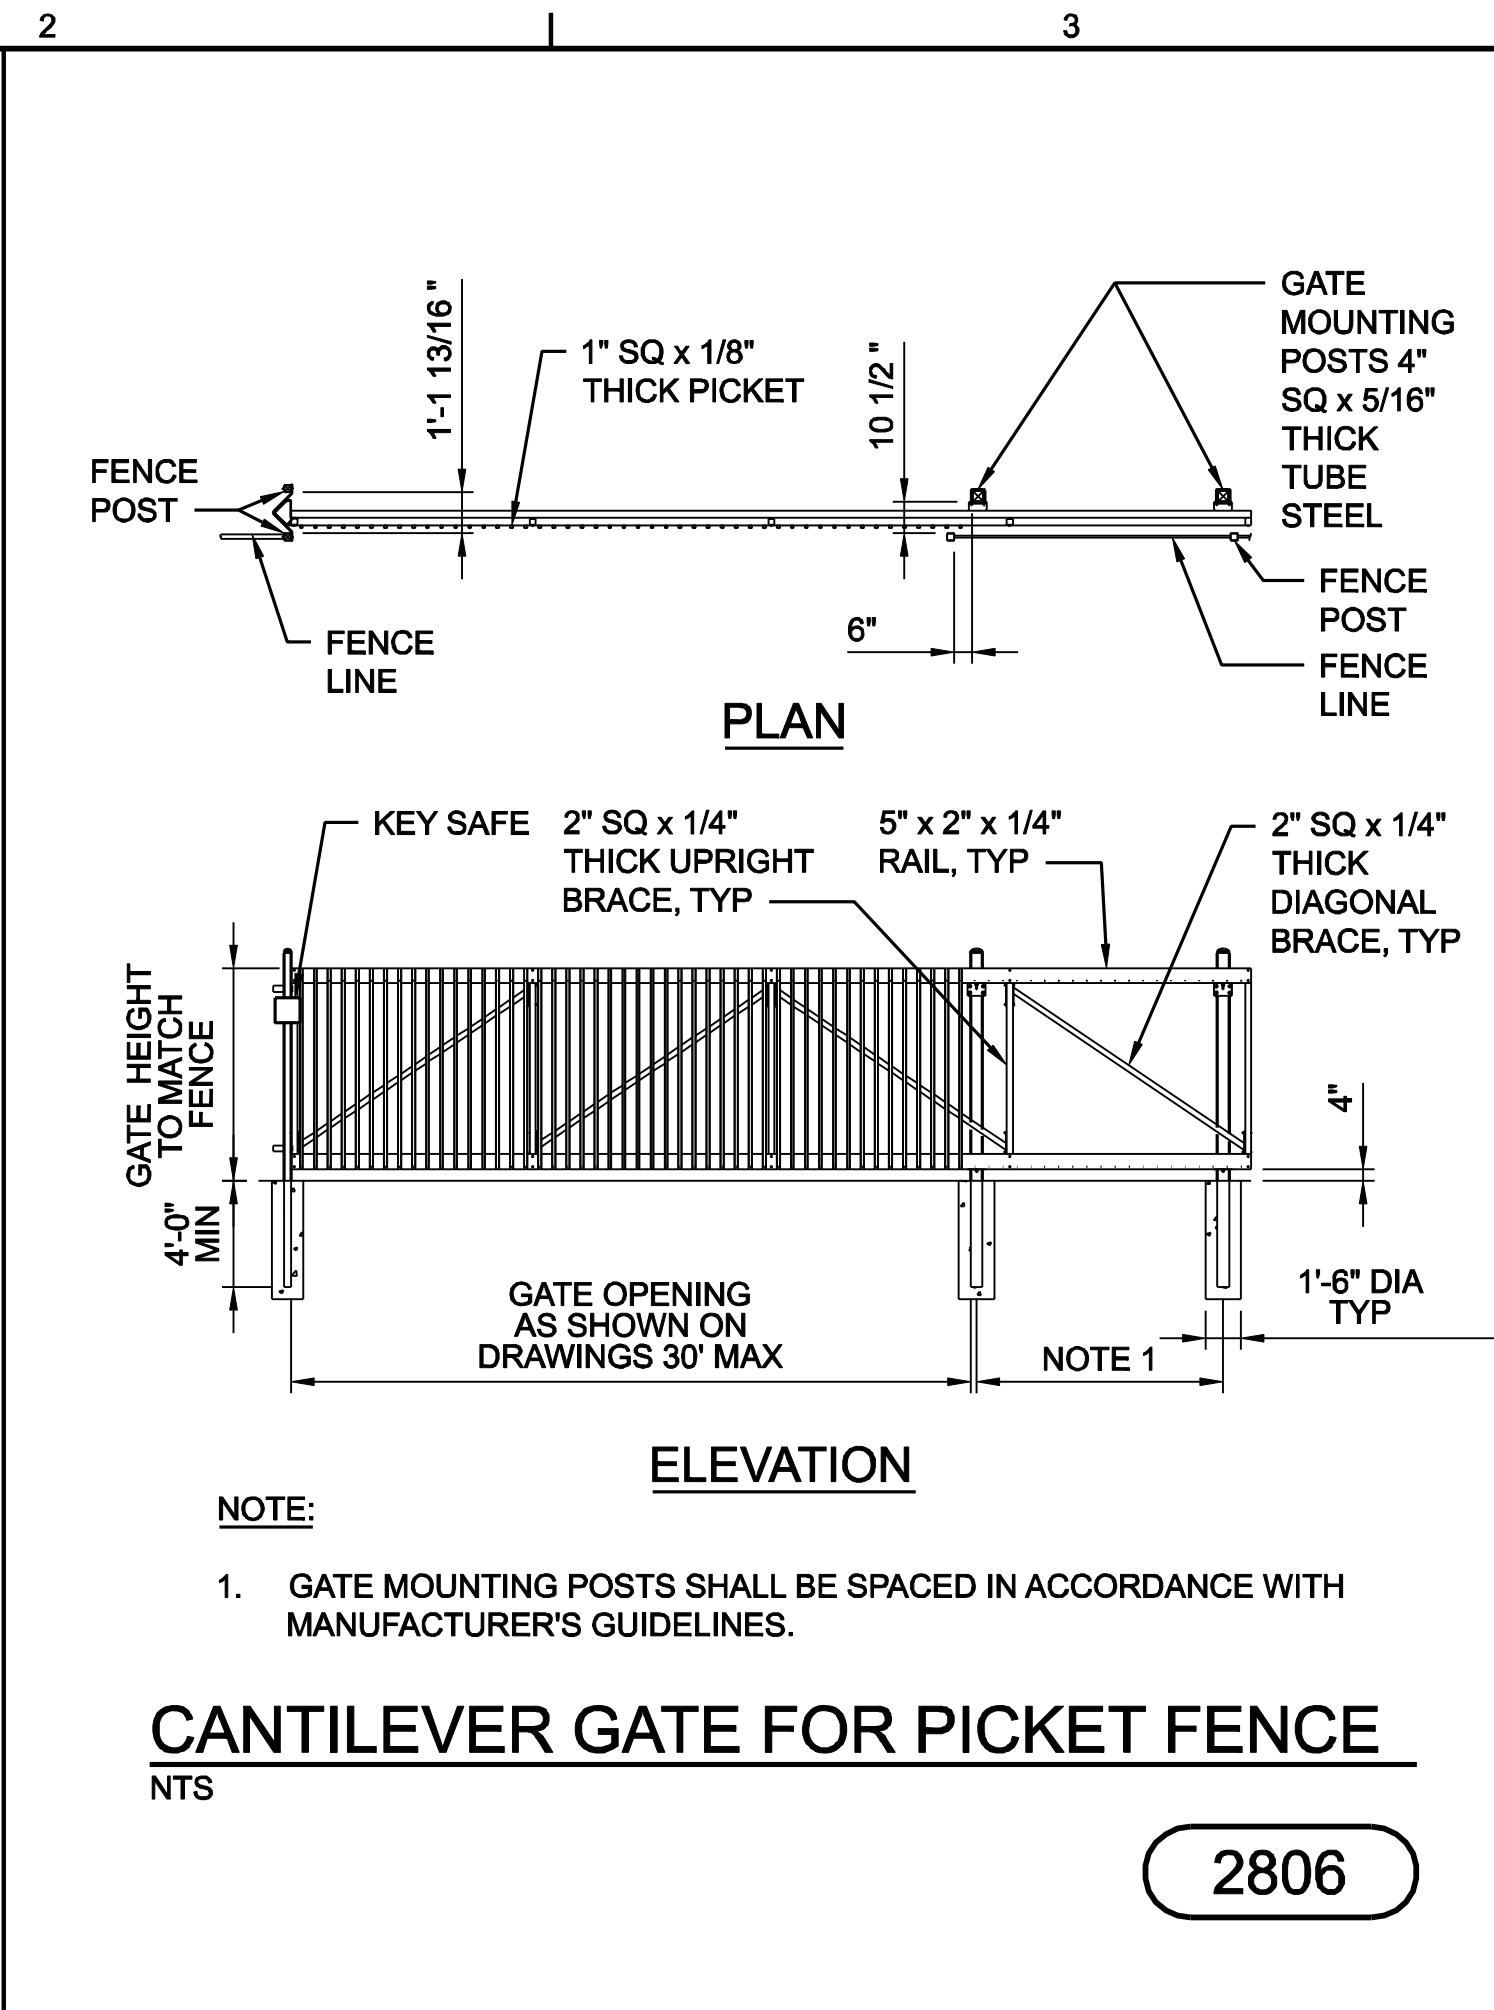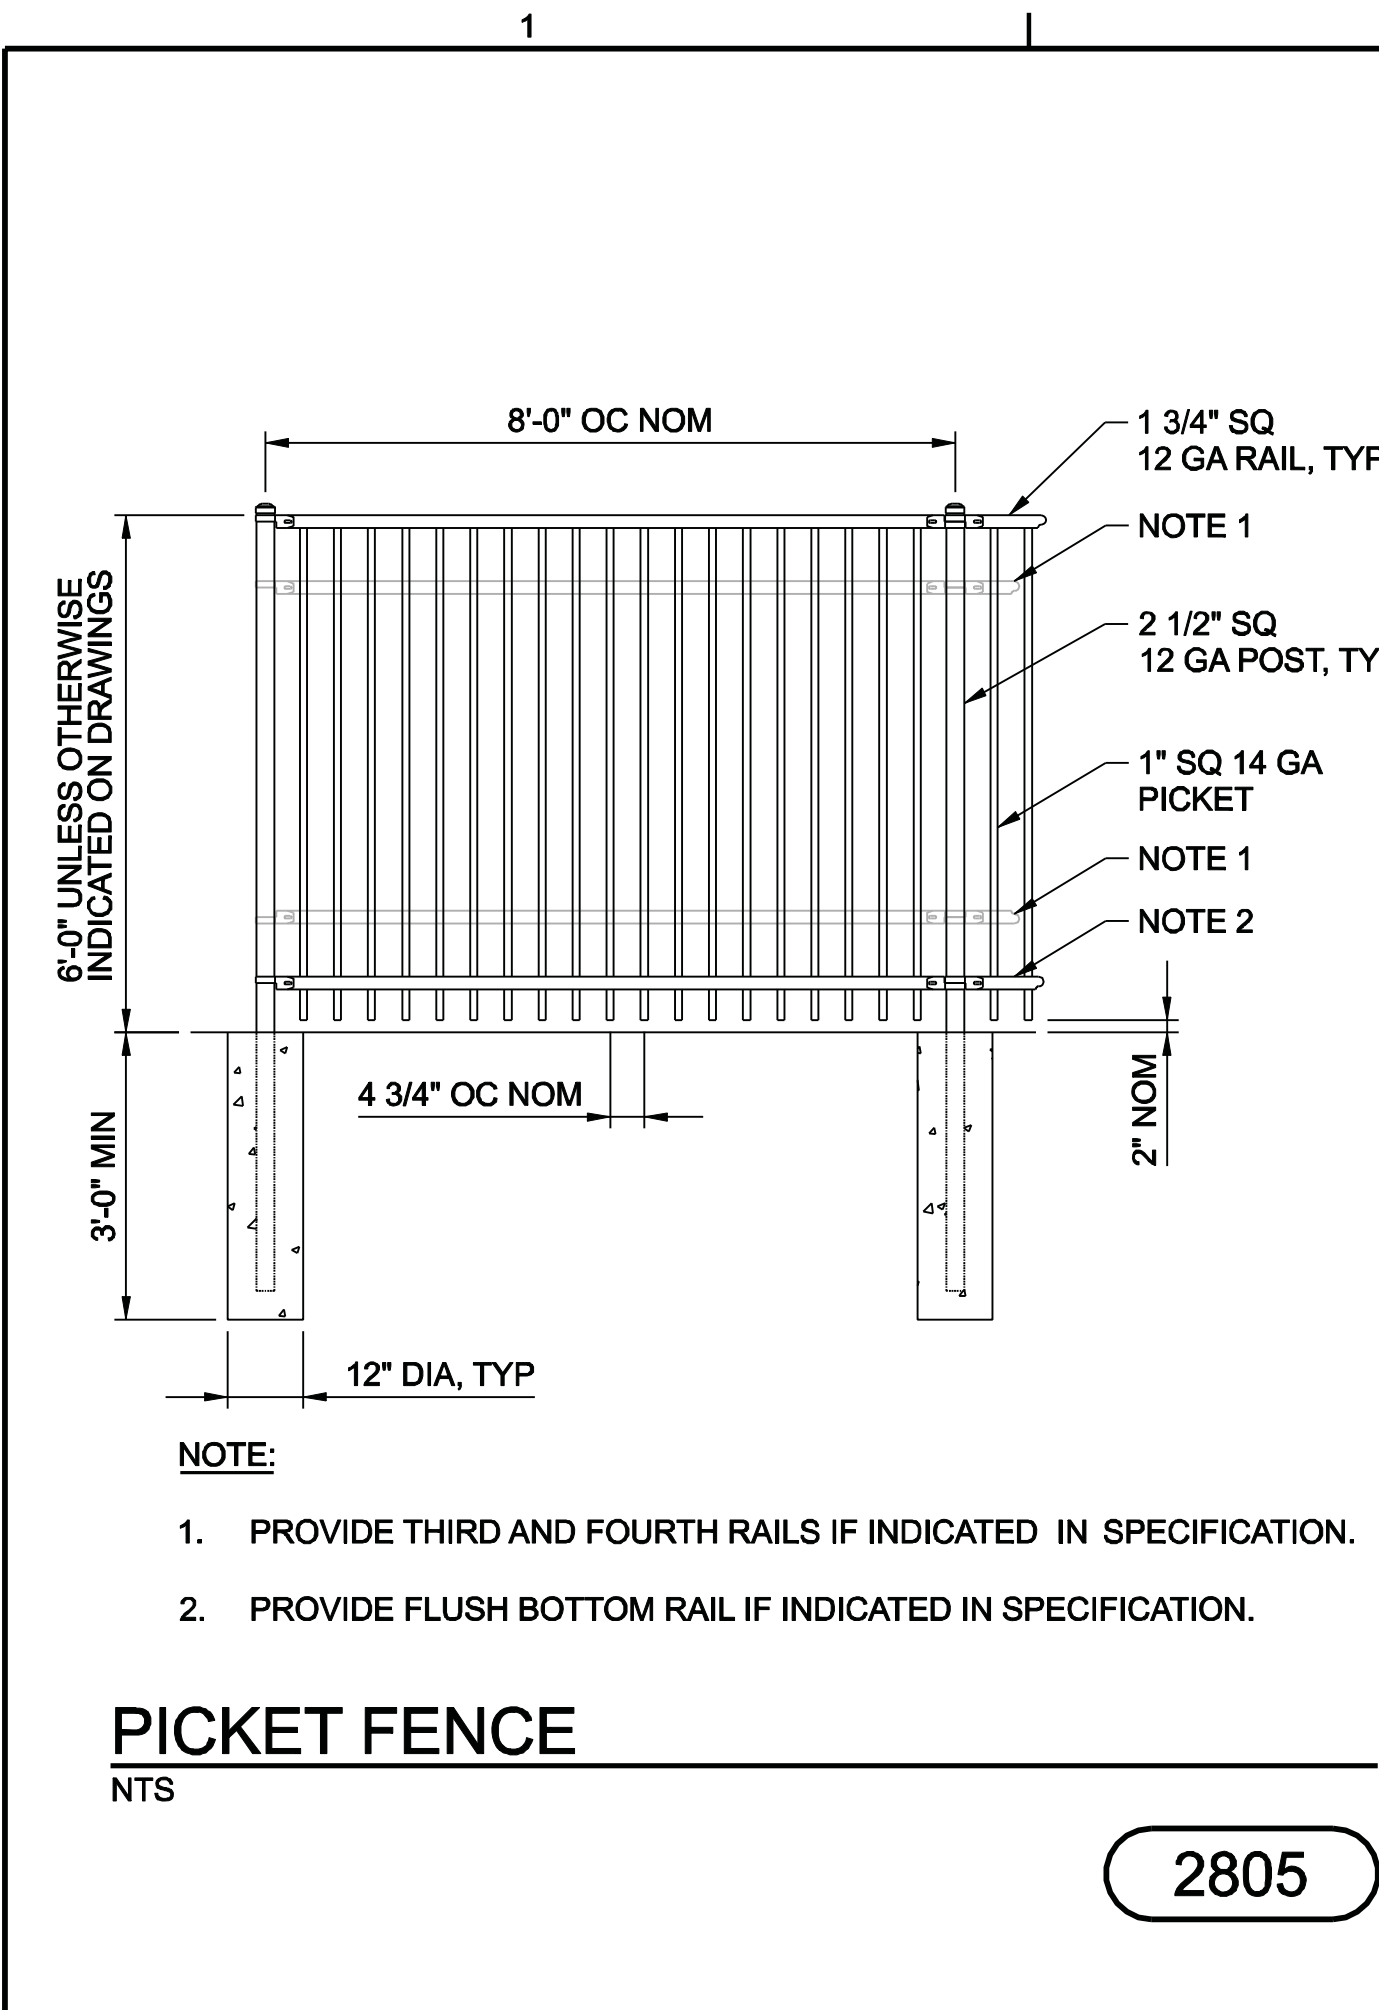

- 1 FINISH GRADE/TOP OF MULCH
- 2 VALVE BOX WITH COVER
- 3 30-INCH LINEAR LENGTH OF WIRE, COILED
- 4 WATERPROOF CONNECTION
- 5 ID TAG
- 6 REMOTE CONTROL VALVE
- 7 PRESSURE REGULATING BASKET FILTER
- 8 PVC SCH 40 FEMALE ADAPTOR
- 9 LATERAL PIPE
- 10 PVC SCH 40 NIPPLE (LENGTH AS REQUIRED)
- 11 PVC SCH 40 ELL
- 12 PVC SCH 40 NIPPLE (2" LENGTH, HIDDEN)
- 13 PVC SCH 40 ELL
- 14 PVC SCH 40 TEE OR ELL
- 15 MAINLINE PIPE
- 16 3" MIN DEPTH OF 3/4" WASHED GRAVEL
- 17 PVC BALL VALVE

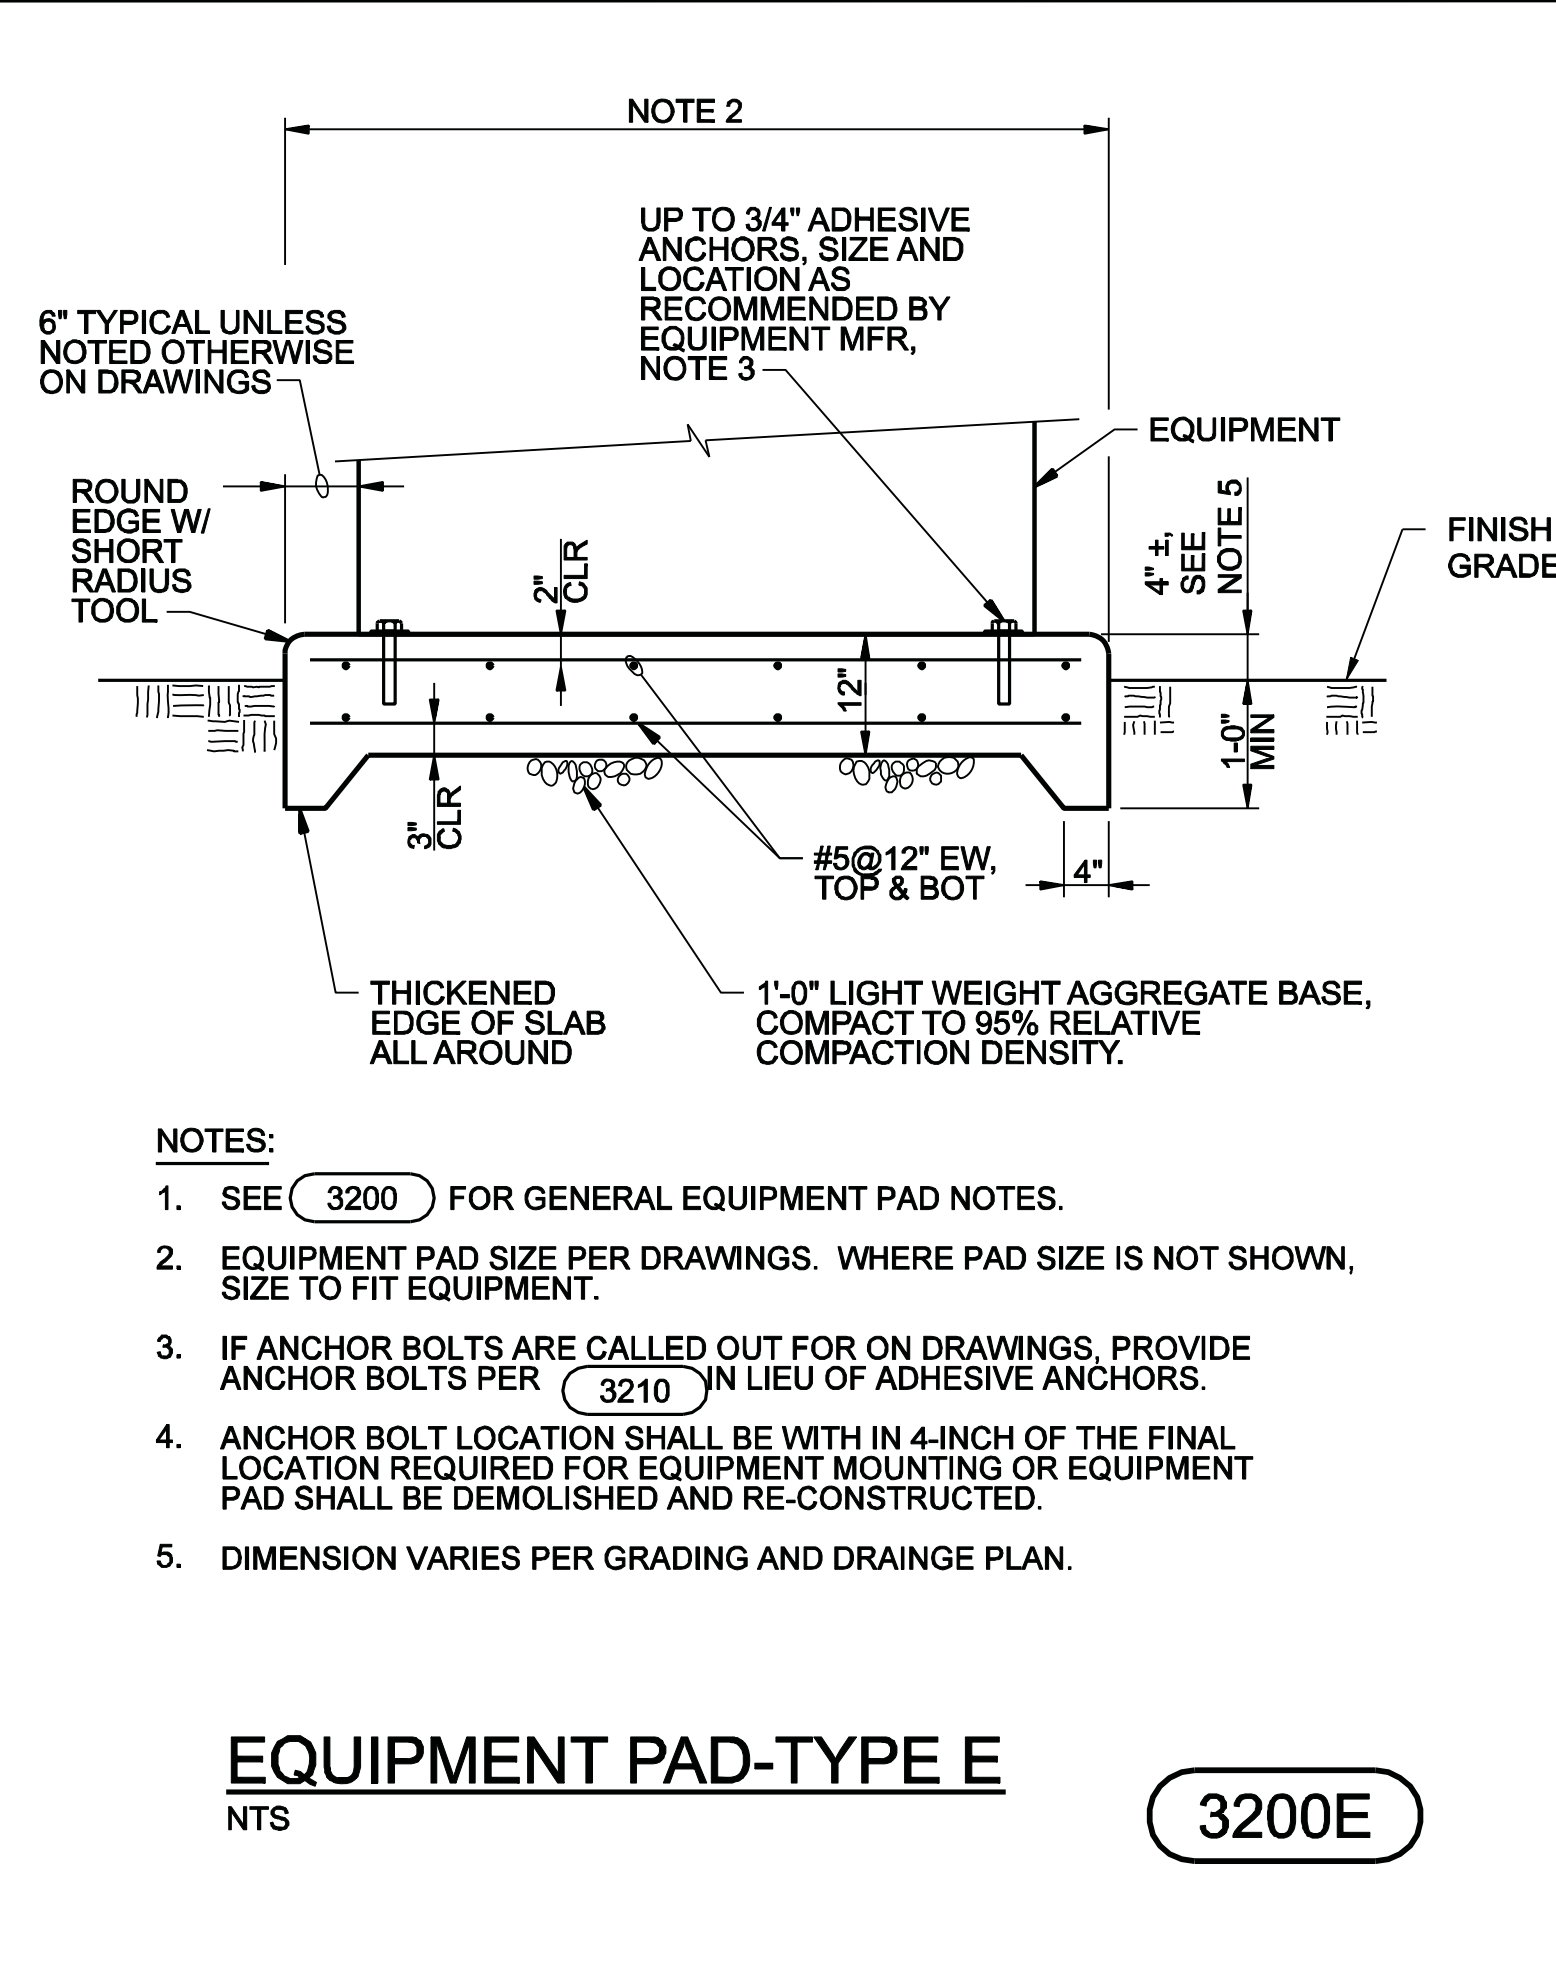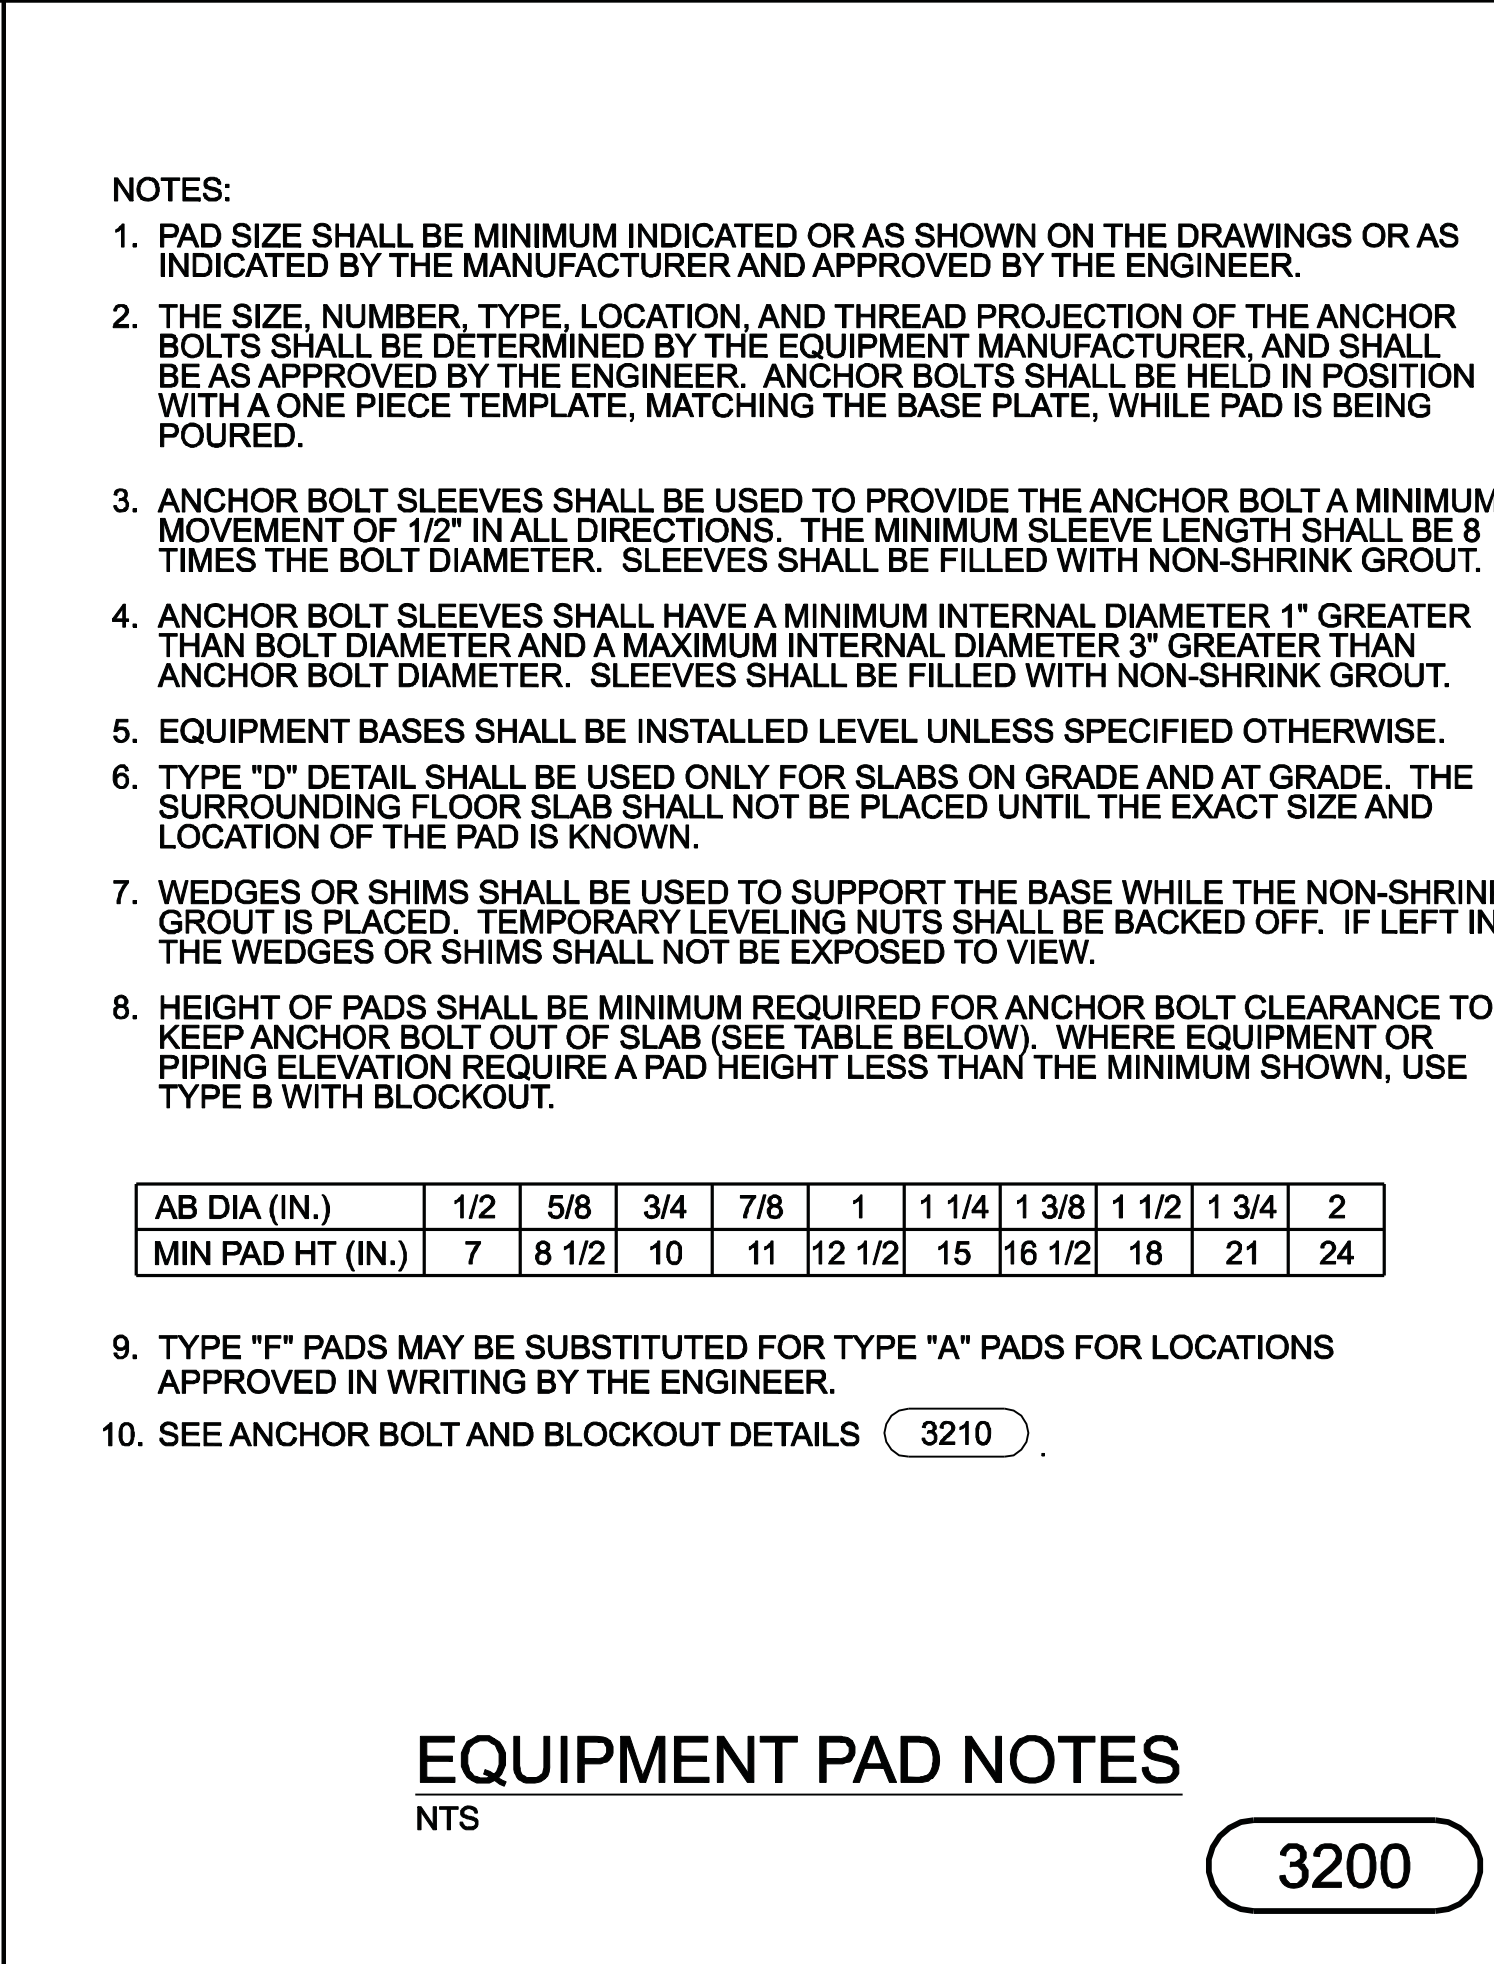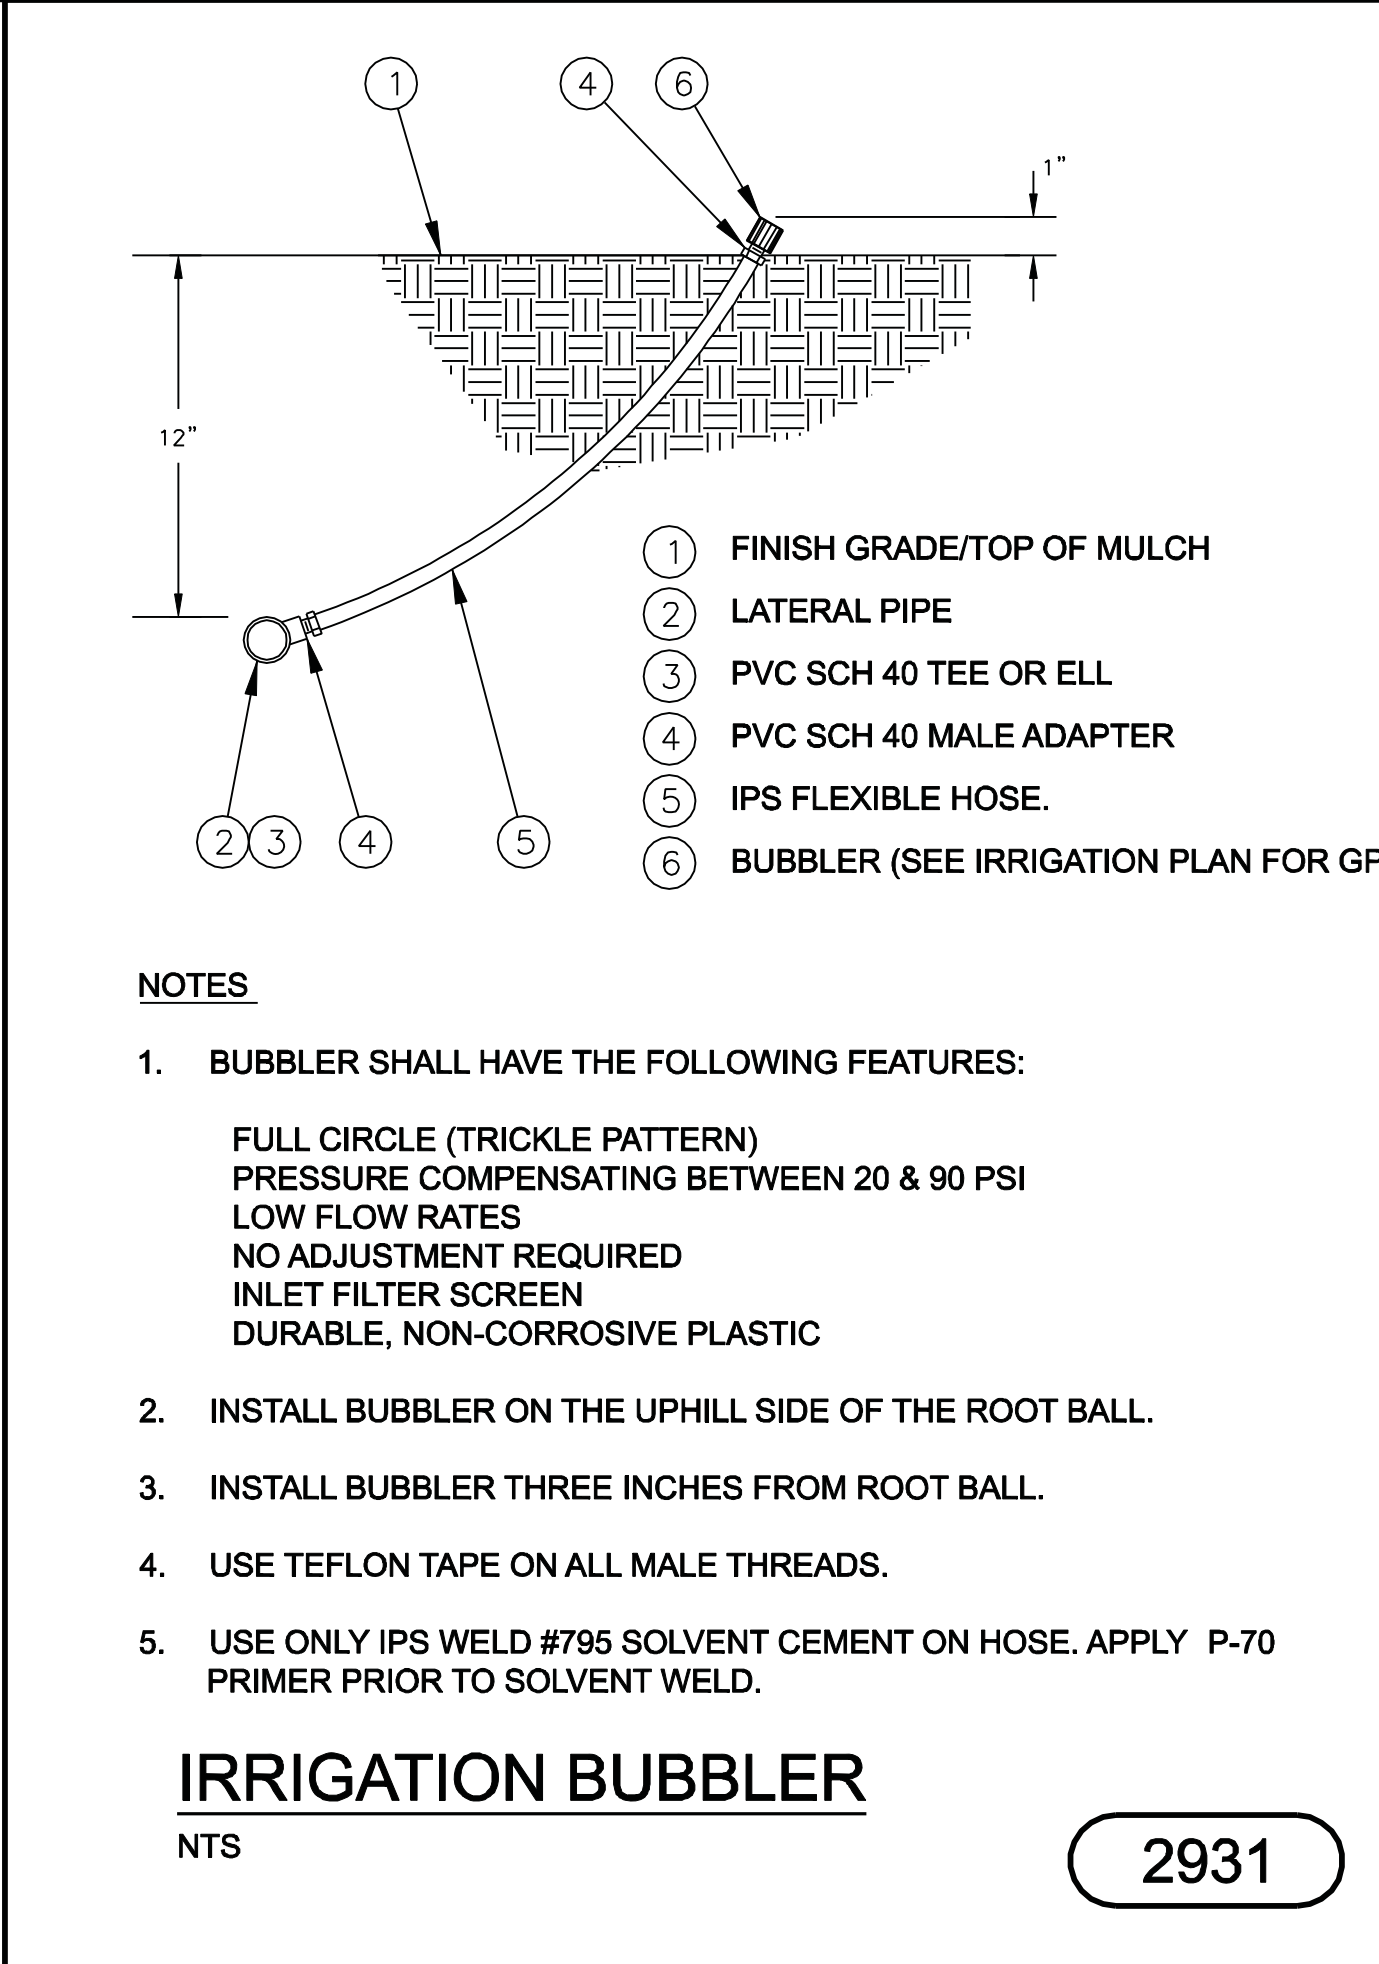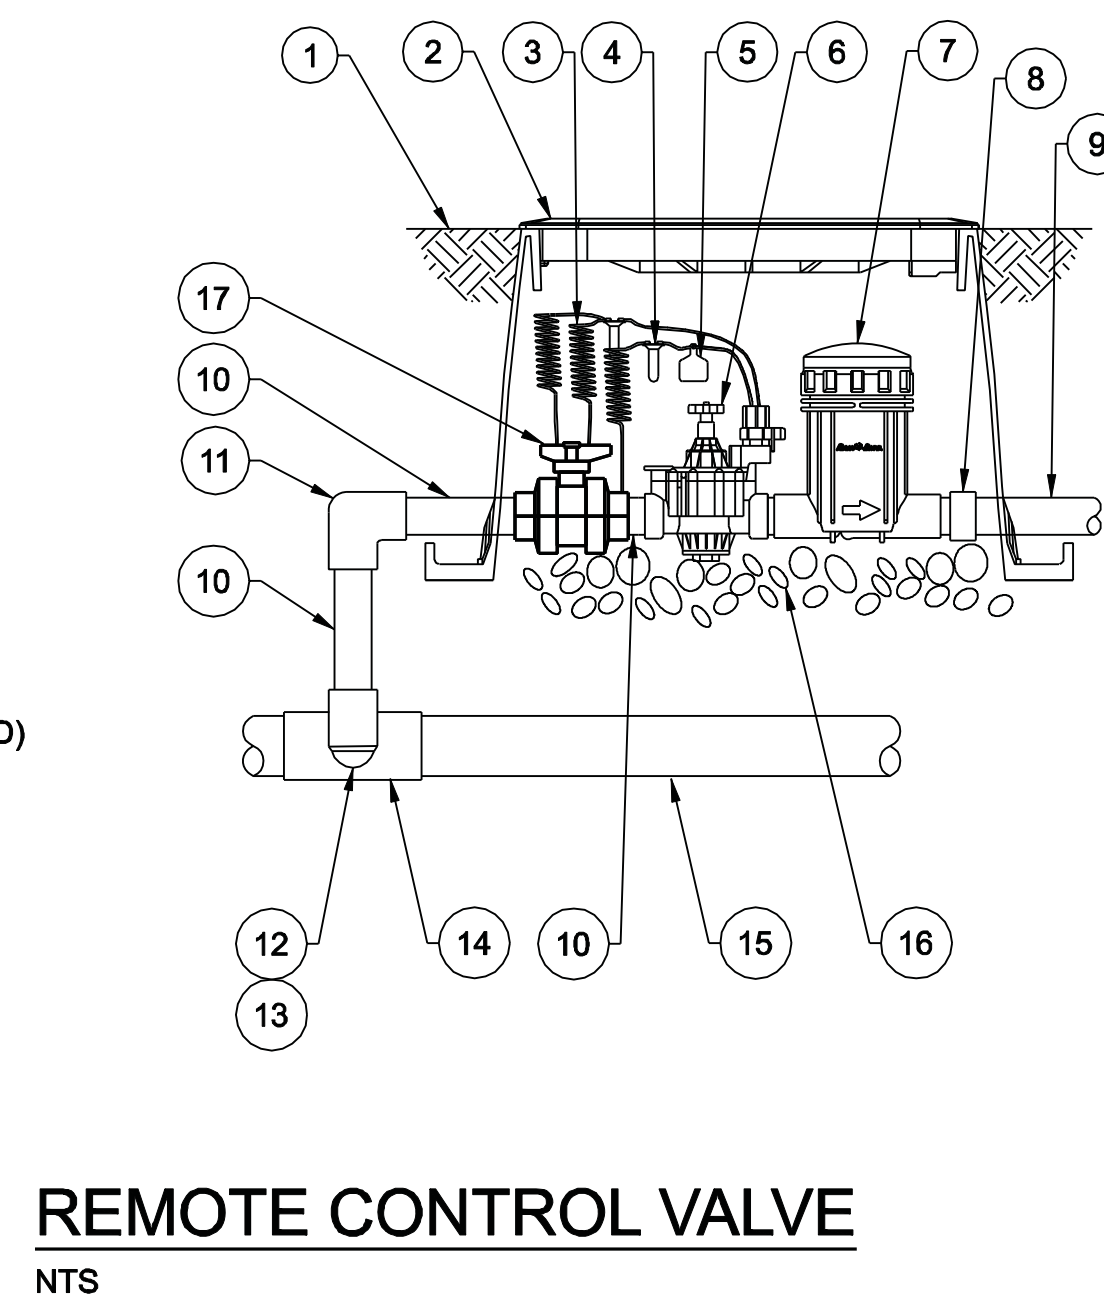

VERIFY SCALE
BAR IS ONE INCH ON ORIGINAL DRAWING.
0 1"
IF NOT ONE INCH ON THIS SHEET, ADJUST SCALES ACCORDINGLY.

DESIGN
T DURBIN

DRAWN
J MARTIN

CHECKED
M FISHER

APPROVED
J GESELBRACHT

WATERWORKS
ENGINEERS
5767 Broadway #201 • Oakland, CA 94618 • 510-423-9590

CITY OF ALAMEDA
BAY FARM ISLAND PUMP STATION
REHABILITATION PROJECT

DETAILS
DETAILS


DATE
JULY 2011

PROJECT NUMBER
11-005

DRAWING NUMBER
SD-3

SHEET NUMBER
41

07-08-11

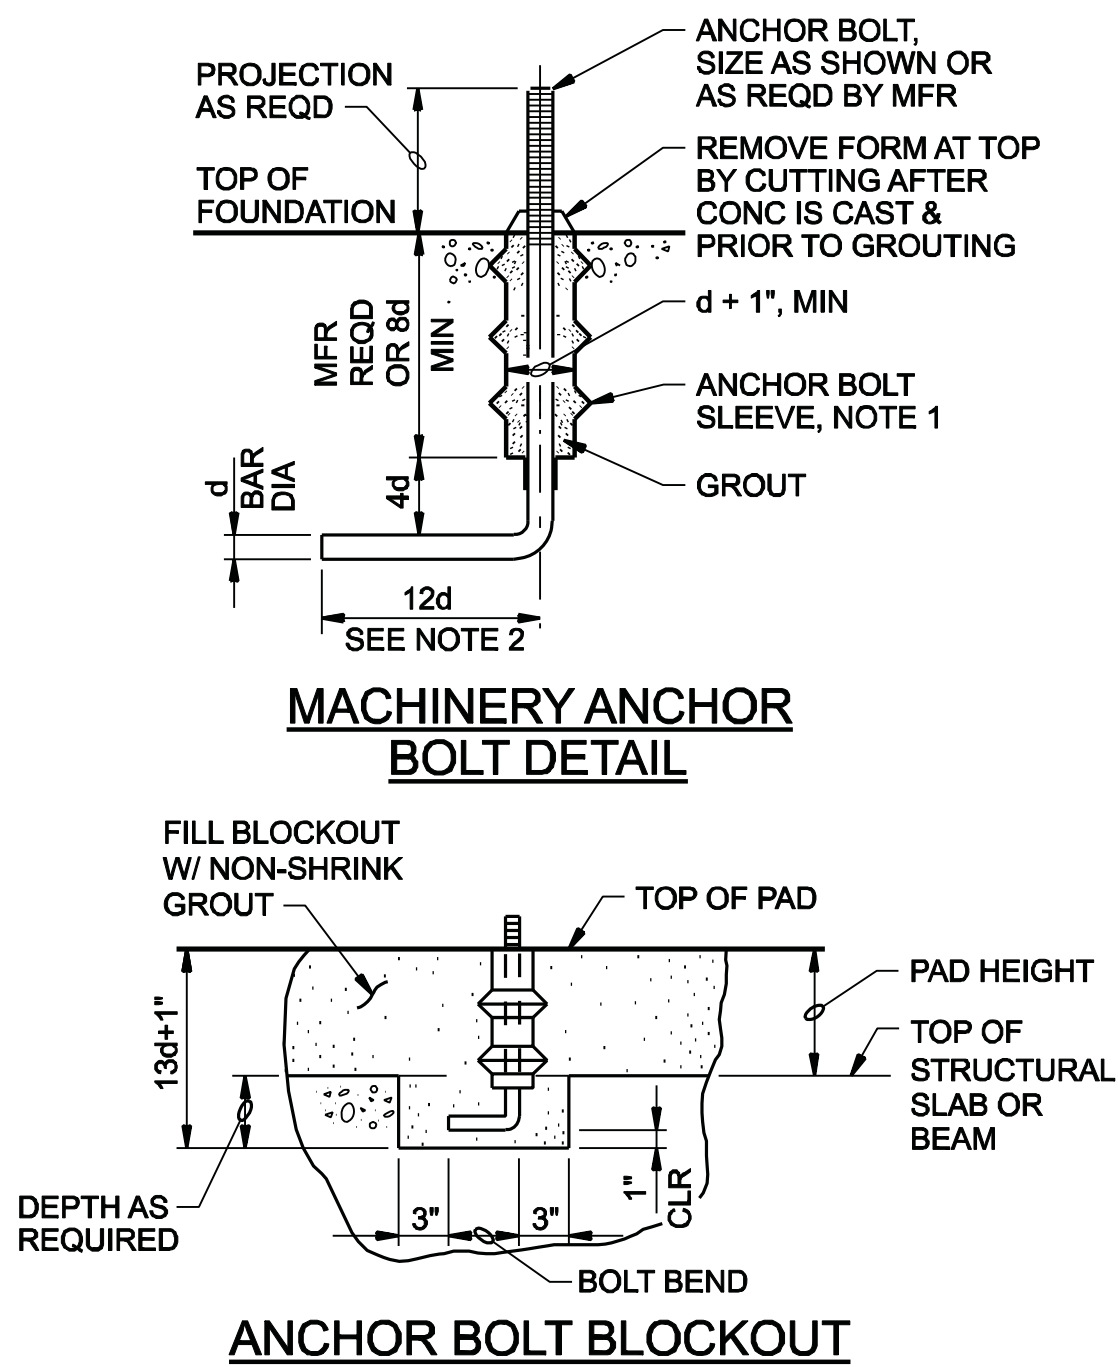


- NOTES:**
1. ANCHOR BOLT SLEEVE BY THE ANCHOR BOLT SLEEVE COMPANY, SHELTON, CT, OR EQUAL.
 2. 3d WHERE MANUFACTURER VERIFIES NO BOLT PULLOUT RESISTANCE REQUIRED.

ANCHOR BOLT DETAILS

NTS


3210

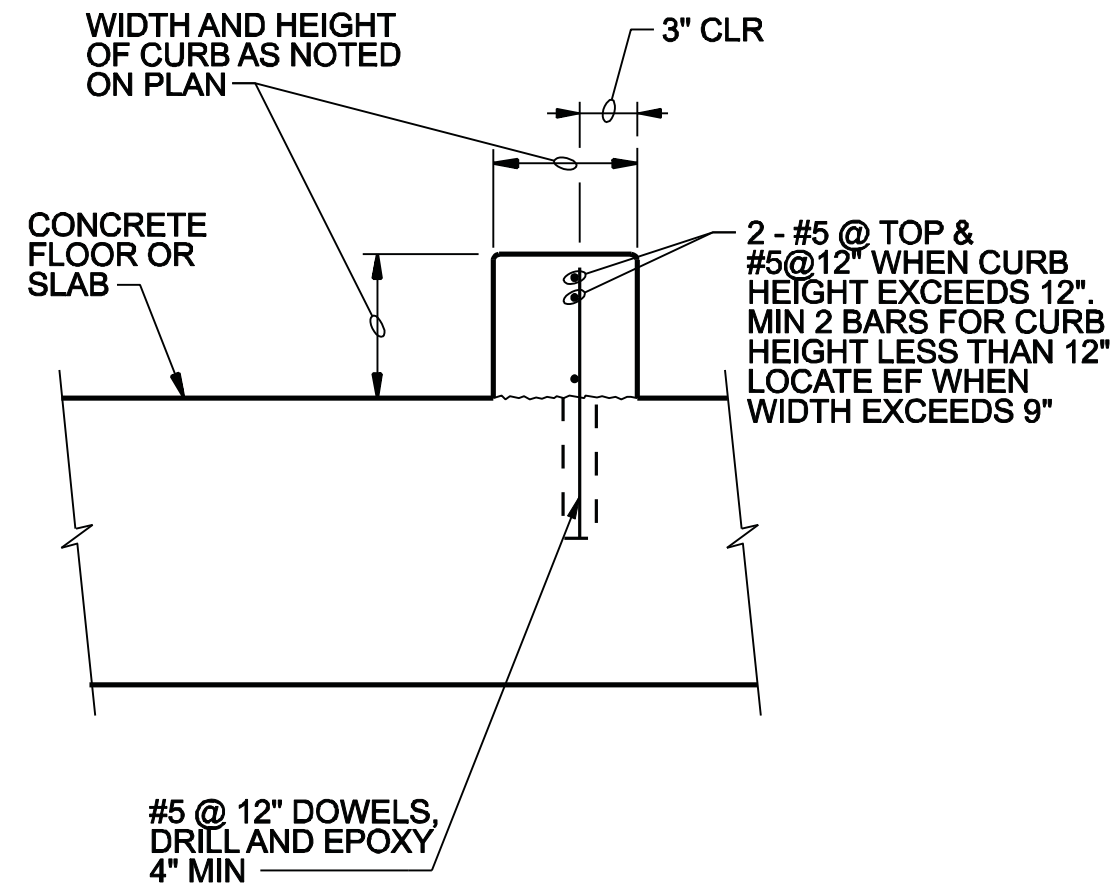

CONCRETE CURB

NTS

3250

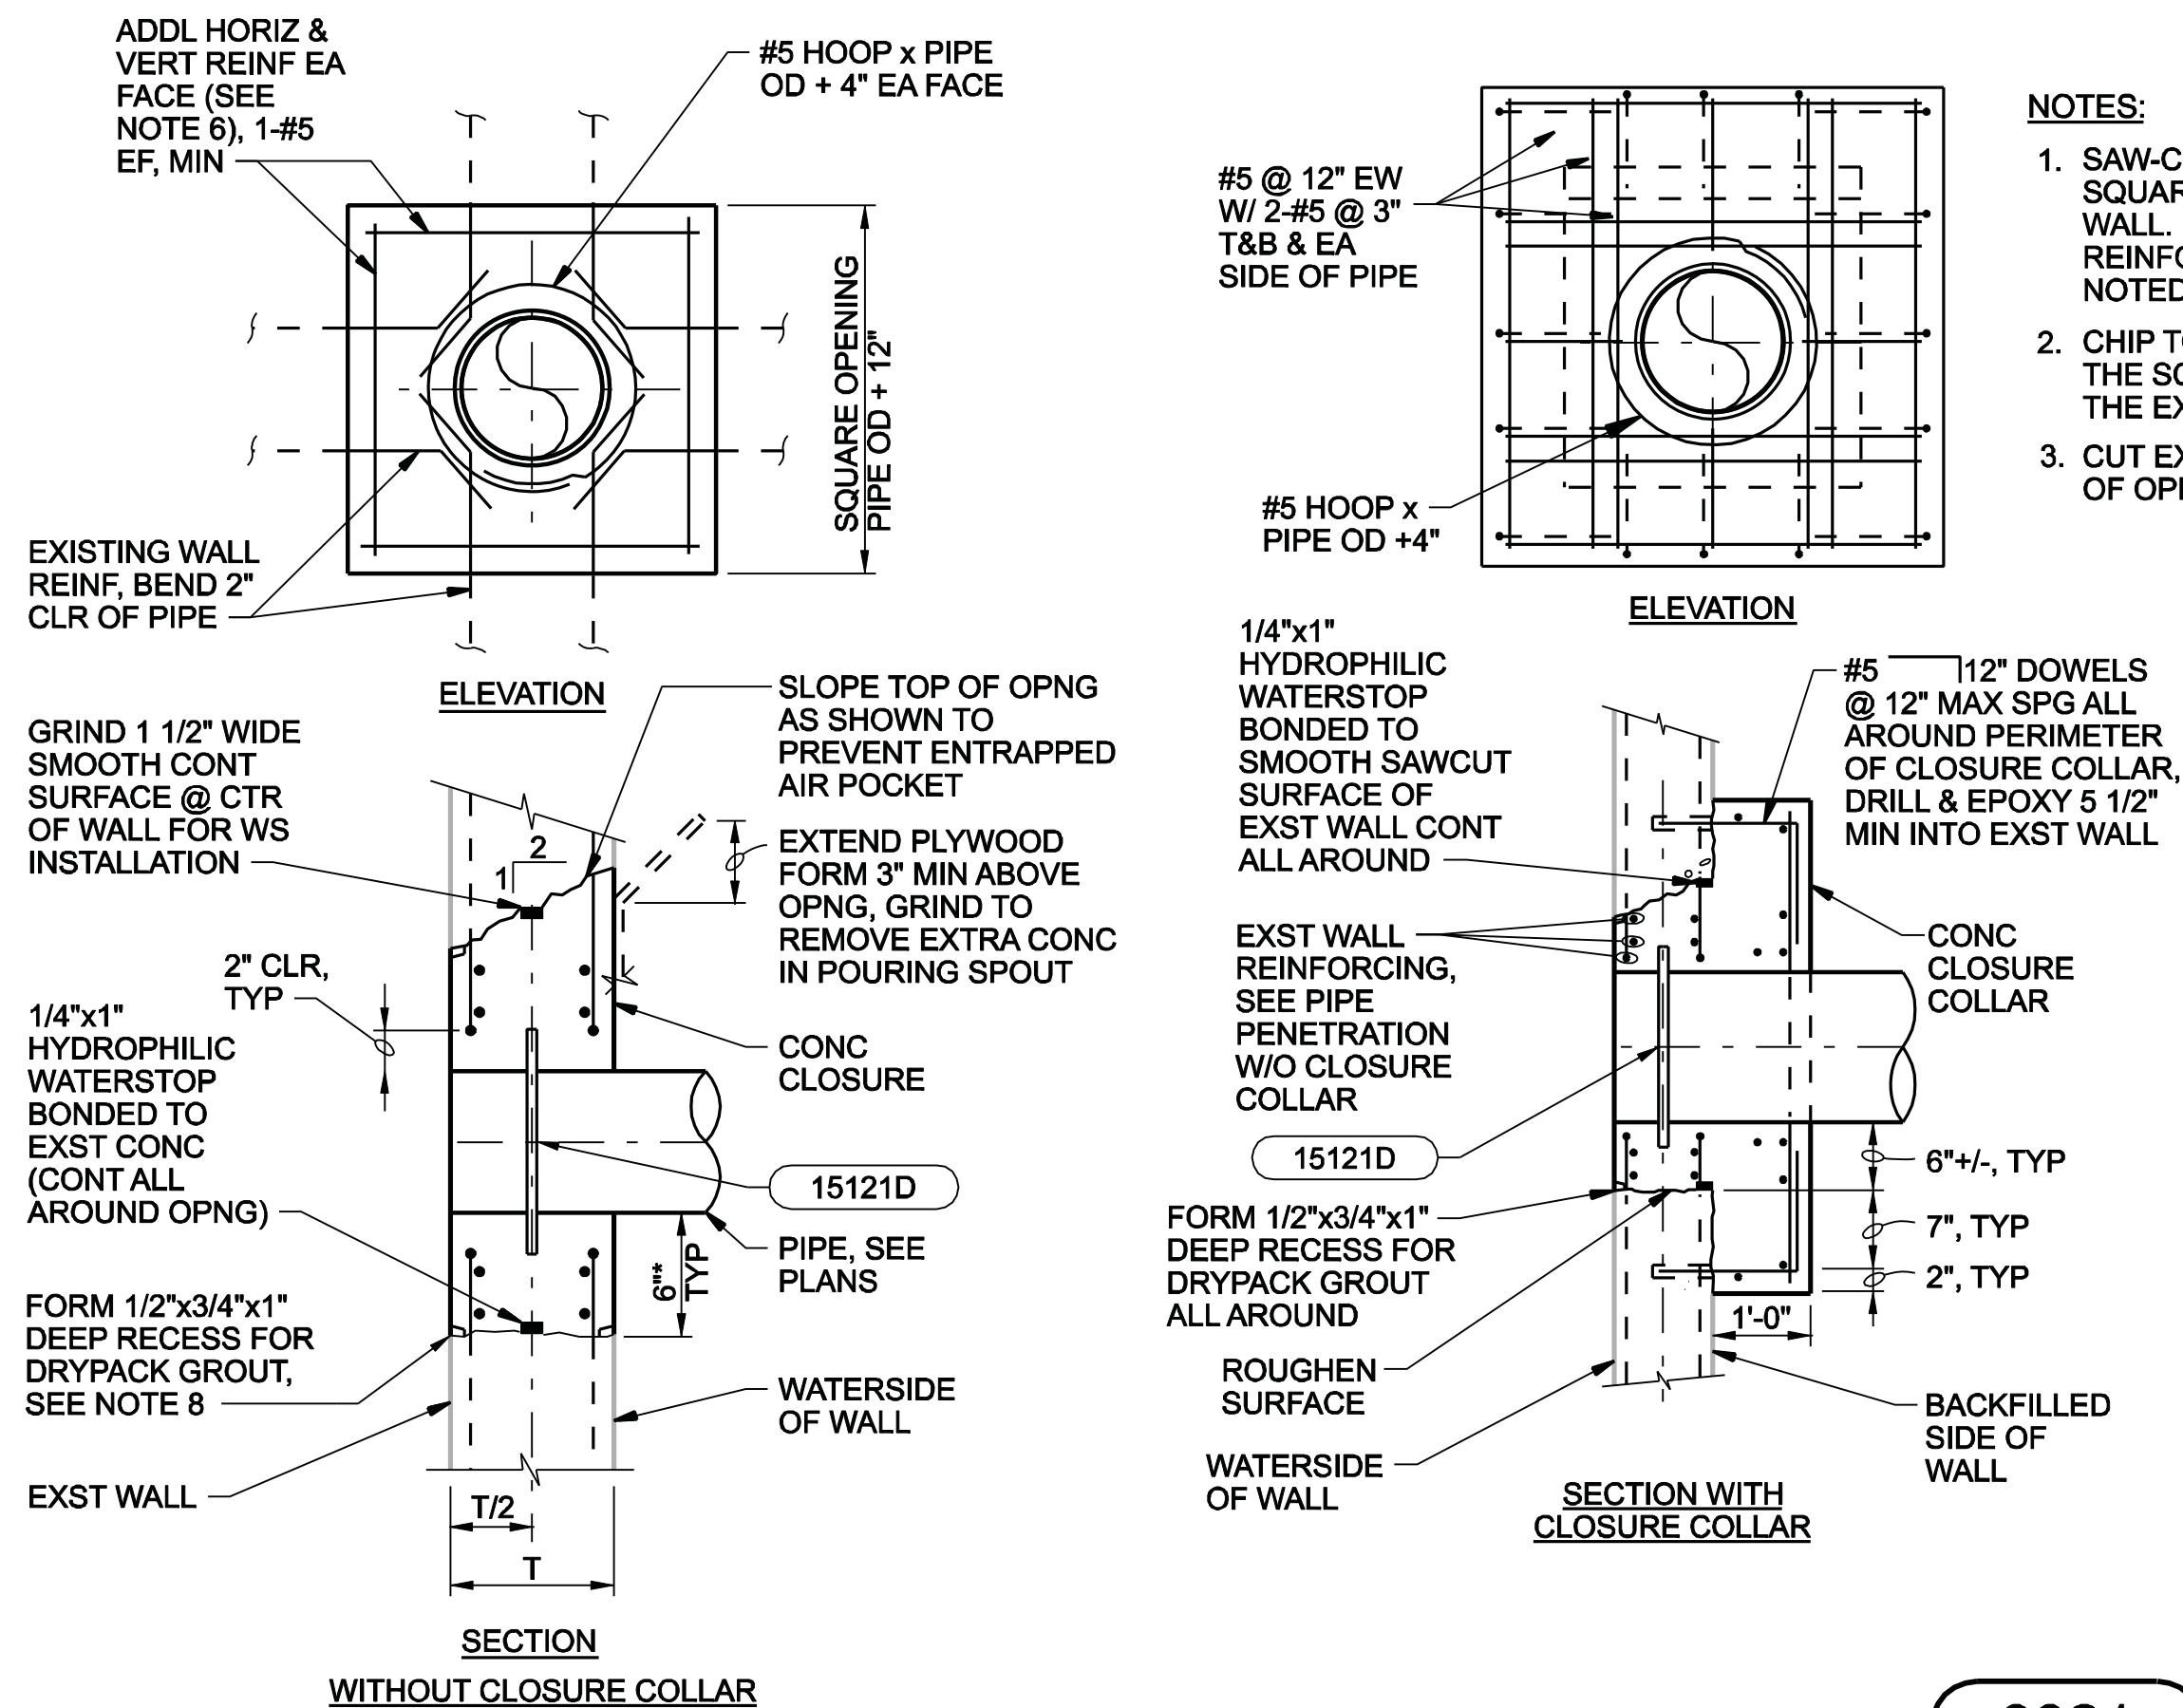


PENETRATION AT EXISTING WALL

NTS

3321

- NOTES:**
1. SAW-CUT 1-INCH DEEP x PIPE OD + 12" SQUARE SCORE LINE ON EACH FACE OF WALL. (VERIFY DEPTH OF CUT TO CLEAR REINFORCING.) (INCREASE HEIGHT AS NOTED AT TOP FOR POURING.)
 2. CHIP TO REMOVE THE CONCRETE WITHIN THE SCORE LINE, WHILE PRESERVING THE EXISTING WALL REINFORCING.
 3. CUT EXISTING REINFORCING AT CENTER OF OPENING AND BEND TO CLEAR PIPE.
 4. GRIND 1 1/2" WIDE x CONT SMOOTH SURFACE ALL AROUND THE OPENING AT CENTER OF WALL. CLEAN SURFACES AND BOND CONTINUOUS HYDROPHILIC WATERSTOP IN PLACE.
 5. INSTALL WALL PIPE. (COAT CONCRETE ENCASED PORTION OF PIPE WITH SPECIFIED COATING SYSTEM.)
 6. INSTALL ADDITIONAL REINFORCING EACH FACE, EACH SIDE, ABOVE AND BELOW PIPE. HORIZONTAL REINFORCING TO HAVE COMBINED AREA EQUAL TO AREA OF HORIZONTAL REINFORCING CUT. VERTICAL REINFORCING TO HAVE COMBINED AREA EQUAL TO AREA OF VERTICAL REINFORCING CUT.
 7. COAT EXISTING CONCRETE SURFACES WITH EPOXY BONDING AGENT. FORM GROOVE ON ALL SIDES OF OPENING EXCEPT AT TOP ON THE POUR SIDE.
 8. CLEAN SURFACES OF FORMED GROOVE WITH POWER WIRE BRUSH OR SANDBLASTING AND DRY-PACK WITH NON-SHRINK GROUT AFTER NEW CONCRETE MIN 28-DAYS OLD.








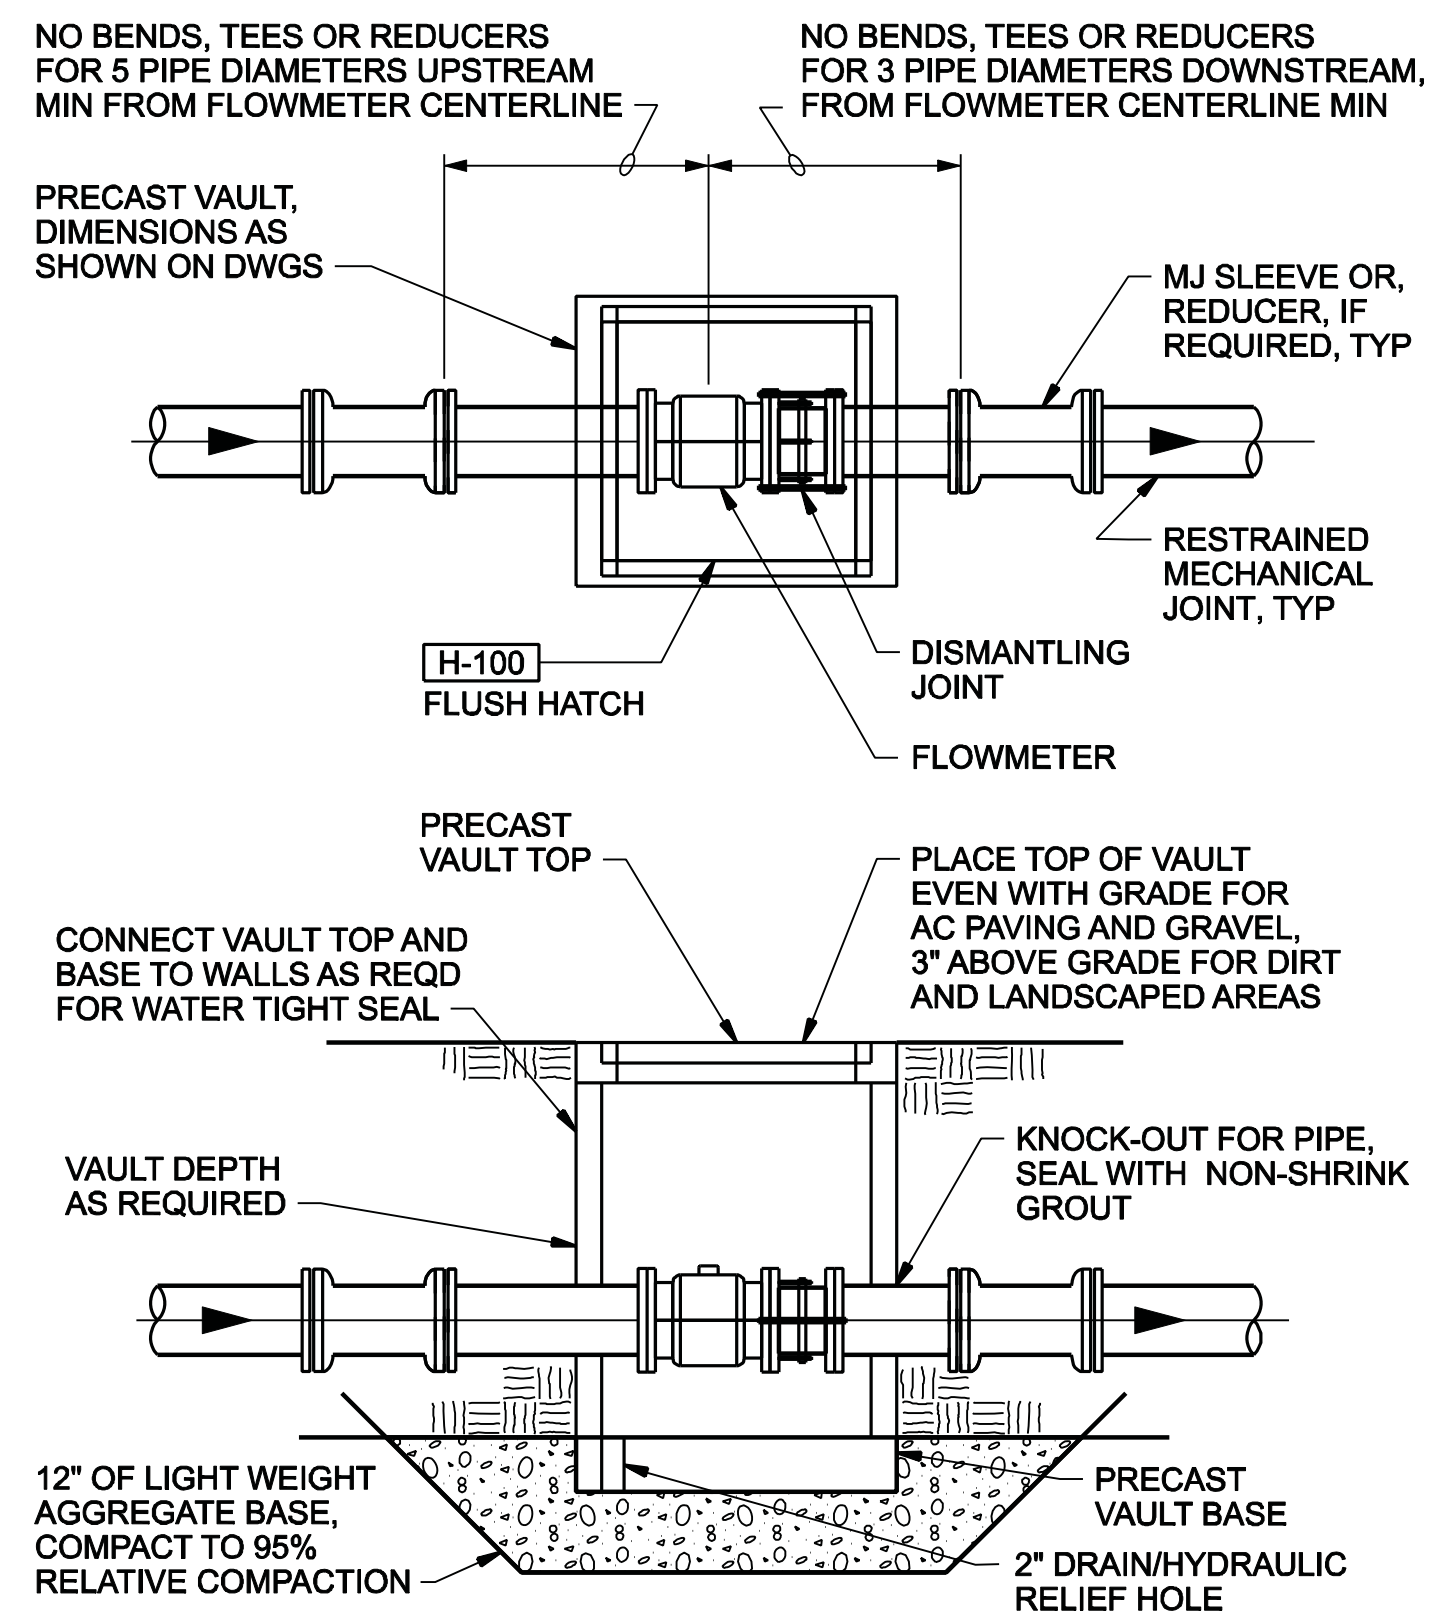



FLOWMETER MANHOLE

NTS

13254




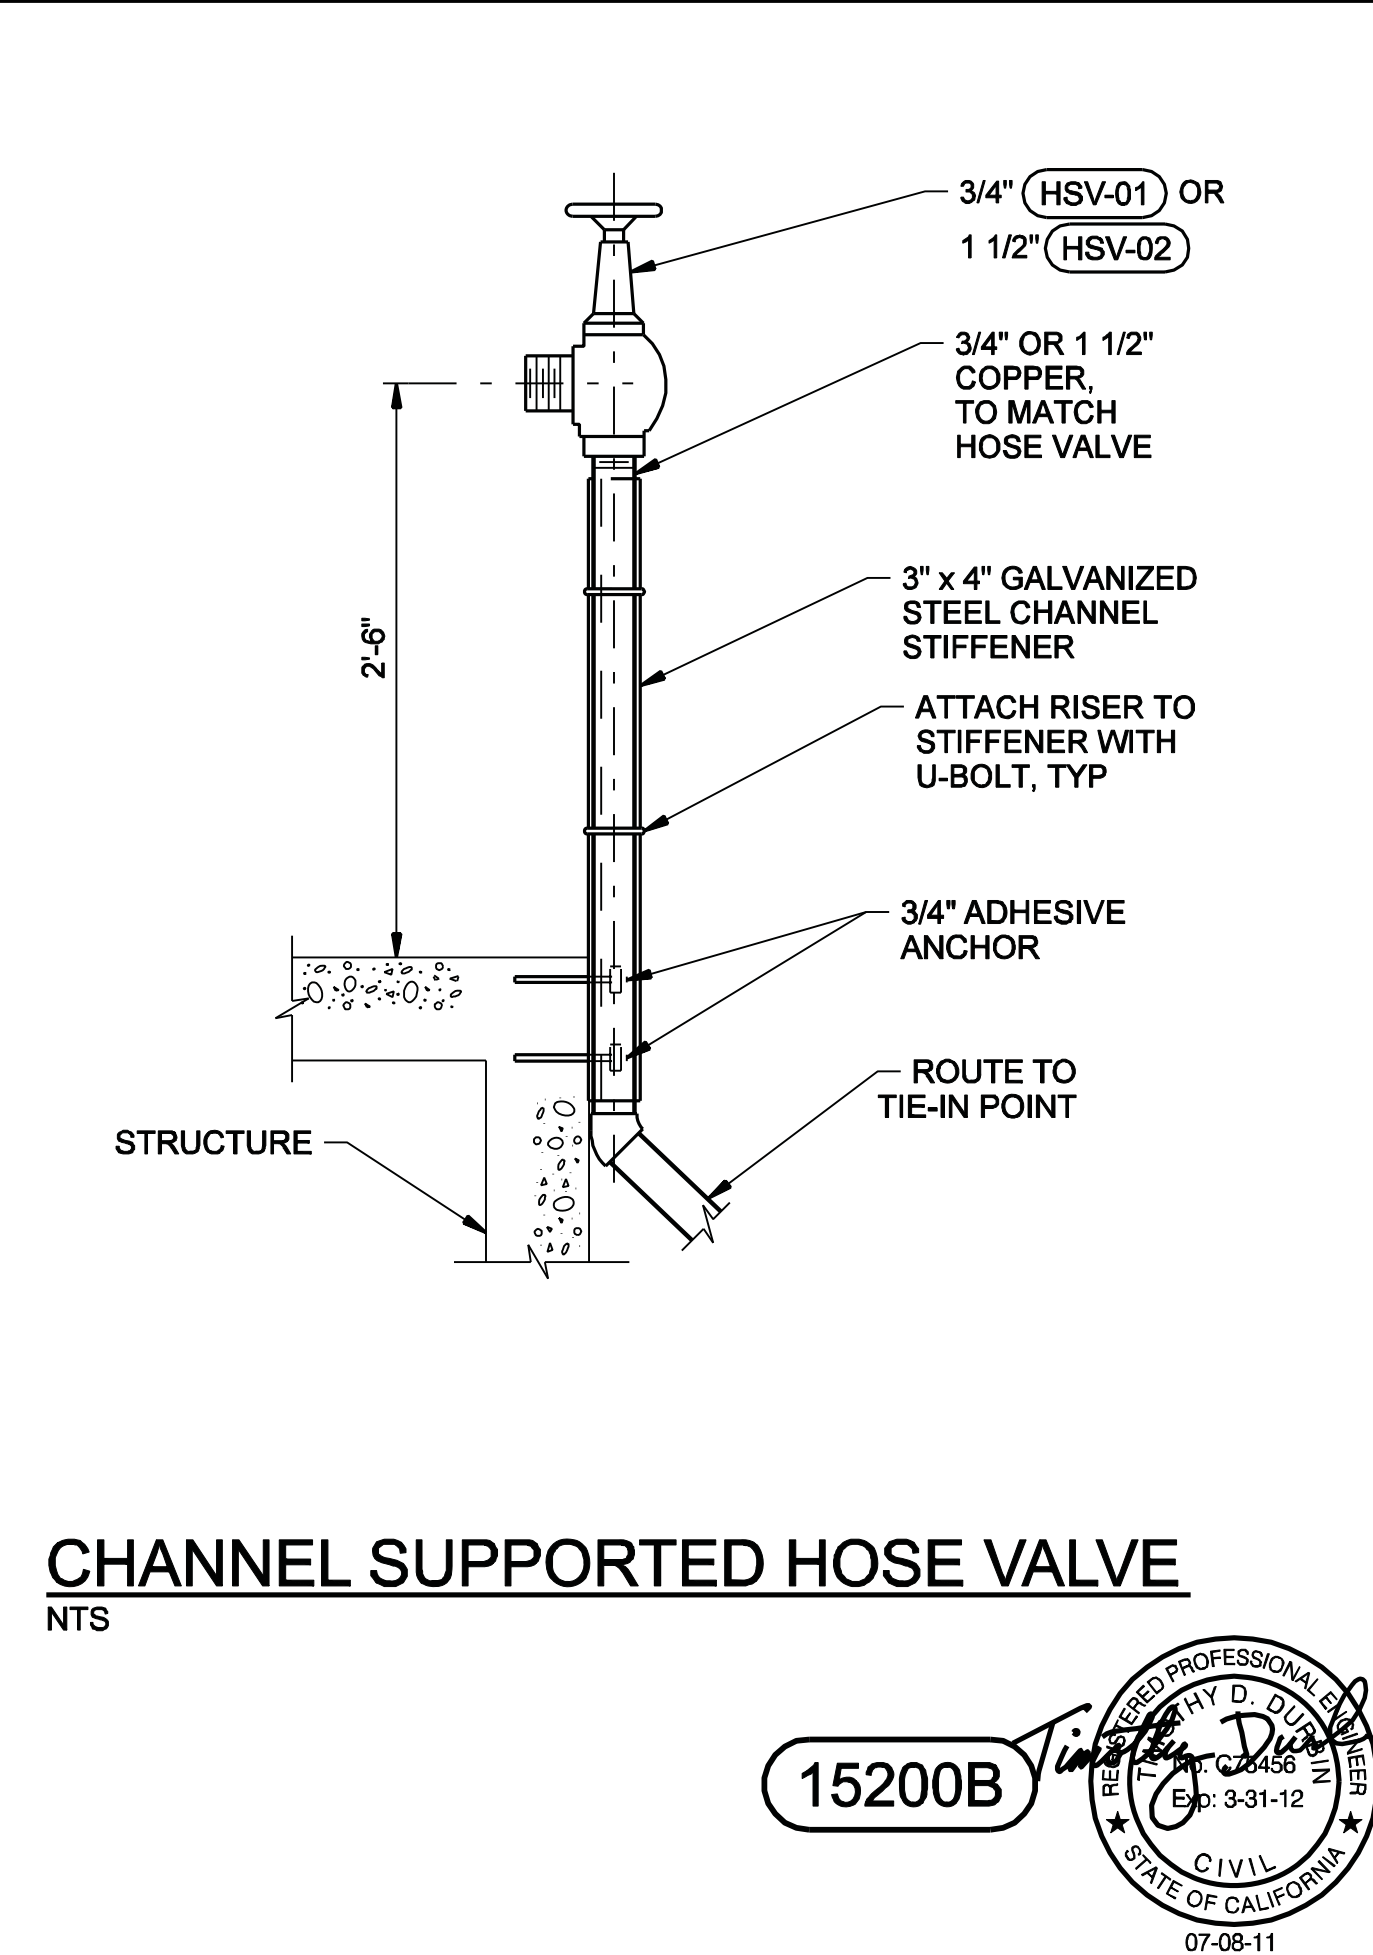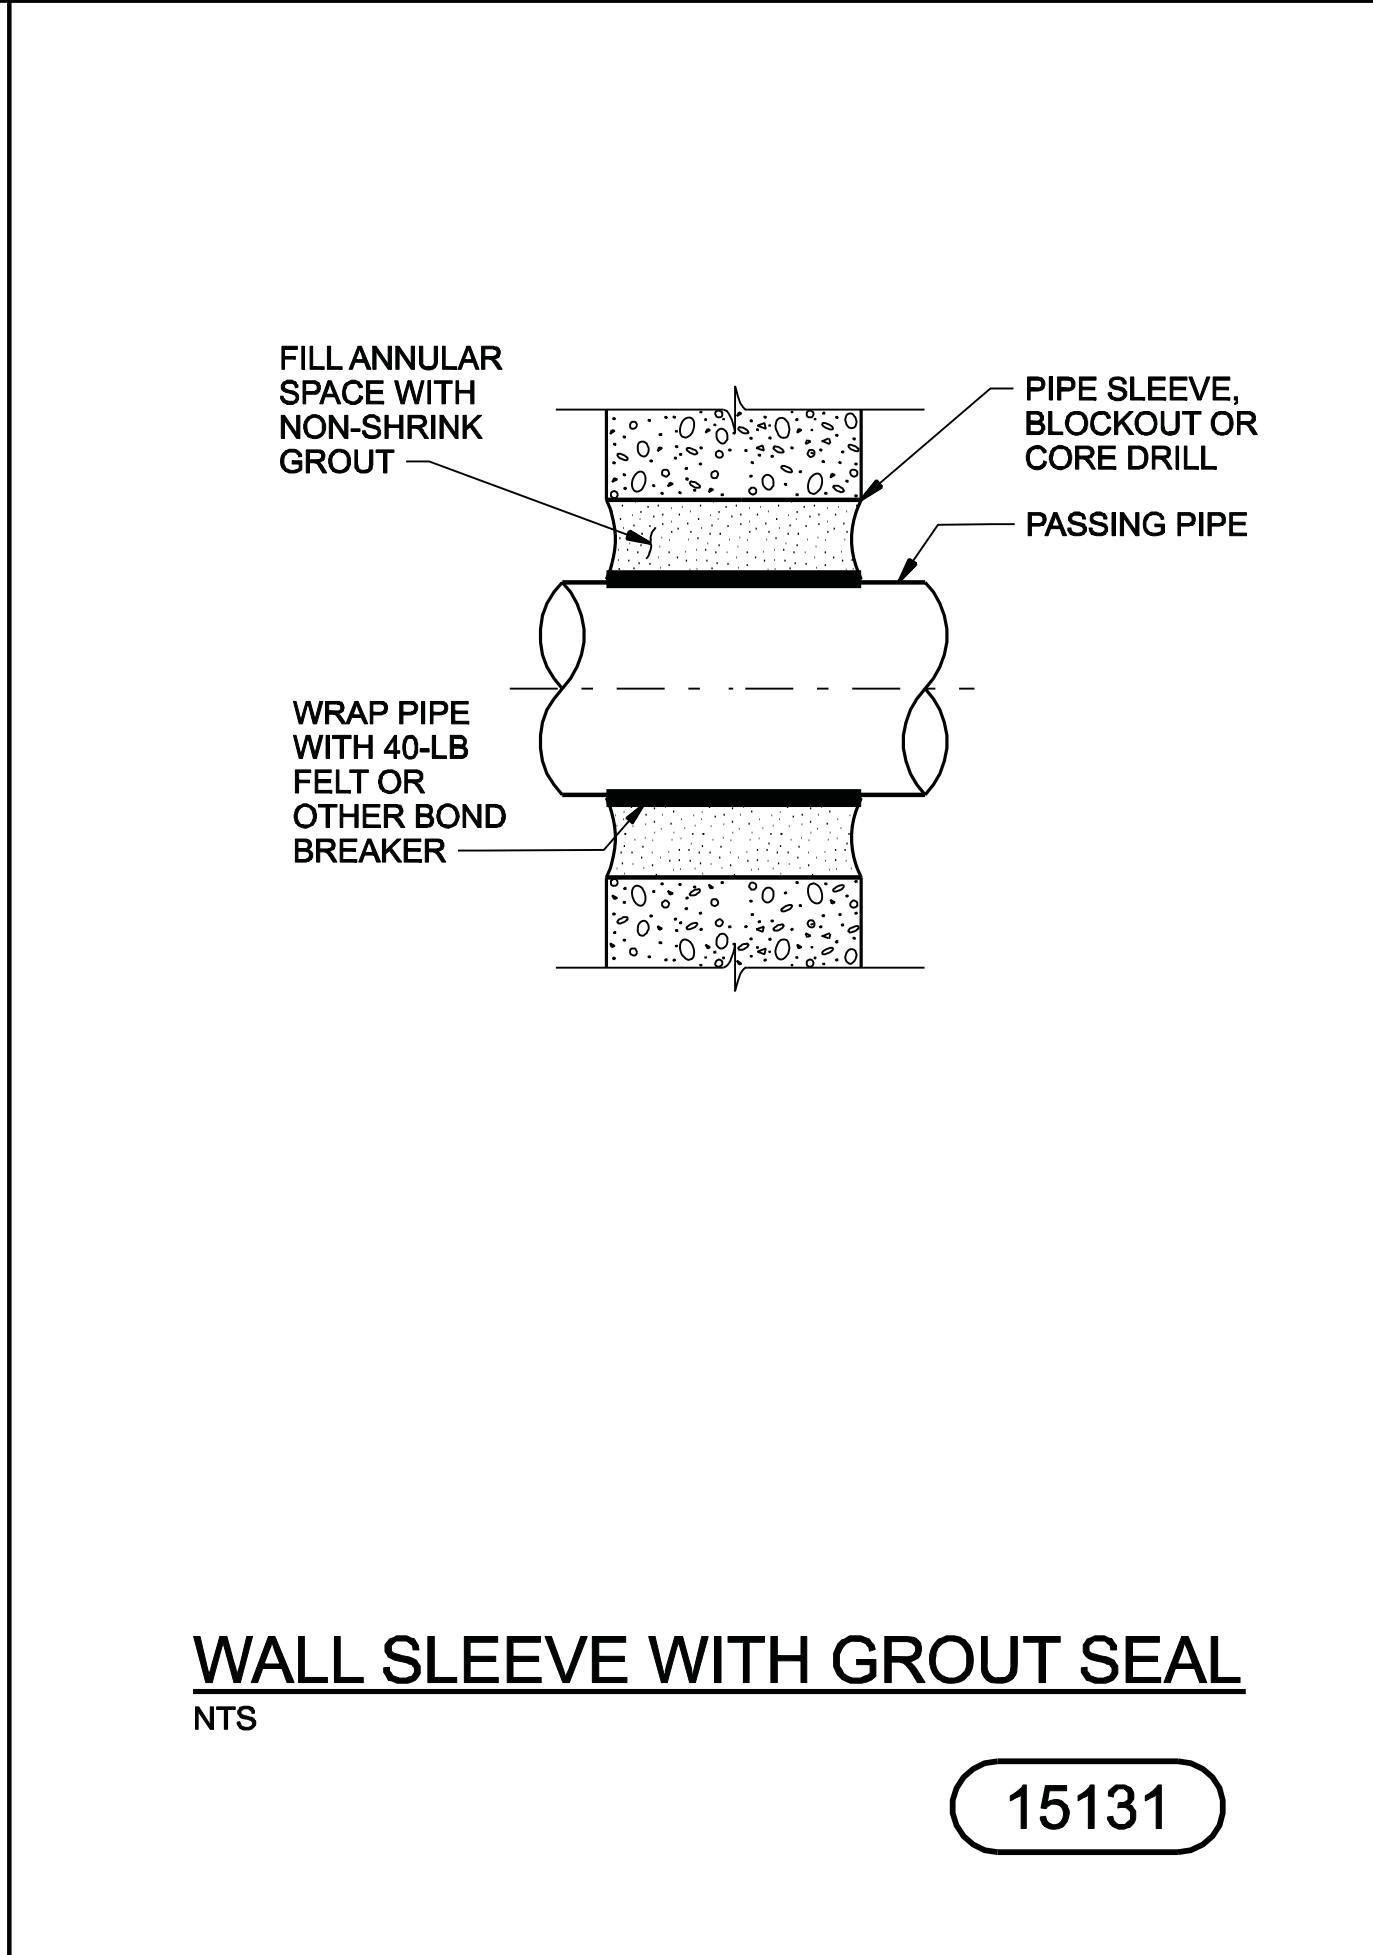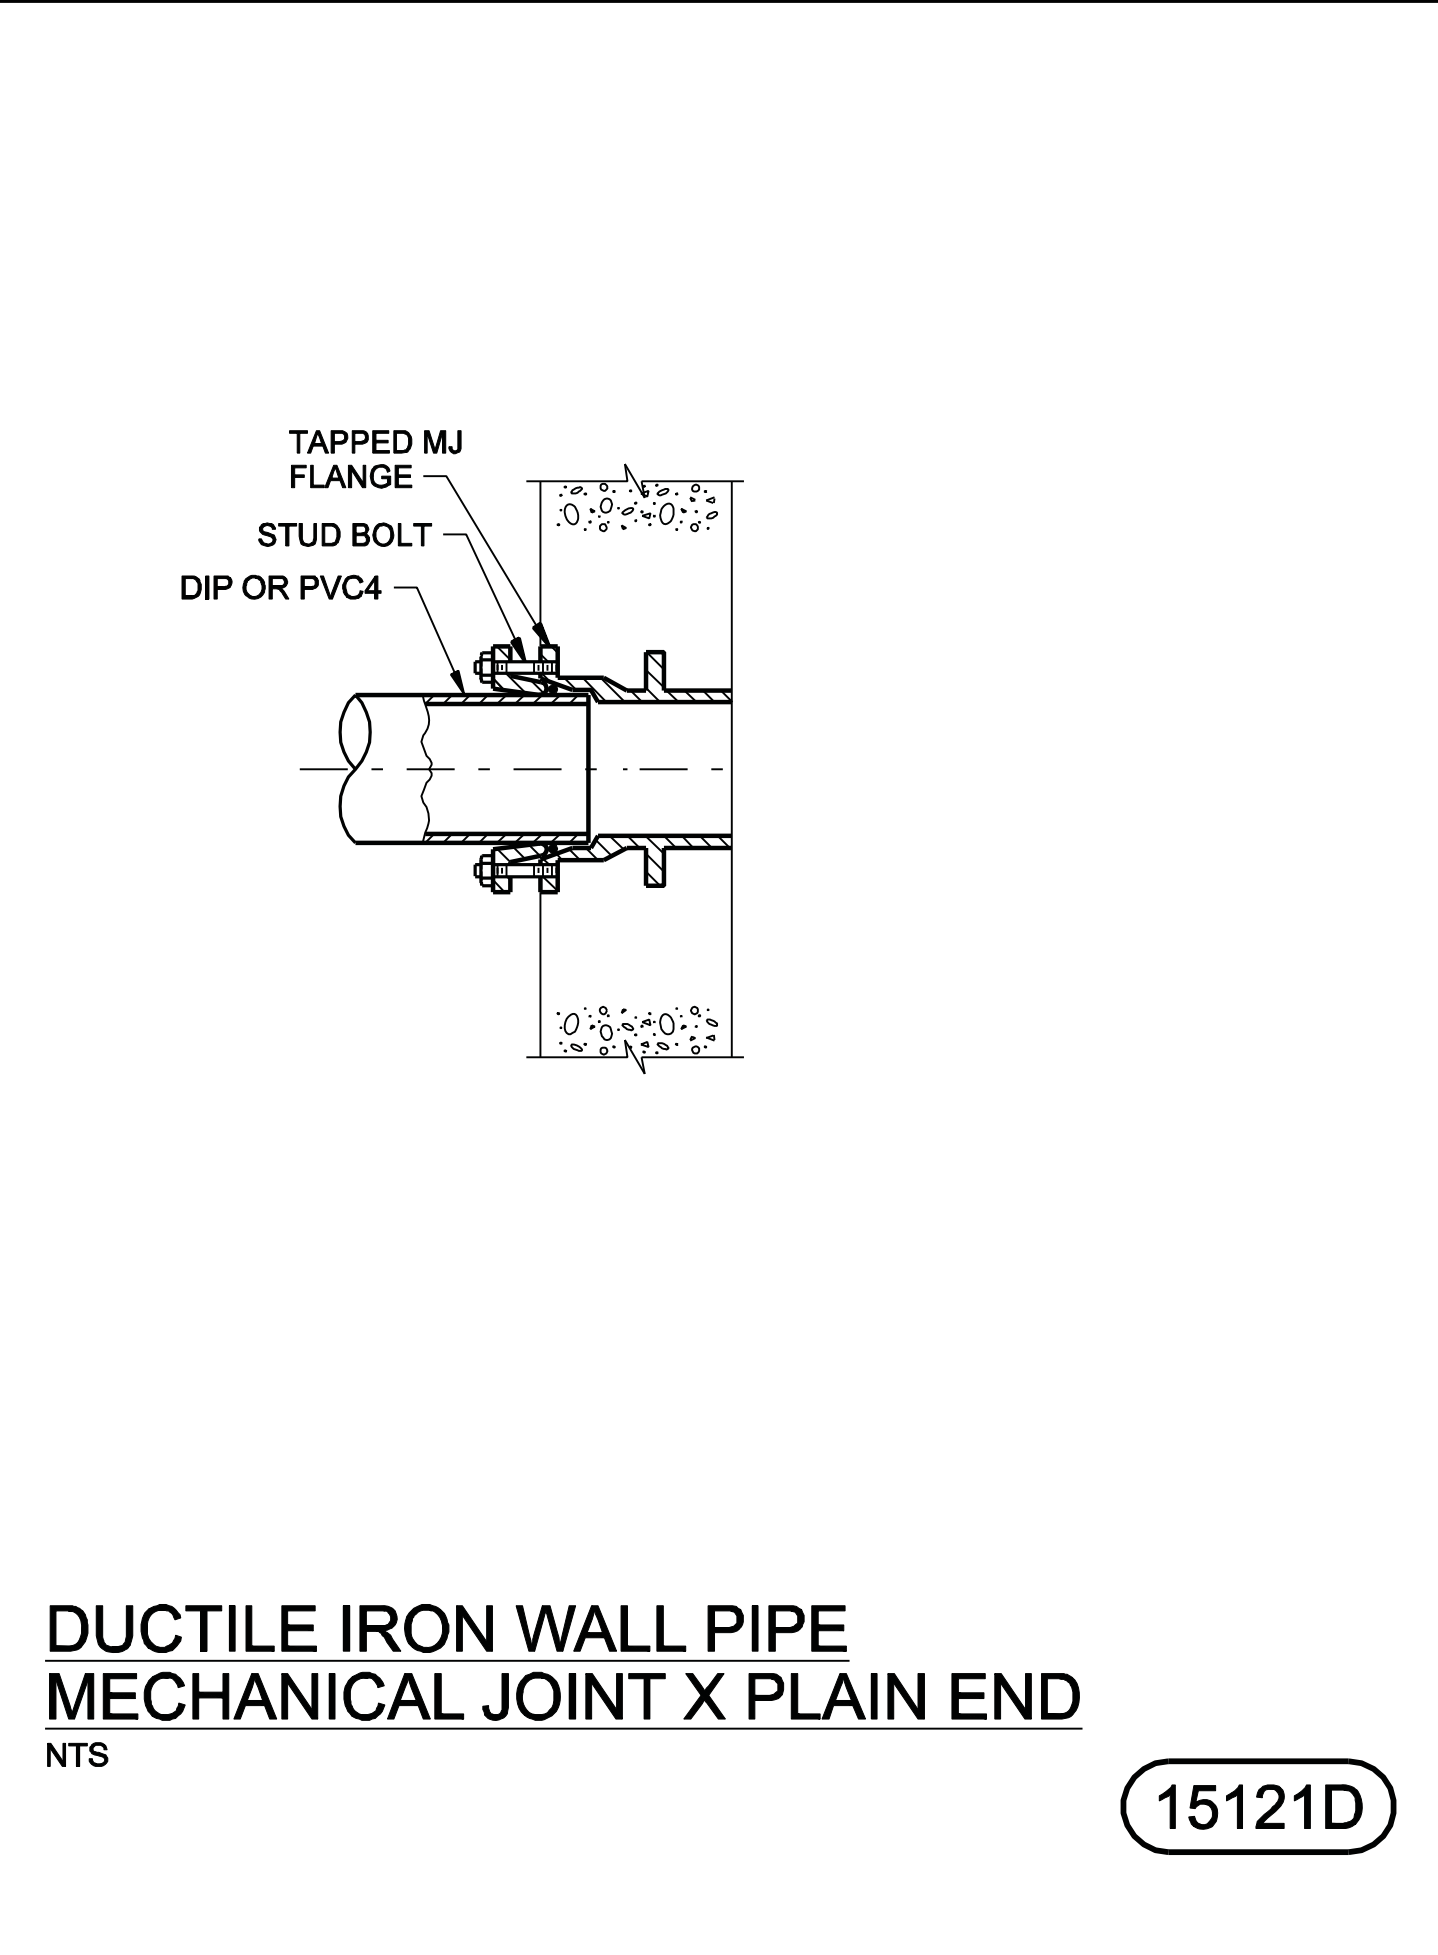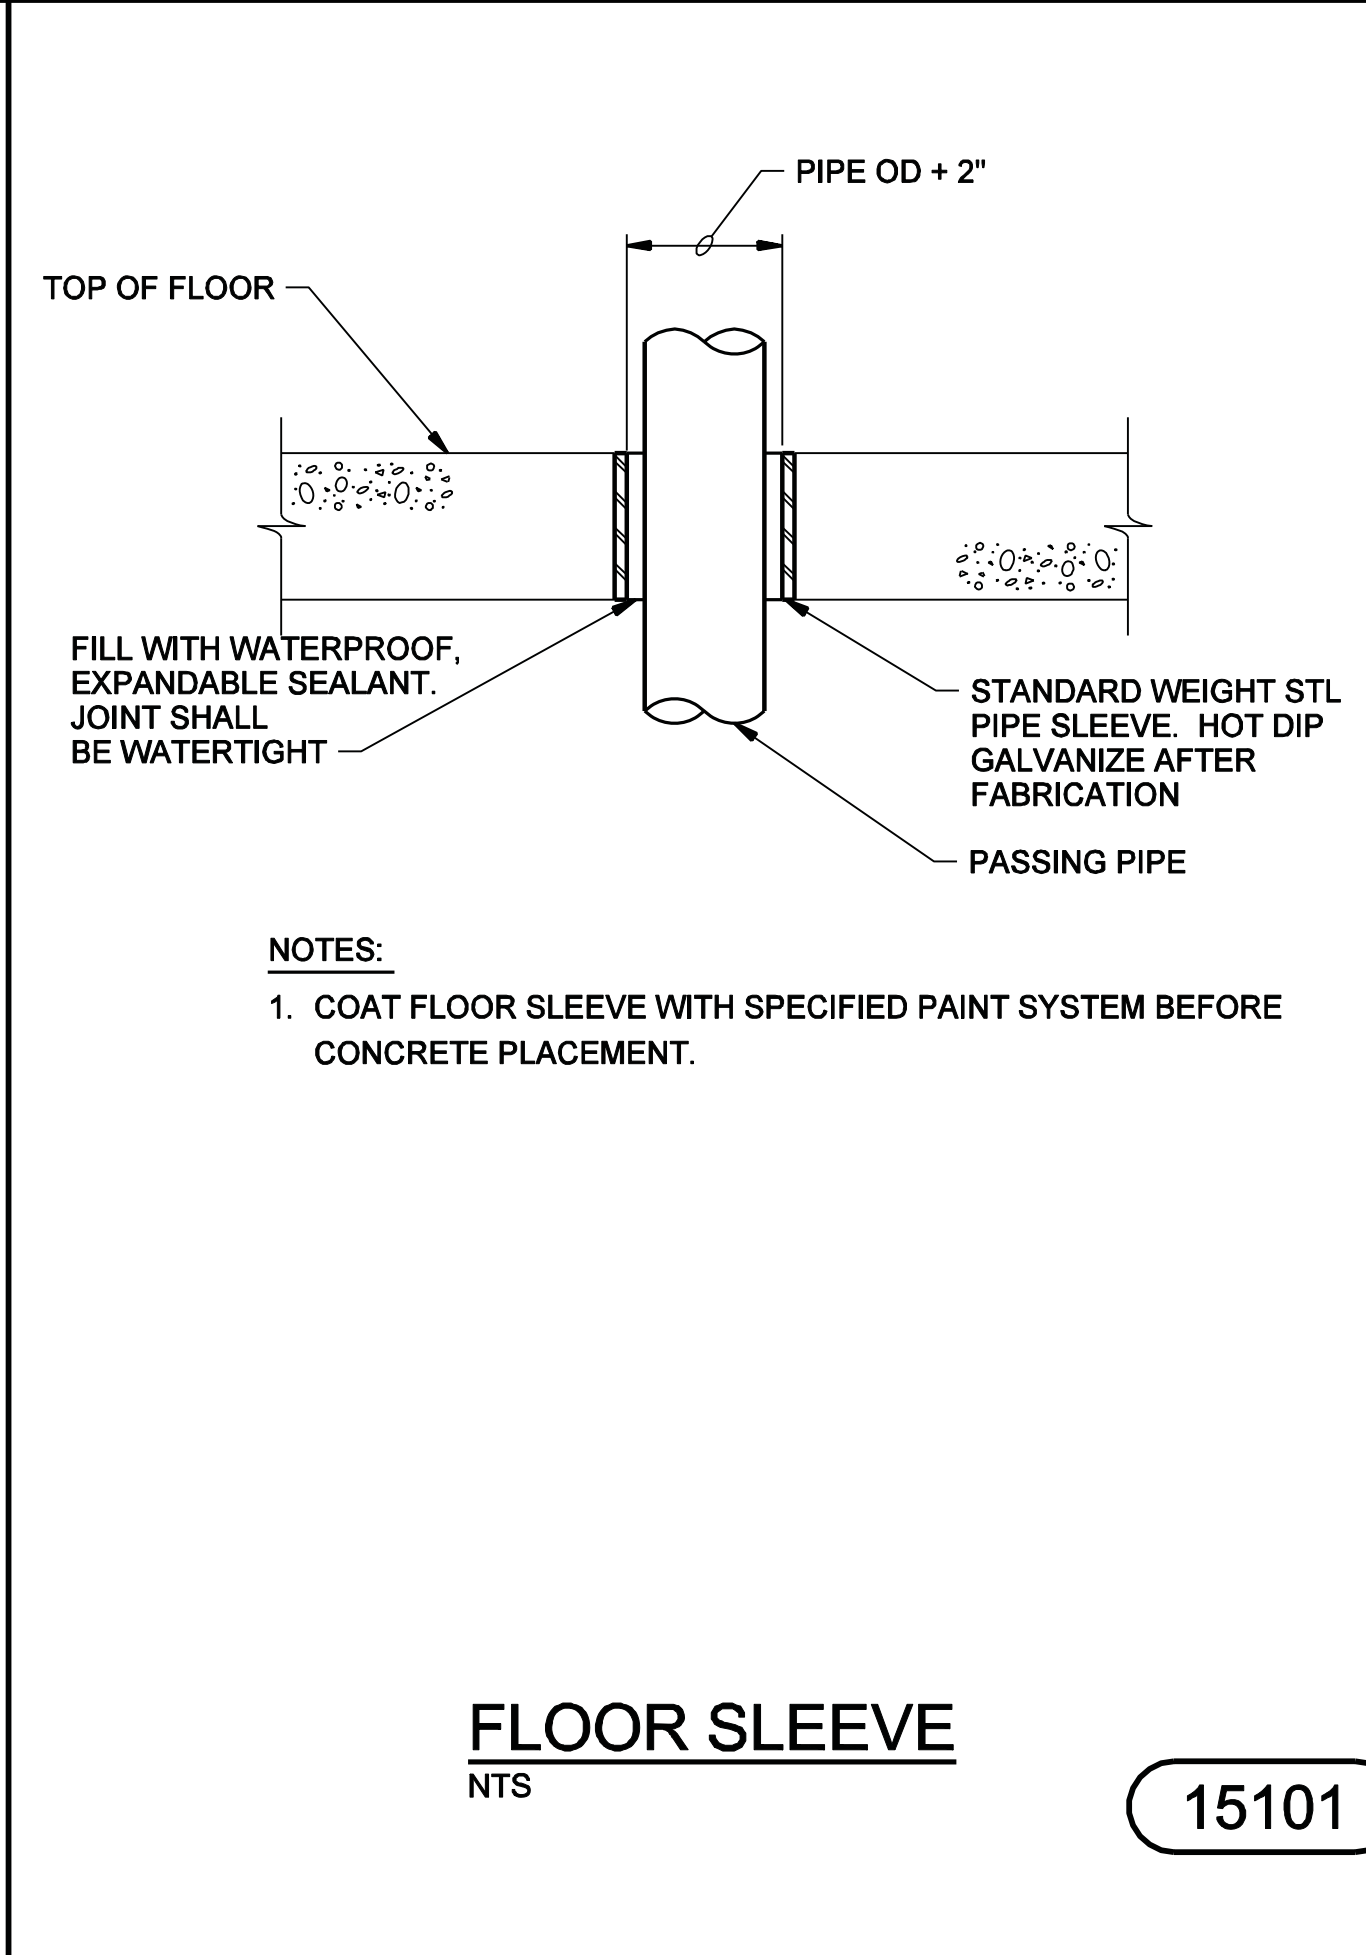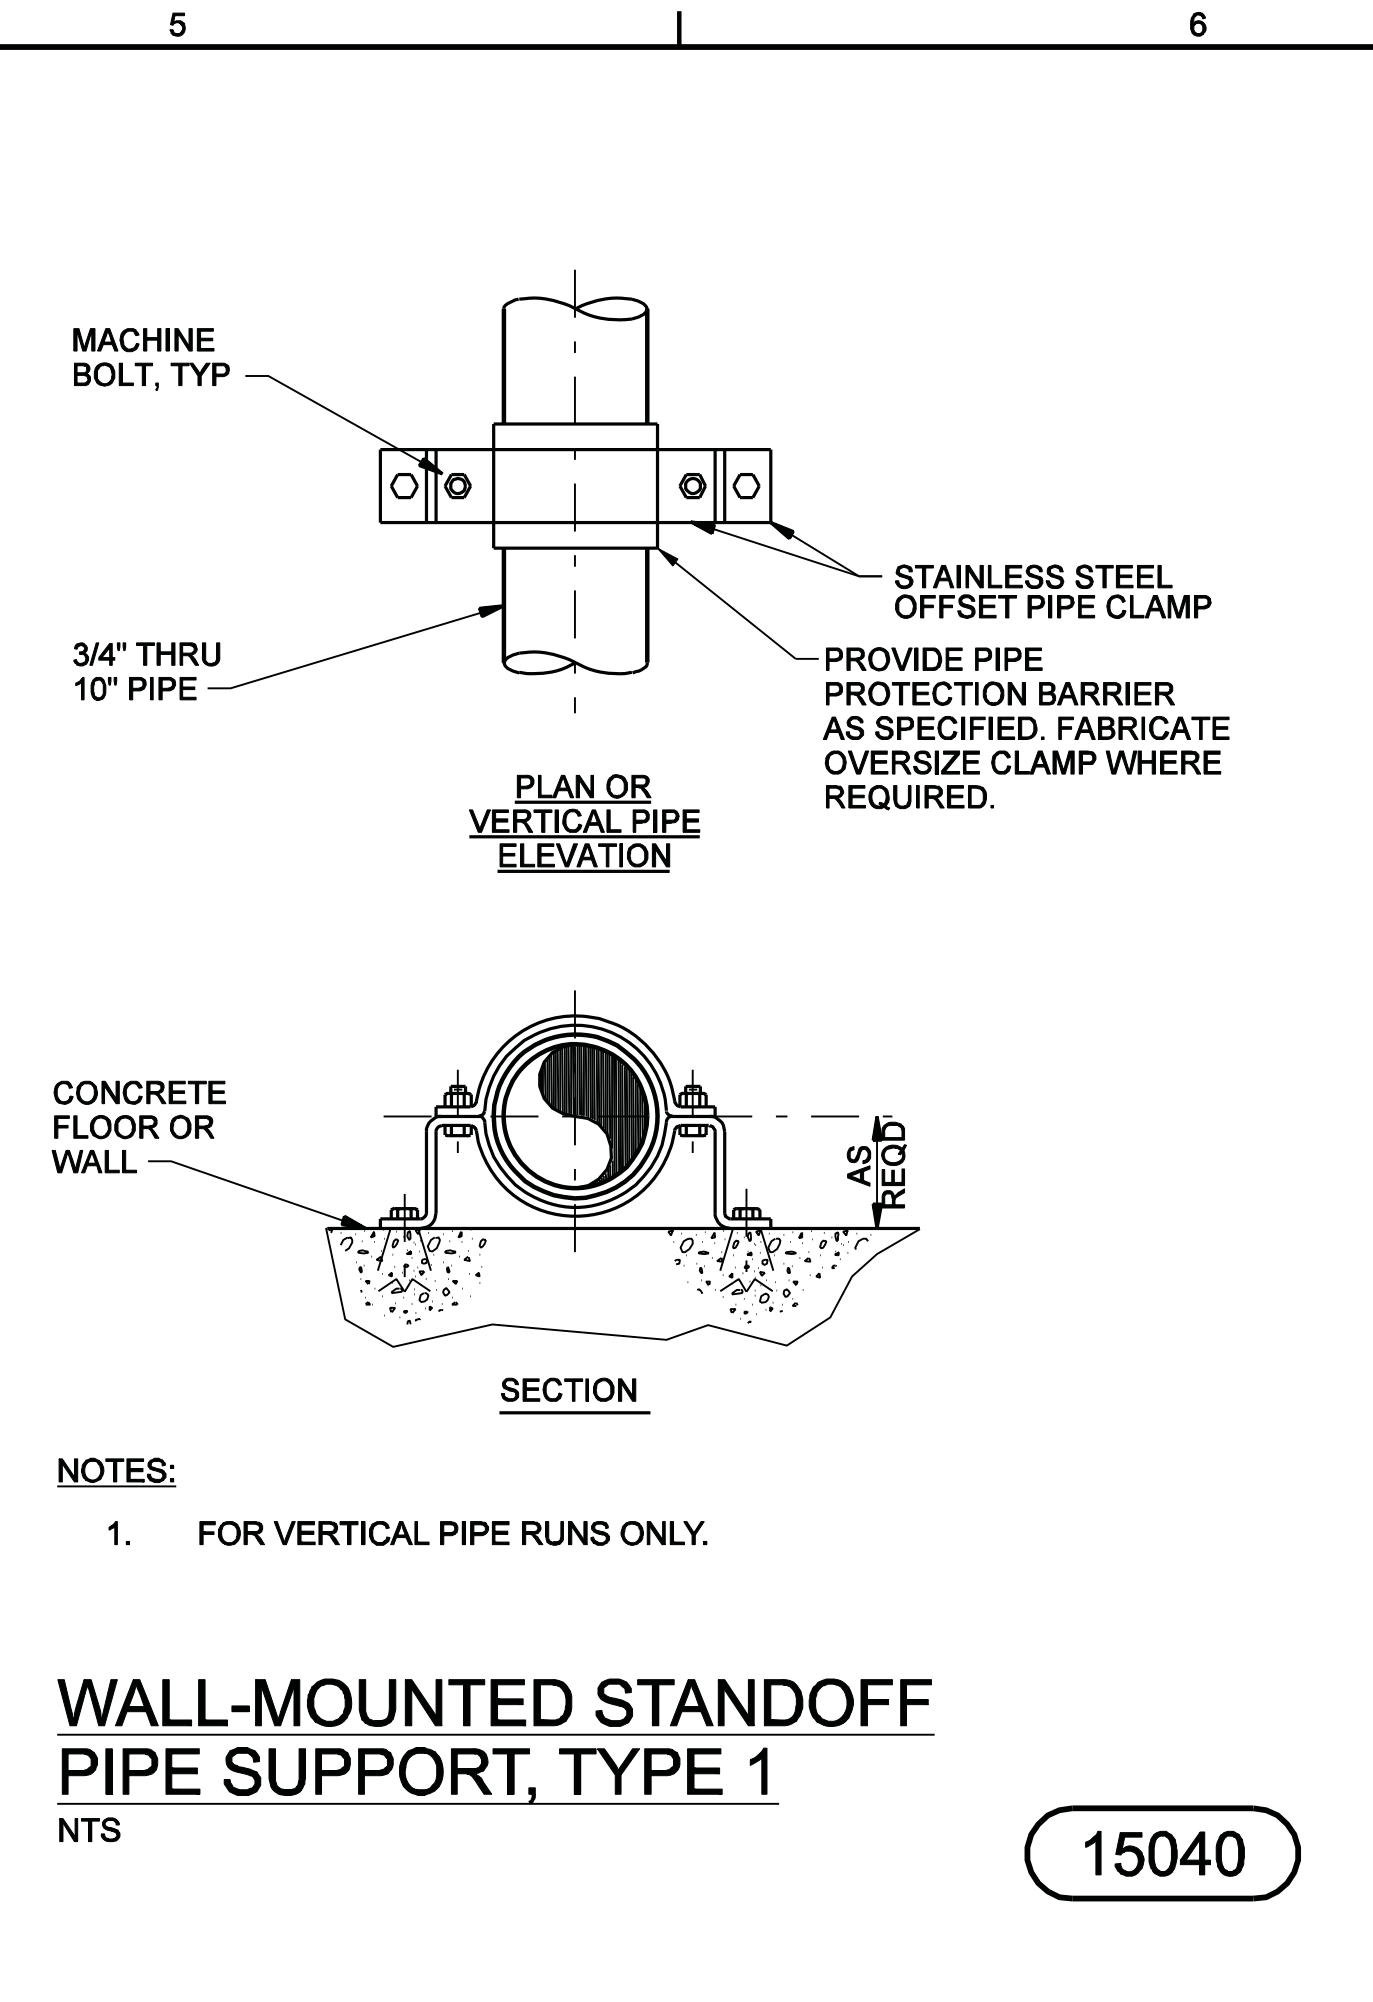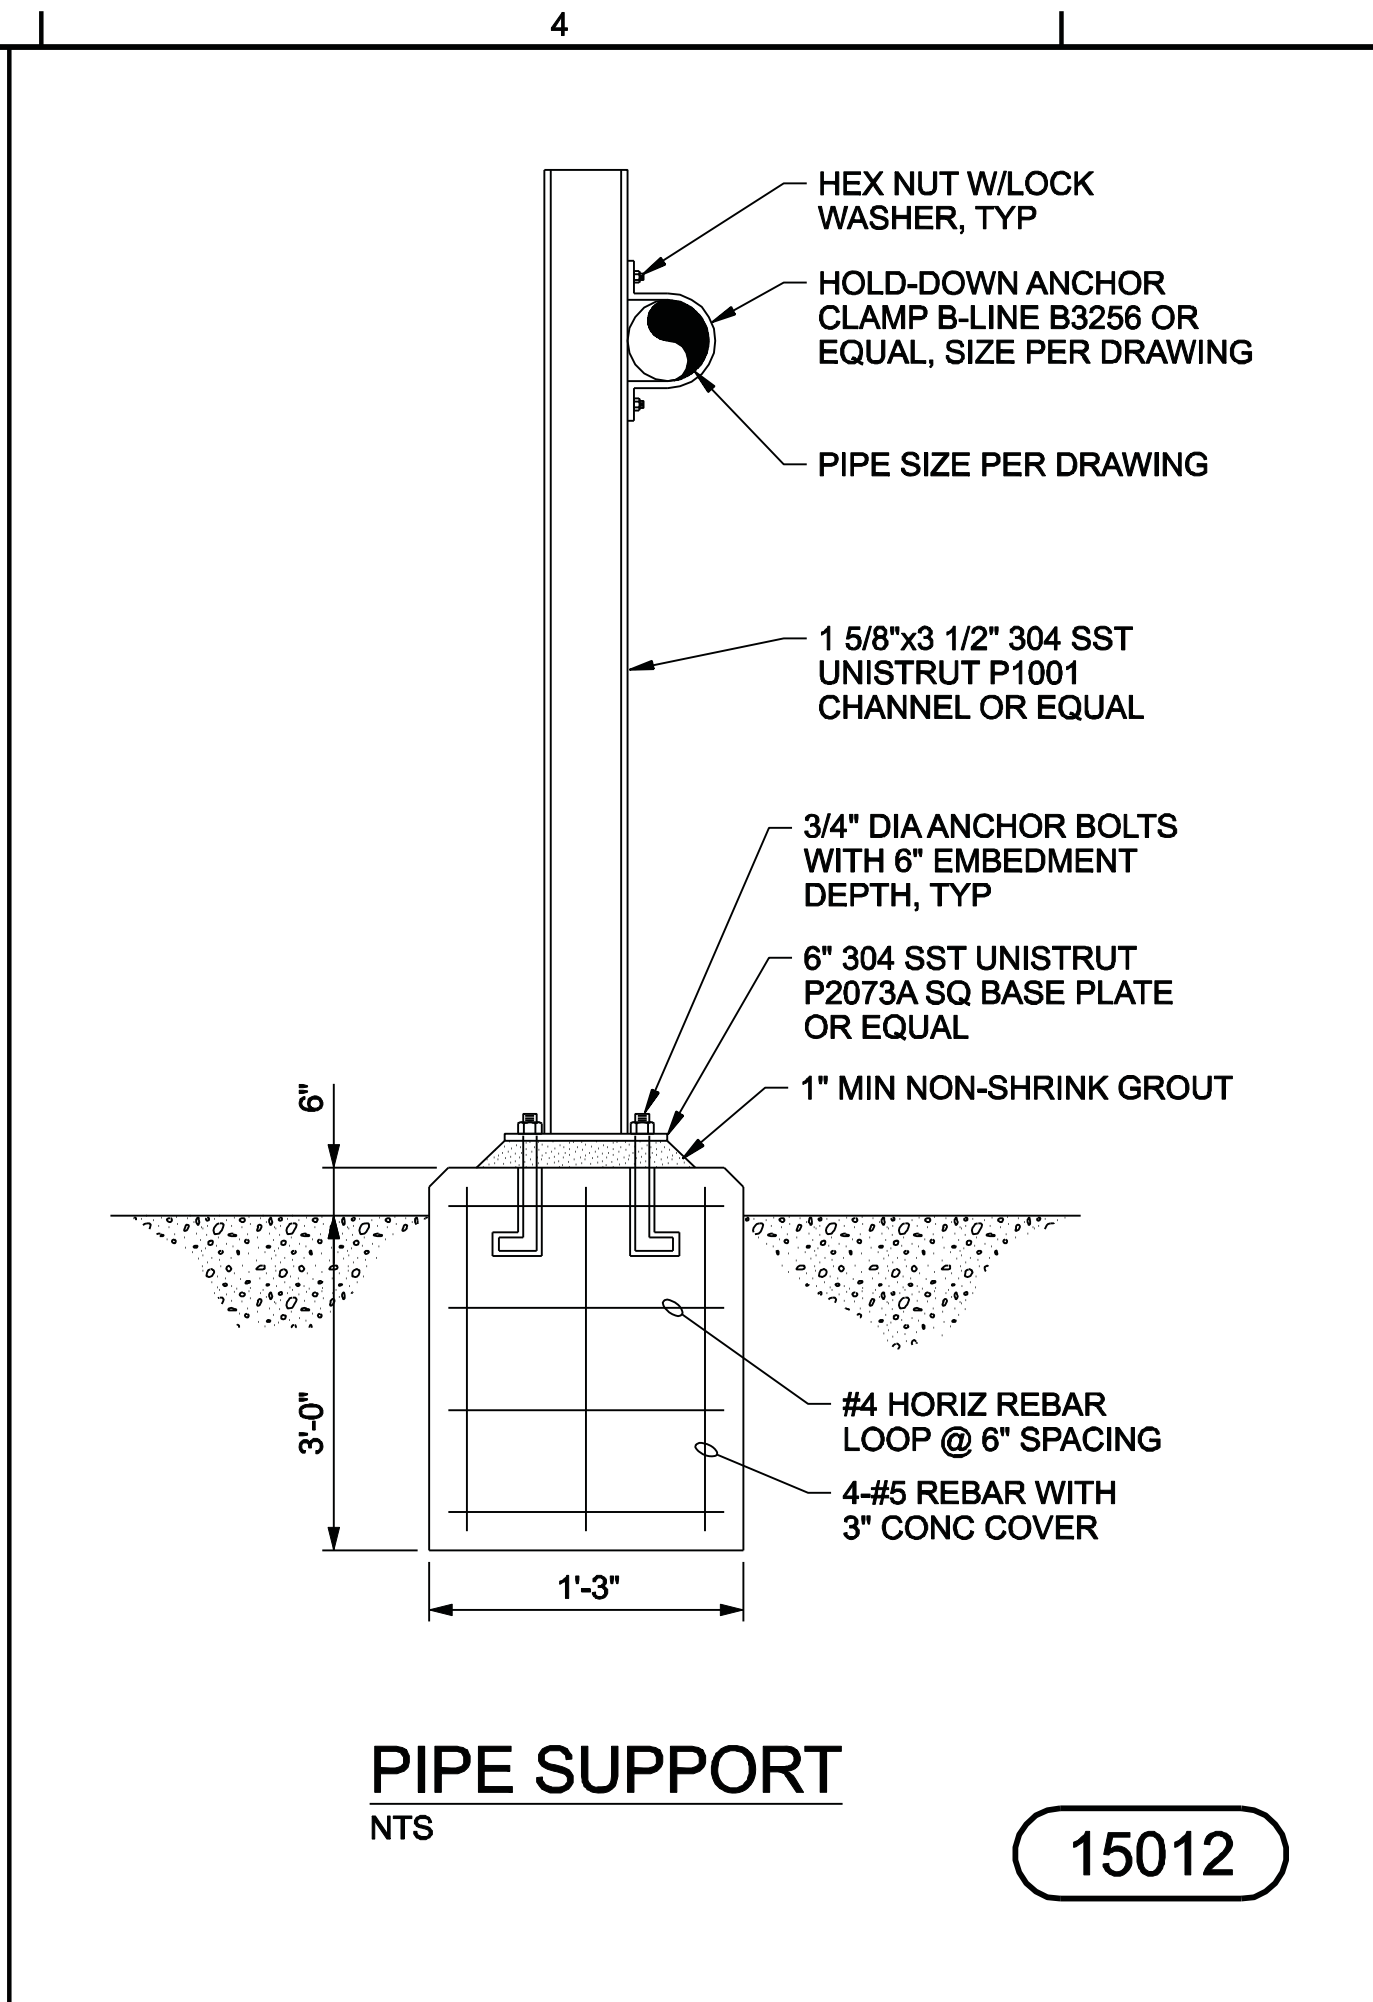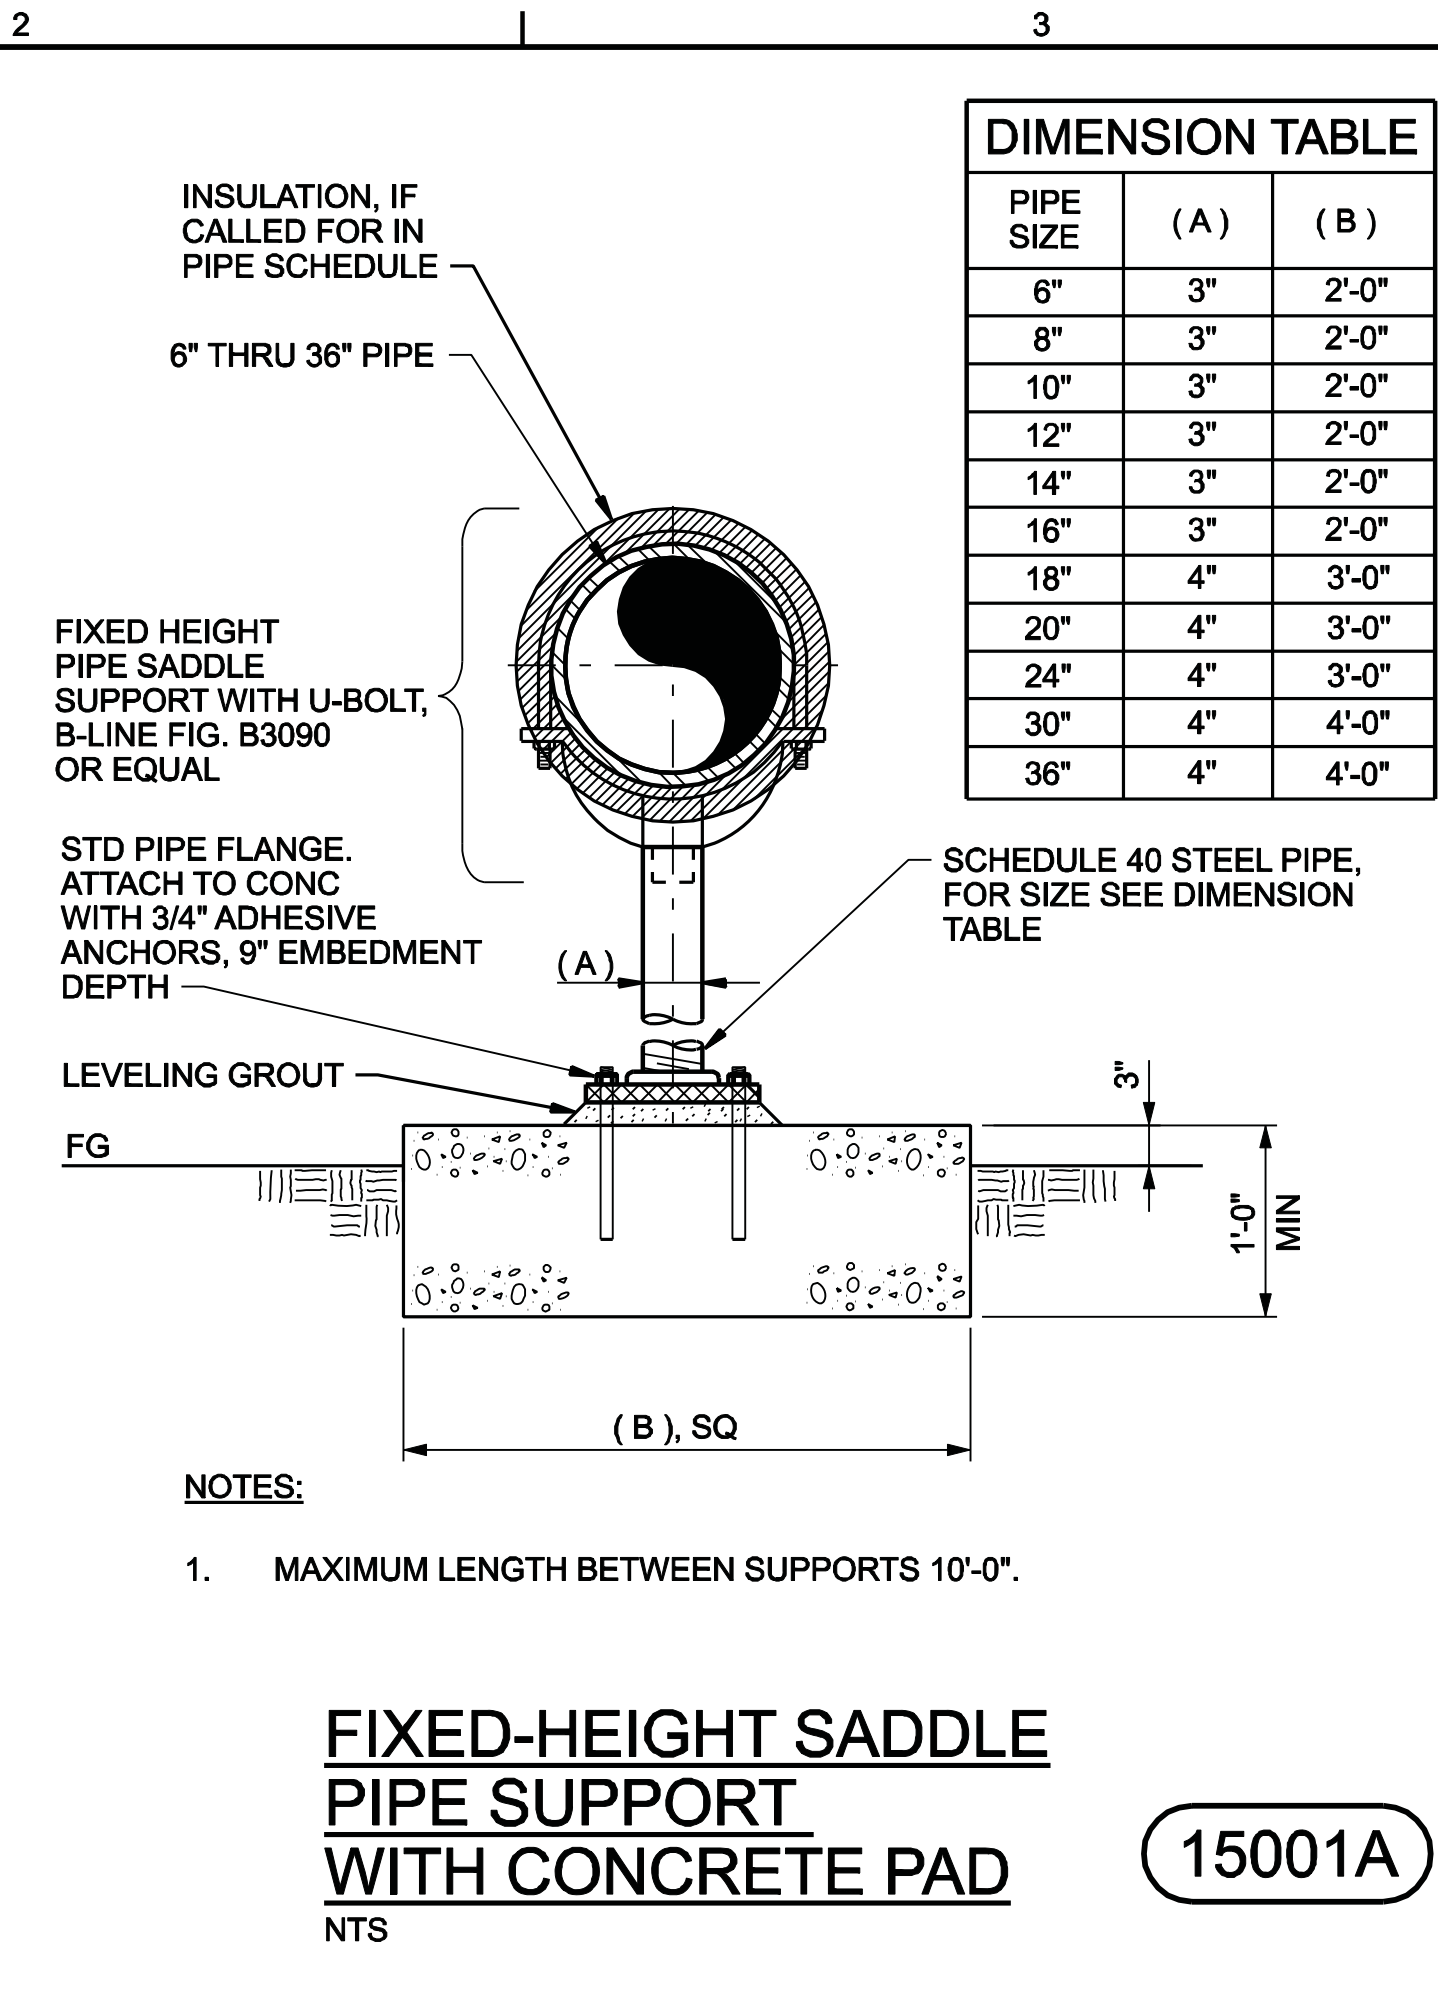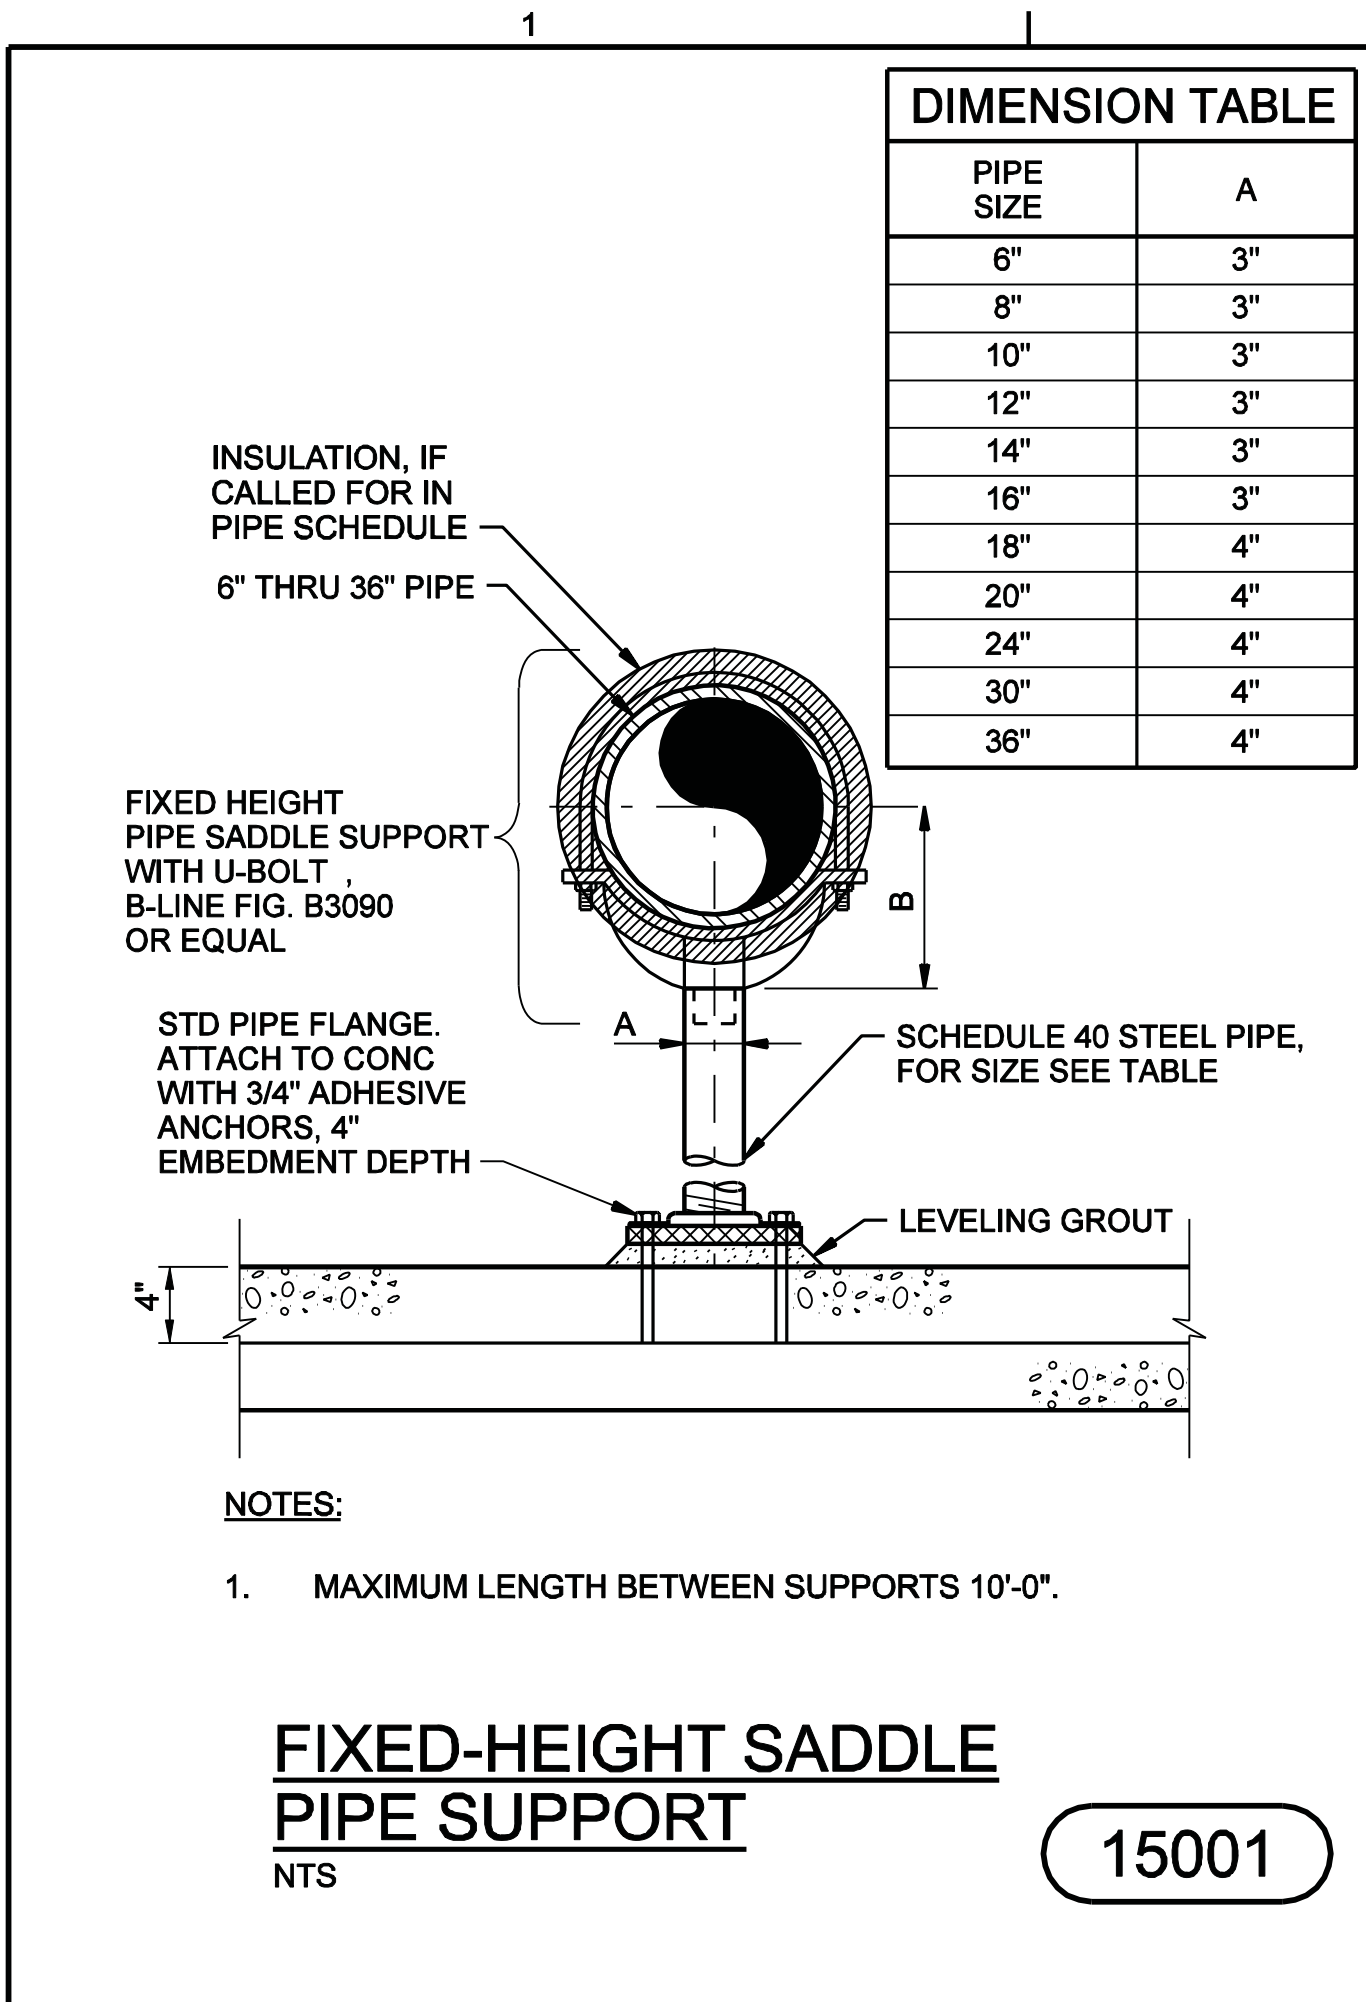

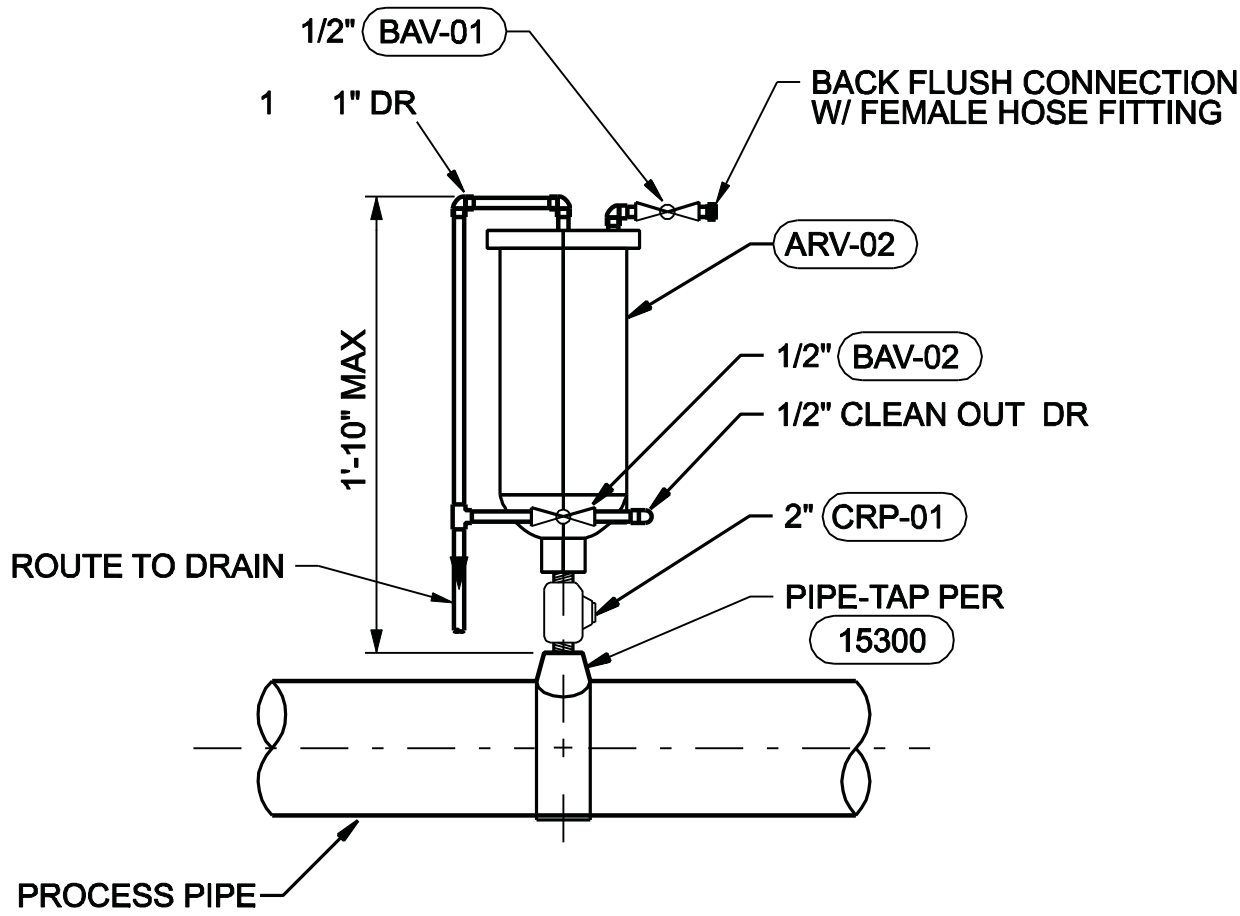


**AIR RELEASE VALVE INSTALLATION
SEWER SERVICE**
NTS

15231

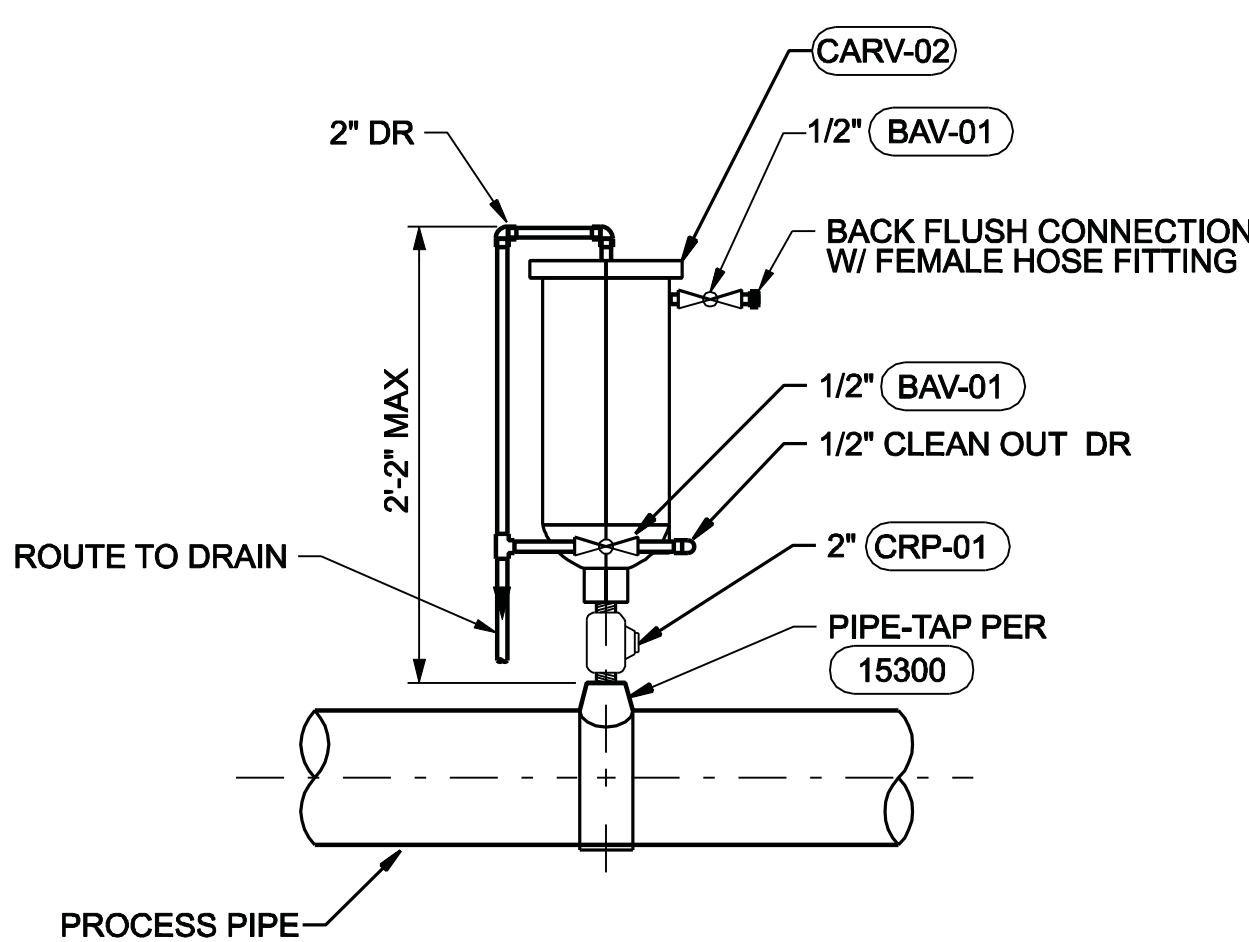

**COMBINATION AIR AND VACUUM
RELEASE VALVE INSTALLATION
SEWER SERVICE**
NTS

15233

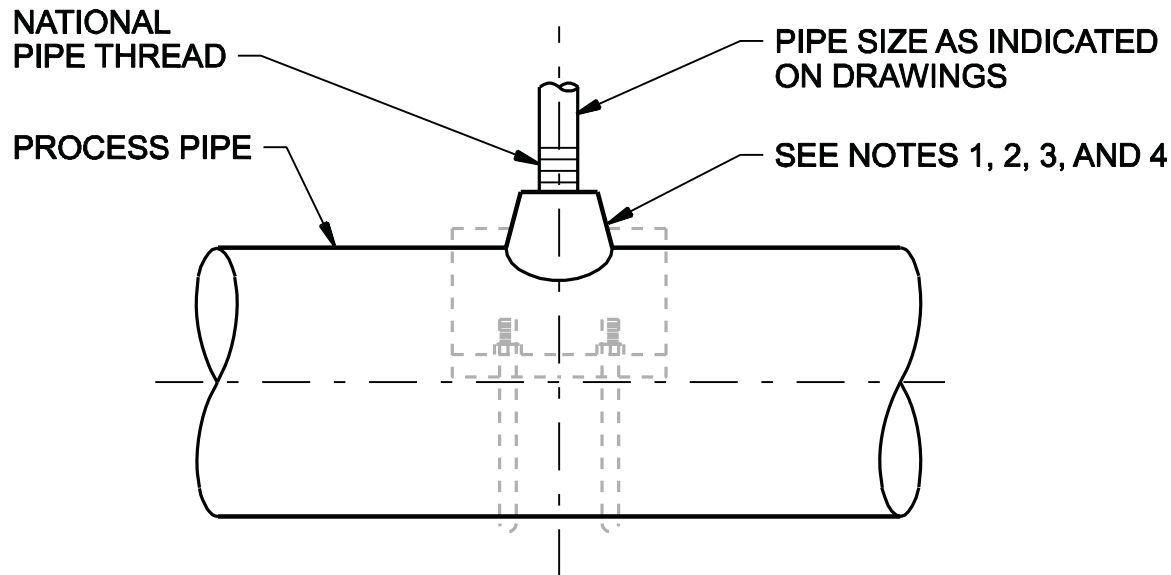


PIPE TAPS

NOTES:


1. FOR STEEL, GALVANIZED STEEL, AND PVC 2 1/2" AND SMALLER USE A BUSHING IN A TEE.
2. FOR DUCTILE IRON, ALL SIZES, USE SERVICE SADDLE.
3. FOR NEW STEEL AND STAINLESS STEEL PIPES 3" AND LARGER, AND PRESSURE VESSELS, USE THRED-O-LET AS SHOWN.
4. FOR EXISTING PVC, STEEL AND STAINLESS STEEL PIPES 3" AND LARGER, USE SERVICE SADDLE.

PIPE TAPS
NTS

15300

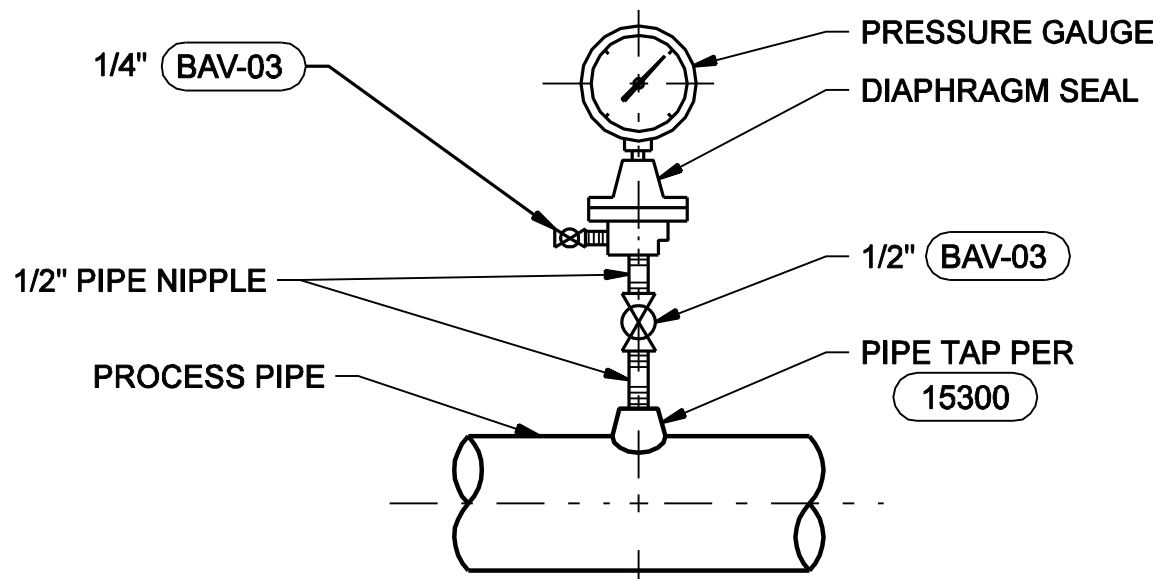

DIAPHRAGM SEAL INSTALLATION

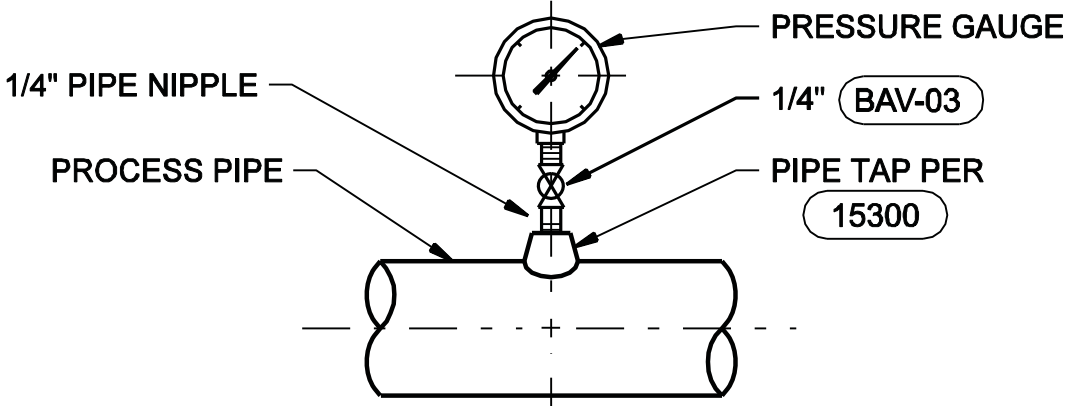

DIRECT INSTALLATION


NOTES:

UNLESS NOTED OTHERWISE ON THE DRAWINGS

1. USE DIRECT INSTALLATION FOR POTABLE WATER, RAW WATER, RECLAIMED WATER PROCESS PIPES AND AIR PIPING
2. USE DIAPHRAGM SEAL INSTALLATION FOR SEWAGE, SLUDGE, CHEMICAL AND ALL PROCESS PIPES THAT ARE NOT WATER OR AIR.
3. ALL PIPE NIPPLES TO BE TYPE 304 STAINLESS STEEL.

PRESSURE GAUGE MOUNTING
NTS

15310

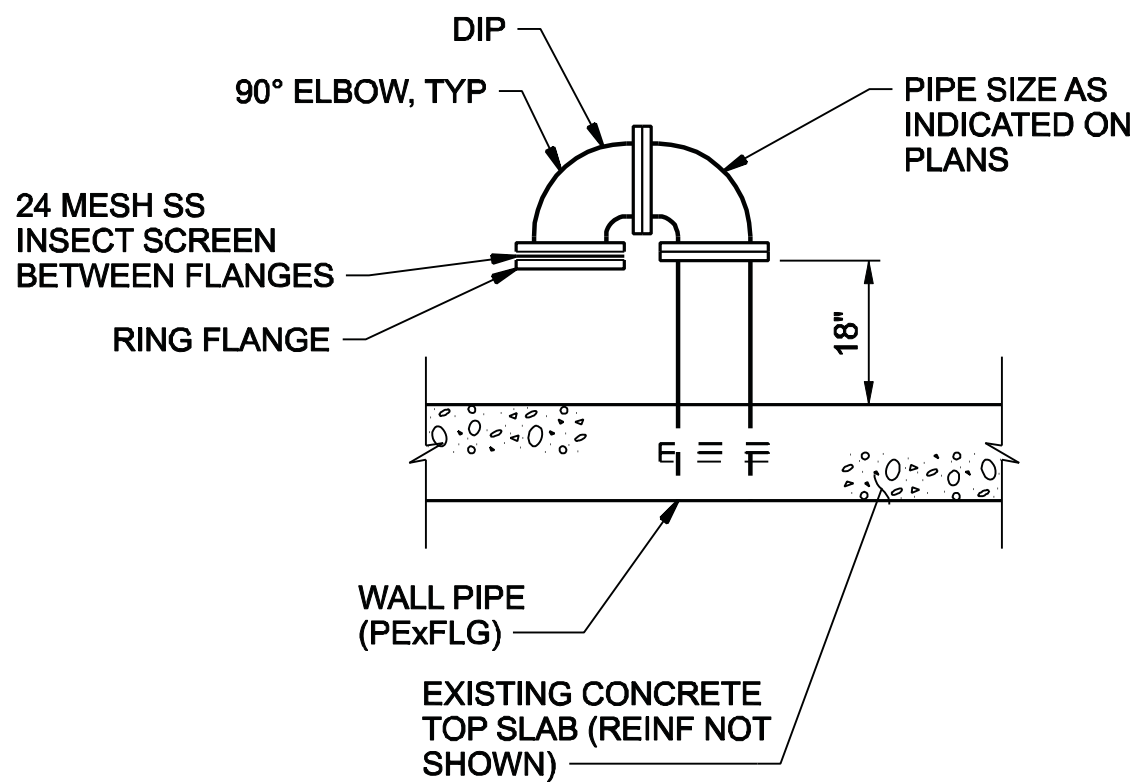

**GOOSENECK VENT THROUGH
CONCRETE SLAB**
NTS


15504

WATERWORKS
ENGINEERS
5767 Broadway #201 • Oakland, CA 94618 • 510-423-9590



CITY OF ALAMEDA
BAY FARM ISLAND PUMP STATION
REHABILITATION PROJECT

DETAILS
DETAILS

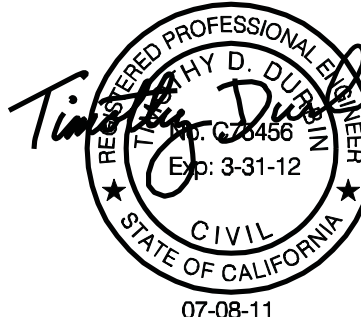

DATE
JULY 2011
PROJECT NUMBER
11-005
DRAWING NUMBER
SD-6
SHEET NUMBER
44